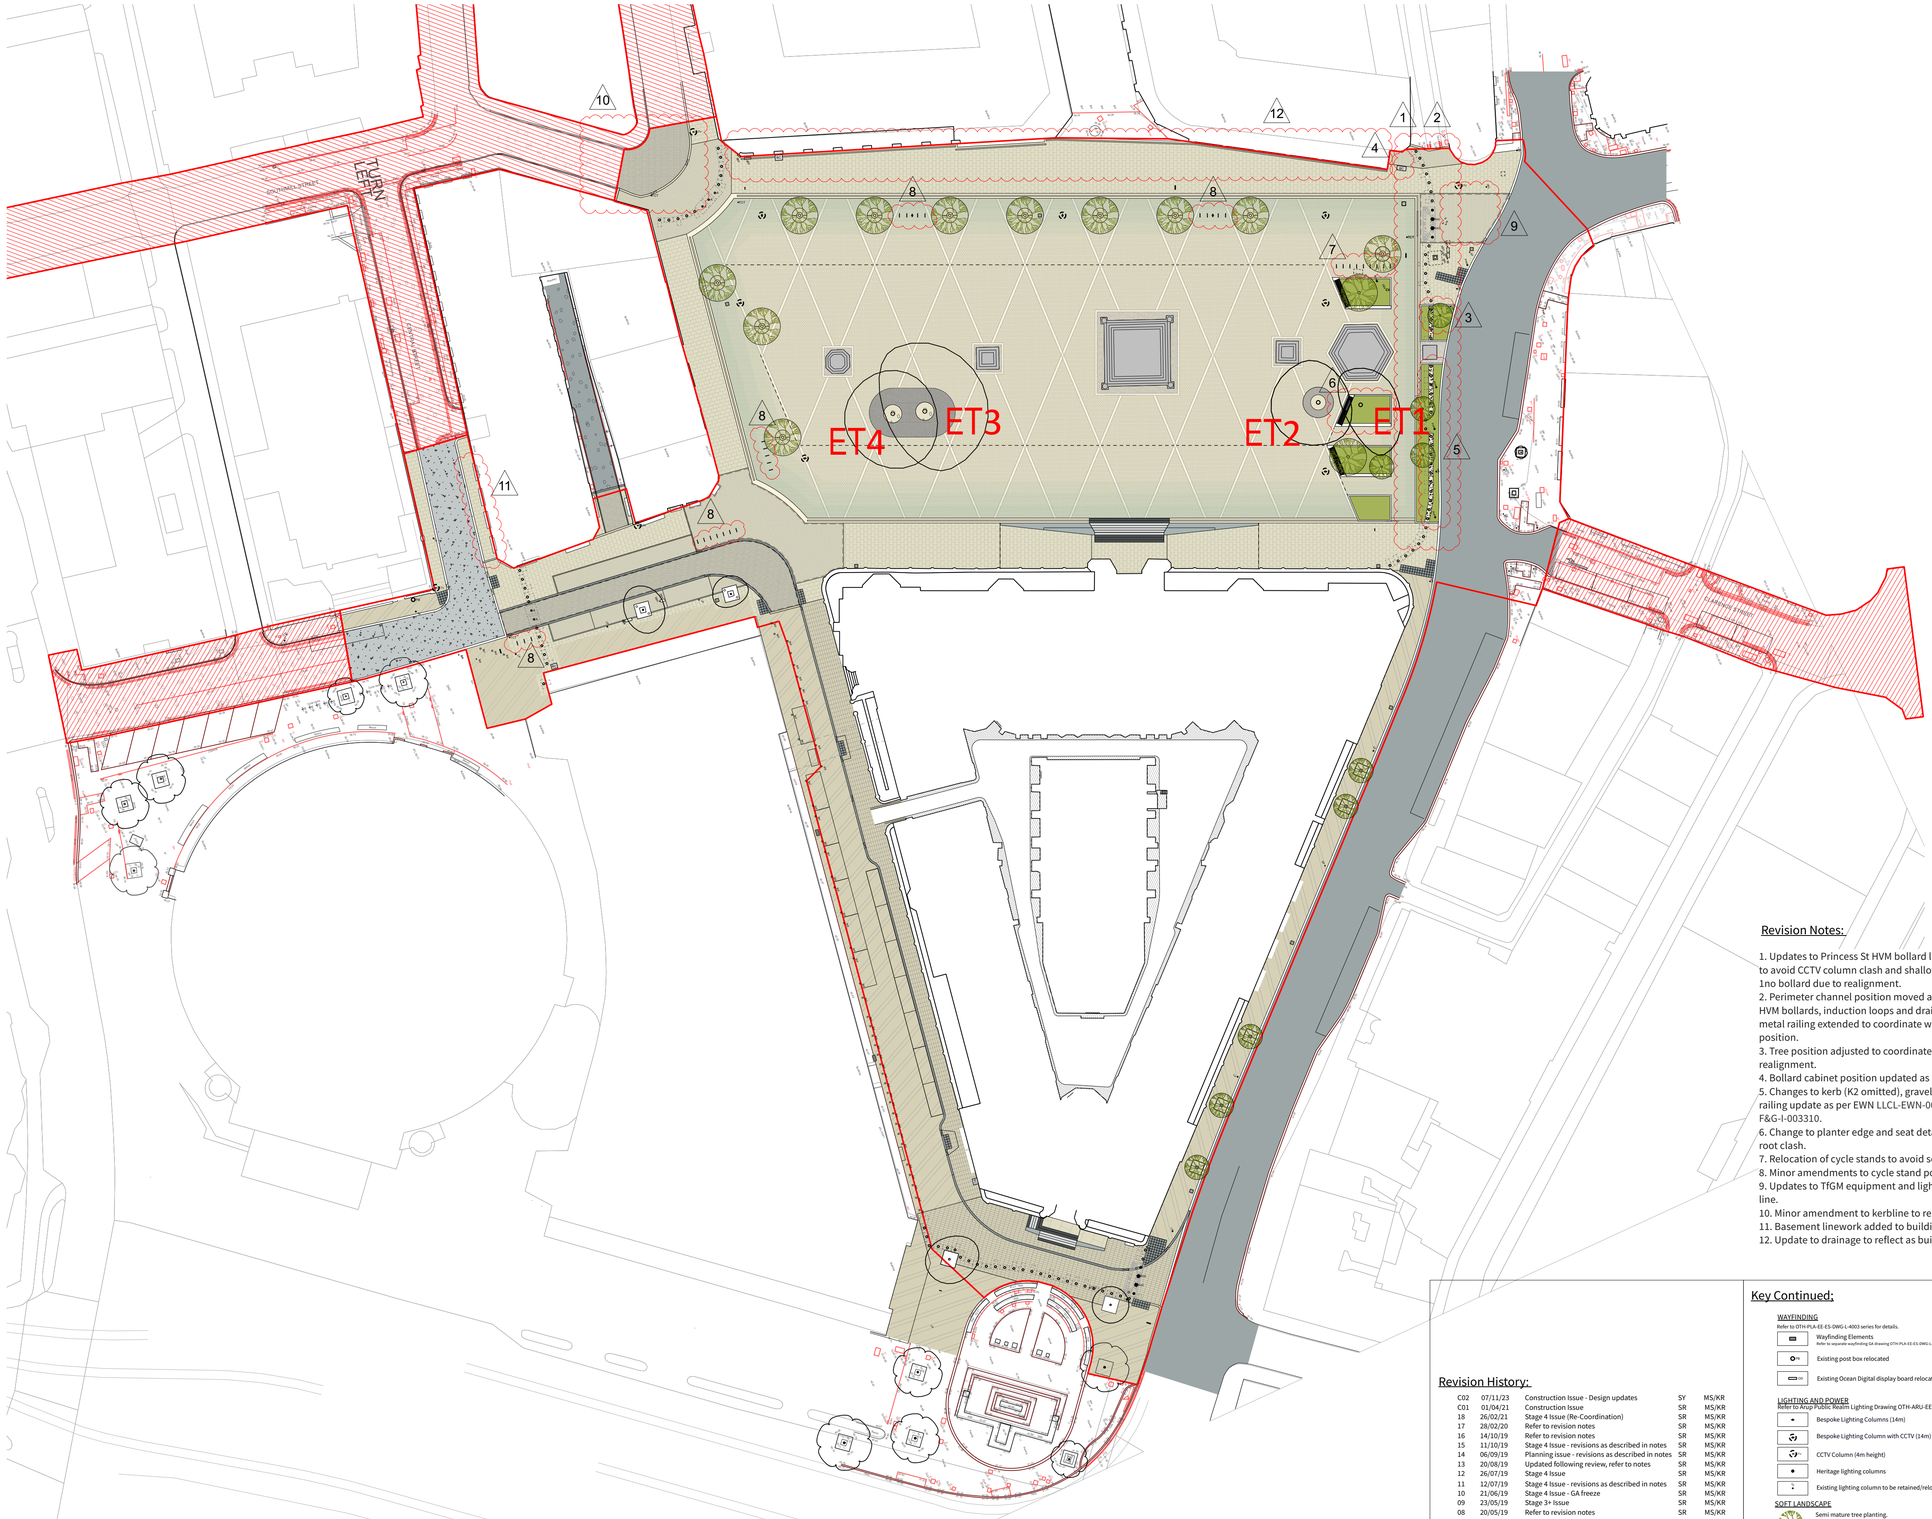


© THIS DRAWING IS COPYRIGHT PROTECTED AND MAY NOT BE REPRODUCED IN WHOLE OR PART WITHOUT WRITTEN AUTHORITY FROM THE OWNER
© Planit Intelligent Environments Limited

NOTES:
1. Do not scale from this drawing.
2. Always work to noted dimensions.
3. All dimensions are in millimetres unless otherwise stated.
4. All setting out, levels and dimensions to be agreed on site.
5. The dimensions of all materials must be checked on site before being laid out.
6. This drawing is to be read with the relevant specification clauses and detail drawings.
7. Order of construction and setting out to be agreed on site.

KEY

BOUNDARIES

- Red Line Boundary
- Section 278 Works

PROPOSED - NATURAL STONE SURFACES

Refer to OTH-PLA-EE-ES-DWG-L-5000 series for hardworks details

- Natural Stone Slab Paving - to streets and perimeter of Albert Square. Material: Yorkstone. Refer to detailed drawing OTH-PLA-EE-ES-DWG-L-5000 **Q25/112A**
- Natural Stone Sett Paving - to vehicular access points at corners of Albert Square Material: Yorkstone. Refer to detailed drawing OTH-PLA-EE-ES-DWG-L-5000 **Q25/112B**
- Natural Stone Slab Paving - to Albert Square and Cooper St entrances. Material: Yorkstone with laser etched surface pattern. Refer to detailed drawing OTH-PLA-EE-ES-DWG-L-5000 **Q25/112C**
- Natural Stone Setts Paving Mix - to main area of Albert Square. Material: Portuguese Granite, Scottish Schist. Refer to detailed drawing OTH-PLA-EE-ES-DWG-L-5000 **Q25/142A**
- Natural Stone Diamond Band - to Albert Square and edge of Monuments. To have special units at intersections and corners, and inlaid bronze features. Material: Portuguese Granite. Refer to detailed drawing OTH-PLA-EE-ES-DWG-L-5000 and 5002 **Q25/142B**
- Natural Stone Perimeter Channel - to edge of setts paving to Albert Square. Double stone channel with central drainage channel incorporated. Material: Portuguese Granite / Burlington Stone (where no drainage channel) Refer to detailed drawing OTH-PLA-EE-ES-DWG-L-5000 and 5002 **Q25/142C**
- Natural Stone Setts - to perimeter of monuments Material: Portuguese Granite. Refer to detailed drawing OTH-PLA-EE-ES-DWG-L-5000 and 5002 **Q25/142D**
- Natural Stone Setts - to perimeter of existing trees Material: Portuguese Granite **Q25/142E**

PROPOSED - BOUND SURFACES

- Porous Resin Bound Surfacing - to existing trees in Albert Square. Refer to detailed drawings: OTH-PLA-EE-ES-DWG-L-6007 **Q33/215B**

PROPOSED - BITUMINOUS SURFACES

- Proposed Asphalt Surfacing: New surfacing to Mount Street and Central Street and tie in areas **Refer to Ramboll Pavement Hardstanding Details drawings OTH-RAM-EE-ES-DWG-N-0100 and 0101**

EXISTING - NATURAL STONE SURFACES

TO BE RETAINED - any damaged material to be replaced with reclaimed paving material from site or new paving to match existing. Replacment material to **Q25/115A**

- Natural Stone Slab Paving: Yorkstone to Mount Street, Lloyd Street, Cooper Street and Princess Street.

TO BE LIFTED & RELAID - any damaged material to be replaced with reclaimed paving material from site or new paving to match existing.

- Natural Stone Setts: Reclaimed Granite Setts from Albert Square to Mount Street & Southmill Street carriageway. **Q25/115B**
- Natural Stone Slab Paving: Yorkstone to Cooper Street and Lloyd Street. **Q25/115A**

COURTYARD

Refer to the following Courtyard drawings for details of proposals:
OTH-PLA-EE-ES-DWG-L-8005 - 8020, OTH-PLA-EE-ES-DWG-L-1012 and OTH-PLA-EE-ES-DWG-L-5005

NATURAL STONE PLINTHS & STEPS

- Natural Stone Steps & Plinths - to Albert Square and Cooper Street entrances. Material: Scottish Green Schist. Step: Refer to drawing: OTH-PLA-EE-ES-DWG-L-5008 Plinths: Refer to drawings OTH-PLA-EE-ES-DWG-L-5004, 5006 & 5007 **F21/115A**

BOLLARDS AND VEHICLE SECURITY FEATURES

- Static Bollard - To IWA 14-1 and 2
- Active (Telescopic) Bollard - To IWA 14-1 and 2
- Existing bollards to be retained on Mount St. & Lloyd St.

STREET FURNITURE & FEATURES

Refer to OTH-PLA-EE-ES-DWG-L-4000 series for Furniture General Arrangement & OTH-PLA-EE-ES-DWG-L-7000 series for details

- Seating Elements. Seating plinths, freestanding benches and seating edges to planting areas. Refer to detailed drawings: OTH-PLA-EE-ES-DWG-L-7000-7002 and 7010-7012
- Informal Stone Seating Plinth/Edge to Planting Areas. Refer to detailed drawing: OTH-PLA-EE-ES-DWG-L-7013
- Bespoke Tree Grilles. Refer to detailed drawings: OTH-PLA-EE-ES-DWG-L-7007
- Cycle Stands. Refer to detailed drawing OTH-PLA-EE-ES-DWG-L-7004
- Litter bin. Refer to detailed drawing OTH-PLA-EE-ES-DWG-L-7005
- Bollard control panel
- Traffic control totem
- Existing post retained. Related to tramline and/or existing crossings
- Existing traffic light retained
- Existing signpost retained
- Existing service box retained

For details of security bollards, bollard control panels, traffic control totems and ether associated elements refer to Arup Public Realm Security Layout: OTH-ARU-EE-ES-DWG-G-17401 and Specification: OTH-ARU-EX-ES-SPE-Y-0001

Revision Notes:

1. Updates to Princess St HVM bollard line - positions adjusted to avoid CCTV column clash and shallow services. Omission of 1no bollard due to realignment.
2. Perimeter channel position moved as part of coordination of HVM bollards, induction loops and drainage. Planters and metal railing extended to coordinate with new channel position.
3. Tree position adjusted to coordinate with bollard realignment.
4. Bollard cabinet position updated as agreed with LPA.
5. Changes to kerb (K2 omitted), gravel margin added and railing update as per EWN LLCL-EWN-001929 and Instruction F&G-I-003310.
6. Change to planter edge and seat detail to avoid existing tree root clash.
7. Relocation of cycle stands to avoid service cover clash.
8. Minor amendments to cycle stand positions / spacing.
9. Updates to TfGM equipment and lighting etc around HVM line.
10. Minor amendment to kerbline to reflect as built position.
11. Basement linework added to building edge on Central St.
12. Update to drainage to reflect as built.

Revision History:

C02	07/11/23	Construction Issue - Design updates	SY	MS/KR
C01	01/04/21	Construction Issue	SR	MS/KR
18	26/02/21	Stage 4 Issue (Re-Coordination)	SR	MS/KR
17	28/02/20	Refer to revision notes	SR	MS/KR
16	14/10/19	Refer to revision notes	SR	MS/KR
15	11/10/19	Stage 4 Issue - revisions as described in notes	SR	MS/KR
14	06/09/19	Planning issue - revisions as described in notes	SR	MS/KR
13	20/08/19	Updated following review, refer to notes	SR	MS/KR
12	26/07/19	Stage 4 Issue	SR	MS/KR
11	12/07/19	Stage 4 Issue - revisions as described in notes	SR	MS/KR
10	21/06/19	Stage 4 Issue - GA freeze	SR	MS/KR
09	23/05/19	Stage 3+ Issue	SR	MS/KR
08	20/05/19	Refer to revision notes	SR	MS/KR
07	17/05/19	Refer to revision notes	SR	MS/KR
06	03/05/19	Refer to revision notes	SR	MS/KR
05	01/04/19	Stage 4 Issue - Refer to revision notes	SR	MS/KR
04	21/01/19	Refer to revision notes	SR	MS/KR
03	30/11/18	Stage 3 Issue	SR	MS/KR
02	20/11/18	Refer to revision notes	SR	MS/KR
01	02/11/18	Refer to revision notes	AD	MS/KR
00	26/09/18	First issue for review	SR	MS/KR

Revision	Date	Description	Drawn	Apprvd.

Key Continued:

WAYFINDING

Refer to OTH-PLA-EE-ES-DWG-L-4003 series for details.

- Wayfinding Elements. Refer to separate wayfinding GA drawing OTH-PLA-EE-ES-DWG-L-4003.
- Existing post box relocated
- Existing Ocean Digital display board relocated

LIGHTING AND POWER

Refer to Arup Public Realm Lighting Drawing OTH-ARU-EE-ES-DWG-E-15401 and specifications.

- Bespoke Lighting Columns (14m)
- Bespoke Lighting Column with CCTV (14m)
- CCTV Column (4m height)
- Heritage lighting columns
- Existing lighting column to be retained/relocated to Mount St. & Princess St.

SOFT LANDSCAPE

- Semi mature tree planting. Refer to Softworks General Arrangement drawing OTH-PLA-EE-ES-DWG-L-2000
- Existing trees to be retained. Refer to Tree Retention and Removal drawing OTH-PLA-EE-ES-DWG-L-1006
- Planting areas. Refer to Softworks General Arrangement drawing OTH-PLA-EE-ES-DWG-L-2000
- Gravel margin to bollards. Refer to Furniture Details drawing OTH-PLA-EE-ES-DWG-L-5026

5

Revision	Date	Description	Drawn	Apprvd.

Planit I.E. Limited
E: info@planit-ie.com **W:** planit-ie.com
MANCHESTER
2 Back Grafton St , Altrincham, WA14 1DY
T: 0161 928 9281
LONDON
Unit 6 Waterside, 44-48 Wharf Road, London, N1 7UX
T: 0207 253 5678
LIVERPOOL
No. 8 Princes Parade, Princes Dock, Liverpool, L3 1DL
T: 0151 705 6746

Client Manchester City Council

Project Our Town Hall

Drg Title Landscape General Arrangement

Created on	Created by	Approved by
26.09.18	SR	MS/KR

Scale	Size	Workstage
1:500	A1	Stage 5

Drg No.	Suitability	Revision
OTH-PLA-EE-ES-DWG-L-1000	S4	C02

© Planit I.E. Limited