MURRAYWOOD CONSTRUCTION LTD

QA Form – Drainage Lines

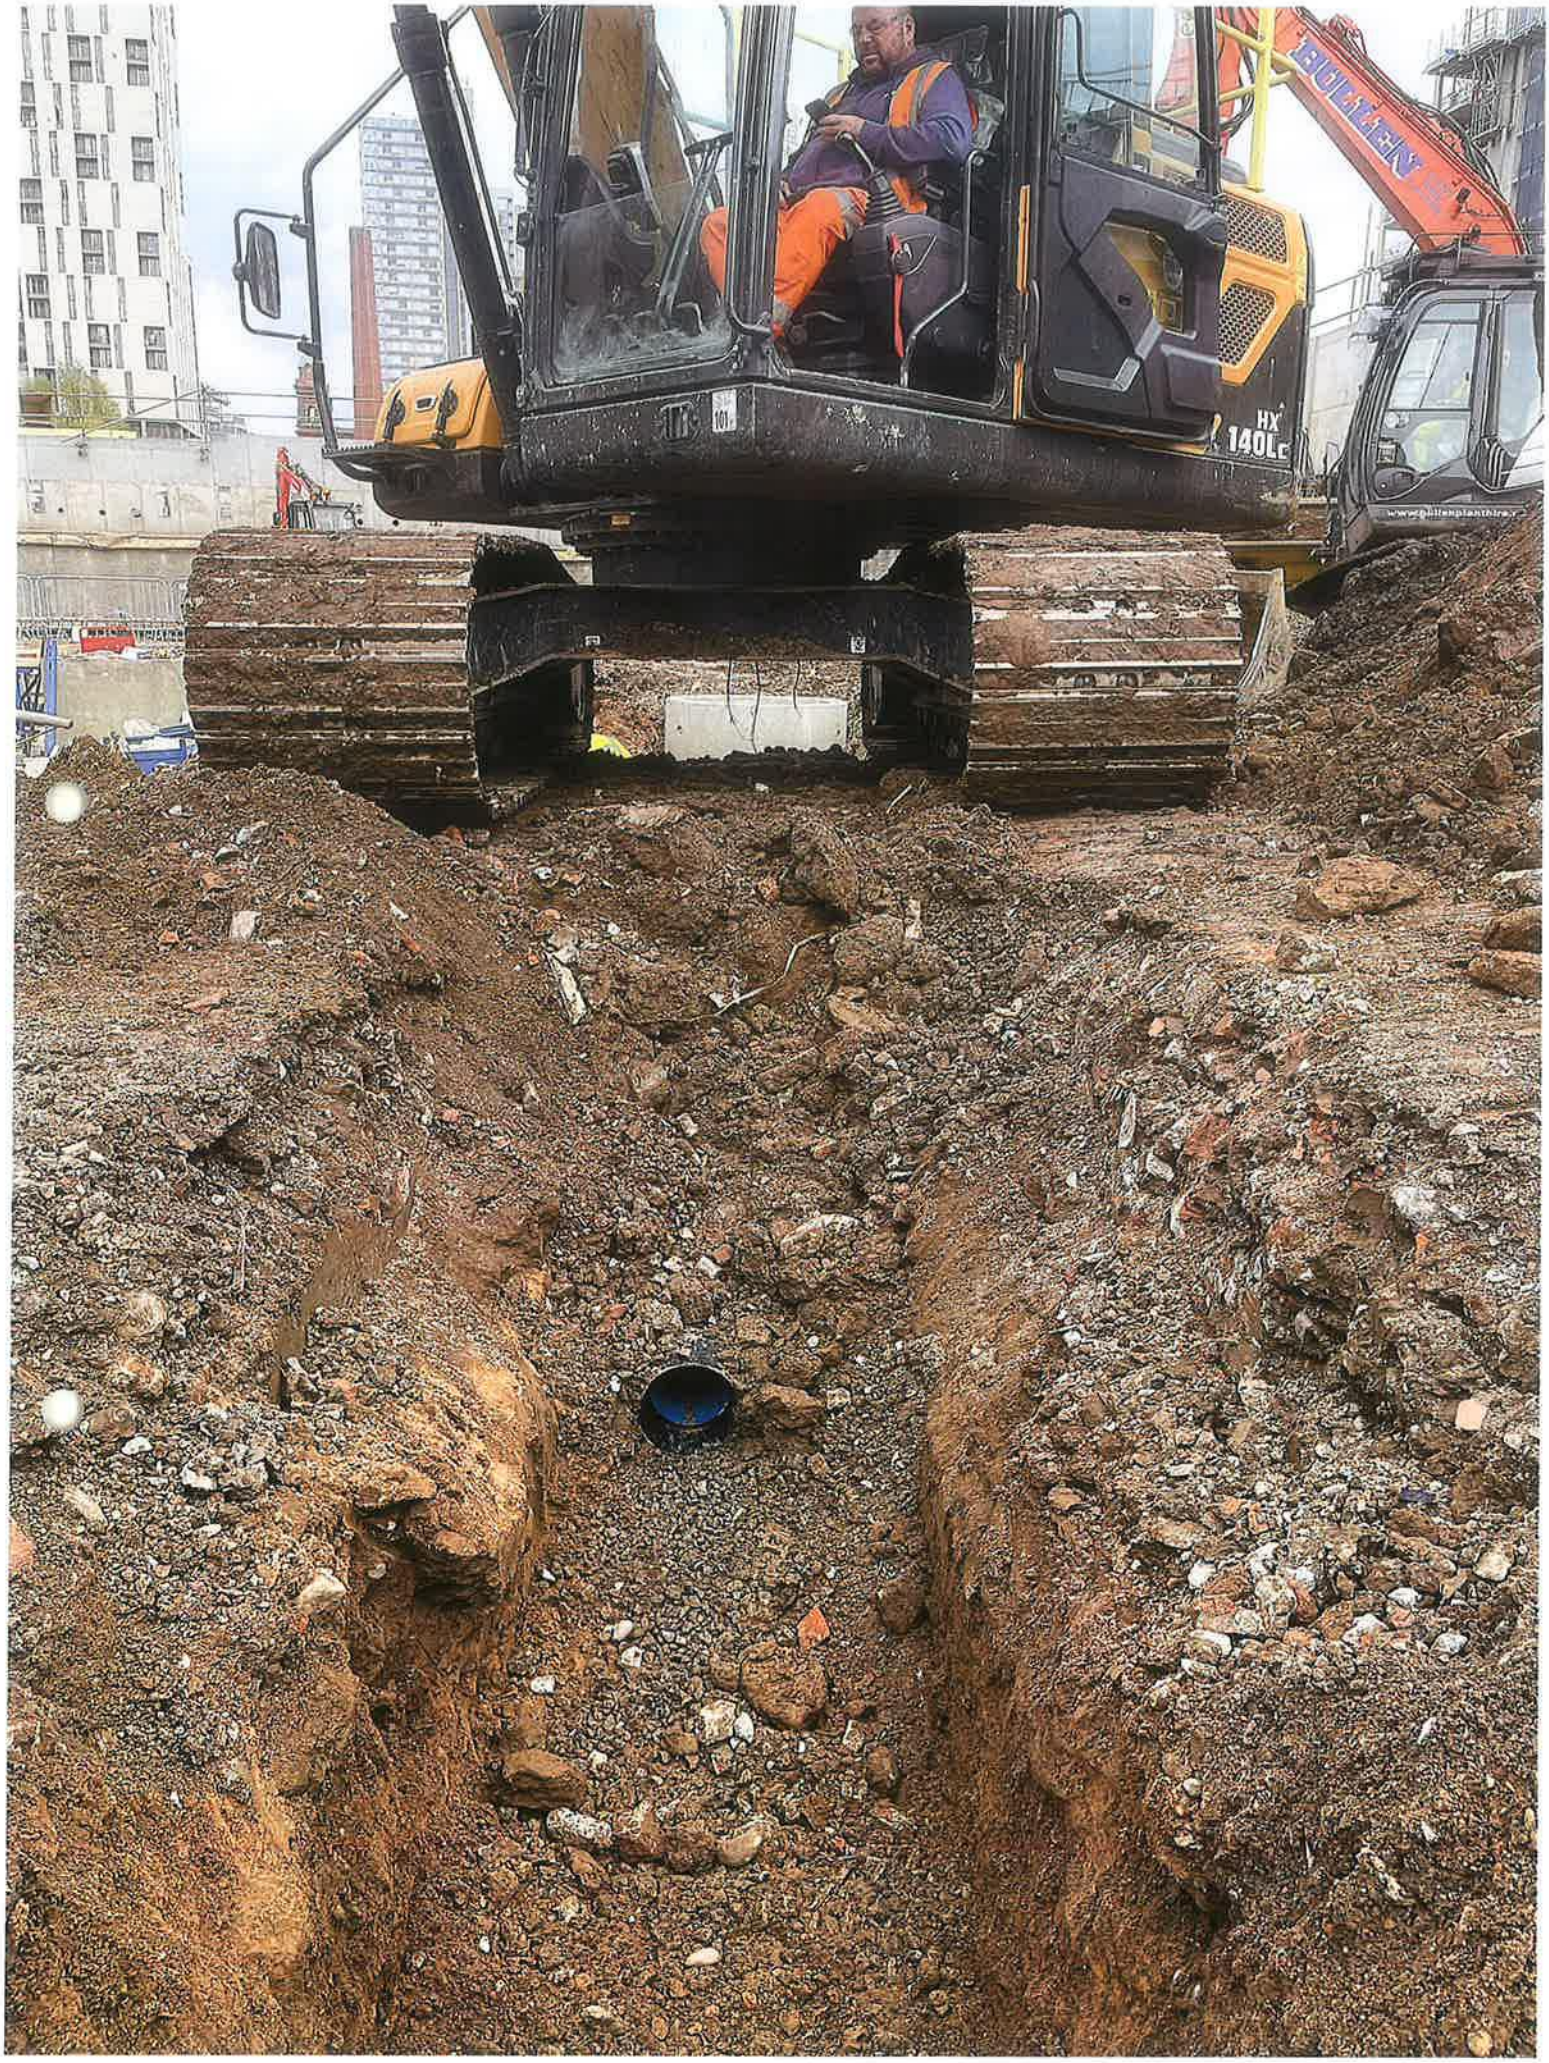
Installation of Drainage Lines			**Sheet No:**	8
Project	First Street Manchester		**Date:**	2/5/23
Location	MH ~~BW1~~ to MH BSW02 Length between Manholes: 13.3m	**Drawing No:**	MN2A-RAM-ZZ-XX-DR-C-000100	
Pipe Details:	~~FOUL~~/SURFACE WATER/~~COMBINED~~ Type of Pipe: 150mm Twinwall Size: 150mm	**INVERTS:**	Upstream: Downstream:	
Incoming Connections:	Distance from MH : Pipe Size: Distance from MH : N/A Pipe Size: Distance from MH : Pipe Size:		Distance from MH : Pipe Size: Distance from MH : N/A Pipe Size: Distance from MH : Pipe Size:	

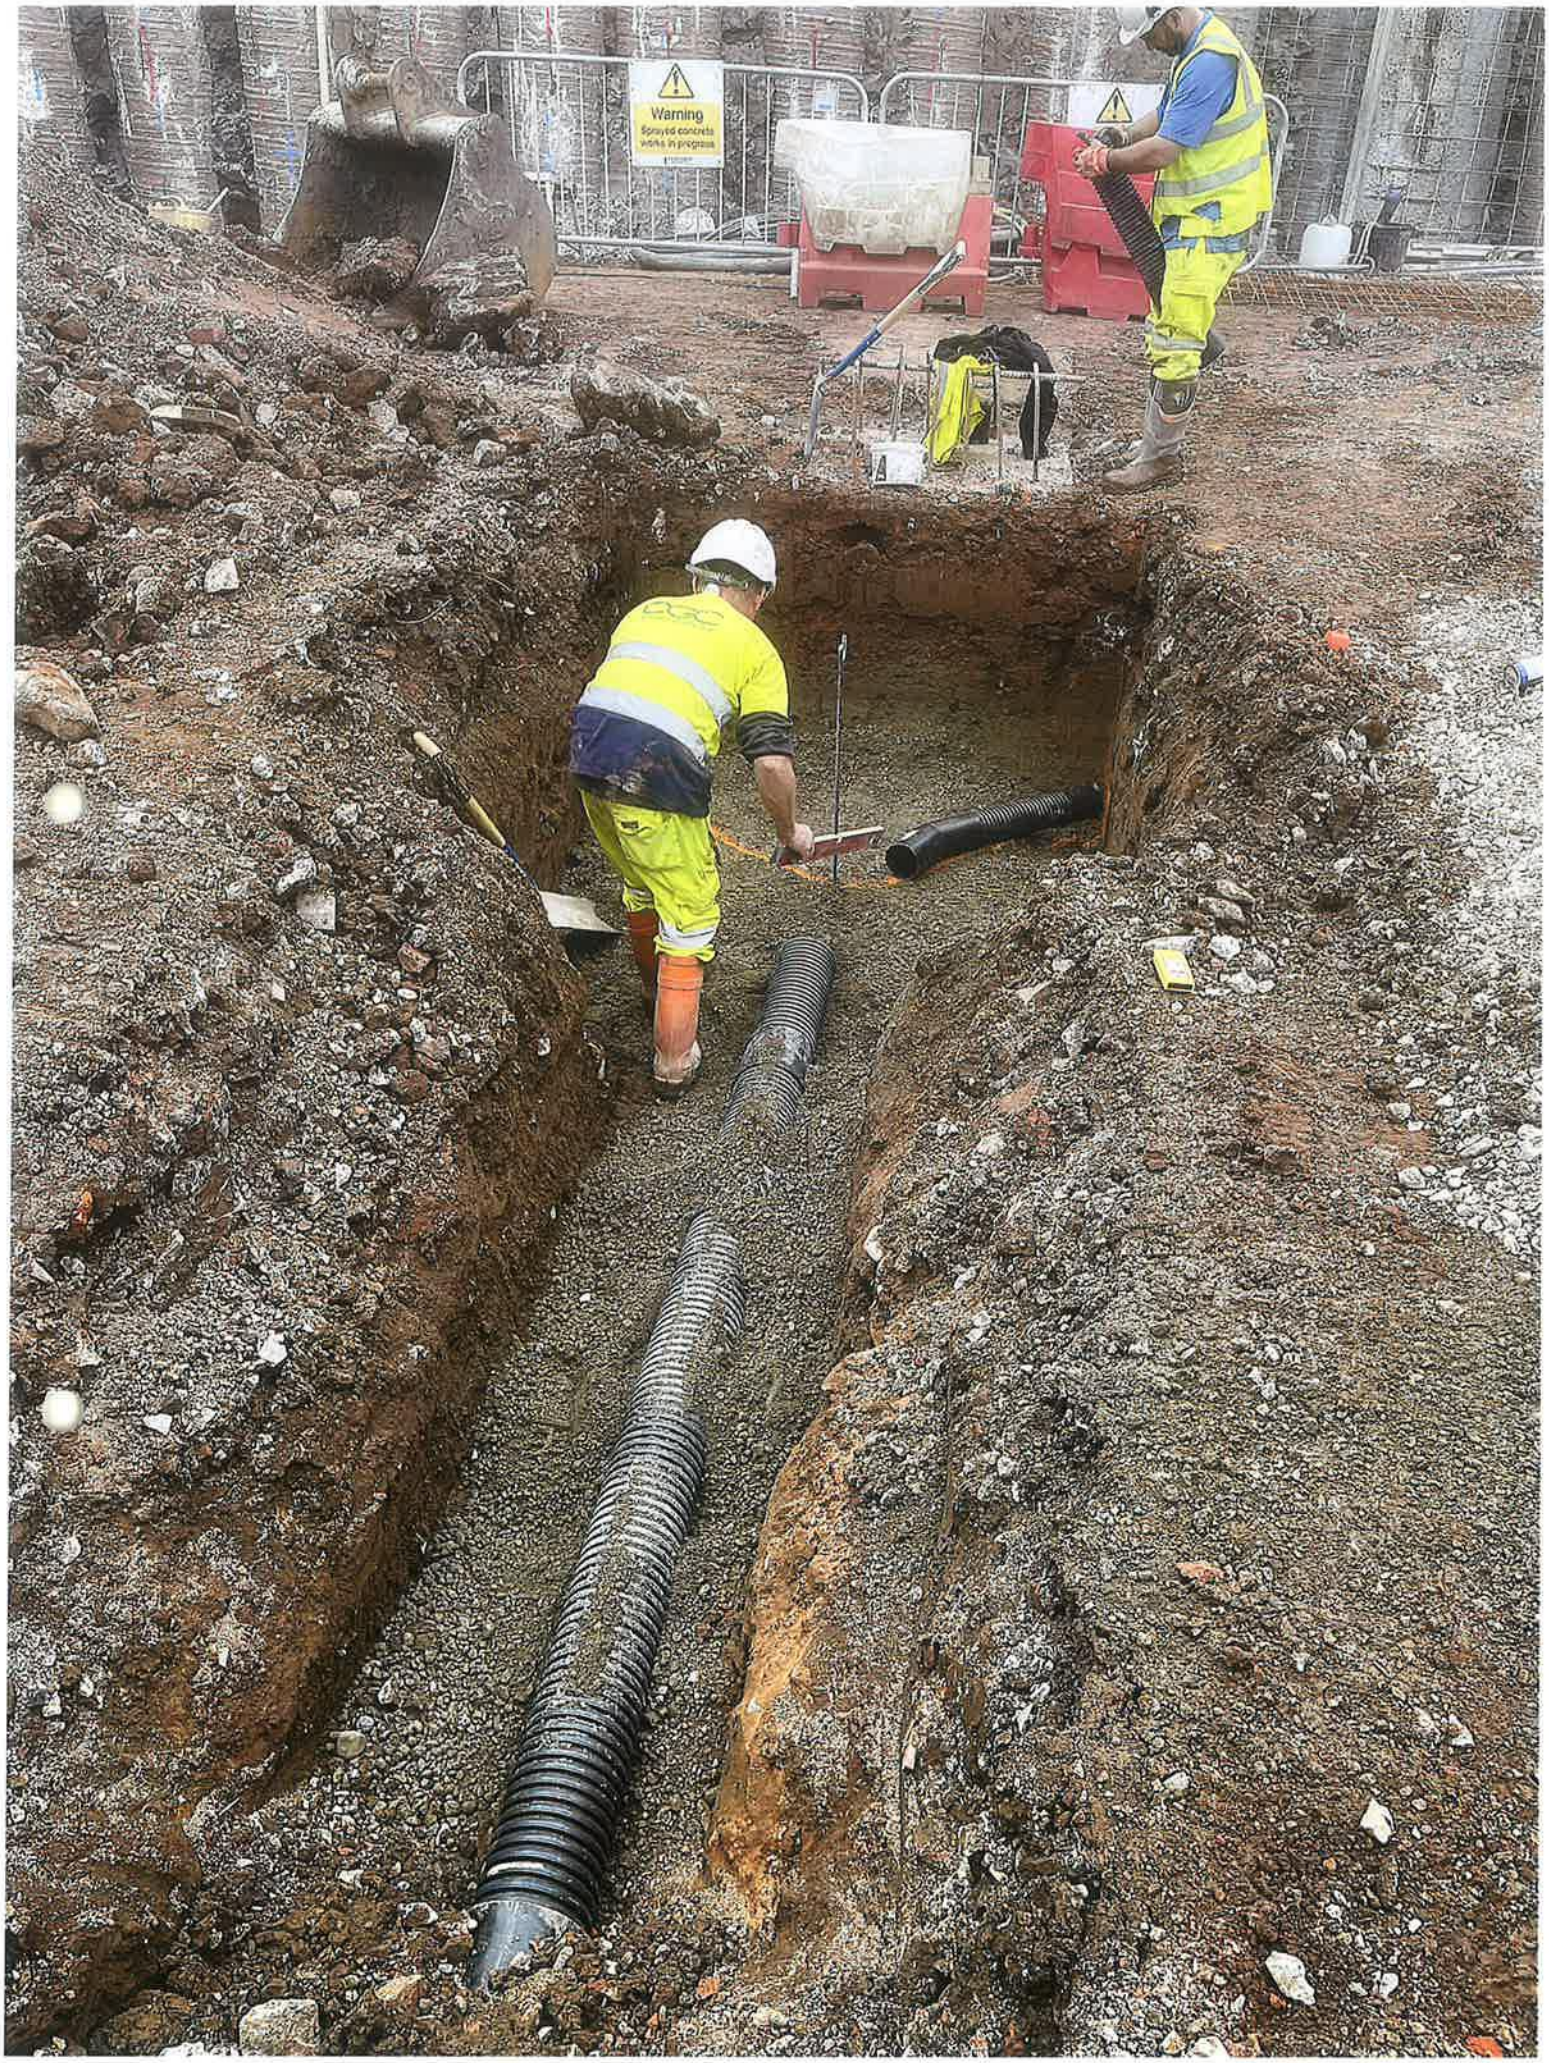
WORK TO BE INSPECTED	**Accepted Yes/ No or N/a**	**Comments**	**MW Construction Eng/QA Signed as Checked:-**
Setting out to drawing	Y		M.S
Trench excavation supported	Y		M
Installation of pipe bedding to correct levels	Y		M
Installation of all drainage materials	Y		M
Connections installed and recorded distance and size	Y		M
Testing of drainage line by Murraywood Operatives	Y		M

MWC Signature confirming readiness to backfill:-	M.S	**Date**	2/5/23
Client Signature confirming acceptance to backfill:-		**Date**	2/5/23

HANDOVER				
WORK TO BE INSPECTED	**Accepted Yes/ No**	Comments	MW Construction Eng/QA Signed as Checked:-	
Backfilling completed to correct level and in layers as instructed in the specification	Y		NO	
Pipeline tested by Building Inspector and accepted.	Y		NO	
Client Signature confirming Handover of Drainage Line:-			**Date**	2/5/23.
MWC Signature confirming Handover of Drainage Line:-	M. Sm		**Date**	2/5/23

SKETCH


BULLEN
HX
140Lc


Warning
Sprayed concrete
works in progress

