




AS BUILT SIDE ELEVATION 1:100
NORTH EAST

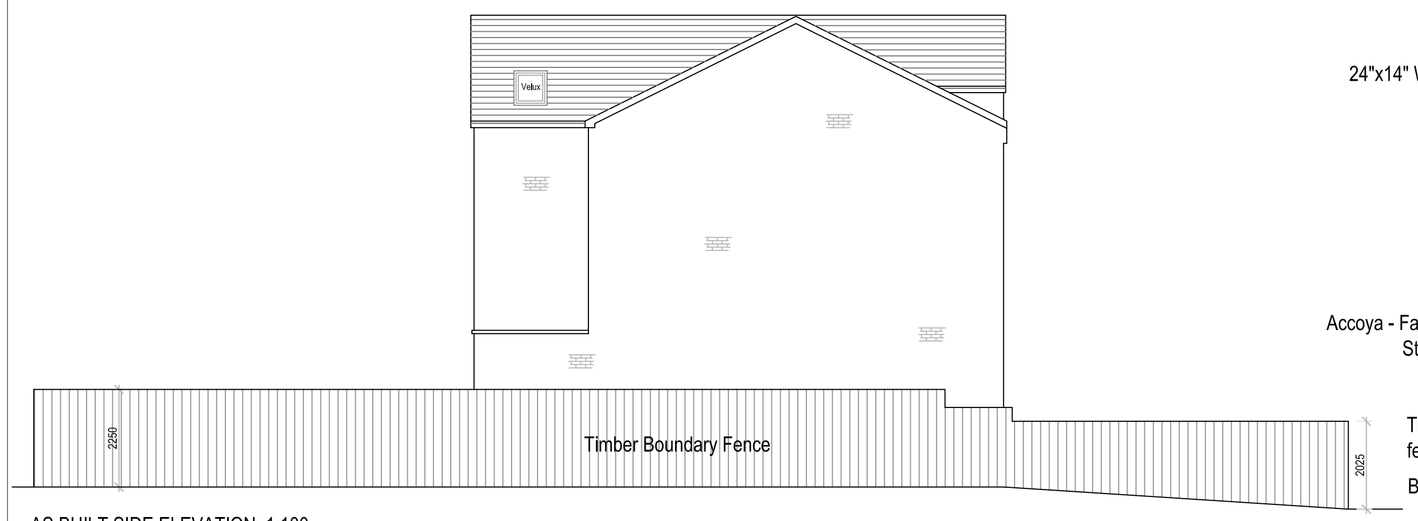

AS BUILT FRONT ELEVATION 1:100
NORTH WEST

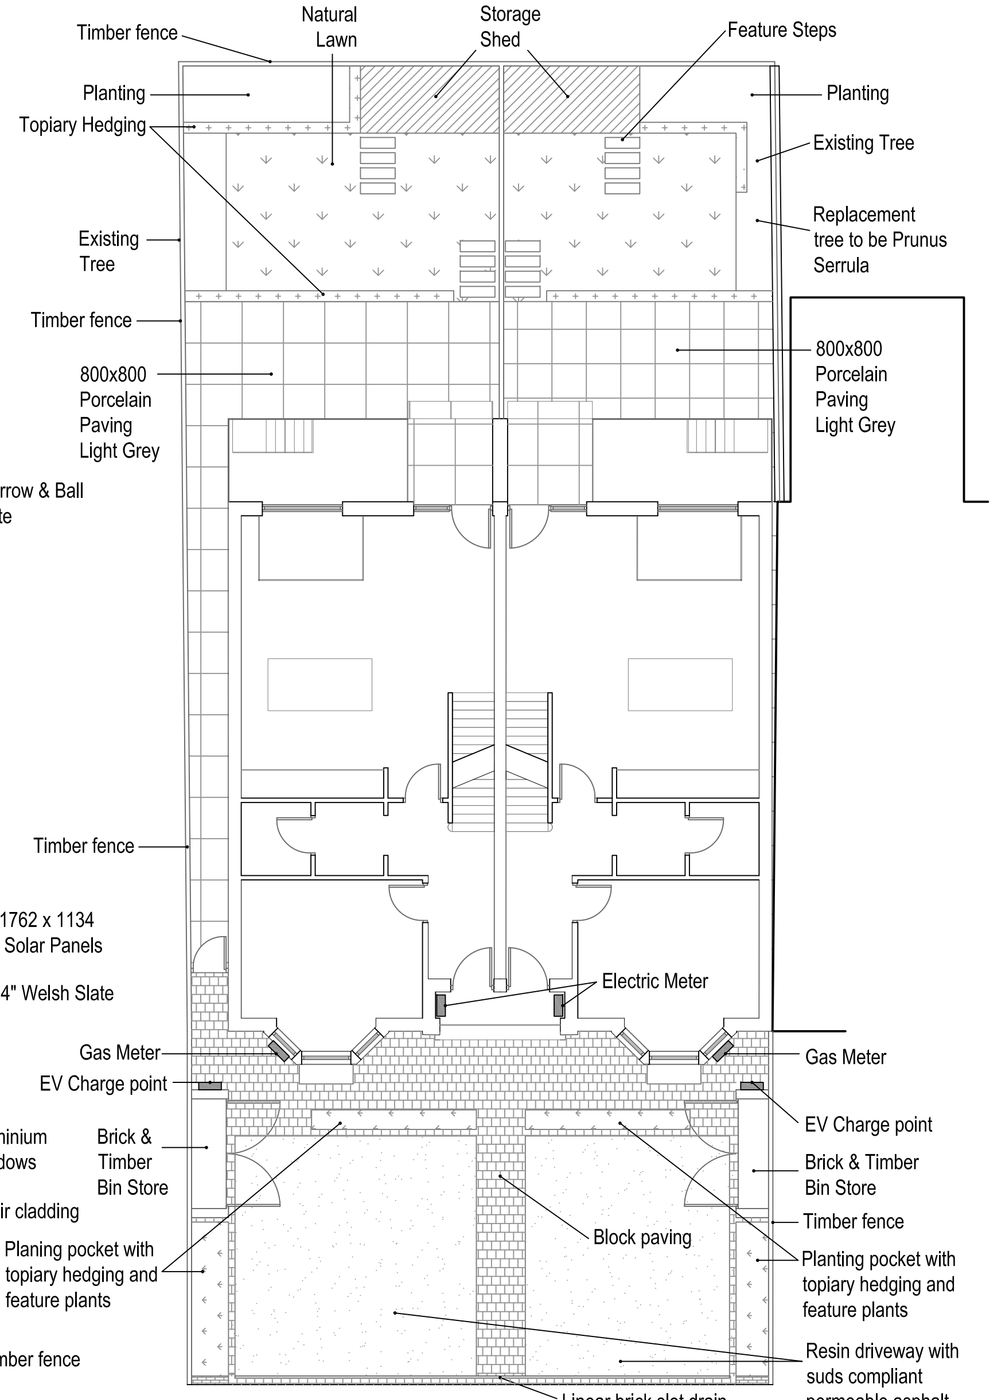


AS BUILT SITE PLAN 1:100

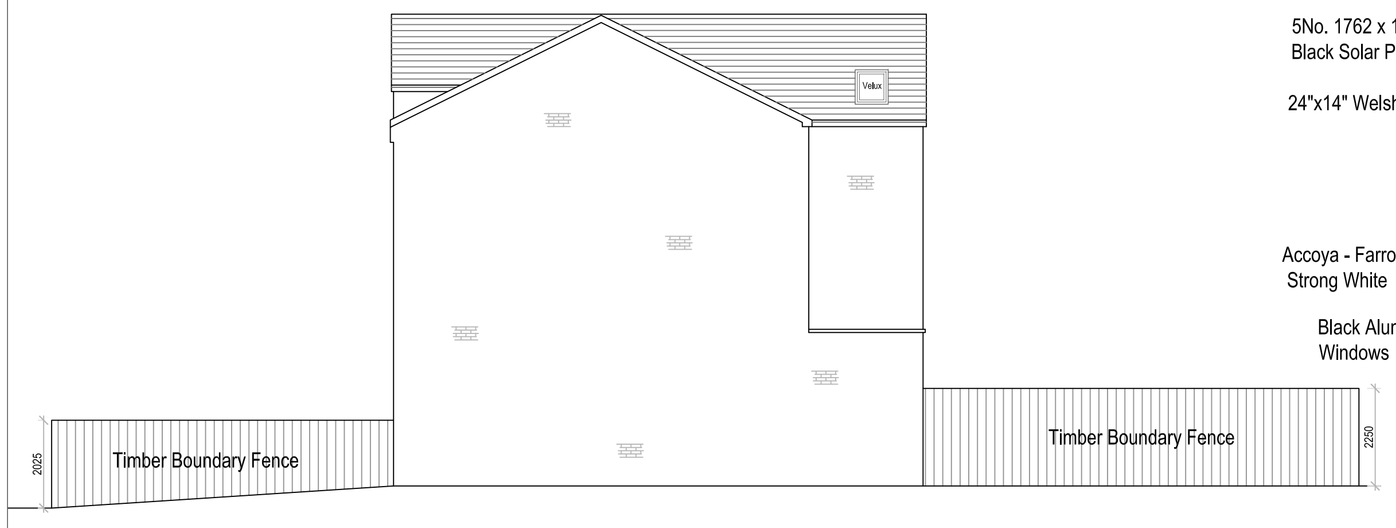


AS BUILT SIDE ELEVATION 1:100
SOUTH WEST




AS BUILT REAR ELEVATION 1:100
SOUTH EAST

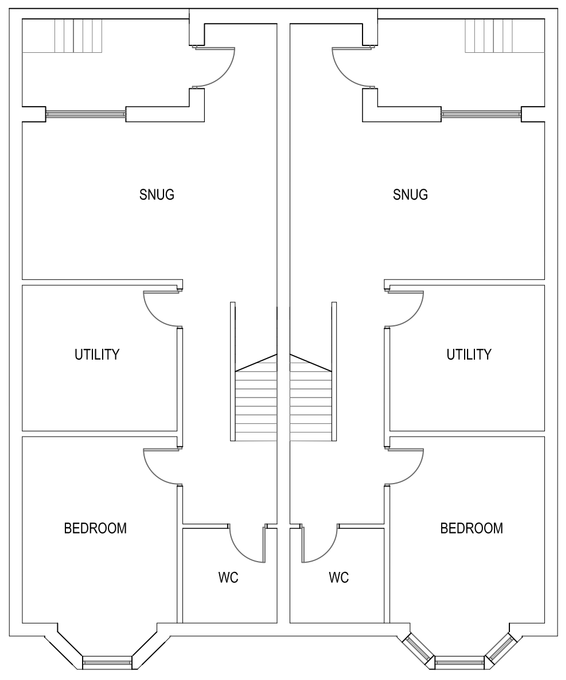


AS BUILT BF PLAN 1:100

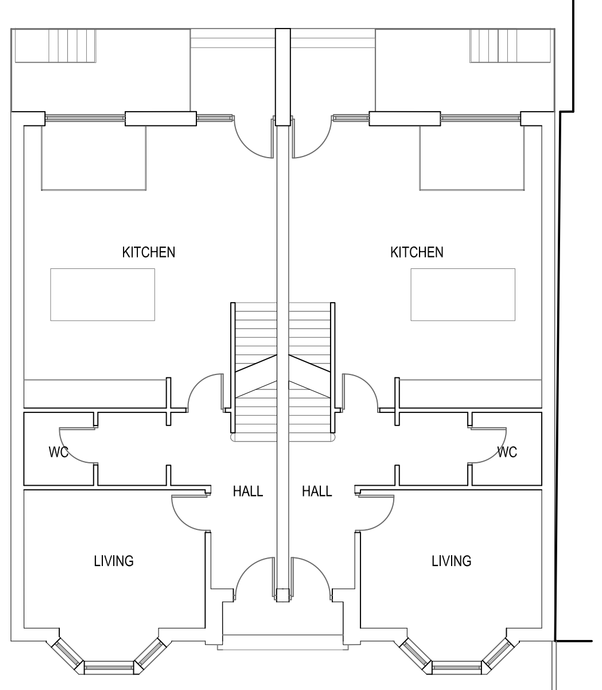


AS BUILT GF PLAN 1:100

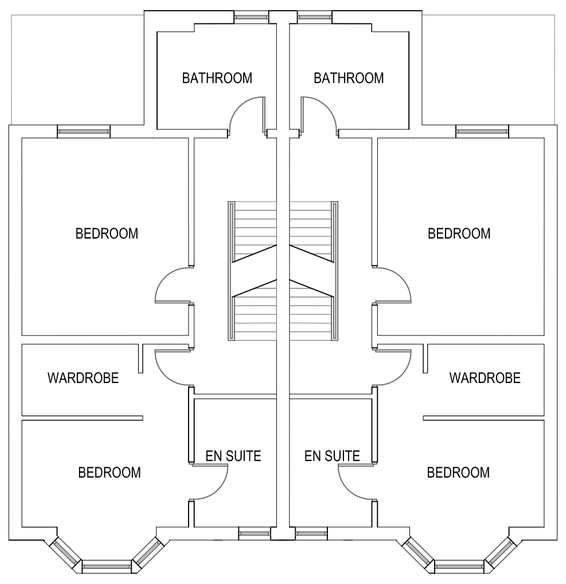

AS BUILT FF PLAN 1:100

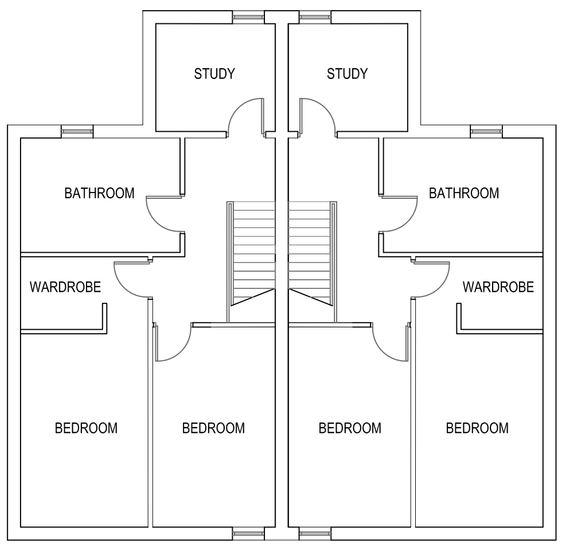

AS BUILT SF PLAN 1:100

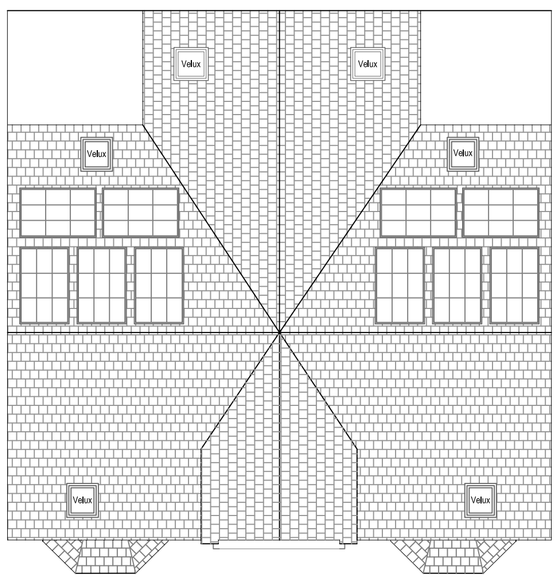

AS BUILT ROOF PLAN 1:100

REV C General amendments
REV B General amendments
REV A General amendments

AS BUILT PLANS & ELEVATIONS

114 Old Landsowne Road,
Didsbury,
M20 2NY

AS BUILT PLANS & ELEVATIONS

Drawn: CDW
Scale: 1:100 @ A1
Date: June 2024

2405_DID_01_AS_BUILT_Rev_C

CDWP
CD Wilkinson Plans
tel: 07967 522401 email: chris@cdwilkinsonplans.co.uk
5 Highmeadow, Manchester, M26 1YN