Copyright of this drawing is vested in Jon Matthews Architects and it must not be copied or reproduced without written consent. If figured dimensions only are to be taken from this drawing. Do not scale from this drawing.

All Contractors must visit the site and are responsible for taking and checking all dimensions relative to their work. Jon Matthews Architects are to be advised of any variation between drawings and site conditions.

Electronic data or drawings issued as 'read only' are'nt/should not be interrogated for measurement. All dimensions and levels should be 'read only' from those values stated in text, on the drawings.

⚠ CONSTRUCTION - It is considered that the proposed works are within the scope of a competent contractor and assume that no unusual hazards have been identified, refer to relevant Key/ Schedule/ Designers Risk Assessment

Key Plan:



## MATERIALITY KEY:

01 Horizontal green pre cast concrete cladding articulated with an inverted envelope profile and ornamental pattern. Acid etched finish

02 Horizontal green pre cast concrete forming an angled crown at top. Polished finish

03 Vertical green pre cast concrete cladding. Polished finish

04 Capless fixed glazing set out on a 3m module. Mid-dark grey frames with clear glass

05 Capless opening solid vent panel with decorative profile. Anodised metal, mid-dark silver finish

06 Capless glass to glass curtain walling system set out to a 1.5m & 3m module. Mid-dark grey frames with clear glass and manifestation pattern to ground floor only. Manifestation to comply with Approved Documents and British Standards. Module width changes to suit full height glazing at building corners

07 Recessed PPC insulated metal spandrel panel behind glass masking floor construction

08 Fully glazed automated powered detection curved sliding door at office entrance, incorporated into curtain walling system

09 Horizontal green pre cast concrete panel with decorative perforations. Panel sits in front of winter garden curtain walling system. Acid etched finish

10 Capless curtain walling system to winter gardens with automated parallel opening panels. Mid-dark grey frames with clear glass

11 Back painted glass in a curtain walling system, mid-dark grey frames

12 PPC Metal balustrade

13 Vertical metal louvre system, mid grey metallic PPC, screening external plant

14 ~~Grey vertical pre cast concrete cladding, articulated with a decorative ribbed profile. Acid etched finish~~

15 ~~Back painted glass screen concealing plant at roof level~~

16 Vertical metal louvre system, mid grey metallic PPC, with integrated service doors as part of system

17 ~~Metal ventilation louvres at high level. Metallic mid-dark silver finish~~

18 Decorative anodised metal panel for solar shading with perforated pattern. Mid-dark silver finish

19 PPC Aluminium flashing, colour to match green PCC


20 Anodised metal panel with decorative profile, mid-dark silver finish

21 Dark grey pre cast concrete plinth. Acid-etched finish


22 To Level 9 - Anodised capped curtain wall system with mid-dark silver finish and clear glass. Internal frames in white

23 Shadow box units within curtain wall system. Mid-dark grey frames.


24 Metallic PPC metal cladding to car park ramp below ground

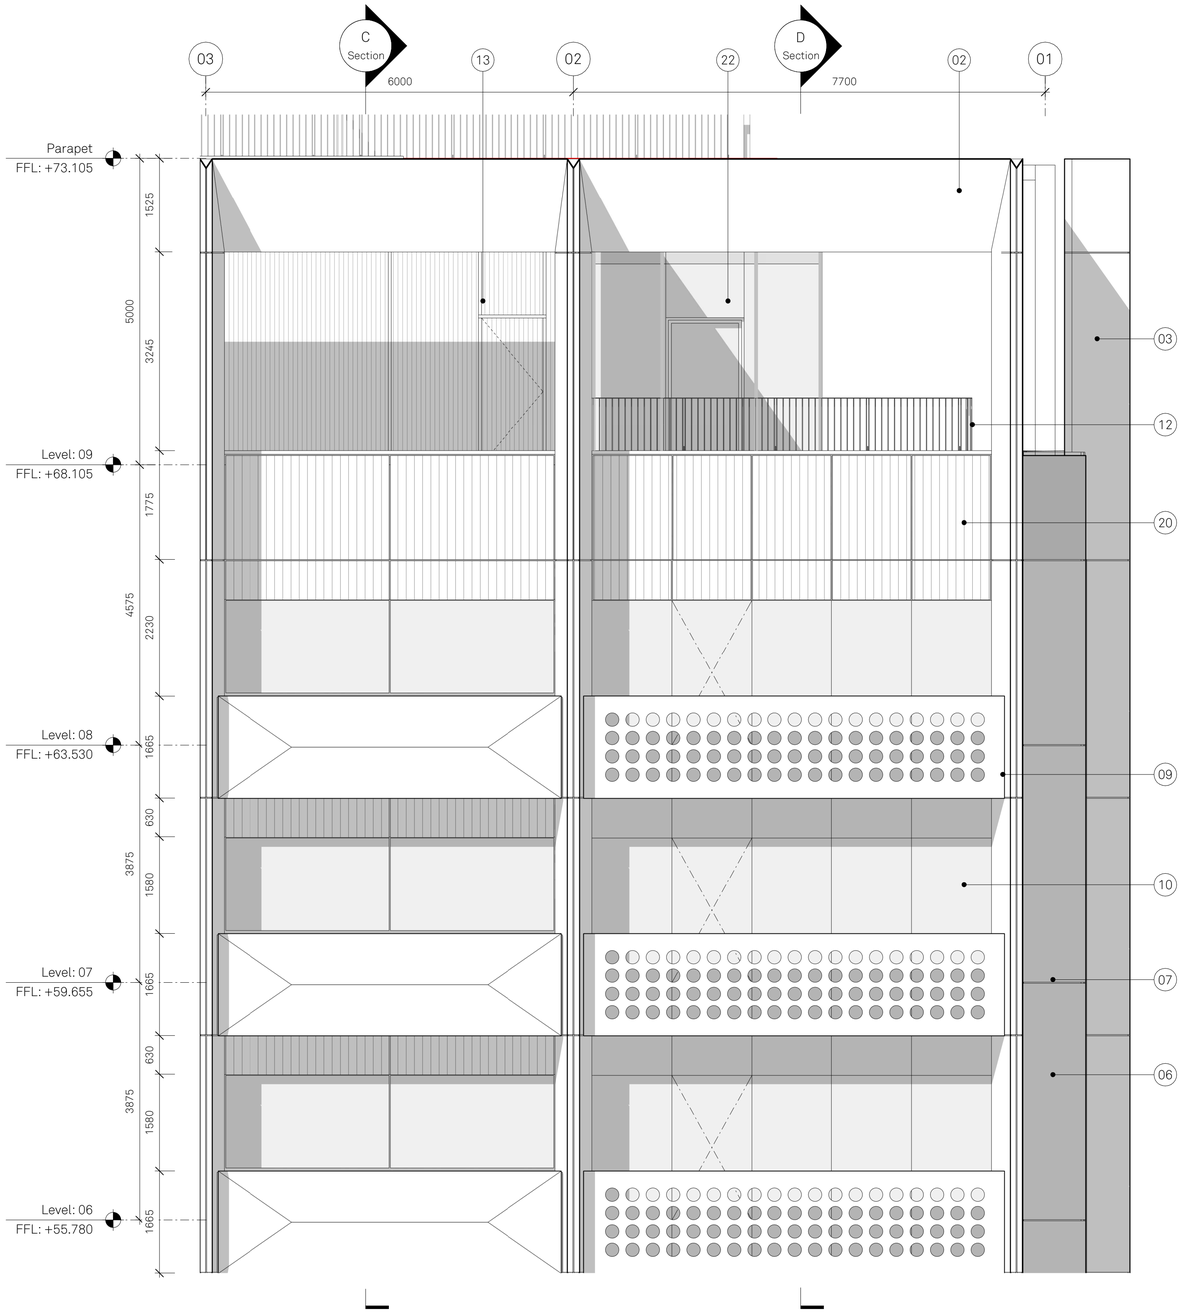



PARTIAL ELEVATION
Winter Gardens

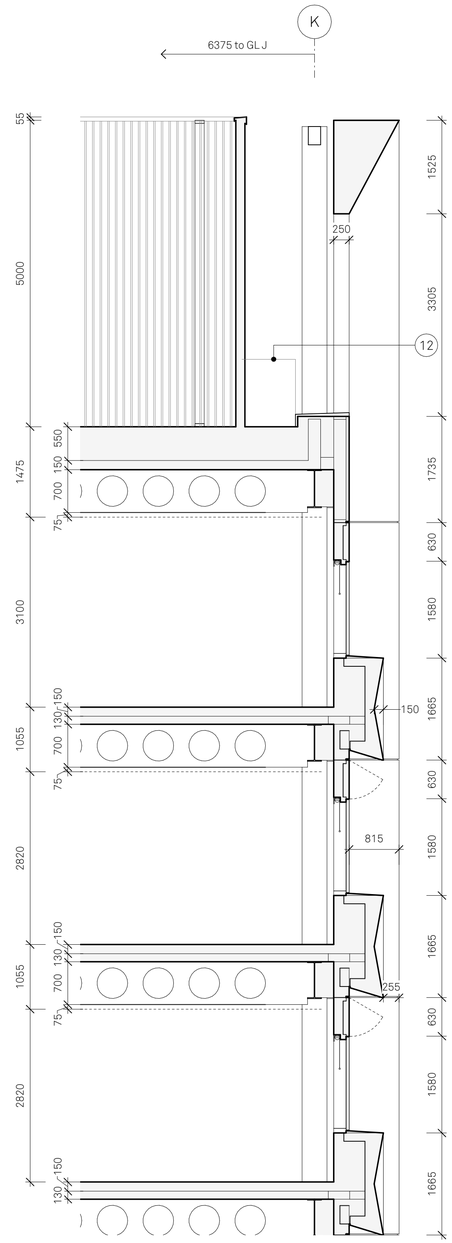


SECTION C
Through office & external plant

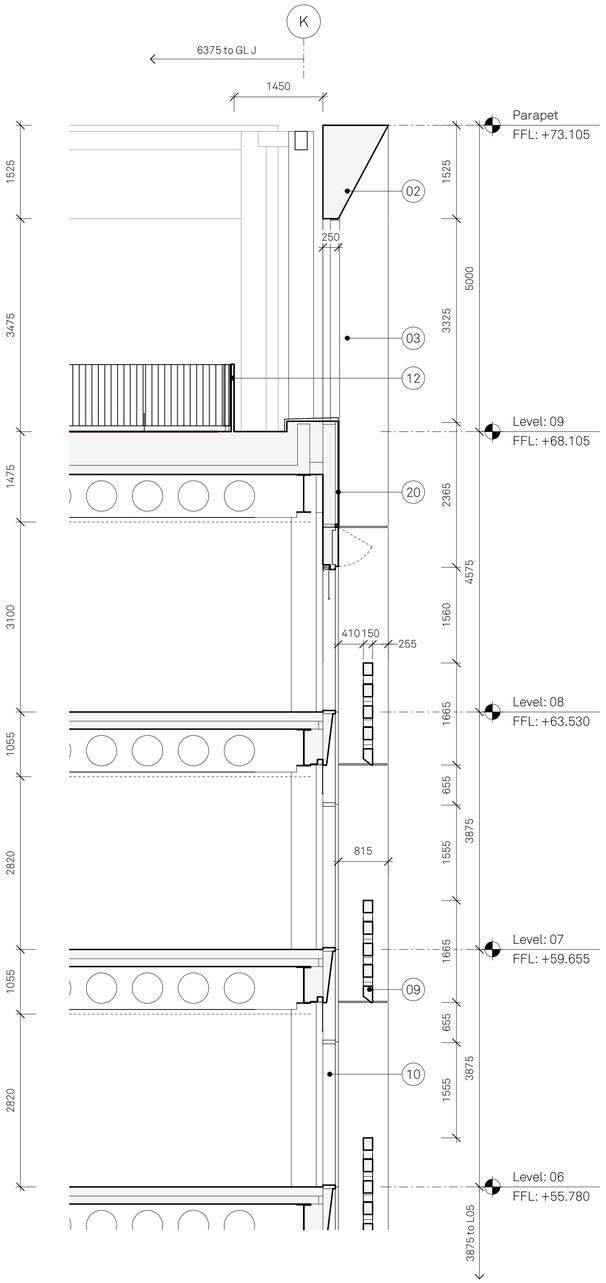


SECTION D
Through Winter Gardens & roof terrace

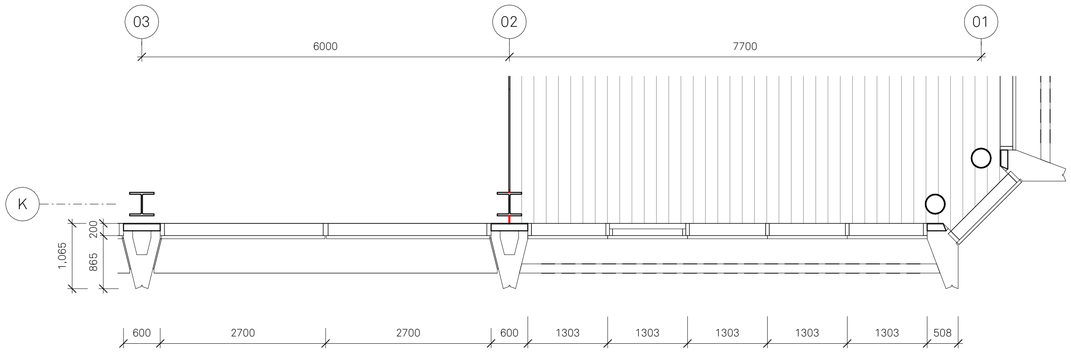


PLAN B
Winter Gardens

| | | |
|---|---|---|
| P01 | 19/03/24 | Issued for Planning |
| Rev: | Date: | Details: |

Jon Matthews Architects
Union, 2-10 Albert Square, Manchester, M2 6LW

Project:
MN2A

Title:
NMA Bay Study 02
Winter Gardens

| Scale: | Origin Date: | Drawn: | Checked: |
|---|---|---|---|
| 1:50 @ A1 | 01/30/24 | Author | Checker |

Status:
S2

Drawing No: MN2A-JMA-MB-XX-DR-A-104252

Rev: P01