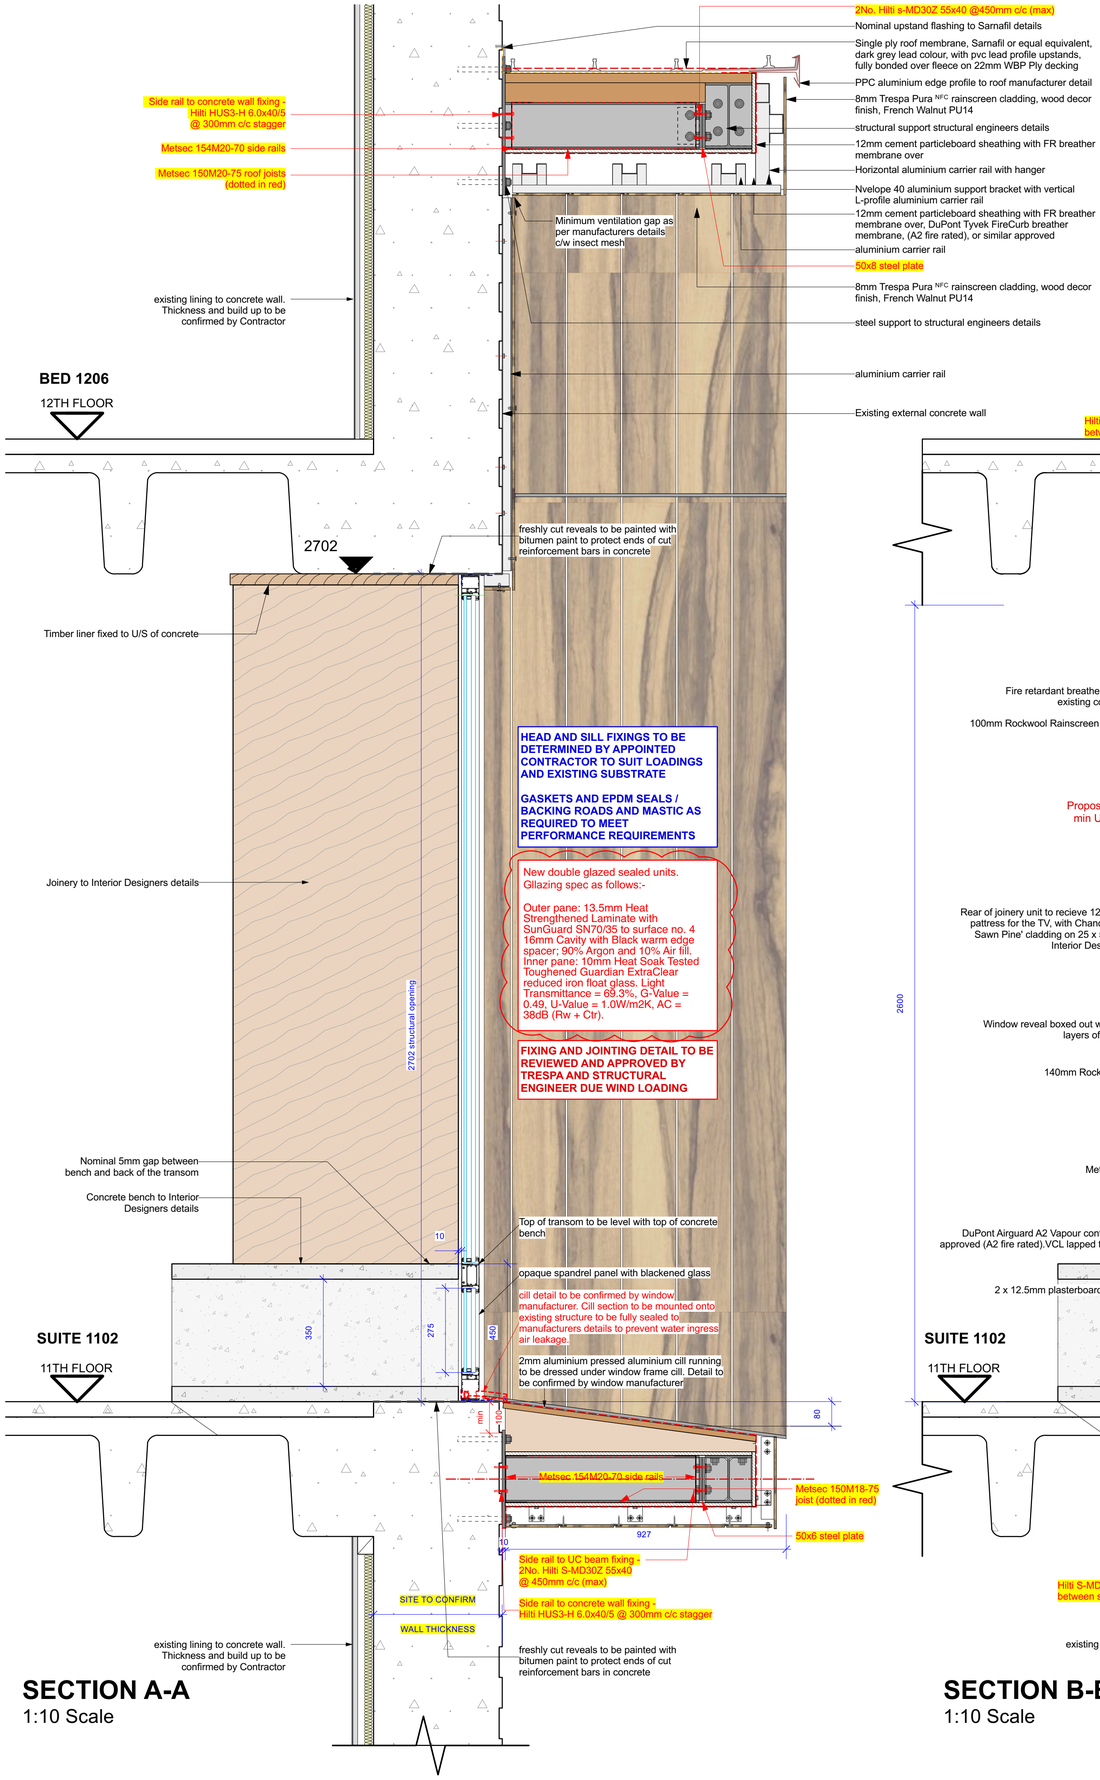

SECTION A-A
1:10 Scale

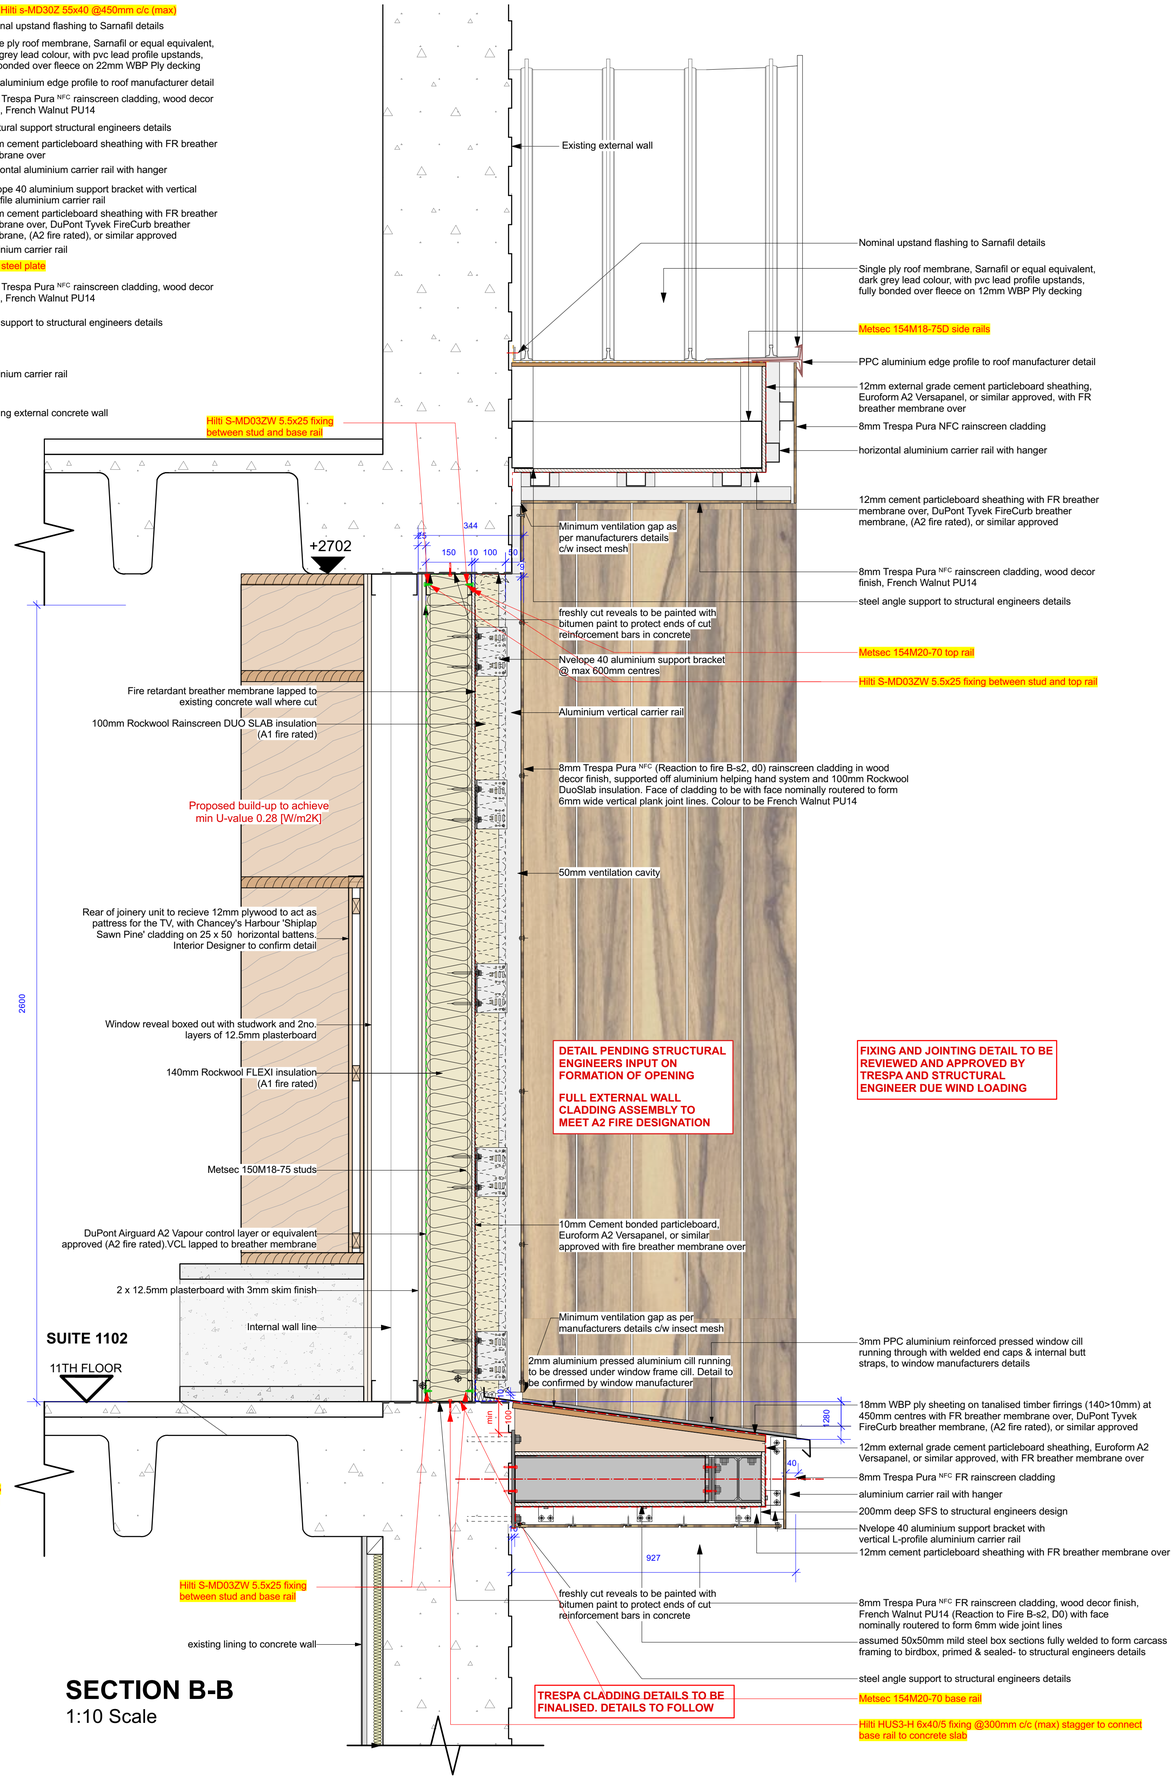

SECTION B-B
1:10 Scale

Notes

All contractors, subcontractors and/or specialists are responsible for taking and checking all dimensions relating to their work on site.

KEY:

Notes highlighted in yellow are MJM Consulting specification as per MJM marked up dated 14.03.24

Rev.	Date	Description	By	Appr.
C1	07.05.24	Drawing updated with MJM comments dated 14.03.24	PB	RG
P7	06.11.23	Inner leaf glazing thickness corrected to 10mm	PB	RG
P6	27.10.23	Window cladding updated to Trespa Pura planks. Curtain walling replaced with window system at Wordsworth request	MK / PB	PB
P5	21.07.23	Window reveal finishes updated	PB	PB
P4	20.07.23	Transom included at Wordsworths request. Rainscreen cladding, cement board and breather membrane specification updated	PB	RG
P3	03.02.23	Treehouse supports changed to box section stubs. Rainscreen extended above window head	PB	RG
P2	15.08.22	Bird feature omitted at Client request	PB	RG
P1	19.05.22	Drawing and titleblock updated to Calma Group naming conventions for Aconex.	PB	RG

synergy architects
Synergy Architects Ltd
8 Euston Place Leamington Spa
Warwickshire CV32 4LN
T: 01926 450391
F: 01926 889086
www.synergyarchitects.co.uk

CLIENT
Deansgate SOF Alliance Hotel Co Ltd.

Project
TREEHOUSE HOTEL MANCHESTER

Document reference: THM1-001-011-DR-A-3.18

Status: CONSTRUCTION

Drawing
11th Floor Gable Treehouse Sections AA & BB

Scale	Date	By	Approved
1:10 @ A1	15/10/21	MC	RG

Synergy Job No.	Synergy Drawing No.	Revision
SA813	3.18	C1

Copyright Synergy Architects Limited. The information contained in this document may not be used, reproduced or distributed, in whole or in part, without the written consent of Synergy Architects. Only parties to which this document has been intentionally issued by Synergy Architects may use the information. Synergy Architects will not accept responsibility for any consequence of its unauthorised use.