
© Tier Consult
© Tier Consult

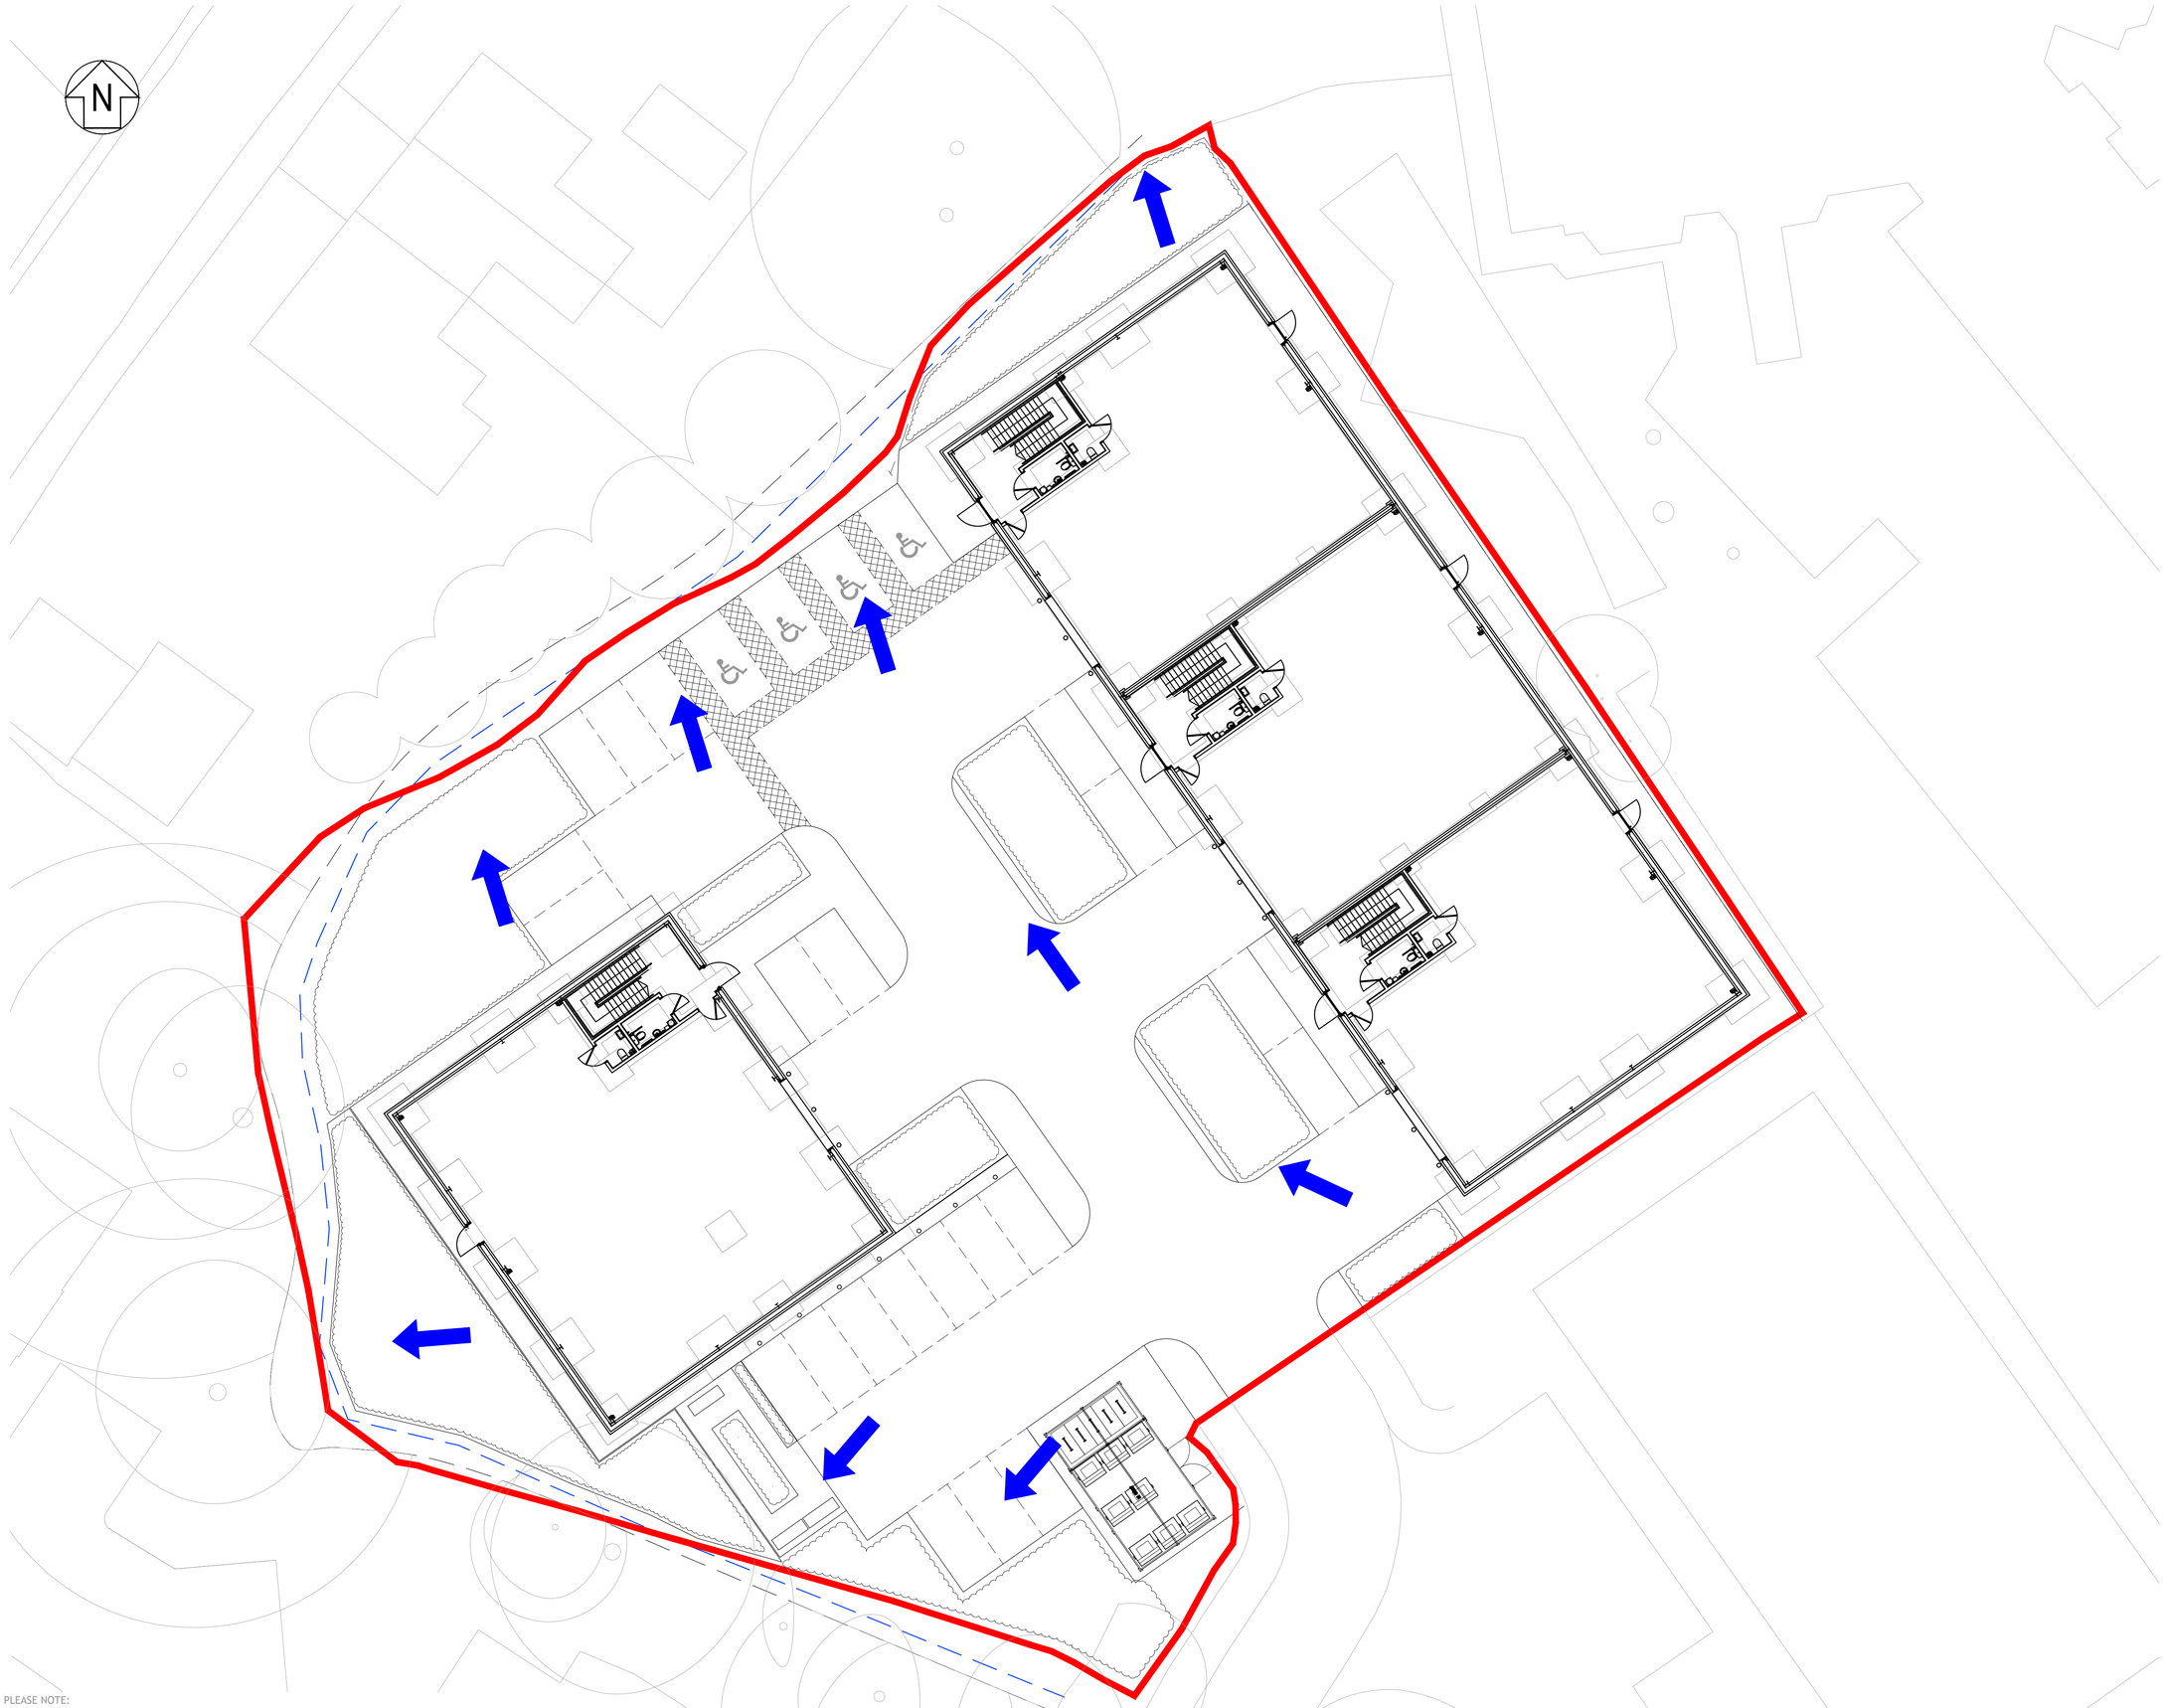

Notes

1. THIS DRAWING IS THE COPYRIGHT OF TIER CONSULT LTD AND CANNOT BE REPRODUCED IN ANY FORM WITHOUT WRITTEN CONSENT FROM THE COMPANY.
2. THIS DRAWING IS TO BE READ IN CONJUNCTION WITH ALL OTHER RELEVANT ARCHITECT'S, ENGINEER'S AND SPECIALIST'S DRAWINGS TOGETHER WITH THE APPROPRIATE SPECIFICATION.
3. ALL DIMENSIONS ARE IN MILLIMETRES UNO, FOR THE PURPOSES OF CONSTRUCTION THIS DRAWING MUST NOT BE SCALED AND ONLY WRITTEN DIMENSIONS USED. IT IS THE CONTRACTOR'S RESPONSIBILITY TO CHECK ALL DIMENSIONS ON SITE PRIOR TO CONSTRUCTION AND ANY DISCREPANCIES TO BE BROUGHT TO THE IMMEDIATE ATTENTION OF THE ENGINEER IN WRITING.
4. ALL LEVELS ARE IN METRES UNO & TO OS DATUM.

Legend:

EXPECTED ROUTE OF FLOOD WATER IN EVENT OF SYSTEM FAILURE

Rev	Date	By	Description	Chk	App
F1	15.05.2024	CCF	ASBUILT ISSUE	CCF	PJB

Status
ASBUILT

TIER CONSULT.
Richmond House,
Sandpiper Court,
Chester Business Park,
Chester | CH4 9QZ
T: 01244 684 900

Client

Project
ASHBROOK MOSS NOOK.

Title
FLOOD EXCEEDANCE PLAN.

Scale	Drawn	Revision
1:150@A1	C.C.FITTON	F1
Date	Checked	
06.08.2021	W.N.LLOYD	

Drawing No :
T_21_2463-55-04

PLEASE NOTE:
OVERALL BACKGROUND MAP INFORMATION PROVIDED BY ORDNANCE SURVEY DIGITAL DATA.
© CROWN COPYRIGHT 2021. ALL RIGHTS RESERVED. LICENCE NUMBER 100022432.

© Tier Consult
© Tier Consult