



- Notes**
1. All dimensions in mm, unless otherwise stated.
 2. Scaling from drawing if printed incorrectly may lead to errors.
 3. All information outside red line boundary shown for contextual purpose only.
 4. This drawing is to be read in conjunction with landscape general arrangement, planting schedules, details and specification.
 5. Refer to 0919-RFM-XX-00-DR-L-0015 for planting schedules.
 6. Refer to arboricultural impact assessment for full details of tree retention and removals

- Planting Notes**
7. Soft landscape contractor to undertake a briefing session with landscape architect prior to installation of planting on site.
 8. Planting to be installed in an evenly spaced staggered matrix, avoiding visible rows.
 9. All topsoil for the landscaping must be in accordance with the latest British Standards, BS 3882:2015.
 10. All subsoil to be in accordance with BS8601:2013.
 11. Tree pits to include 150mm depth of free draining gravel wrapped in geotextile membrane to base of pit.
 12. The base to all planting areas to be broken up / loosened and debris removed to promote good drainage.
 13. Container Grown Plants: To comply with the National Plant Specification. Shrubs shall be planted in pits min. 300 x 300 x 200mm depth. Roots are to be fully submerged beneath topsoil.
 14. Mulch: All Planting beds to receive 50mm ornamental mulch.
 15. Watering: Plant only into moist soil and water thoroughly to the full depth of soil immediately after planting.
 16. Wildflower meadows subject to seasonal mowing regime
 17. Any proposed plant substitution shall be agreed with the landscape architect prior to ordering.


KEY

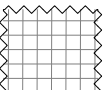


Existing hedge to be retained
Refer to Arboricultural Impact Assessment (June 2022)

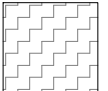

Existing planting to be retained
To be reviewed on site by landscape architects

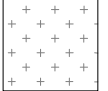

Species rich lawn
Refer to drawing L-0015 for detailed specification

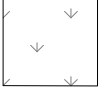

Wildflower meadow
Refer to drawing L-0015 for detailed specification



Proposed hedge planting
Refer to drawing L-0015 for detailed specification



Proposed semi-mature tree in pot



Existing trees to be retained
Refer to Arboricultural Impact Assessment (June 2022)



Proposed multi-stem tree
Underground guyed



Proposed single-stem tree
Underground guyed



Rear Boundary Planting
Refer to drawing L-0015 for detailed specification



Historic Building Edge Planting
Refer to drawing L-0015 for detailed specification



Woodthorpe Courtyard Planting
Refer to drawing L-0015 for detailed specification




Building 3 & 4 Courtyard Planting
Refer to drawing L-0015 for detailed specification



Tree Understory Planting
Refer to drawing L-0015 for detailed specification

Rev P05

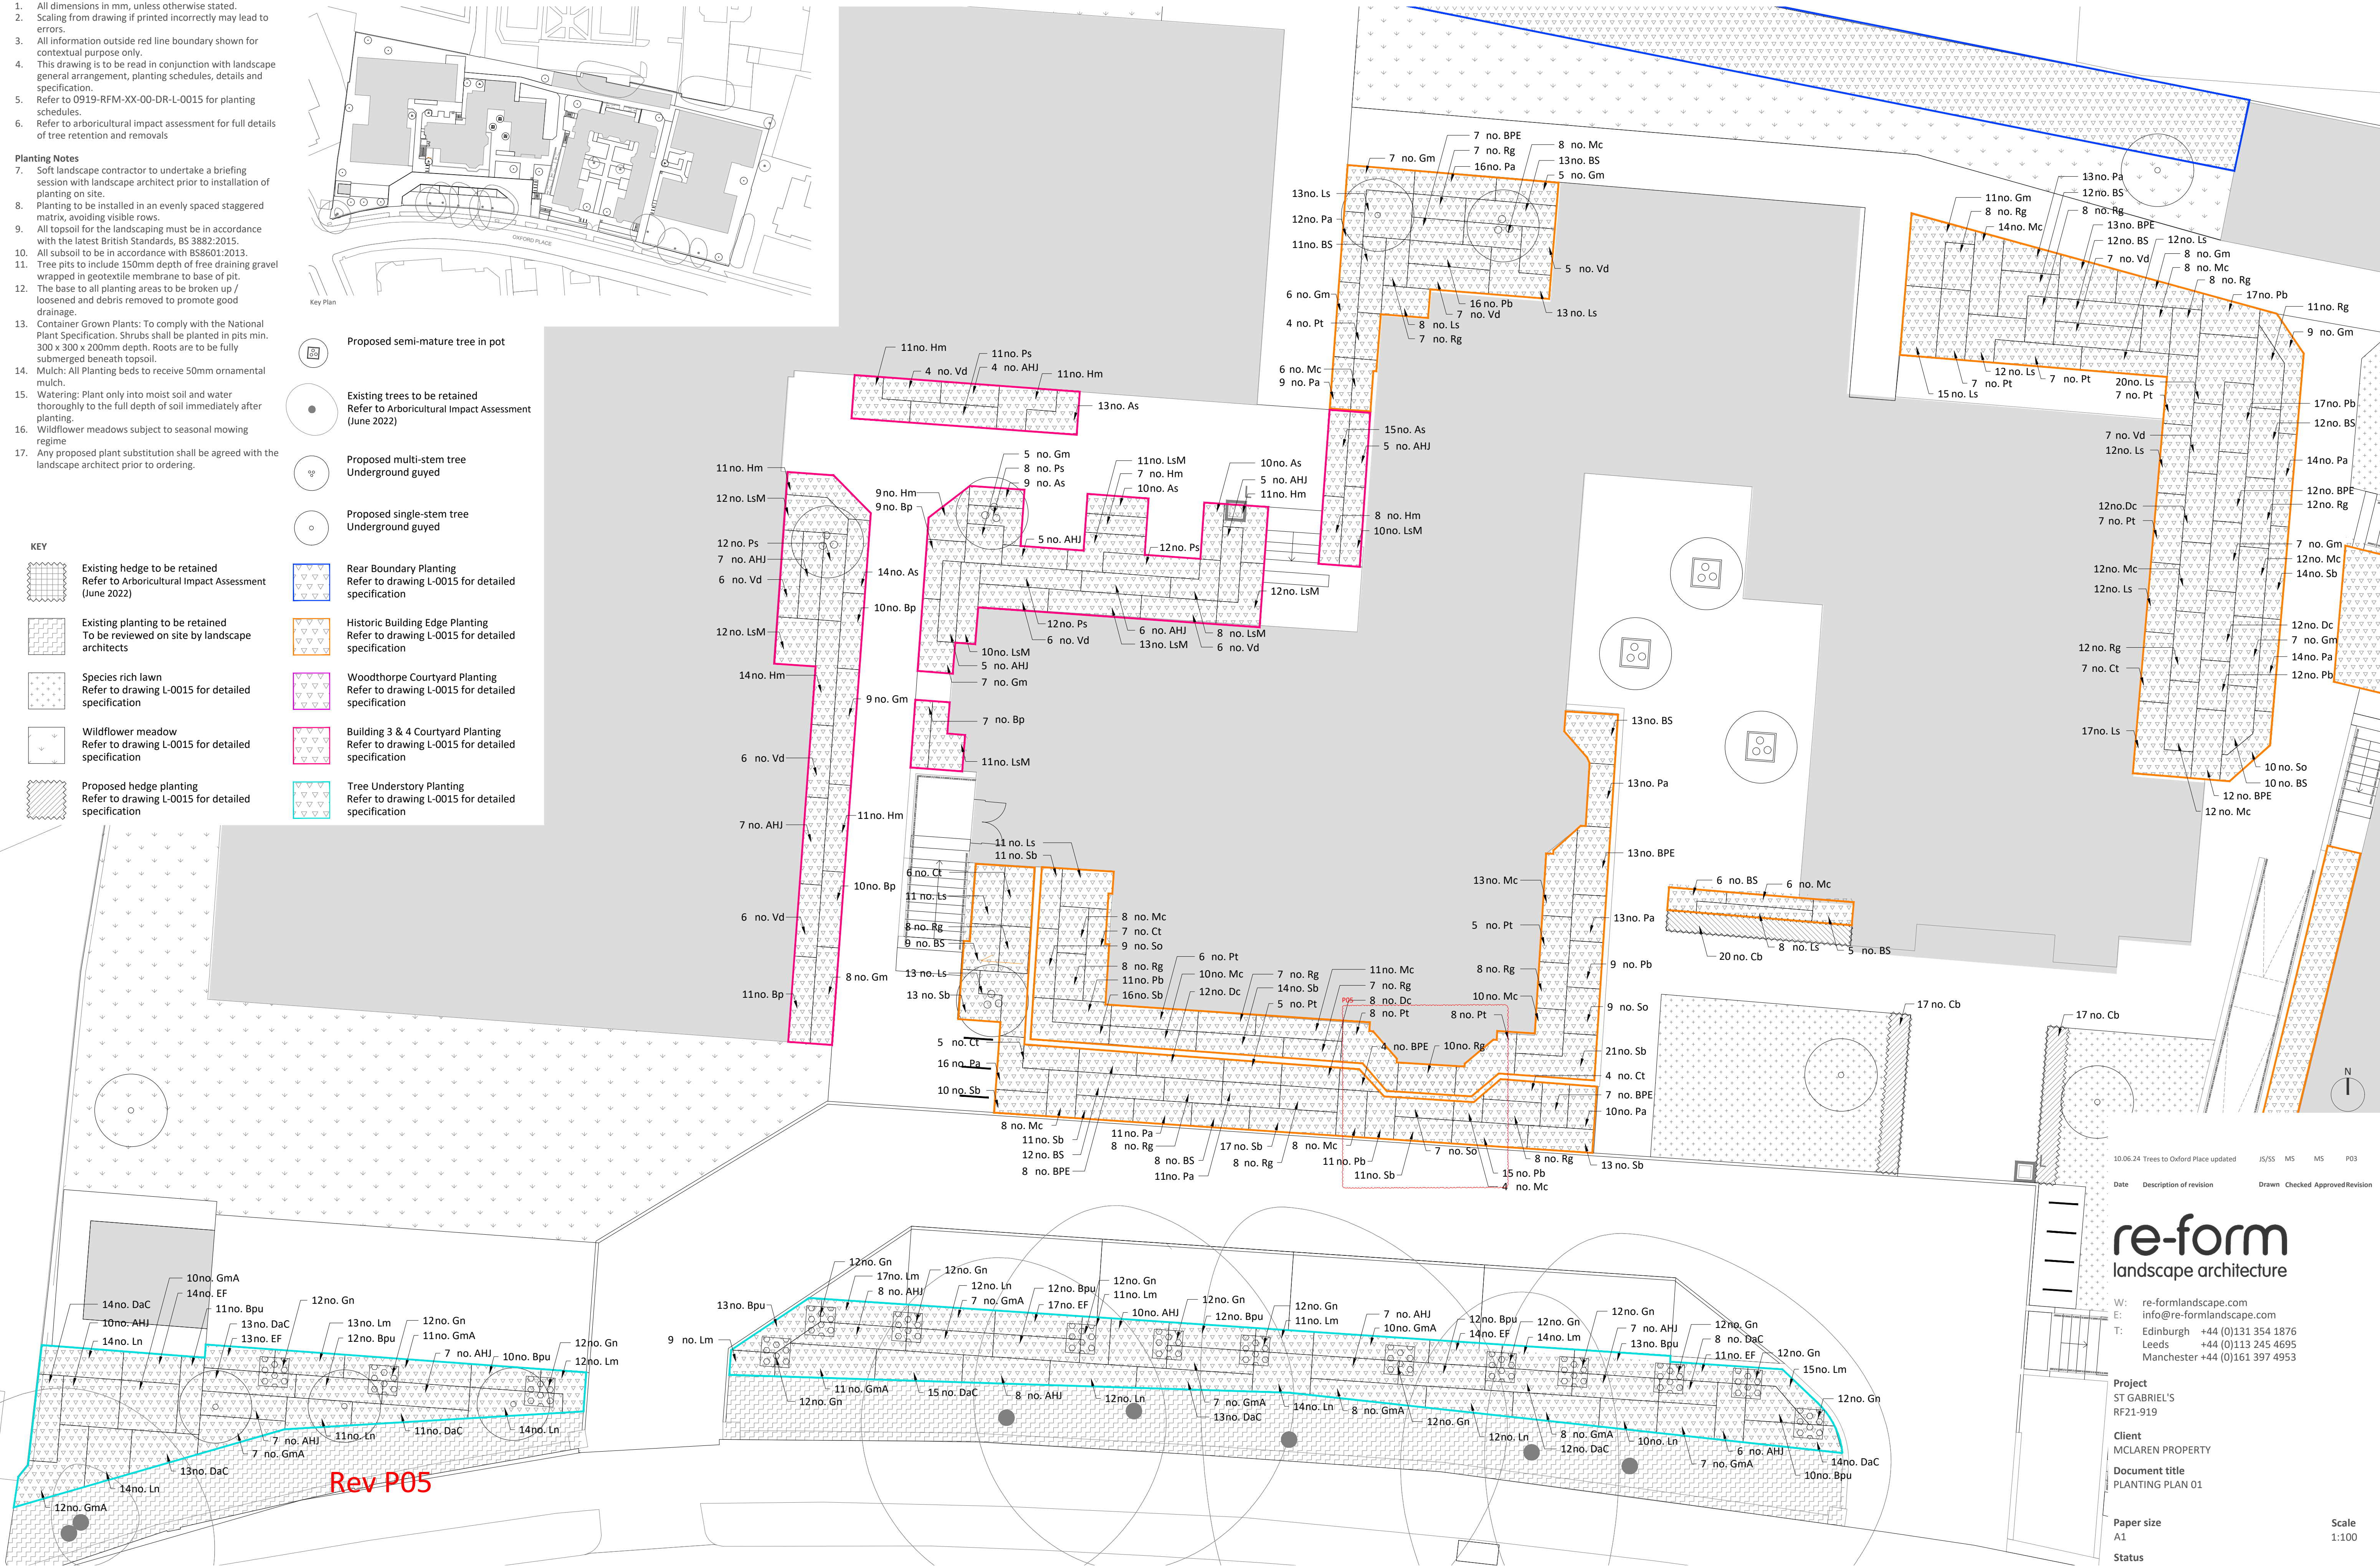

10.06.24 Trees to Oxford Place updated JS/SS MS MS P03

Date Description of revision Drawn Checked Approved/Revision

re-form
landscape architecture

W: re-formlandscape.com
E: info@re-formlandscape.com
T: Edinburgh +44 (0)131 354 1876
Leeds +44 (0)113 245 4695
Manchester +44 (0)161 397 4953

Project
ST GABRIEL'S
RF21-919

Client
MCLAREN PROPERTY
Document title
PLANTING PLAN 01

Paper size
A1
Scale
1:100
Status
REVIEW AND ACCEPTANCE
Drawing number
0919-RFM-XX-00-DR-L-0012
S5
Revision
P03

© re-form landscape architecture