


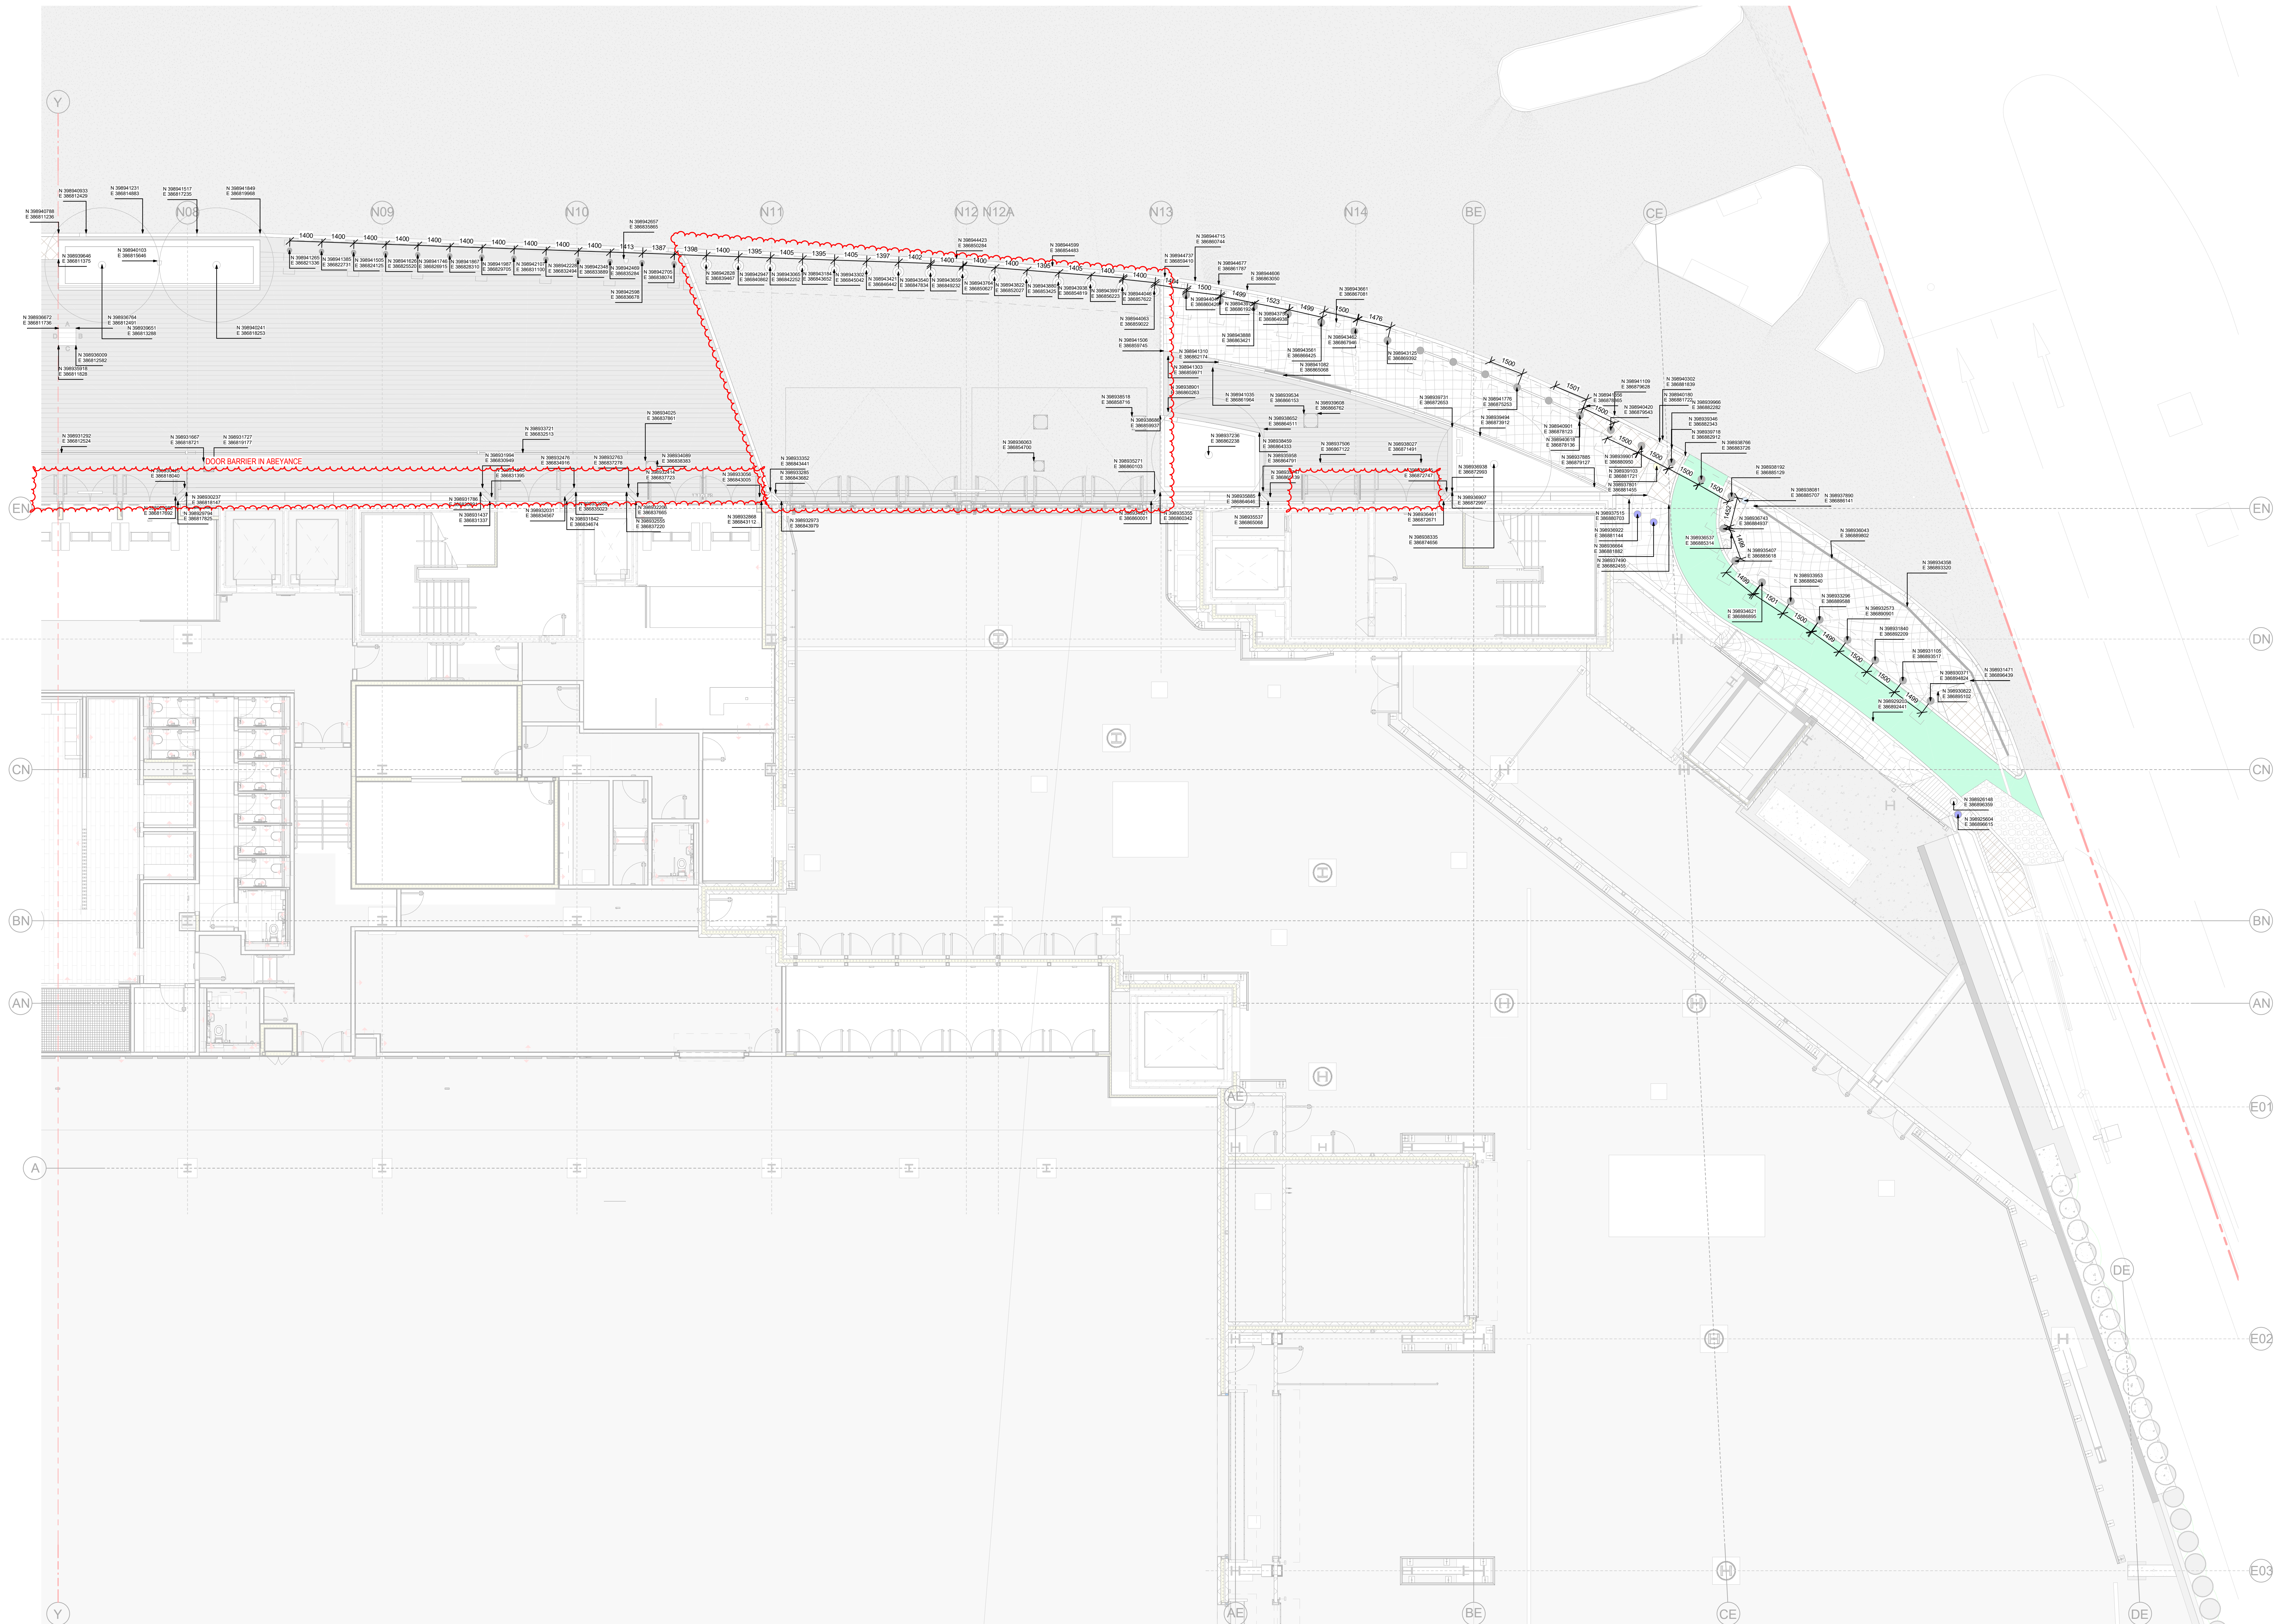

Suitability Code (as defined in ISO 19650-2:2018)

Work in Progress (WIP)

S0 - Under Review

Shared (Non-Contractual)

S1 - Suitable for co-ordination

S2 - Suitable for information

S3 - Suitable for review & comment

S4 - Suitable for stage approval

S5 - Withdrawn

S6 - Suitable for PM authorisation

S7 - Suitable for AM authorisation

Published (Contractual)

A1, A2, A3, etc. - Authorised and accepted

B1, B2, B3, etc. - Partial sign-off (with comments)

Published (AIM Acceptance)

CR - As constructed record document

KEY PLAN

KEY

PLANNING APPLICATION BOUNDARY

COORDINATES AT SPOT

DRAINAGE PENETRATION OUTLET IN STRUCTURAL SLAB

THIS DRAWING IS ONLY TO SCALE IF IT IS REPRODUCED AT THE CORRECT PAPER SIZE

1:100@A0

ALL INTERNAL LAYOUTS AND USES ARE SHOWN FOR ILLUSTRATIVE PURPOSES ONLY AND ARE NOT FOR DETERMINATION

Safety, Health and Environmental Information

In addition to the hazards / risks normally associated with the types of work detailed on this drawing, note the following risks and information:

Construction See risk register

No abnormal risks identified with this package of work.

For information relating to Live, Closing and Maintenance see the Health and Safety File. It is assumed that all works will be carried out by a competent contractor working, where appropriate, to an approved method statement.

04/2021

POPULOUS®

14 BLADES COURT | DEodar ROAD | LONDON | SW16 2NU | UNITED KINGDOM

TELEPHONE +44 (0)20 8874 7666 FACSIMILE +44 (0)20 8874 7470

ALL PRODUCTION & INTELLECTUAL PROPERTY RIGHTS RESERVED © POPULOUS 2020

REVISIONS

REV DATE DESCRIPTION

00 12/02/2021 STAGE 4B BOLLARDS SCOPE ISSUE

001 10/12/2021 HARD LANDSCAPE PACKAGE FOR CONSTRUCTION

002 12/10/2022 JUNCTION BOLLARDS LAYOUT UPDATED

003 24/04/2023 DRAINAGE UPDATE

004 10/05/2023 PLANTERS UPDATE

005 22/05/2023 S278 UPDATE

006 10/06/2023 KERBS UPDATE

007 07/06/2023 JNE KERBS LINE UPDATE

008 09/06/2023 ADDITIONAL INFORMATION INCLUDED

009 13/10/2023 T&A HARD LANDSCAPE GRADING & DRAINAGE AND SETTING OUT UPDATE

010 22/02/2024 PAVING UPDATES IN RESPONSE TO RET 4807 BAM S1 1700150 E&I 272 AND LIGHTING COLUMN LOCATION. UPDATES BASED ON RET 4808-4833. TOTEM SETTING OUT BASED ON RET 4877

project name

Co-op Live

the SETTING OUT ENLARGED PLAN

SPORTCITY WAY JUNCTION

GROUND FLOOR

scale 1:100@A0

drawn FP

project no.

4933

date 12/02/21

checked TJ

substanty

project code

original

version

level

type

number

reference

BRA-POP-ZZ-GF-DR-L-8170

C010