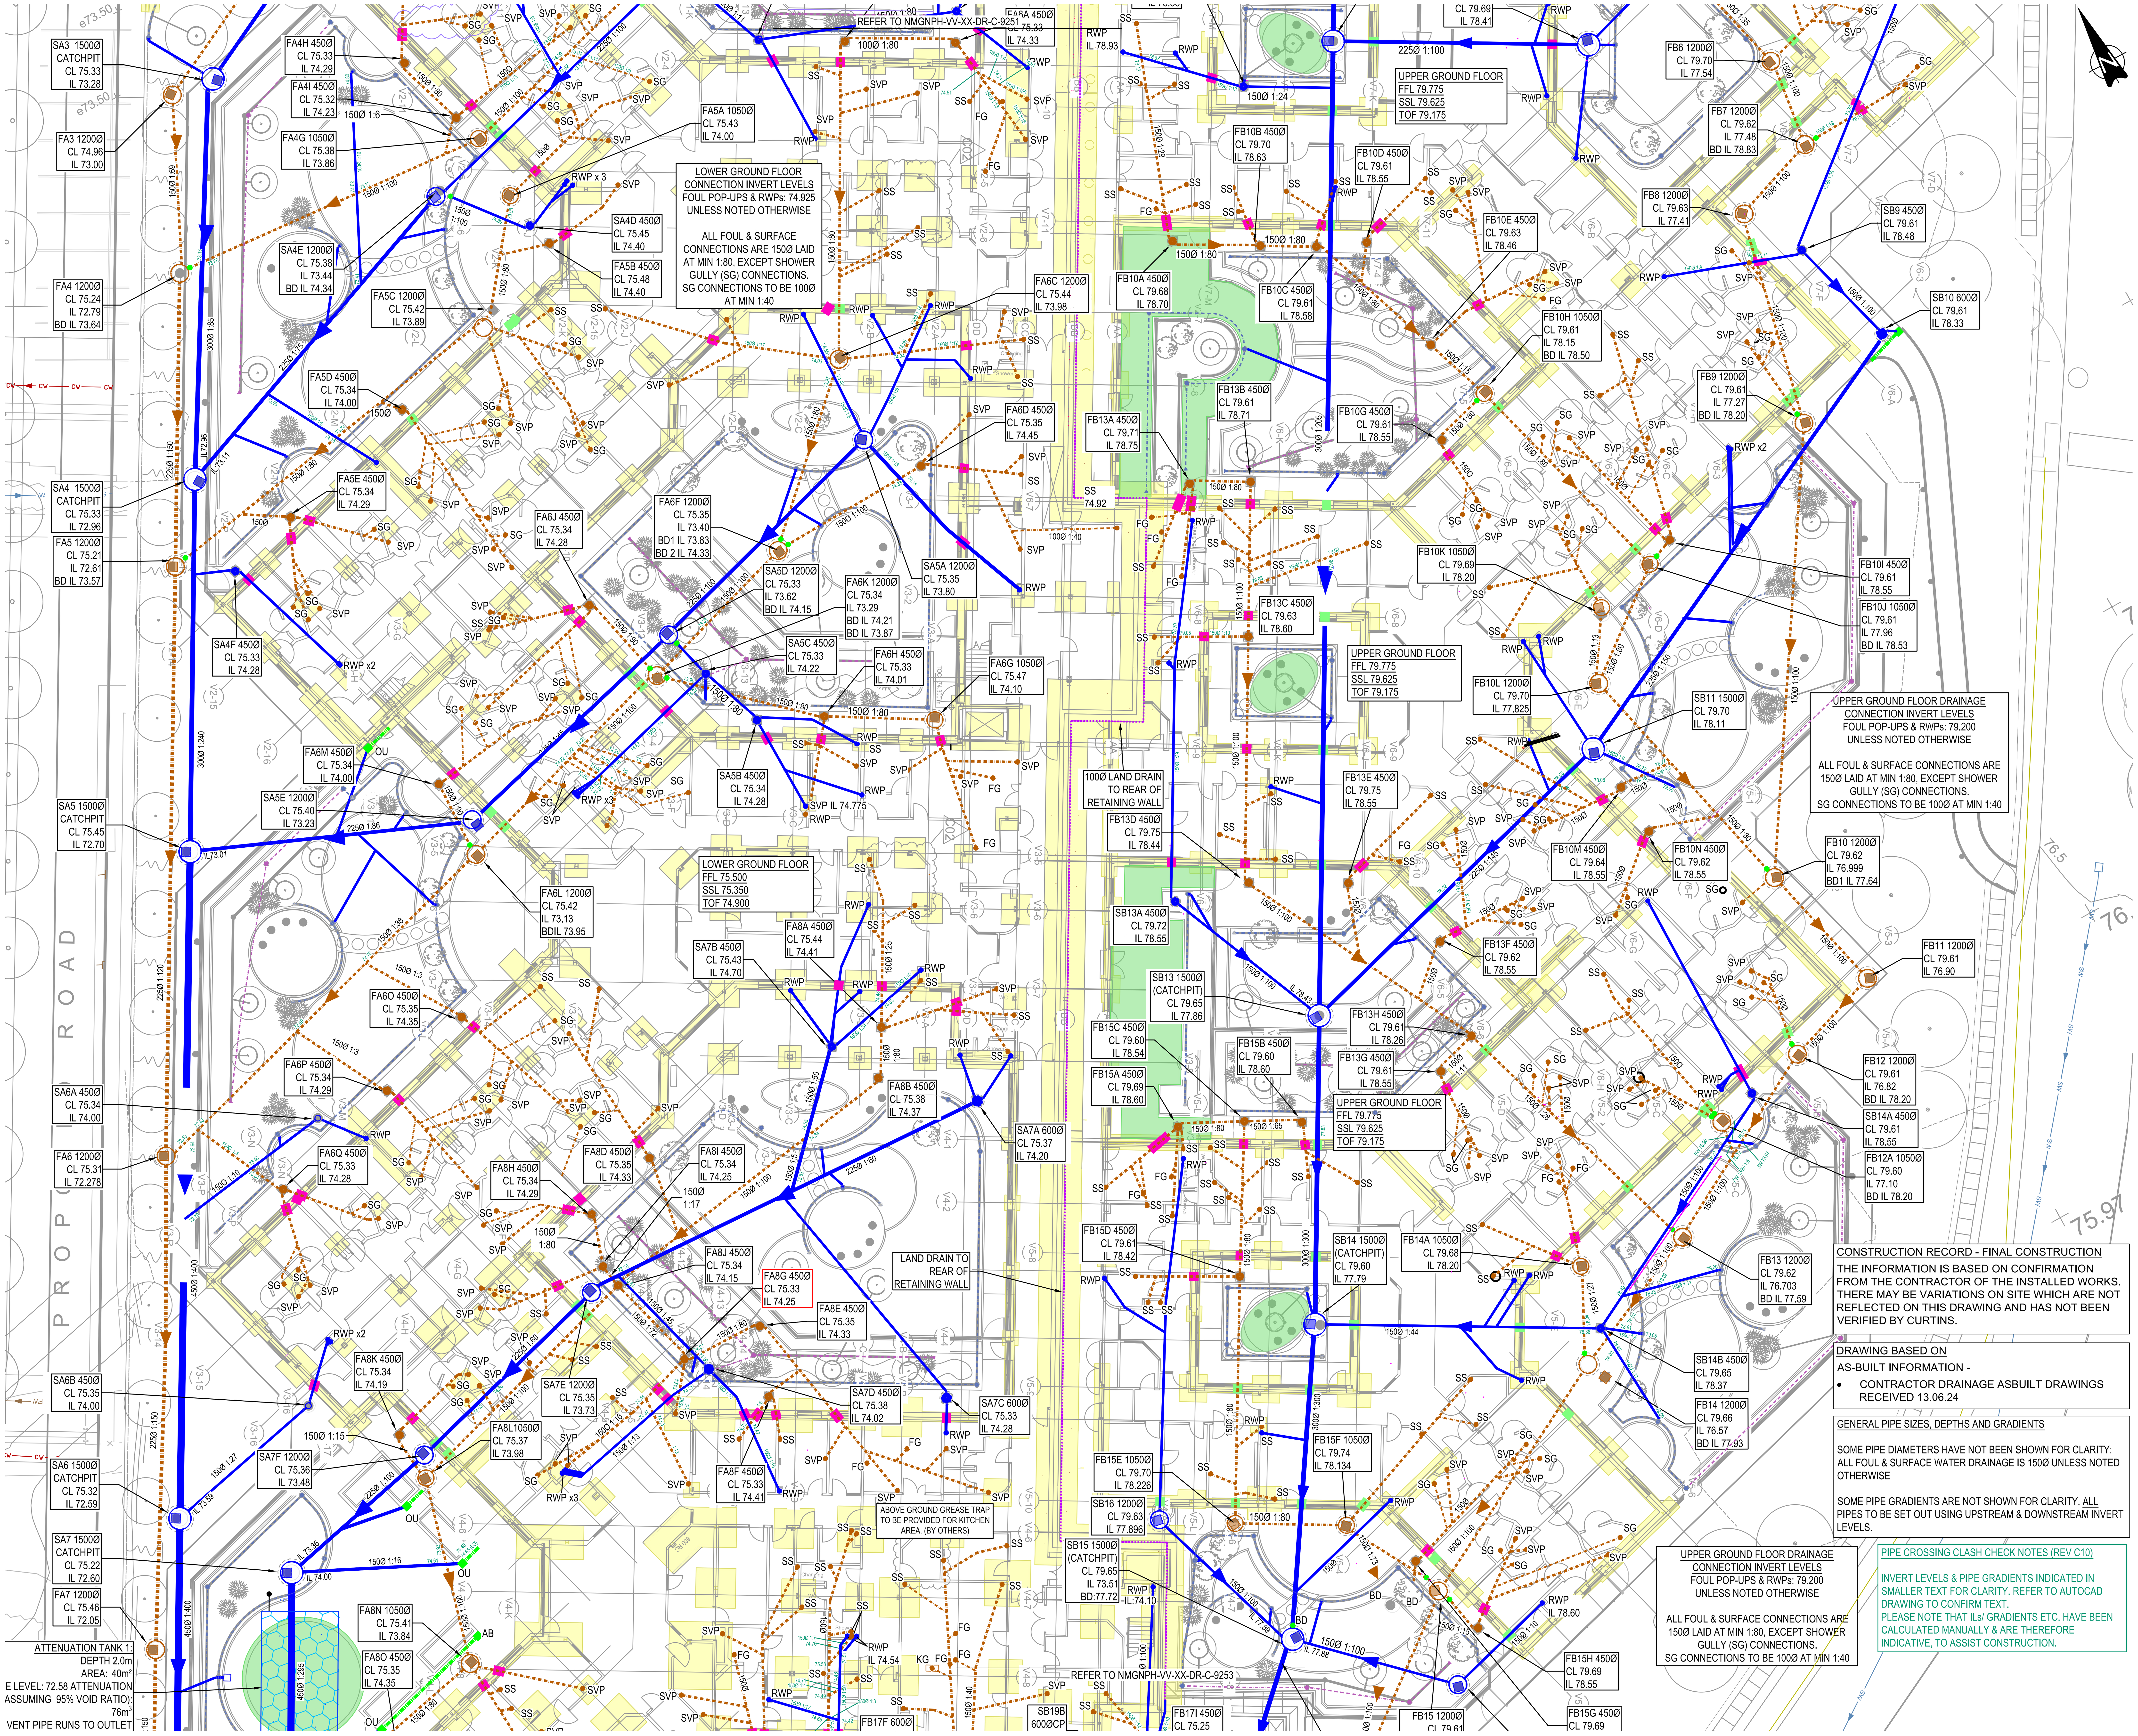


GENERAL NOTES:

FOR DRAWING REFERENCES REFER TO DRAWING NMGNPH-CUR-VV-XX-DR-C-9250
FOR FULL DRAINAGE NOTES REFER TO DRAWING NMGNPH-CUR-VV-XX-DR-C-9260

KEY:

- SITE BOUNDARY BASED ON LANDSCAPE ARCHITECT'S LAYOUT
- EXISTING PUBLIC COMBINED SEWER
- EXISTING PRIVATE COMBINED DRAINAGE
- EXISTING PRIVATE SURFACE WATER DRAINAGE
- EXISTING PRIVATE FOUL DRAINAGE
- PROPOSED COMBINED MANHOLE
- PROPOSED FOUL DRAINAGE
- PROPOSED FOUL DRAINAGE MANHOLE/ INSPECTION CHAMBER
- PROPOSED SURFACE WATER DRAINAGE
- PROPOSED SURFACE WATER ROUTED THROUGH PETROL INTERCEPTOR
- PROPOSED SURFACE WATER MANHOLE/ INSPECTION CHAMBER
- PROPOSED FLOW CONTROL MANHOLE
- PROPOSED CELLULAR ATTENUATION TANK
- PROPOSED ARBORCELL
- PROPOSED BACKDROP
- PROPOSED ROAD GULLY
- PROPOSED GULLY TO SEATING AREA
- PROPOSED FOUL CONNECTION
  SVP - SOIL VENT PIPE
  SS - STUB STACK
  SG - SHOWER GULLY
  FG - FOUL GULLY
  KG - MAIN KITCHEN COMPACT DRAIN
- PROPOSED RAINWATER PIPE
- DRAINAGE CAST PASSES THROUGH STRIP FOOTING*
- DRAINAGE PASSES UNDER STRIP FOOTING**
- LINEAR DRAINAGE CHANNEL GATIC CASTSLOT TREADSAFE (150 UNLESS NOTED OTHERWISE)
- AB LINEAR DRAINAGE ACCESS BOX
- OU LINEAR DRAINAGE OUTLET UNIT
- PERFORATED PIPE IN FILTER DRAIN 150Ø UNLESS NOTED OTHERWISE.
- RODDING EYE FOR LAND DRAIN
- 300Ø INSPECTION CHAMBER ON LAND DRAIN
- 150Ø RETAINING WALL DRAIN
- TREE PIT DRAINAGE - 150Ø PERFORATED PIPE AND INFILTRATION TANK
- PERMEABLE PAVING

* ALL DRAINAGE PASSES ABOVE FOUNDATION UNLESS NOTED OTHERWISE

DRAINAGE TO BE ABANDONED NOT SHOWN FOR CLARITY. REFER TO DRAINAGE REMOVAL DRAWING NMGNPH-VV-XX-DR-C-9254

CONSTRUCTION RECORD - FINAL CONSTRUCTION

THE INFORMATION IS BASED ON CONFIRMATION FROM THE CONTRACTOR OF THE INSTALLED WORKS. THERE MAY BE VARIATIONS ON SITE WHICH ARE NOT REFLECTED ON THIS DRAWING AND HAS NOT BEEN VERIFIED BY CURTINS.

DRAWING BASED ON

AS-BUILT INFORMATION -

- CONTRACTOR DRAINAGE ASBUILT DRAWINGS RECEIVED 13.06.24

GENERAL PIPE SIZES, DEPTHS AND GRADIENTS

SOME PIPE DIAMETERS HAVE NOT BEEN SHOWN FOR CLARITY: ALL FOUL & SURFACE WATER DRAINAGE IS 150Ø UNLESS NOTED OTHERWISE

SOME PIPE GRADIENTS ARE NOT SHOWN FOR CLARITY. ALL PIPES TO BE SET OUT USING UPSTREAM & DOWNSTREAM INVERT LEVELS.

PIPE CROSSING CLASH CHECK NOTES (REV C10)

INVERT LEVELS & PIPE GRADIENTS INDICATED IN SMALLER TEXT FOR CLARITY. REFER TO AUTOCAD DRAWING TO CONFIRM TEXT.
PLEASE NOTE THAT ILs/ GRADIENTS ETC. HAVE BEEN CALCULATED MANUALLY & ARE THEREFORE INDICATIVE, TO ASSIST CONSTRUCTION.

Rev:	Description:	Date:	By:	Chkd:
CR01	FINAL CONSTRUCTION	26.07.24	KS	ATL

curtins
Merchant Exchange, 17-19 Whitworth Street West, Manchester, M1 5WG
0161 236 2394
manchester@curtins.com
www.curtins.com
Civils & Structures • Transport Planning • Environmental • Infrastructure • Geotechnical • Conservation & Heritage • Principal Designer
Birmingham • Bristol • Cambridge • Cardiff • Douglas • Dublin • Edinburgh • Glasgow • Kendal • Leeds • Liverpool • London • Manchester • Nottingham

Status: CONSTRUCTION RECORD


Project: NORTH VIEW

Drg Title: PROPOSED 1:200 DRAINAGE LAYOUT SHEET 2

Size:	Date:	Drawn By:	Designed By:	Checked By:
A1	18/01/21	ATL	ATL	MW
Scale: 1:500				

Project No:	Originator:	Volume:	Level:	Type:	Role:	Category / Number:	Rev:
NMGNPH	CUR	VV	XX	DR	C	9252	CR01

\\ma-fs-1\Projects\075001 - 076000\075856 - New Park House\Q4-Production\4A-Models-Drawings\CICAD\92\

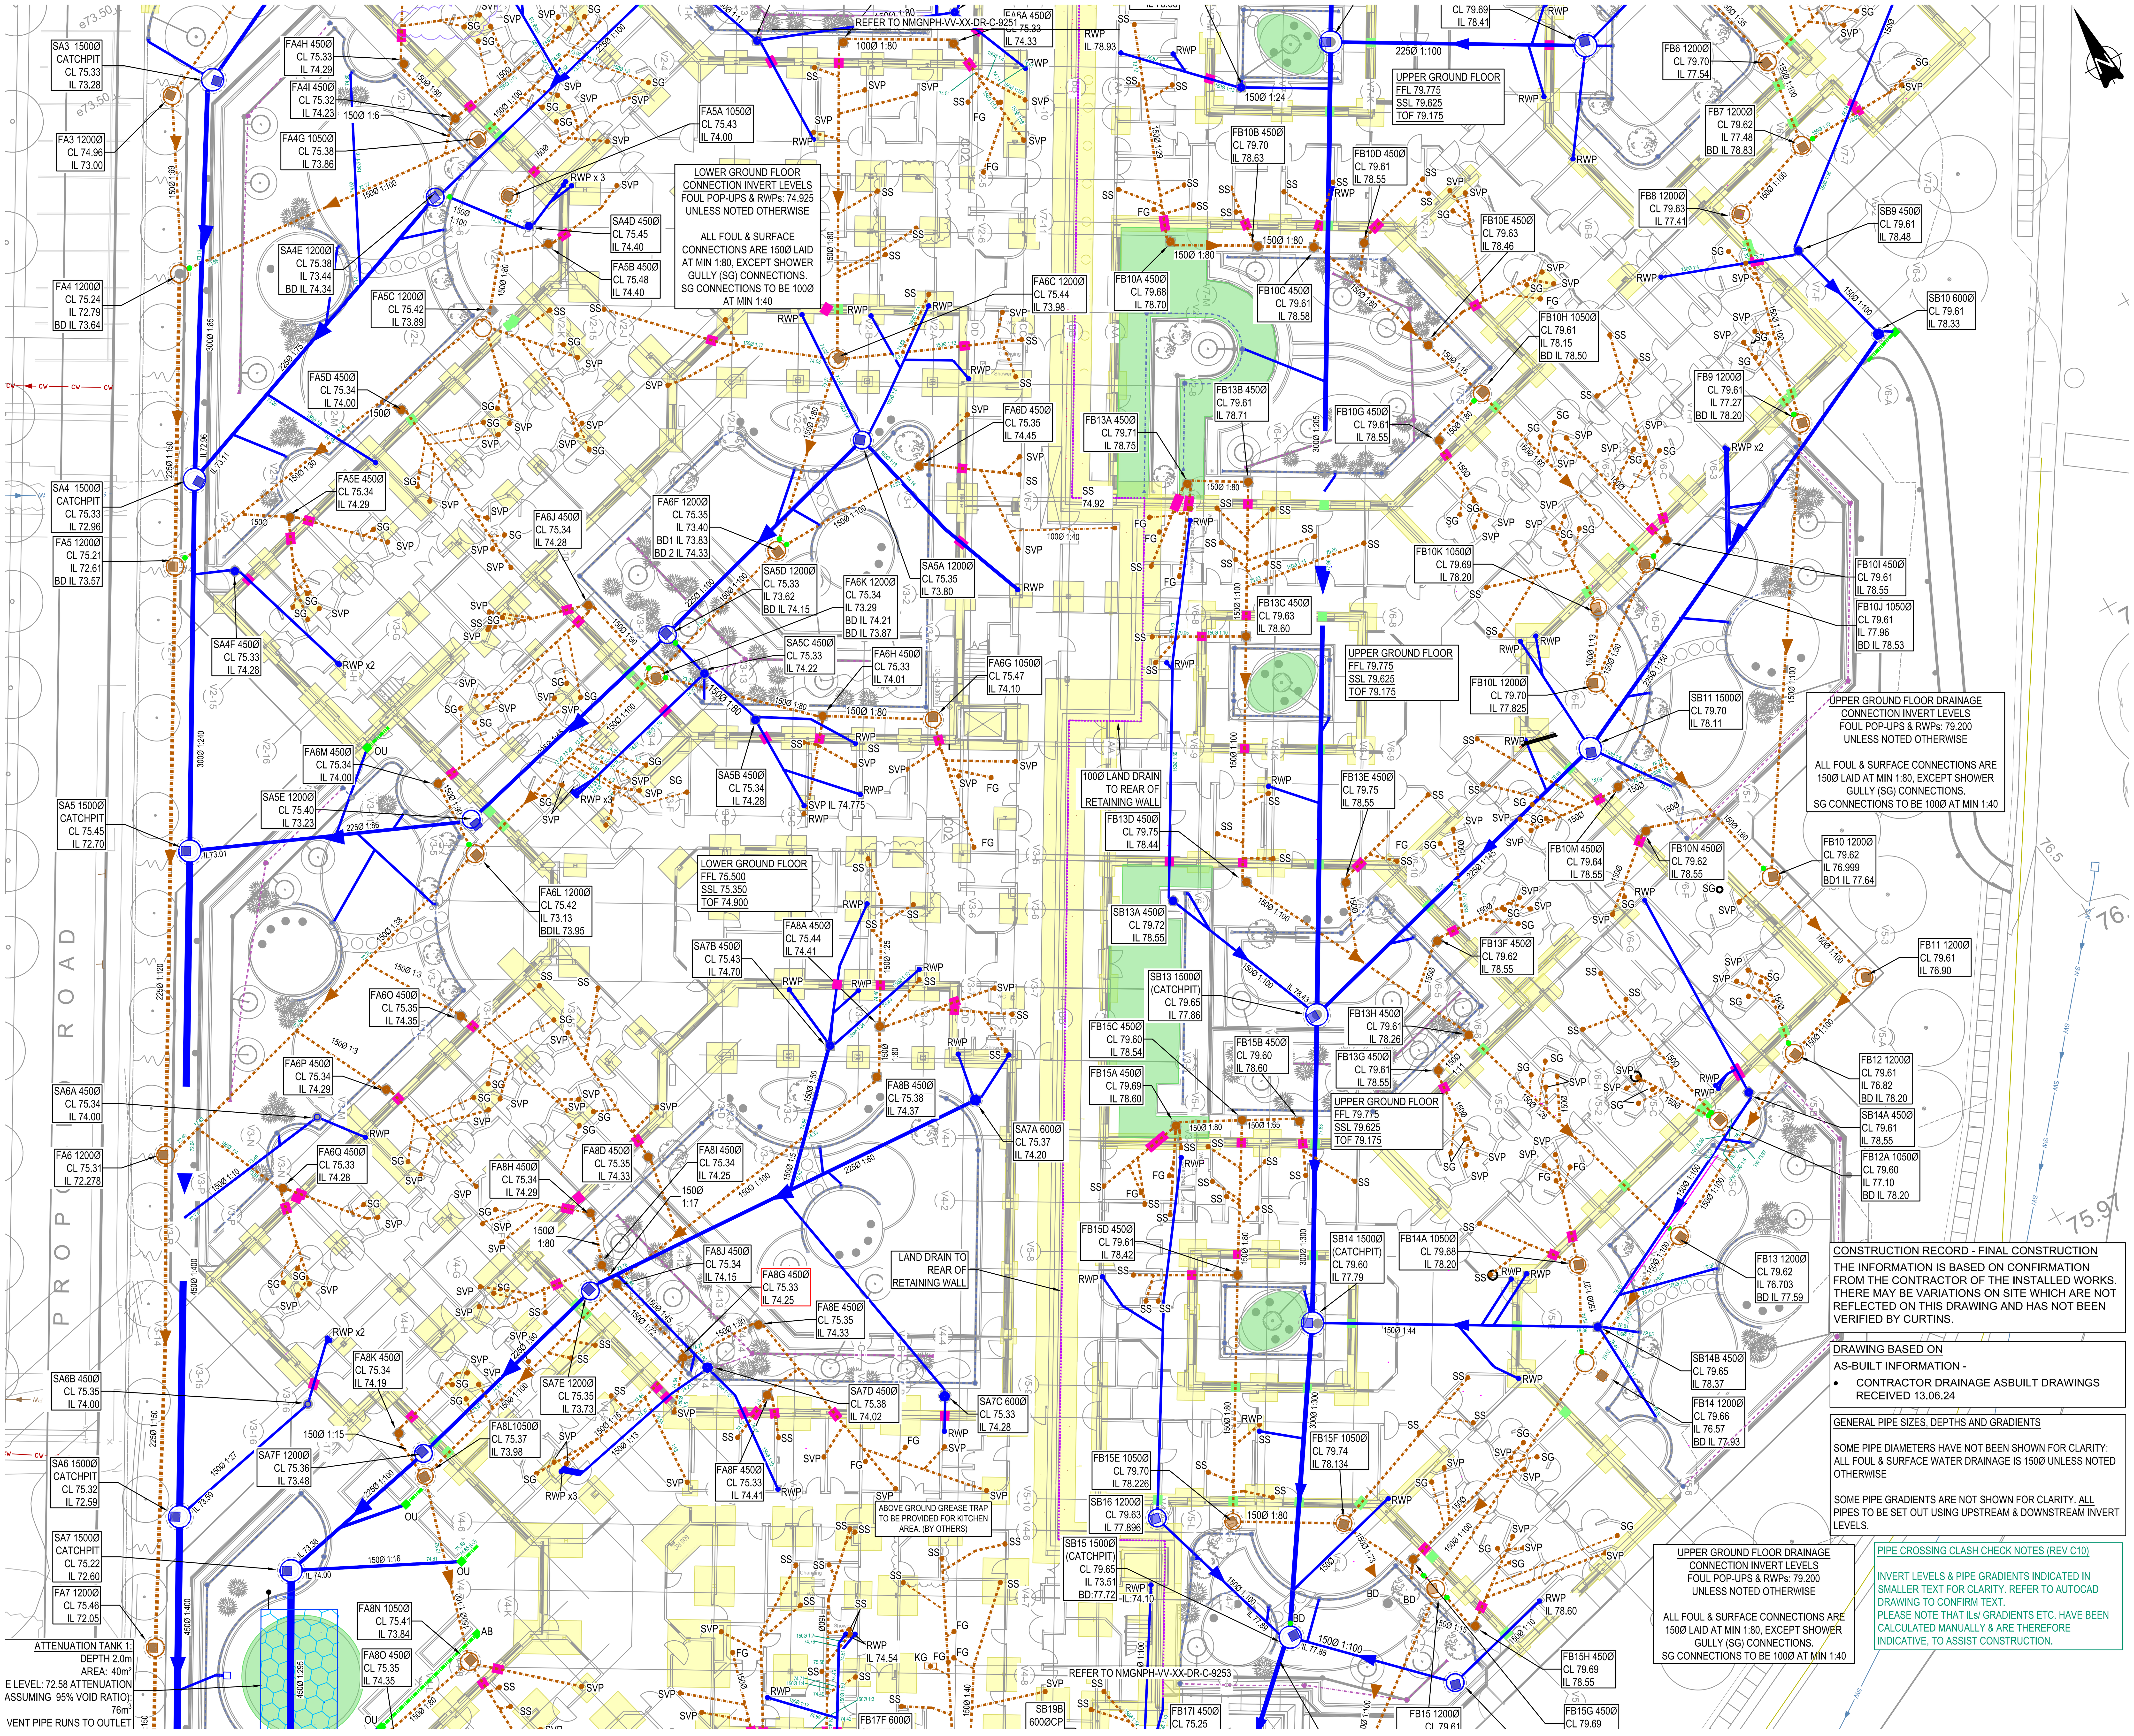

CONSTRUCTION RECORD - FINAL CONSTRUCTION

THE INFORMATION IS BASED ON CONFIRMATION FROM THE CONTRACTOR OF THE INSTALLED WORKS. THERE MAY BE VARIATIONS ON SITE WHICH ARE NOT REFLECTED ON THIS DRAWING AND HAS NOT BEEN VERIFIED BY CURTINS.

DRAWING BASED ON

AS-BUILT INFORMATION -

- CONTRACTOR DRAINAGE ASBUILT DRAWINGS RECEIVED 13.06.24

GENERAL PIPE SIZES, DEPTHS AND GRADIENTS

SOME PIPE DIAMETERS HAVE NOT BEEN SHOWN FOR CLARITY: ALL FOUL & SURFACE WATER DRAINAGE IS 150Ø UNLESS NOTED OTHERWISE

SOME PIPE GRADIENTS ARE NOT SHOWN FOR CLARITY. ALL PIPES TO BE SET OUT USING UPSTREAM & DOWNSTREAM INVERT LEVELS.

PIPE CROSSING CLASH CHECK NOTES (REV C10)

INVERT LEVELS & PIPE GRADIENTS INDICATED IN SMALLER TEXT FOR CLARITY. REFER TO AUTOCAD DRAWING TO CONFIRM TEXT.
PLEASE NOTE THAT ILs/ GRADIENTS ETC. HAVE BEEN CALCULATED MANUALLY & ARE THEREFORE INDICATIVE, TO ASSIST CONSTRUCTION.

GENERAL NOTES:

FOR DRAWING REFERENCES REFER TO DRAWING NMGNPH-CUR-VV-XX-DR-C-9250
FOR FULL DRAINAGE NOTES REFER TO DRAWING NMGNPH-CUR-VV-XX-DR-C-9260

KEY:

- SITE BOUNDARY BASED ON LANDSCAPE ARCHITECT'S LAYOUT
- EXISTING PUBLIC COMBINED SEWER
- CW — CW EXISTING PRIVATE COMBINED DRAINAGE
- SW EXISTING PRIVATE SURFACE WATER DRAINAGE
- FW EXISTING PRIVATE FOUL DRAINAGE
- PROPOSED COMBINED MANHOLE
- PROPOSED FOUL DRAINAGE
- PROPOSED FOUL DRAINAGE MANHOLE/ INSPECTION CHAMBER
- PROPOSED SURFACE WATER DRAINAGE
- PROPOSED SURFACE WATER ROUTED THROUGH PETROL INTERCEPTOR
- PROPOSED SURFACE WATER MANHOLE/ INSPECTION CHAMBER
- PROPOSED FLOW CONTROL MANHOLE
- PROPOSED CELLULAR ATTENUATION TANK
- PROPOSED ARBORCELL
- PROPOSED BACKDROP
- PROPOSED ROAD GULLY
- PROPOSED GULLY TO SEATING AREA
- PROPOSED FOUL CONNECTION
  - SVP - SOIL VENT PIPE
  - SS - STUB STACK
  - SG - SHOWER GULLY
  - FG - FOUL GULLY
  - KG - MAIN KITCHEN COMPACT DRAIN
- PROPOSED RAINWATER PIPE
- DRAINAGE CAST PASSES THROUGH STRIP FOOTING*
- DRAINAGE PASSES UNDER STRIP FOOTING**
- LINEAR DRAINAGE CHANNEL GATIC CASTSLOT TREADSAFE (150 UNLESS NOTED OTHERWISE)
- AB LINEAR DRAINAGE ACCESS BOX
- OU LINEAR DRAINAGE OUTLET UNIT
- PERFORATED PIPE IN FILTER DRAIN 150Ø UNLESS NOTED OTHERWISE.
- RODDING EYE FOR LAND DRAIN
- 300Ø INSPECTION CHAMBER ON LAND DRAIN
- 150Ø RETAINING WALL DRAIN
- TREE PIT DRAINAGE - 150Ø PERFORATED PIPE AND INFILTRATION TANK
- PERMEABLE PAVING

* ALL DRAINAGE PASSES ABOVE FOUNDATION UNLESS NOTED OTHERWISE

DRAINAGE TO BE ABANDONED NOT SHOWN FOR CLARITY. REFER TO DRAINAGE REMOVAL DRAWING NMGNPH-VV-XX-DR-C-9254

Rev:	Description:	Date:	By:	Chkd:
CR01	FINAL CONSTRUCTION	26.07.24	KS	ATL

curtins

Merchant Exchange, 17-19 Whitworth Street West, Manchester, M1 5WG
0161 236 2394
manchester@curtins.com
www.curtins.com

Civils & Structures • Transport Planning • Environmental • Infrastructure • Geotechnical • Conservation & Heritage • Principal Designer
Birmingham • Bristol • Cambridge • Cardiff • Douglas • Dublin • Edinburgh • Glasgow • Kendal • Leeds • Liverpool • London • Manchester • Nottingham

Status: CONSTRUCTION RECORD

Project: NORTH VIEW

Drg Title: PROPOSED 1:200 DRAINAGE LAYOUT SHEET 2

Size:	Date:	Drawn By:	Designed By:	Checked By:
A1	18/01/21	ATL	ATL	MW
Scale: 1:500				

Project No:	Originator:	Volume:	Level:	Type:	Role:	Category / Number:	Rev:
NMGNPH	CUR	VV	XX	DR	C	9252	CR01

\\ma-fs-1\Projects\075001 - 076000\075856 - New Park House\Q4-Production\4A-Models-Drawings\CAD\92\