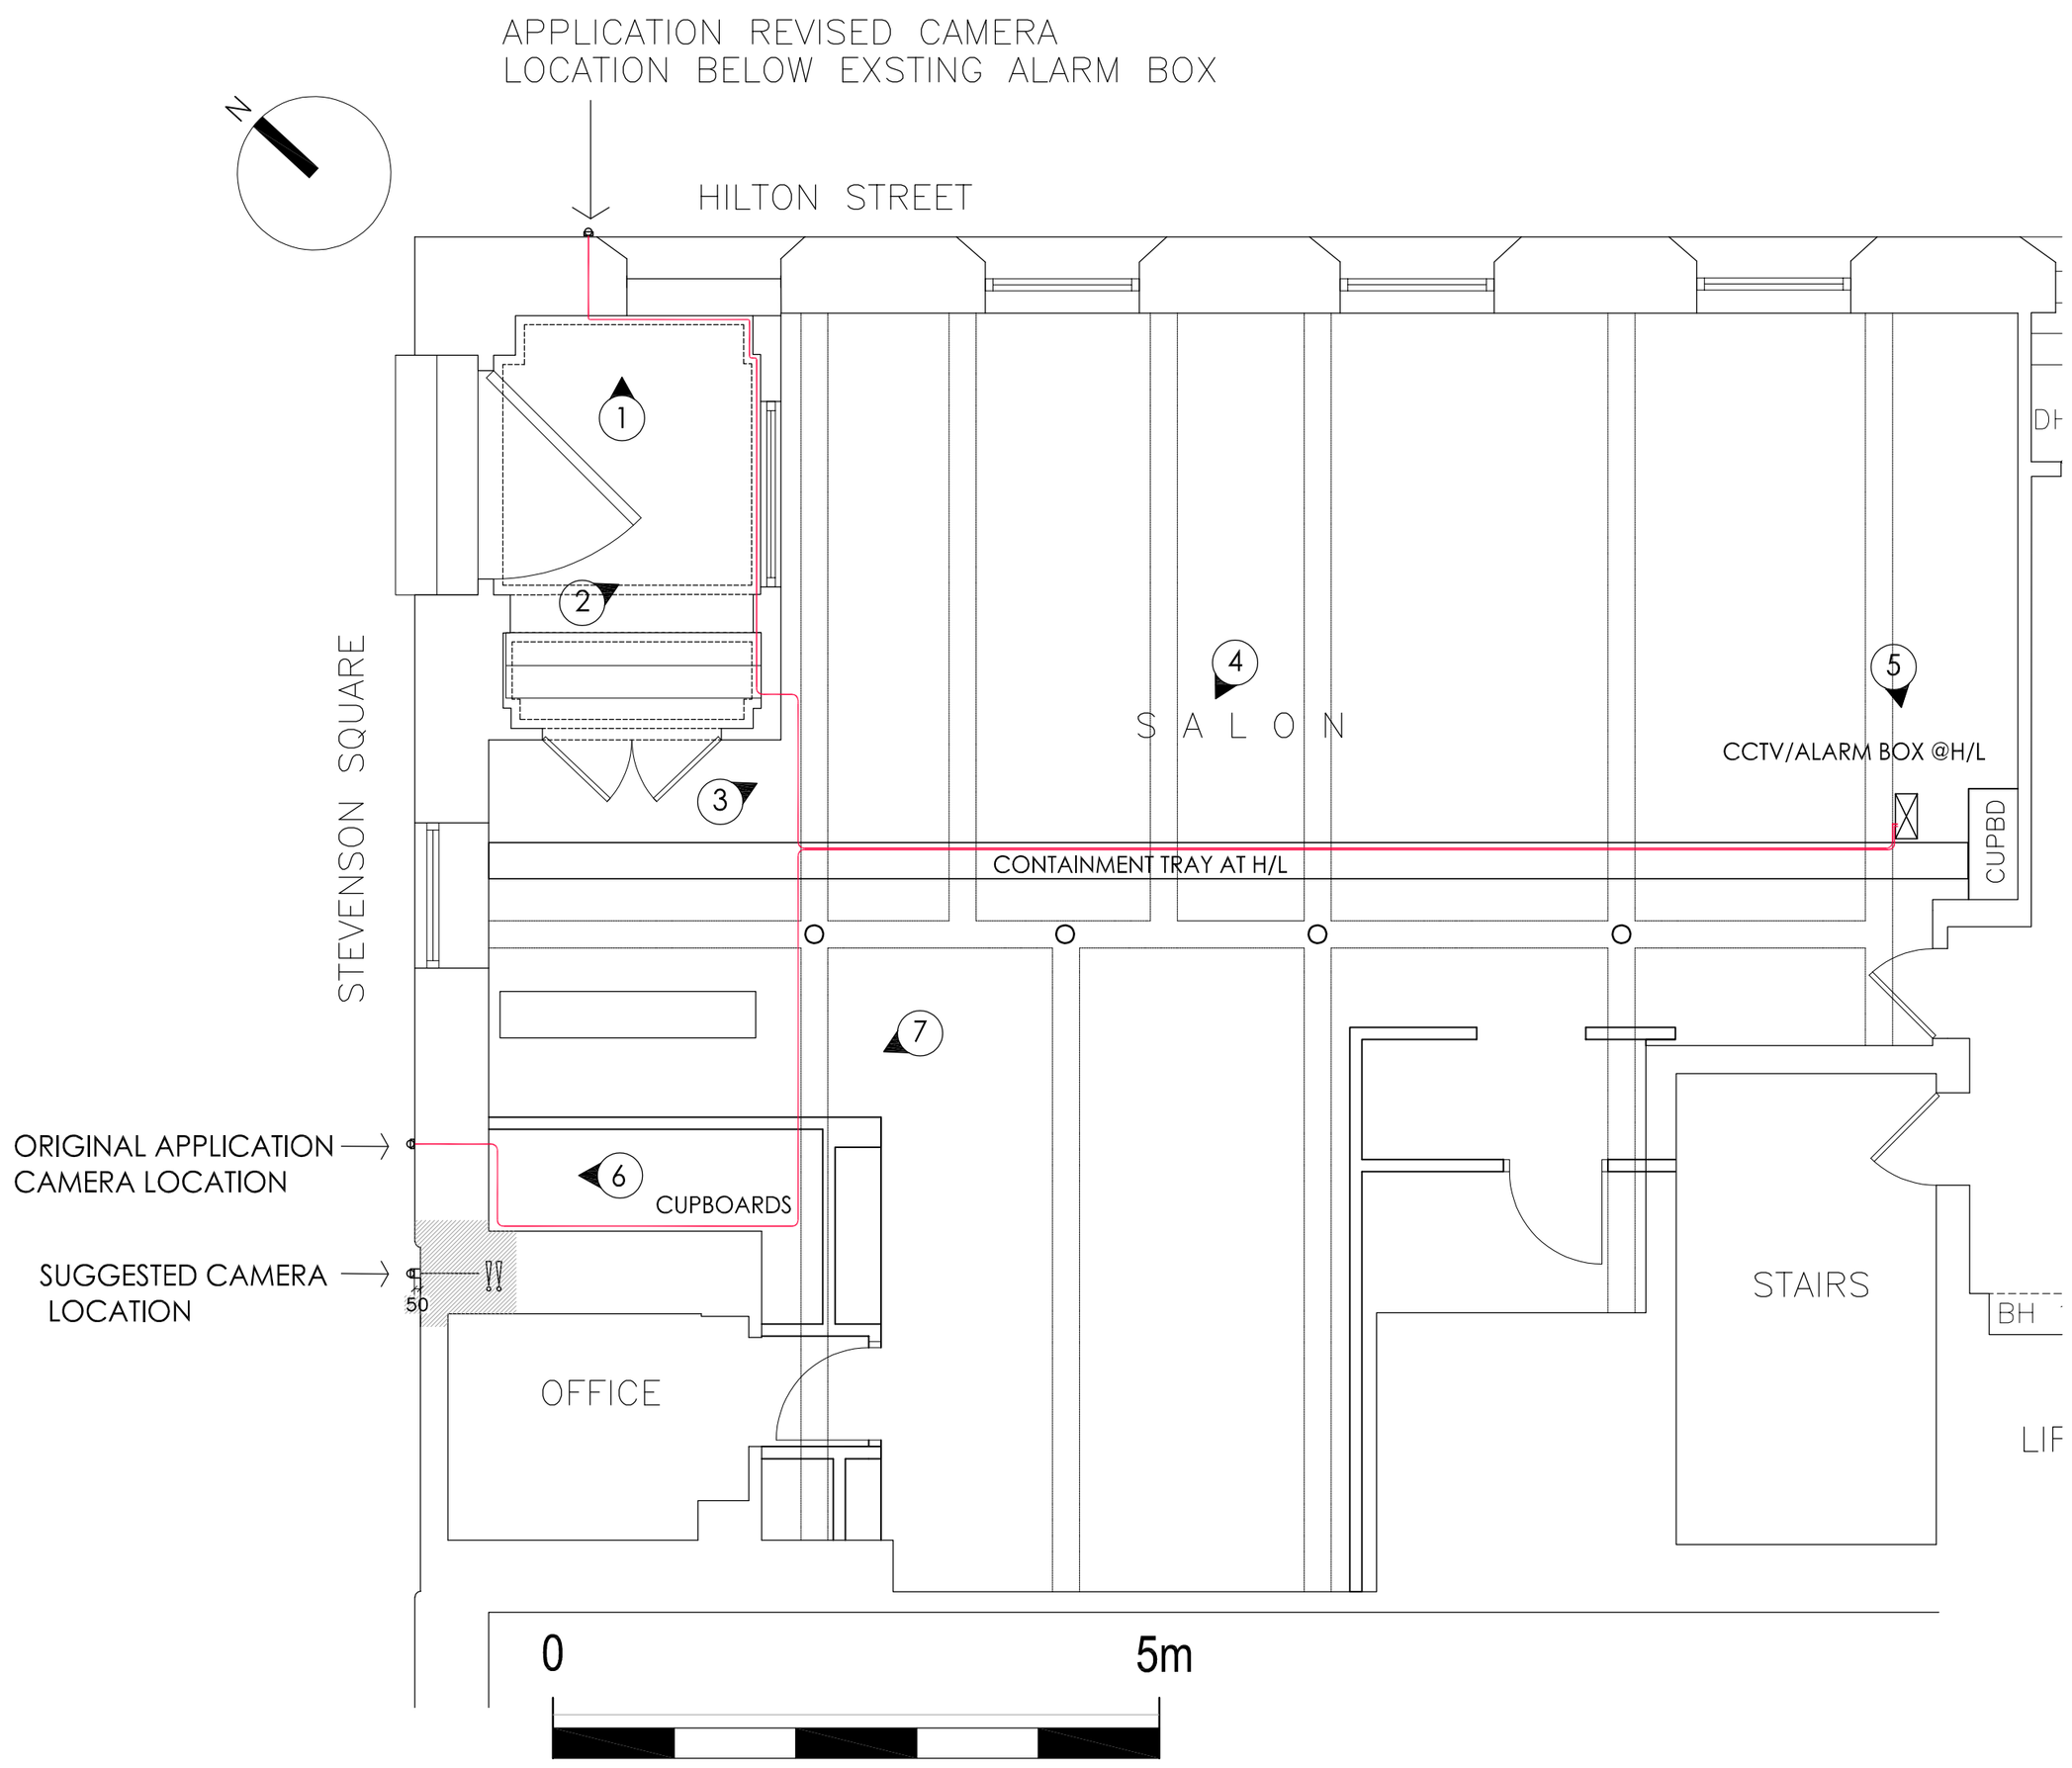


NOTES

1. On no account may this drawing be scaled.
THIS DOES NOT APPLY TO PLANNING DRAWINGS
2. Any discrepancy to be reported to the Contract Administrator immediately
3. The Contractor must check all dimensions on site prior to placing work in hand and/or ordering any materials or work.
4. This drawing is copyright of propertysign ltd t/a studio_neo
it may not be reproduced, or part reproduced without the express consent of propertysign

Drawing Status

- ☒ PRELIMINARY FOR APPROVAL
- ☐ AGREED LAYOUT -SIGNED OFF
- ■ PLANNING DRAWING
- ☐ BUILDING CONTROL DRAWING
- ☐ TENDER DRAWING
- ☐ CONTRACT DRAWING
- ☐ CONSTRUCTION DRAWING
- ☐ AS-BUILT DRAWING

FOR INTERNAL PHOTOGRAPHS REFER TO PHOTOGRAPHIC RECORD DOCUMENT.

Project

GROUND FLOOR
10 STEVENSON SQUARE.

Drawing Title

CCTV INSTALLATION

Scale	Date
1:50 @ A2	03.06.24.
Drawing No.	Revision
2372/L2-02	

Rev.	Date	Description
-	00.00.24.	-

studio_neo
Architects

3 Bridgewater Street
Lymm
Cheshire
WA13 0AB

t. +44(0)1925 752225
e. steve@studio-neo.co.uk
www.studio-neo.co.uk