

© Tier Consult


NOTE: THE TACTILE SURFACE MAY BE CONSTRUCTED FROM ANY MATERIAL SUITABLE FOR PAVING FOOTWAY SURFACES.
TACTILE CROSSING FLAGS TO BE IN ACCORDANCE WITH BS EN 1339:2003.

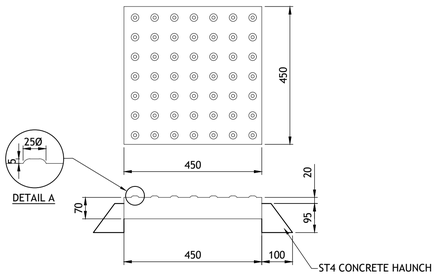


TACTILE PAVING SLAB DETAIL.
SCALE: 1:10.

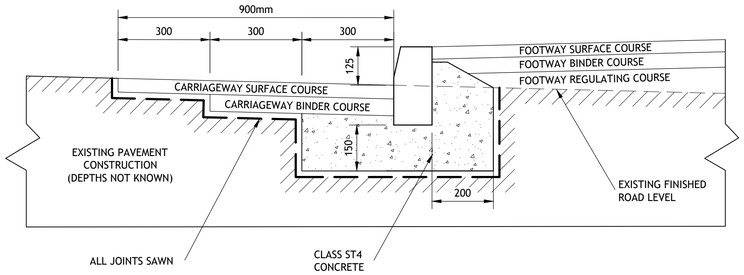


KERB REALIGNMENT DETAIL
SCALE 1:10

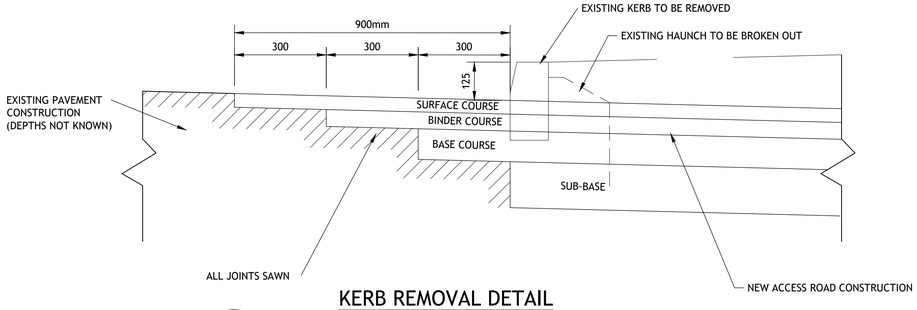


KERB REMOVAL DETAIL
SCALE 1:10

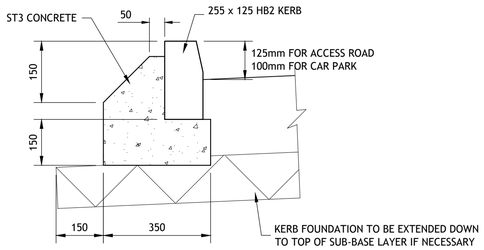

HB2 KERB FOUNDATION DETAIL
SCALE 1:10

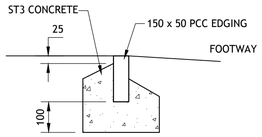

EF KERB FOUNDATION DETAIL
SCALE 1:10

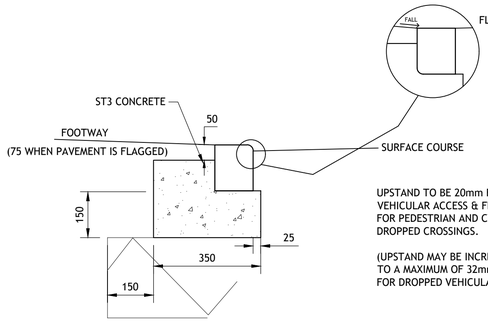


BN KERB FOUNDATION DETAIL
SCALE 1:10


UPSTAND TO BE 20mm FOR VEHICULAR ACCESS & FLUSH FOR PEDESTRIAN AND CYCLE DROPPED CROSSINGS.

(UPSTAND MAY BE INCREASED TO A MAXIMUM OF 32mm FOR DROPPED VEHICULAR CROSSING).


FOOTWAY CROSSFALL	MINIMUM LENGTH OF 125mm RAMP TO ACHIEVE 1:12 GRADIENT
1:20	3750mm
1:30	2520mm
1:40	2145mm
1:50	1975mm
1:60	1875mm
1:70	1810mm
1:80	1765mm

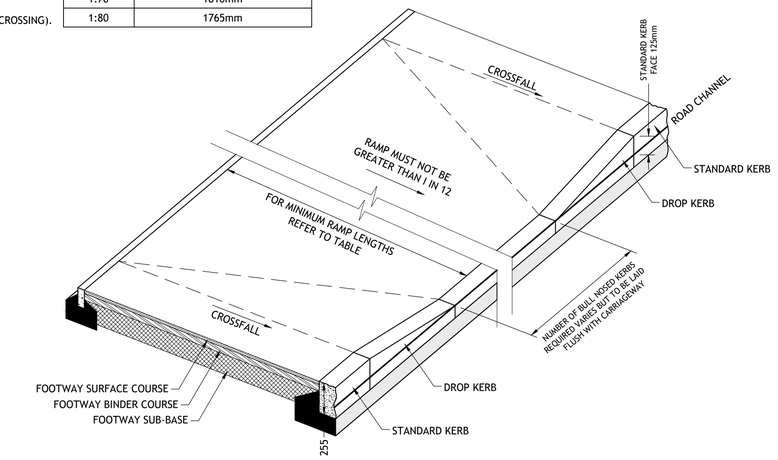


DROPPED KERB DETAIL
SCALE 1:25

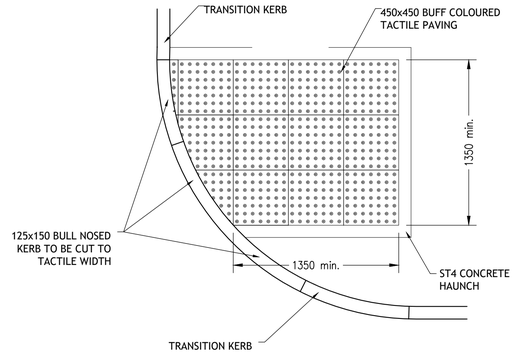

TACTILE PAVING LAYOUT ON A RADIUS
SCALE 1:25

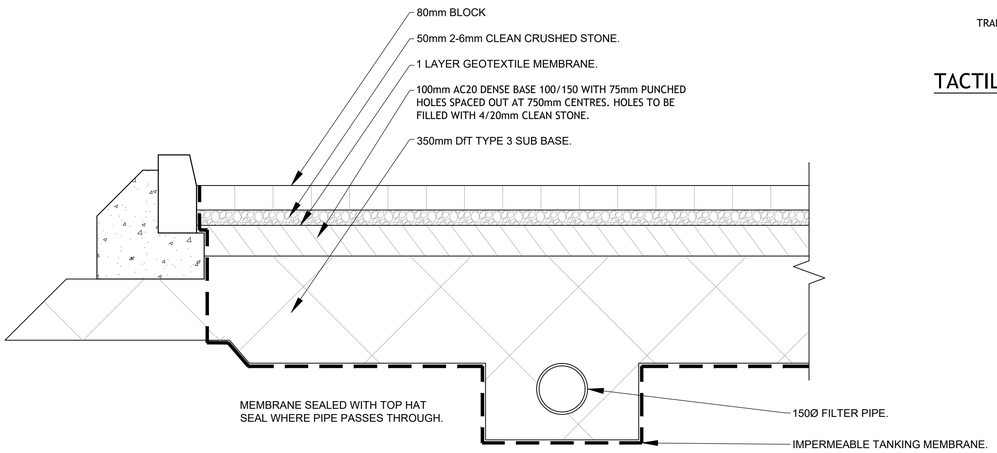

TYPICAL SECTION THROUGH TANKED PERMEABLE BLOCK PAVING.
SCALE: 1:10.

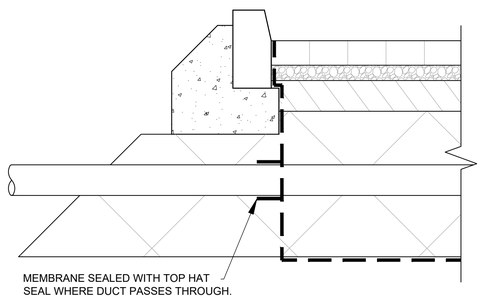

TYPICAL SECTION THROUGH TANKED PERMEABLE BLOCK PAVING SHOWING CABLE DUCT TOP HAT SEAL.
SCALE: 1:10.

Notes

Rev	Date	By	Description	Chk	App
F1	15.05.2024	CCF	ASBUILT ISSUE	CCF	PJB

Status: ASBUILT

TIER CONSULT.
Richmond House,
Sandpiper Court,
Chester Business Park,
Chester | CH4 9QZ
T: 01244 684 900

Client:

Project: ASHBROOK MOSS NOOK.

Title: EXTERNAL WORKS CONSTRUCTION DETAILS.

Scale: 1:200@A1
Drawn: C.C.FITTON
Revision: F1
Date: 06.08.2021
Checked: W.N.LLOYD

Drawing No : T_21_2463-60-03

© Tier Consult
© Tier Consult