

PAS 128: 2014 QUALITY LEVEL GUIDE

Q-LEVEL	DESCRIPTION	ACC.	Q-LEVEL	DESCRIPTION
QL-D	Service problems taken from records.	Undefined	QL-B2	Horizontal & vertical location using only one geophysical technique.
QL-C	Visual evidence of service evidence but undetectable by geophysical technology.	Undefined	QL-B1	Horizontal & vertical location using multiple geophysical techniques.
QL-B4	Undetectable service present shown as an assumed route (AR).	to +1.00m	QL-A	Horizontal & vertical position verification by open excavation, manholes and/or inspection chambers.
QL-B3	Horizontal location by one geophysical technique but with none as per depth information.			

DETECTION METHOD
IN ACCORDANCE WITH PAS 128: 2014 SURVEY TYPE B

DRAINAGE SURVEY

All accessible Manholes and Inspection chambers have had their respective covers lifted with pipe sizes, inverts, chamber sizes/types and service data recorded from ground level. All connections from DPs, Gullies, Drains, VP's, RE's and lampholes have been proven wherever possible using audible connections (AC) and/or sonde instrumentation where applicable. Where these methods have proved unsuccessful then assumed (AR) straight line connections will be shown.

CCTV DRAINAGE SURVEY

All accessible Manholes and Inspection chambers have had their respective covers lifted with pipe sizes, inverts, chamber sizes/type and service data recorded from ground level. Pipework has been traced, accessed and collected for post processing. Drainage layout, including manhole covers not located by topographical survey, may be taken from CCTV chainage and will be shown as indicative only.

Electricity

Elec cables will have been predominantly located using EML methodology with electronically derived depths shown. GPR techniques will be employed to achieve greater quality levels as required.

British Telecoms

BT cables will have been predominantly located using EML methodology with electronically derived depths shown. GPR techniques will be employed to achieve greater quality levels as required. Due to current laws and legislation protecting all BT apparatus, cabling can only be located remotely. We therefore compare all our telecom findings against record information to produce the final service layout. In some instances, where high amount of cable ducts are present, we may only be able to identify a linear centre peak signal rather than identifying all the individual duct positions. For further information regarding Telecoms apparatus, please contact Openreach directly.

Cable TV & Communications

CTV and/or Com cables will have been predominantly located using EML methodology with electronically derived depths shown. GPR techniques will be employed to achieve greater quality levels as required.

Fibre Optic

FO cables will have been predominantly located using GPR methodology. This is due to the materials used within fibre optic cabling. In some rare instances, tracer cabling or conductible non fibre optic cabling will be present within some or all ducting. When this is the case, both EML and GPR methodology will be combined to identify service network and achieve greater quality levels.

Lighting, Traffic Signal & Security Cables

LC, TS and/or Sec cables will have been predominantly located using EML methodology with electronically derived depths shown. GPR techniques will be employed to achieve greater quality levels as required.

Gas & Water Inc. Fuel Pipes and Hot Water Pipes

GM/GS and/or VM/WWS pipe work will have been attempted and located using both EML & GPR methodology with electronically derived depths shown for the former and depths to crown levels shown for the latter. When the Gas/Water pipe work is constructed using conductible materials, then we are able to employ multiple geophysical techniques to identify service network and achieve greater quality levels. When a non conductible material is used, GPR methodology will be employed to locate and plot the final service layout.

Ground Penetrating Radar

GPR methodology is used to identify and locate all non metallic, non conductible piping and cabling. We also employ GPR to obtain a greater accuracy levels on EML located services. The GPR has a greater success rate on pipe or service diameter upward of Ø63mm, C63mm, as size increments increase, so does the chance of detection. The GPR can produces varying results and as such, wouldn't be used as an independent utility surveying instrument.

Unidentified Traces

All UITs will have been predominantly located using EML methodology with electronically derived depths shown. GPR techniques will be employed to achieve greater quality levels as required. Every effort has been made to identify the service but in this instance, is not achievable. We recommend excavation work to determine identity and depth where applicable.


Scarring (QL-C)

Scarring has been identified on site with a potential of an undetectable service present.

Assumed Routes & Taken from Records (QL-B4/D)

Assumed routes (AR) are shown if there is evidence that a service exists but we are unable to trace it whilst on site. The surveyor will attempt to locate various risers/ics/valves/meters (service evidence) etc. around site area to successfully determine an assumed route between these points. If there is little evidence on site but they believe a service is still present, then a common sense approach to an assumed route shall be employed.

Taken from records (TFR) are service routes that are taken from STAT record plans or previous survey information and overlaid onto our drawings.

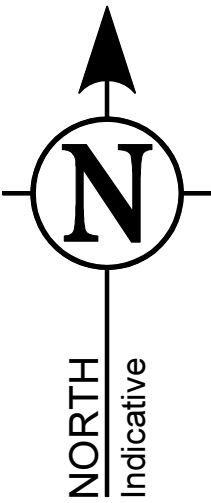

380700E

Unable to survey
downstream beyond this
point due to blockage.

Middleton Old Road

Rochdale Road

UTILITIES & UNDERGROUND INVESTIGATIONS

ABBREVIATIONS & SYMBOLS

1D SC	1 Duct 5 Cables	DCr	Depth To Crown	RBC	Rectangular Brick Chamber
Ø	Diameter	DI	Depth To Invert	RCC	Rectangular Conc Chamber
AC	Audible Connection	DS	Depth To Silt	RE	Rodding Eye
AG	Above Ground	DTB	Depth To Base	SA	Survey Abandoned
AR	Assumed Route	DTW	Depth To Water	SL	Silt Level
BL	Base Level	DTS	Depth To Surcharge	SuL	Surcharge Level
CB	Concrete Benching	EBD	External Backdrop	TFR	Taken From Records
CBC	Circular Brick Chamber	EOT	End Of Trace →	UTC	Unable To CCTV
CCC	Circular Conc Chamber	IBD	Internal Backdrop	UTDO	Unable To Determine Outfall
CL	Cover Level	IL	Invert Level	UTL	Unable To Lift
CPC	Circ Plastic Chamber	OH	Overhead	UTS	Unable To Survey
CRL	Crown Level	POH	Poor Depth Response	UTT	Unable To Trace
CU	Camera Under Water →	RB	Rest Bend	WL	Water Level

BT	BT CABLE(S)	BT	BT CABLE(S)
GBT	OVERHEAD BT CABLE(S)	GBT	OVERHEAD BT CABLE(S)
COM	COMMUNICATIONS CABLE(S)	COM	COMMUNICATIONS CABLE(S)
CTV	CABLE TV CABLE(S)	CTV	CABLE TV CABLE(S)
DUCT	EMPTY DUCT	DUCT	EMPTY DUCT
E	ELECTRIC CABLE(S)	E	ELECTRIC CABLE(S)
OE	OVERHEAD ELECTRIC CABLE(S)	OE	OVERHEAD ELECTRIC CABLE(S)
FO	FIBREOPTIC CABLE(S)	FO	FIBREOPTIC CABLE(S)
FUEL	FUEL PIPE(S)	FUEL	FUEL PIPE(S)
GM	GAS MAIN	GM	GAS MAIN
GS	GAS SERVICE	GS	GAS SERVICE
GPR	GROUND PENETRATING RADAR (GPR) TRACE	GPR	GROUND PENETRATING RADAR (GPR) TRACE
HW	HOT WATER PIPE	HW	HOT WATER PIPE
LC	LIGHTING CIRCUIT	LC	LIGHTING CIRCUIT
OL	OIL PIPE(S)	OL	OIL PIPE(S)
SCAR	VISIBLE SCARRING	SCAR	VISIBLE SCARRING
SEC	SECURITY CABLING	SEC	SECURITY CABLING
TC	TELECOM CABLE(S)	TC	TELECOM CABLE(S)
TS	TRAFFIC SIGNAL	TS	TRAFFIC SIGNAL
UB	UNIDENTIFIED SERVICE	UB	UNIDENTIFIED SERVICE
UIT	UNIDENTIFIED TRACE	UIT	UNIDENTIFIED TRACE
WM	WATER MAIN	WM	WATER MAIN
WS	WATER SERVICE	WS	WATER SERVICE
GW	COMBINED SEWER	GW	COMBINED SEWER
CW RM	COMBINED WATER RISING MAIN	CW RM	COMBINED WATER RISING MAIN
EW	EFFLUENT WATER	EW	EFFLUENT WATER
FW RM	FOUL WATER RISING MAIN	FW RM	FOUL WATER RISING MAIN
SW RM	SURFACE WATER RISING MAIN	SW RM	SURFACE WATER RISING MAIN
INVESTIGATION EXTENTS		INVESTIGATION EXTENTS	
75-AC	AUDIBLE CONNECTION	75-AC	AUDIBLE CONNECTION
75-AB	SERVICE ABOVE GROUND	75-AB	SERVICE ABOVE GROUND
75-OH	CAMERA UNDER WATER	75-OH	CAMERA UNDER WATER
75-OH	SERVICE OVERHEAD	75-OH	SERVICE OVERHEAD

Note: UTILITIES COMMENT BOX (GENERAL NOTES)
-d0.37m DEPTH TO SERVICE

GENERAL SYNOPSIS

This survey has been carried out in accordance with PAS 128: 2014 & our version of the Royal Institution of Chartered Surveyors (RICS) specification for Measured Surveys of Land, Buildings and Utilities. Our survey extents have been agreed and confirmed with formal acceptance of 43437 from JAMES CAMPBELL ASSOCIATES LTD. If you have any queries regarding the final services layout, please may we ask you to carefully read all the information within this title block in its entirety before continuing to do so.

TOPOGRAPHICAL/DWG DRAWING INFORMATION
TOPOGRAPHICAL SURVEY DATE 01/02/2021

SURVEY TYPE	DESCRIPTION	EFFECT ON SURVEY RESULTS
TOPO	Survey Systems	
OUTDATED		
OS		
NTS		

GENERAL SITE CONDITIONS
EXCELLENT

ADDITIONAL INFORMATION	EFFECT ON SURVEY RESULTS

SURVEY RECOMMENDATIONS

Due to the geophysical nature of subsurface technology, we always recommend excavation works to be carried out for verification, especially within critical areas.

UTILITIES & UNDERGROUND INVESTIGATIONS
DRAWING NOTES

All below ground details shown have been identified from above ground without excavation. Survey Solution use electro-magnetic and/or ground penetrating radar (GPR) methods to investigate for underground utilities, services and features. Results using these methods are not infallible and we recommend trial excavations are carried out to confirm any identifications, positions and depths.

Any areas on the drawing where services or features have not been shown are not necessarily clear of services or features but are an indication that no items have been identified during our investigations. All reasonable care and normal good practice should still be employed during design and construction processes.

Certain types of services such as plastic or concrete pipes, some conduit and ducting where direct access can not be achieved for tracing may not be shown and alternative locating methods should be used.

Survey Solutions has used all reasonable care to research available service records but the completeness or use of the service records supplied to or by Survey Solutions cannot be guaranteed. Therefore Survey Solutions cannot be held responsible for any features annotated as 'taken from records' (TFR).

Depths obtained using electro-magnetic or GPR are effected by ground conditions and should be treated as indicative only. Electro-magnetic depths to utilities and services are generally taken to the centre of a feature, GPR depths to the top of a feature and drainage depth shown to inverts, unless otherwise indicated.

Drainage pipe sizes will be obtained without entering the chamber and therefore should be treated as approximate. Pipe dimensions which have not been obtained visually will be taken from records when available.

All services, drainage and utilities routes are assumed straight between access points, unless otherwise stated. The numbers of cables in runs will not be shown unless specifically requested. All services are below ground unless indicated.

Services, utilities and features may not have been surveyed if obstructed or not reasonably visible or accessible at the time of survey.

Survey Solutions accept no responsibility for the completeness or accuracy of either the topographical survey or base mapping on this project.

All critical dimensions and measurements should be checked and verified with any errors or discrepancies notified to Survey Solutions immediately. The accuracy of the digital data is the same as the plotting scale implies. All dimensions are in metres unless otherwise stated.

The contractor must check and verify all site and building dimensions, levels, utilities and drainage details and connections prior to commencing work.


© Land Survey Solutions Limited hold the copyright to all the information contained within this document and their written consent must be obtained before copying or using the data other than for the purpose it was originally supplied.

Do not scale from this drawing.

DESKTOP UTILITY RECORDS (PAS 128: 2014 SURVEY TYPE D)
PREREQUISITE FOR PAS 128: 2014 SURVEY TYPE B
COMMISSIONED: NO

UTILITY	AVAILABILITY	UTILITY COMPANY PROVIDER
SEWER	NO	N/A
WATER MAIN	N/A	N/A
GAS MAIN	N/A	N/A
TELECOM	N/A	N/A
CABLE TV	N/A	N/A
ELECTRICITY	N/A	N/A
OIL PIPES	N/A	N/A
OTHER	N/A	N/A

REV	DESCRIPTION	DRAWN	CHECKED	APPR	SURVEY DATE
-----	-------------	-------	---------	------	-------------

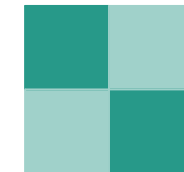

SURVEY SOLUTIONS

**LAND SURVEYING
BUILDING SURVEYING
UNDERGROUND SURVEYING
SITE ENGINEERING
MONITORING**

**0845 040 5969
survey-solutions.co.uk**

IPSWICH BEDFORD COVENTRY GLASGOW LONDON MANCHESTER NORWICH NOTTINGHAM YEOVL

PROJECT TITLE
1133 ROCHDALE ROAD
MANCHESTER, M9 8DS

DRAWING DETAIL
SITE SPECIFIC CCTV DRAINAGE SURVEY.
SHEET 1 OF 1

CLIENT JAMES CAMPBELL ASSOCIATES LTD	SCALE 1:200
SURVEYOR PI	SURVEY DATE 21/07/2022
CHECKED BY RDN	APPROVED BY JTM
DRAWING NUMBER 43437UG-01	REVISION ISSUE DATE 04/08/2022

