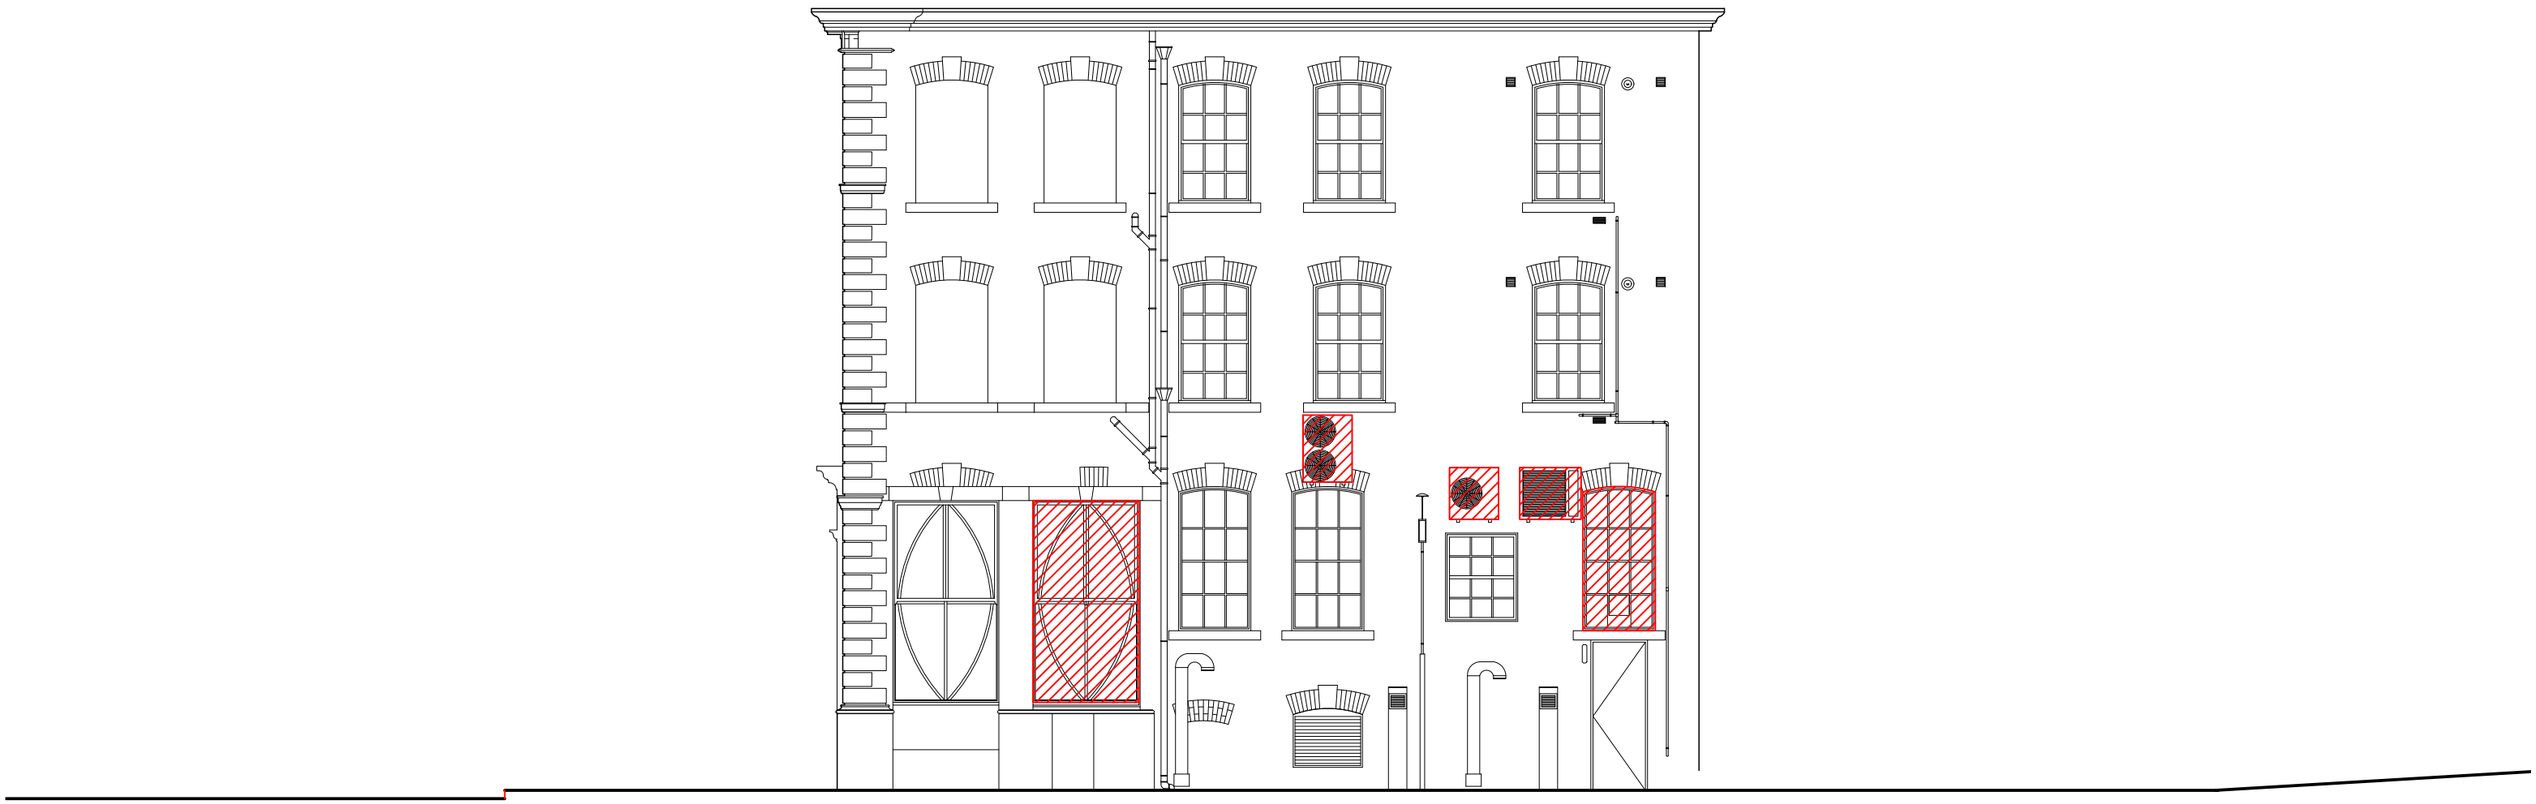


EXISTING NORTH EAST ELEVATION

BOW LANE FACADE

DEMOLITIONS SHOWN IN RED

Up North Architects	North	Drawing Title:	Drawing Number:	Revision:	Scale:	Job No.:	Date:	RIBA Stage:	Drawing Purpose:
		NE Demolitions Elevation	025	-	1:100 @ A3	M866	May 2024	03 - Spatial Coordination	For Information