
© Tier Consult
© Tier Consult


Notes

1. THIS DRAWING IS THE COPYRIGHT OF TIER CONSULT LTD AND CANNOT BE REPRODUCED IN ANY FORM WITHOUT WRITTEN CONSENT FROM THE COMPANY.
2. THIS DRAWING IS TO BE READ IN CONJUNCTION WITH ALL OTHER RELEVANT ARCHITECT'S, ENGINEER'S AND SPECIALIST'S DRAWINGS TOGETHER WITH THE APPROPRIATE SPECIFICATION.
3. ALL DIMENSIONS ARE IN MILLIMETRES UNO, FOR THE PURPOSES OF CONSTRUCTION THIS DRAWING MUST NOT BE SCALED AND ONLY WRITTEN DIMENSIONS USED. IT IS THE CONTRACTOR'S RESPONSIBILITY TO CHECK ALL DIMENSIONS ON SITE PRIOR TO CONSTRUCTION AND ANY DISCREPANCIES TO BE BROUGHT TO THE IMMEDIATE ATTENTION OF THE ENGINEER IN WRITING.
4. ALL LEVELS ARE IN METRES UNO & TO OS DATUM.

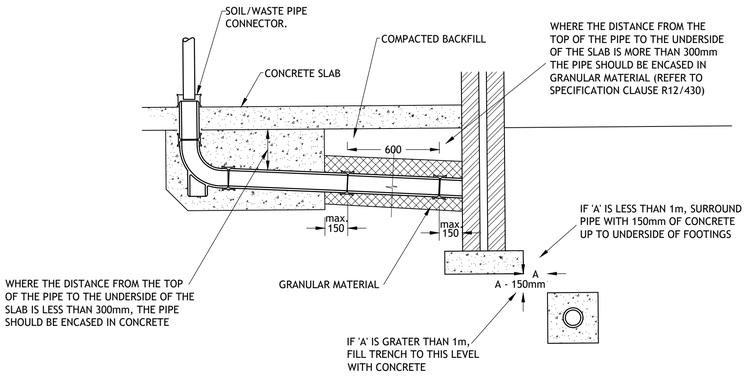


PIPE BEDDING - TYPE W & Y

SCALE 1:20

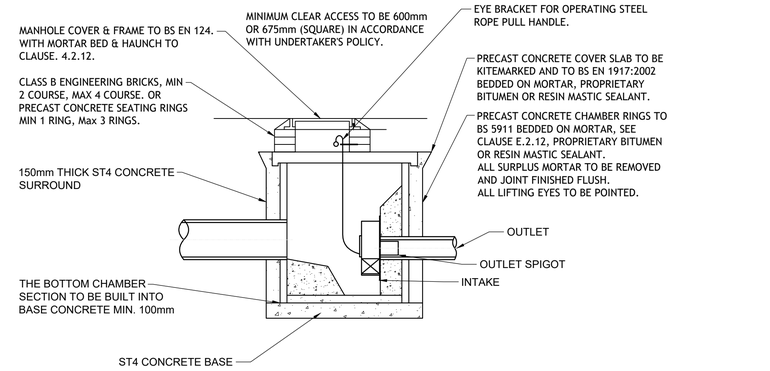


SECTION A-A

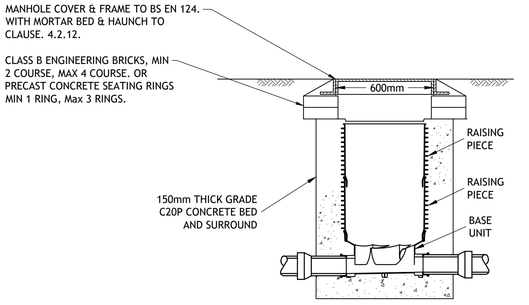


HEAVY DUTY POLYPROPYLENE INSPECTION CHAMBER

SCALE 1:20

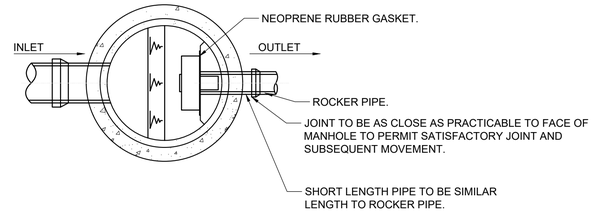

TYPICAL HYDROBRAKE MANHOLE CONSTRUCTION DETAIL

SCALE 1:20

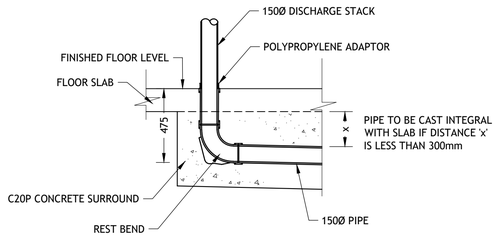


FOUL OUTLET CONNECTION DETAIL

SCALE1:20

NOTES:


1. WHEN FOUNDATION IS MORE THAN 450mm ABOVE DRAIN DO NOT ENCASE IN CONCRETE.
2. JOINT FILLER TO BE PLASTAZOTE OR SIMILARLY APPROVED.
3. 12mm DIA CHORD FOR 100mm DRAINAGE PIPES WITH 150mm DIA CASING.
4. 25mm DIAMETER CHORD FILLER FOR 150mm DRAINAGE PIPES WITH 225mm DIAMETER CASING.
5. WHERE DRAINAGE PIPES UNDER BUILDINGS HAVE LESS THAN 300mm COVER THEY SHALL HAVE 150mm CONCRETE ENCASEMENT.

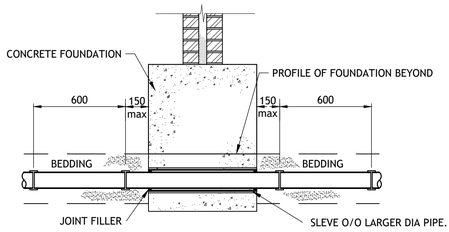

DRAIN PASSING BELOW FOUNDATION


(ENCASE IN CONCRETE BELOW FOOTING)

SCALE 1:20

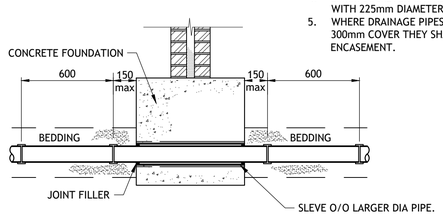


DRAIN PASSING THROUGH FOUNDATION

SCALE 1:20

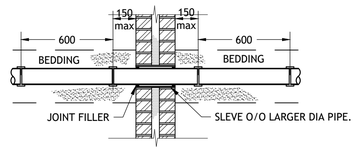


DRAIN PASSING THROUGH WALLS

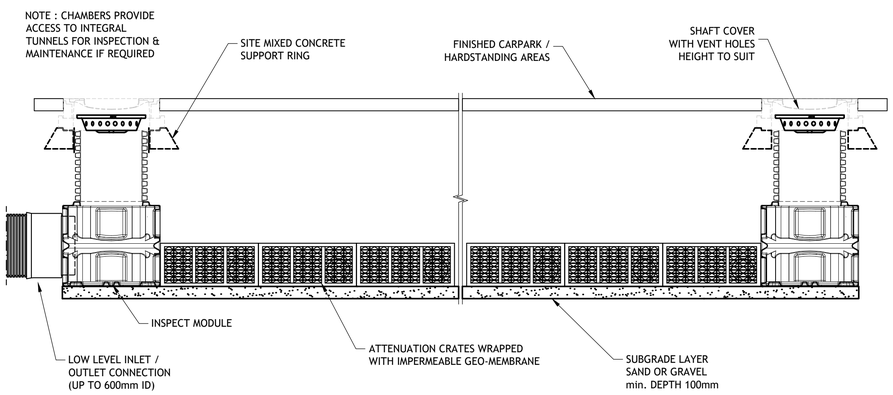

SECTION THROUGH ATTENUATION UNIT

Scale 1:25

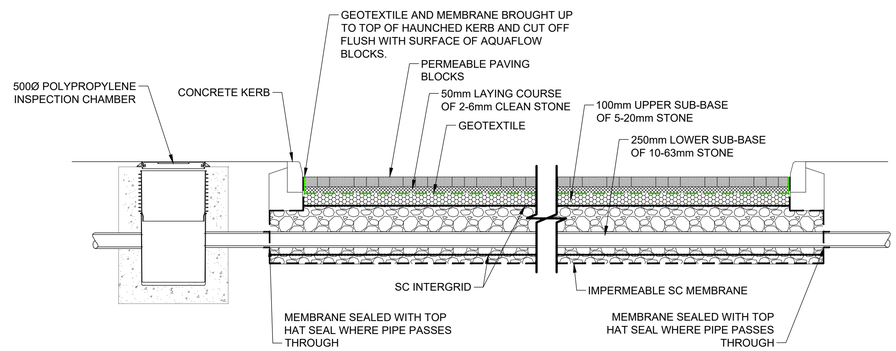

TYPICAL PERMEABLE PAVING DETAIL

SCALE 1:25

Rev	Date	By	Description	Chk	App
F1	15.05.2024	CCF	ASBUILT ISSUE	CCF	PJB

Status: ASBUILT

TIER CONSULT.
Richmond House,
Sandpiper Court,
Chester Business Park,
Chester | CH4 9QZ
T: 01244 684 900

Client:

Project: ASHBROOK MOSS NOOK.

Title: DRAINAGE CONSTRUCTION DETAILS - SHEET 2.

Scale	Drawn	Revision
AS SHOWN@A1	C.C.FITTON	F1
Date	Checked	
06.08.2021	W.N.LLOYD	

Drawing No : T_21_2463-55-03

© Tier Consult
© Tier Consult