


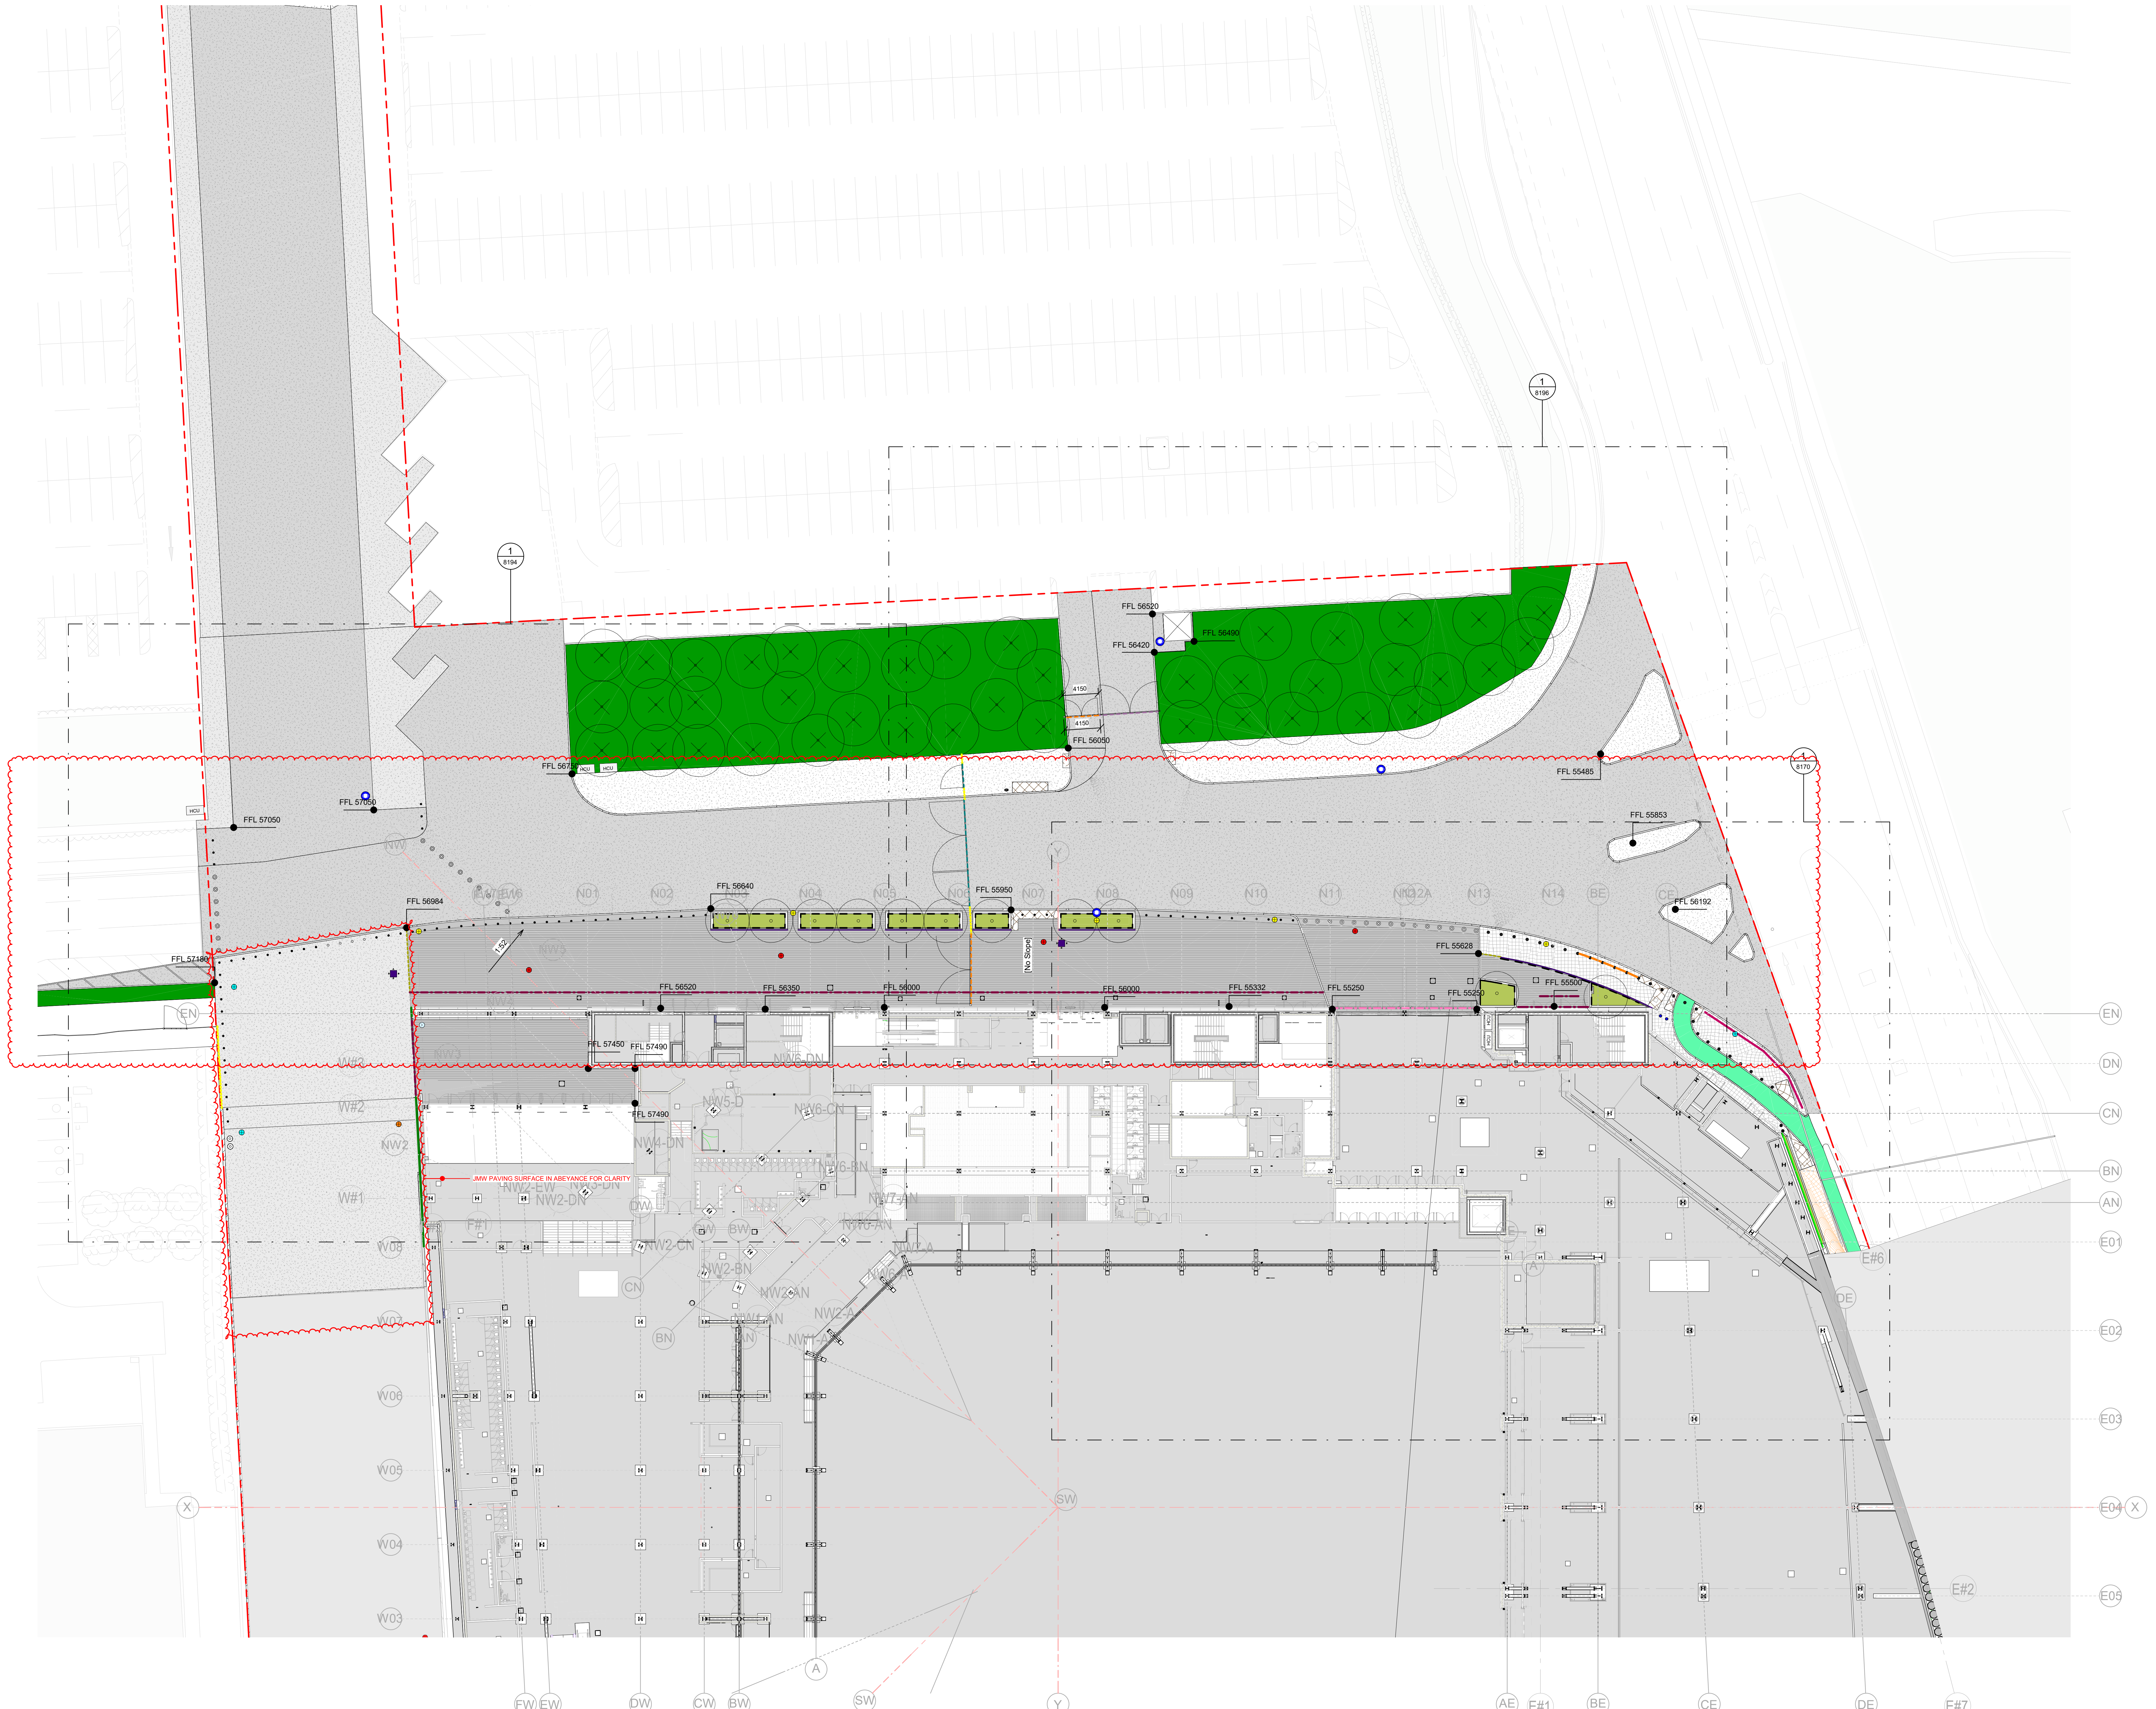

Suitability Code (as defined in ISO 19650-2:2018)

Work in Progress (WIP)

50 - Under Construction

Shared (Non-Contractual)

S1 - Suitable for co-ordination
S2 - Suitable for information
S3 - Suitable for review & comment
S4 - Suitable for review & comment
S5 - Withdrawn
S6 - Suitable for PM authorisation
S7 - Suitable for AM authorisation

Published (Contractual)

A1, A2, A3, Etc - Authorised and accepted
B1, B2, B3, Etc - Partial sign-off (with comments)

Published (AIM Acceptance)

CR - As constructed record document

KEY PLAN

KEY

- PROJECT BOUNDARY
- CONCRETE BLOCK PAVING IMPERMEABLE
- EXT-131 TARMAC
- EXT-135 COATED MACADAM PAVING - WITH TEXTUREFLEX TOP COAT
- EXT-112 CONCRETE PAVING SLAB
- EXT-201, EXT-202, EXT-203 CONCRETE KERB
- EXT-221 METAL EDGING
- EXT-333 CONCRETE PLANTER
- EXT-301 PAS RATED STATIC BOLLARD
- EXT-303 PAS RATED RETRACTABLE BOLLARD - TYPE 1
- EXISTING BOLLARD TO BE RELOCATED
- RELOCATED EXISTING STATIC BOLLARD
- RELOCATED EXISTING RETRACTABLE BOLLARD
- RELOCATED EXISTING LITTER BIN
- RELOCATED EXISTING CONCRETE BENCHES
- EXT-423 DOOR BARRIER
- EXT-405, EXT-429 GATE
- RELOCATED EXISTING GATE
- EXISTING GATE TO BE RETAINED
- EXT-401, EXT-402 SECURITY FENCE
- EXT-471 CONCRETE WALL
- EXT-411, EXT-412 BALUSTRADE
- EXT-413 BALUSTRADE PANEL FIXED ON THE BOLLARDS BASE PLATE
- EXT-414 BALUSTRADE PANEL FIXED ON THE FOUNDATION IN THE GROUND
- EXT-541 GREEN SCREEN
- EXT-544 LIVING WALL
- EXT-801 SLOT DRAIN TYPE 1
- EXT-803 SLOT DRAIN TYPE 3
- EXT-811 FLOOR GULLY
- WAYFINDING ITEM
- EXT-335 SECURITY HUT
- EXT-561 PROPOSED TREES
- EXISTING TREES TO BE RETAINED
- EXISTING TREES TO BE REMOVED
- EXT-568 SHRUB AND UNDERSTORY PLANTING
- EXISTING PLANTING
- PROPOSED LIGHTING COLUMN
- EXISTING LIGHTING COLUMN TO BE RETAINED
- EXISTING LIGHTING COLUMN TO BE REMOVED
- EXISTING LIGHTING COLUMN TO BE RELOCATED
- RELOCATED EXISTING LIGHTING COLUMN
- CCTV CAMERA

THIS DRAWING IS ONLY TO SCALE IF IT IS REPRODUCED AT THE CORRECT PAPER SIZE

1:250@A0

0 5 10 20

ALL INTERNAL LAYOUTS AND USES ARE SHOWN FOR ILLUSTRATIVE PURPOSES ONLY AND ARE NOT FOR DETERMINATION.

drawn

© COPYRIGHT. ALL RIGHTS RESERVED.

THIS WORK IS COPYRIGHTED AND CANNOT BE REPRODUCED OR COPIED IN ANY FORM OR BY ANY MEANS WITHOUT THE WRITTEN PERMISSION OF POPULOUS. ANY LICENSE, EXPRESS OR IMPLIED, TO USE THIS DOCUMENT FOR ANY PURPOSE WHATSOEVER IS RESTRICTED TO THE TERMS OF THE AGREEMENT OR IMPLIED AGREEMENT BETWEEN POPULOUS AND THE INSTRUCTING PARTY.

USE FOR PRELIMINARY DESIGN ONLY. NOT TO BE USED FOR CONSTRUCTION. CHECK ALL DIMENSIONS ON SITE BEFORE FABRICATION OR SETTING OUT.

drawn

POPULOUS®

14 BLADES COURT | DODDAR ROAD | LONDON | SW15 2NU | UNITED KINGDOM
TELEPHONE +44 (0)20 8874 7665 FACSIMILE +44 (0)20 8874 7470
ALL PRODUCTION & INTELLECTUAL PROPERTY RIGHTS RESERVED © POPULOUS 2020

REVISIONS

REV	DATE	DESCRIPTION
00	30.10.2020	STAGE 4A - INCREASE IN SCOPE TO PLANNING
01	16.11.2020	STAGE 4A - INCREASE IN SCOPE TO PLANNING
02	09.07.2021	STAGE 4B TO INCORPORATE VE UPDATE
001	02.12.2021	HARD LANDSCAPE PACKAGE FOR CONSTRUCTION
002	10.06.2022	FLOR GULLY TO GP NORTH WEST ENTRANCE
003	13.10.2022	GR HARD LANDSCAPE GRADING & DRAINAGE AND SETTING OUT UPDATE

project name

Co-op Live

the EXTENDED NORTH WALKWAY
GENERAL ARRANGEMENT PLAN
GROUND FLOOR

scale 1: 250 @ A0

drawn FP

checked TJ

Project no. 4933

date 30.10.2020

Subsidiary S3

revisions

BRA-POP-ZZ-GF-DR-L-8120

C03