

NOTES

Copyright: All rights reserved. This drawing must not be reproduced without permission. This drawing must not be scaled.
Dimensions are in millimetres unless specified.

Rev	Date	Notes	By	Che
.P5	22.04.05	Amendments made to plan in-line with comments from RP	RM	RP
C1	221107	CONSTRUCTION ISSUE	SR	RP
C2	230809	Fire curtain position added	SR	RP
C3	240404	Final Construction Issue & Updated to contractors markups	SR	RP

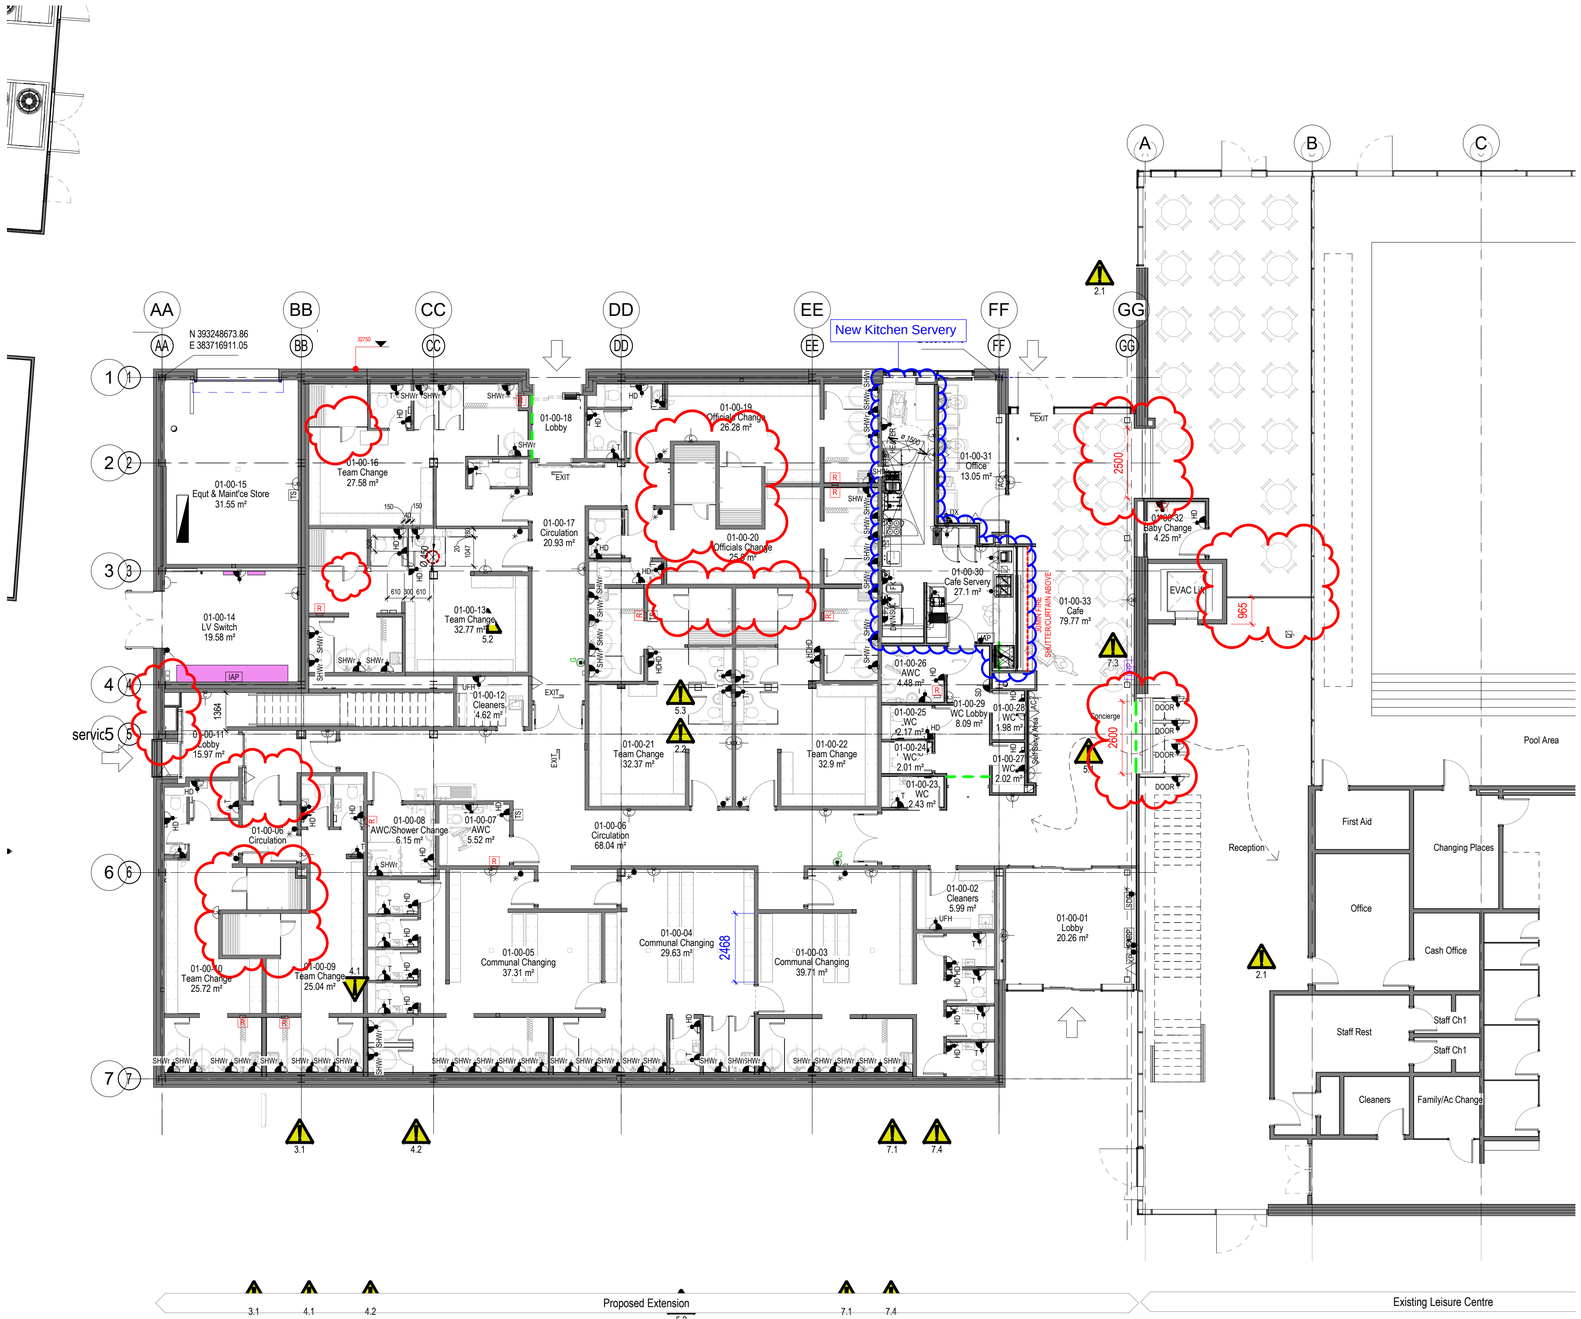

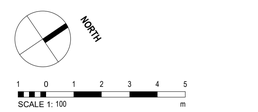

elliswilliams

Project Number: 2638
Project Name: Hough End Leisure Centre Extension

Drawing Status: FINAL CONSTRUCTION ISSUE
Drawing Number: **HEV- EWA- 01- 00- DR- A- 10400**
Drawing Name: Level 00 - GA
Date: 21.06.03 Rev: C3
Drawn By: LA Scale: 1 : 100

Wellfield Chester Road Preston Brook WA7 3BA
T: 01928 752200 E: info@ewa.co.uk W: ewa.co.uk