


Proposed West Elevation Bird Box Location 1

Scale: 1 : 200

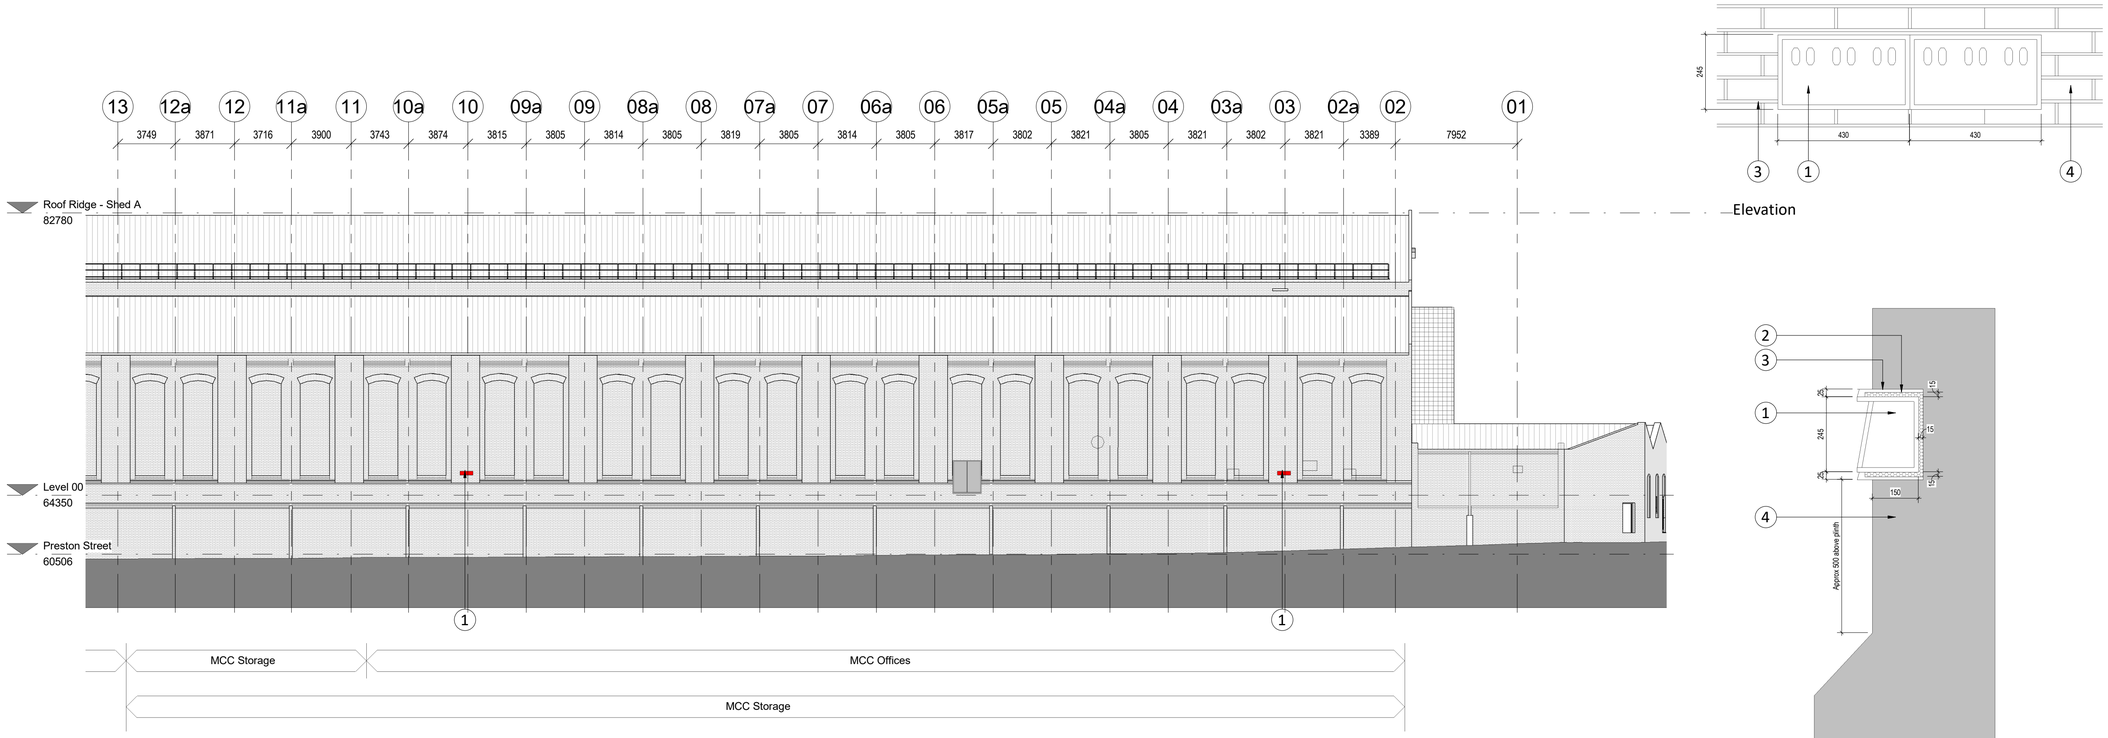

Proposed West Elevation Bird Box Location 2

Scale: 1 : 200

Elevation

Section

House Sparrow Box Details

Scale: 1 : 10

0 5m 10m
1:200

General Notes

Do not scale from this drawing. Only work to written dimensions.

All site dimensions shall be verified by the Contractor on site prior to commencing any works.

This drawing is the property of Fletcher-Rae (UK) Limited (t/a Fletcher-Rae) and copyright is reserved by them. The drawing is not to be copied or disclosed by or to any unauthorised persons without the prior written consent of Fletcher-Rae (UK) Limited.

MORGAN SINDALL



KEY PLAN

Legend

1. Schwegler 1SP House sparrow nest box located in 4no. groups of 2no. boxes (8no. boxes total), minimum 3m above external ground level and recessed into existing wall

2. 15mm insulation to avoid heat conduction

3. Mortar as per masonry refurbishment specification

4. Existing masonry wall

Rev.	Description	Date	ISS	APP
C02	Detail updated to show as installed	2024.02.05	AT	AT
C01	Issued for Comments	2022.08.02	AT	AT

Scale	**As indicated @ A1**
Status	**PD - Published Document (Construction)**
Drawn By	**AT**
Checked By	**AT**
Date	**2022.08.02**

Client:

Morgan Sindall

Project:

18021 Hammerstone Road Manchester

Sheet Name:

Proposed West Elevation Bird Box Locations & Details

Project No.	Orig.	Zone	Level	Type	Role	Cls	Dwg No.	Rev
HRD-FRA-01-XX-DR-A-20-1215								C02

fletcher rae
Architects | Master Planners | Designers
Level 12, Tower 12, 18-22 Bridge Street, Manchester, M3 3BZ
t +44 (0) 161 242 1140
f +44 (0) 161 242 1141
w www.fletcher-rae.com
e info@fletcher-rae.com