


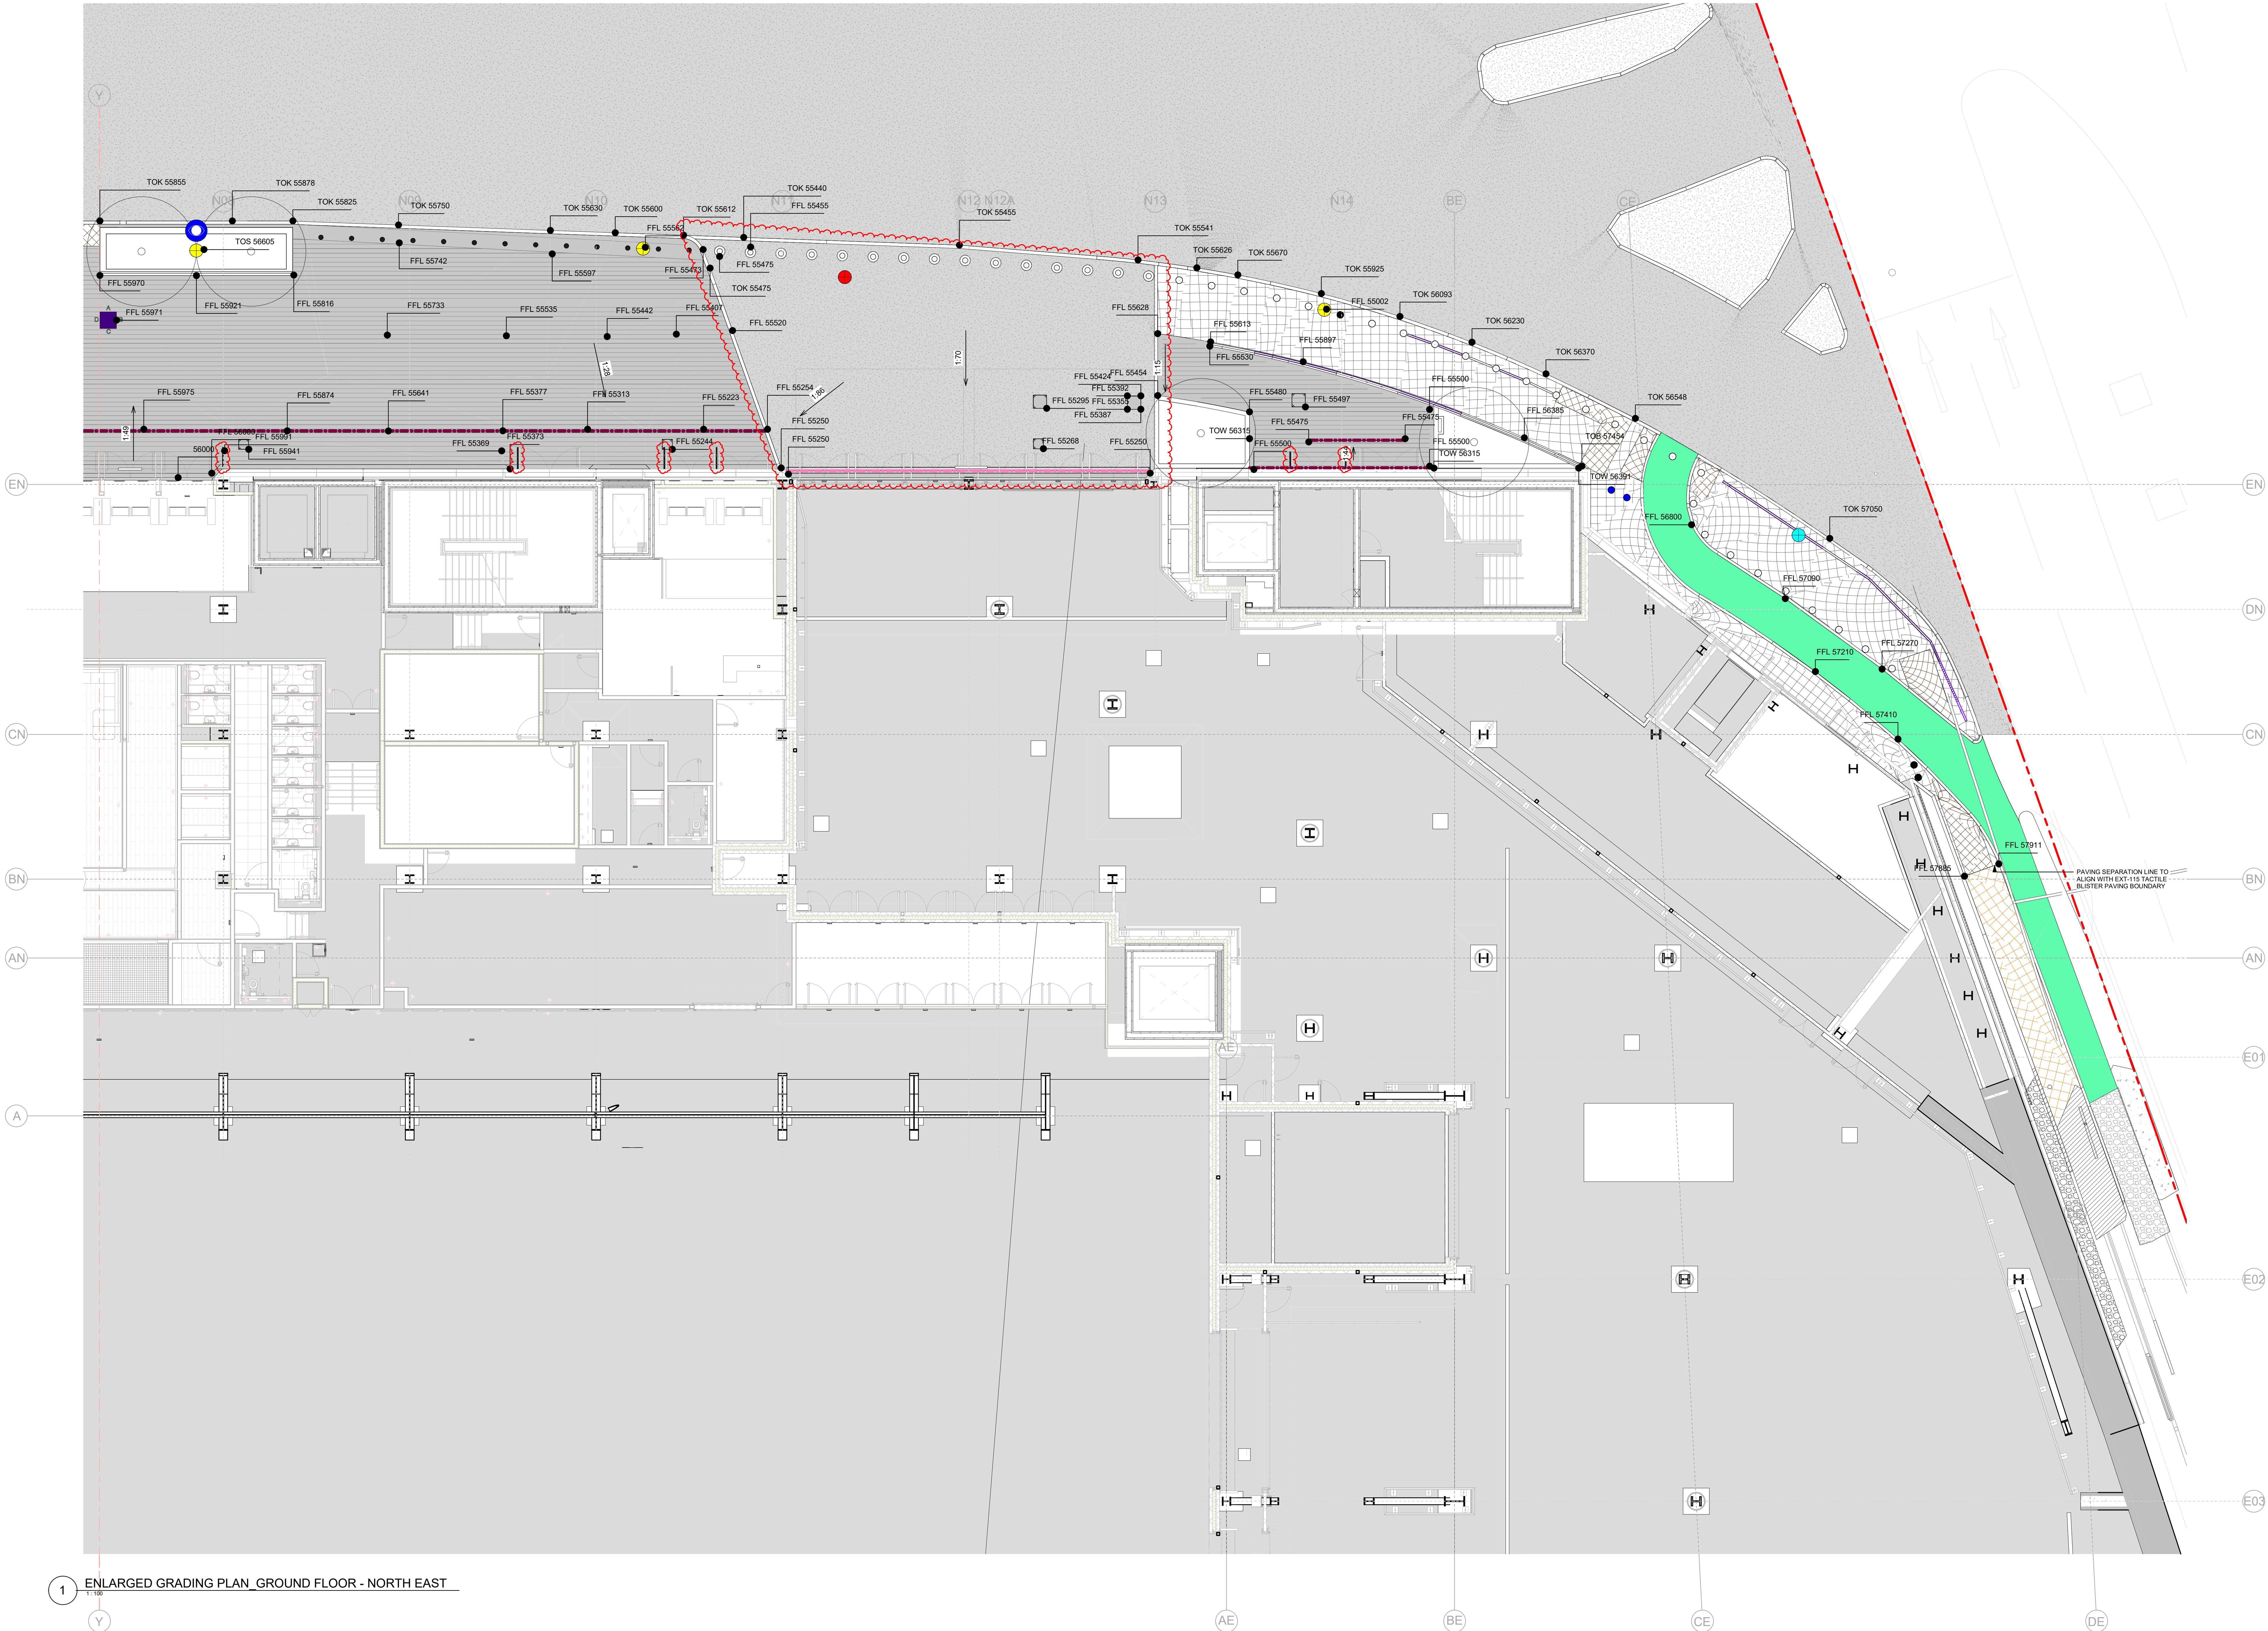

1 ENLARGED GRADING PLAN, GROUND FLOOR - NORTH EAST

Submittal Code (as defined in ISO 19650-2:2018)

Work in Progress (WIP)

50 - Under Review

Shared (Non-Contractual)

S1 - Suitable for co-ordination
S2 - Suitable for information
S3 - Suitable for review & comment
S4 - Suitable for review & comment
S5 - Withdrawn
S6 - Suitable for PM authorisation
S7 - Suitable for AM authorisation

Published (Contractual)

A1, A2, A3, etc. - Authorised and accepted
B1, B2, B3, etc. - Partial sign-off (with comments)

Published (AIM Acceptance)

CR - As constructed record document

KEY PLAN

KEY

- PROJECT BOUNDARY
- EXT-801 SLOT DRAIN TYPE 1
- EXT-803 SLOT DRAIN TYPE 3
- EXT-815 SLOT DRAIN TYPE 4
- EXT-811 SLOT DRAIN TYPE 5
- EXT-811 FLOOR GULLY
- FFL xx.xx FINISH FLOOR LEVEL
- TOK xx.xx TOP OF BALUSTRADE
- TOP xx.xx TOP OF PLANTER
- TOW xx.xx TOP OF WALL
- TOK xx.xx TOP OF KERB
- 1:xx FALL
- DRAINAGE OUTLET (50MM DIA) THROUGH RETAINING WALL
- DRAINAGE OUTLET ON STRUCTURAL SLAB REFER TO SEE DRAWINGS
- DRAINAGE OUTLET (25MM DIA) ON PLANTER WALL (ABOVE FFL)
- DRAINAGE OUTLET (50MM DIA) ON PLANTER CONNECTING TO AGO DRAIN
- DRAINAGE OUTLET (20MM DIA) ON PLANTER WALL (ABOVE FFL)

THIS DRAWING IS ONLY TO SCALE IF IT IS REPRODUCED AT THE CORRECT PAPER SIZE 1:100@A0

ALL INTERNAL LAYOUTS AND USES ARE SHOWN FOR ILLUSTRATIVE PURPOSES ONLY AND ARE NOT FOR DETERMINATION

Safety, Health and Environmental Information

In addition to the hazards / risks normally associated with the types of work detailed on this drawing, note the following risks and information:

Construction See risk register. No abnormal risks identified with this package of work.

For information relating to Live, Closing and Maintenance see the Health and Safety File. It is assumed that all works will be carried out by a competent contractor working, where appropriate, to an approved method statement.

OVG INTERNATIONAL

© COPYRIGHT. ALL RIGHTS RESERVED.

THIS WORK IS COPYRIGHT AND CANNOT BE REPRODUCED OR COPIED IN ANY FORM OR BY ANY MEANS, ELECTRONIC OR MECHANICAL, INCLUDING PHOTOCOPYING, RECORDING, OR BY ANY INFORMATION STORAGE AND RETRIEVAL SYSTEM, WITHOUT THE WRITTEN PERMISSION OF POPULOUS. ANY UNLAWFUL USE OR REPRODUCTION OF THIS DOCUMENT OR ANY PARTS THEREOF IS PROHIBITED TO THE FULLEST EXTENT OF THE LAW. THE USER AGREES TO INDEMNIFY AND HOLD HARMLESS POPULOUS FROM AND AGAINST ALL CLAIMS, DAMAGES, LOSSES AND EXPENSES, INCLUDING REASONABLE ATTORNEY'S FEES, ARISING OUT OF OR IN CONNECTION WITH THE USER'S USE OF THIS DOCUMENT OR ANY PARTS THEREOF.

USE FOR THE PURPOSES OF THE PROJECT ONLY. CHECK ALL DIMENSIONS ON SITE BEFORE CONSTRUCTION OR SETTING OUT.

POPULOUS®

14 BLADES COURT | DODDAR ROAD | LONDON | SW15 2NU | UNITED KINGDOM
TELEPHONE +44 (0)20 8874 7666 FACSIMILE +44 (0)20 8874 7470
ALL PRODUCTION & INTELLECTUAL PROPERTY RIGHTS RESERVED © POPULOUS 2020

REVISIONS

REV	DATE	DESCRIPTION
00	22.06.2020	ISSUED FOR T2 STAGE 4a
01	23.06.2021	STAGE 4b HARD LANDSCAPE
001	02.12.2021	HARD LANDSCAPE PACKAGE FOR CONSTRUCTION
002	24.04.2023	DRAINAGE UPDATE
003	05.05.2023	PLANTERS UPDATE
004	02.06.2023	KERBS UPDATE
005	07.06.2023	THE KERB LINE UPDATE
006	11.06.2023	ADDITIONAL INFORMATION INCLUDED
007	15.06.2023	ADDITIONAL INFORMATION INCLUDED
008	12.06.2023	ADDITIONAL INFORMATION INCLUDED
009	13.10.2023	GA, HARD LANDSCAPE, GRADING & DRAINAGE AND SETTING OUT UPDATE
0010	23.01.2024	LANDSCAPE UPDATE SUBJECT TO DCR #153 AND #157

Co-op Live

the GRADING ENLARGED PLAN
SPORTCITY WAY JUNCTION
GROUND FLOOR

scale 1:100@A0 drawn FP project no. 4933
date 22.06.2020 checked TJ

project code original volume level type role number
reference BRA-POP-ZZ-GF-DR-L-8165

submittal
S3
C010