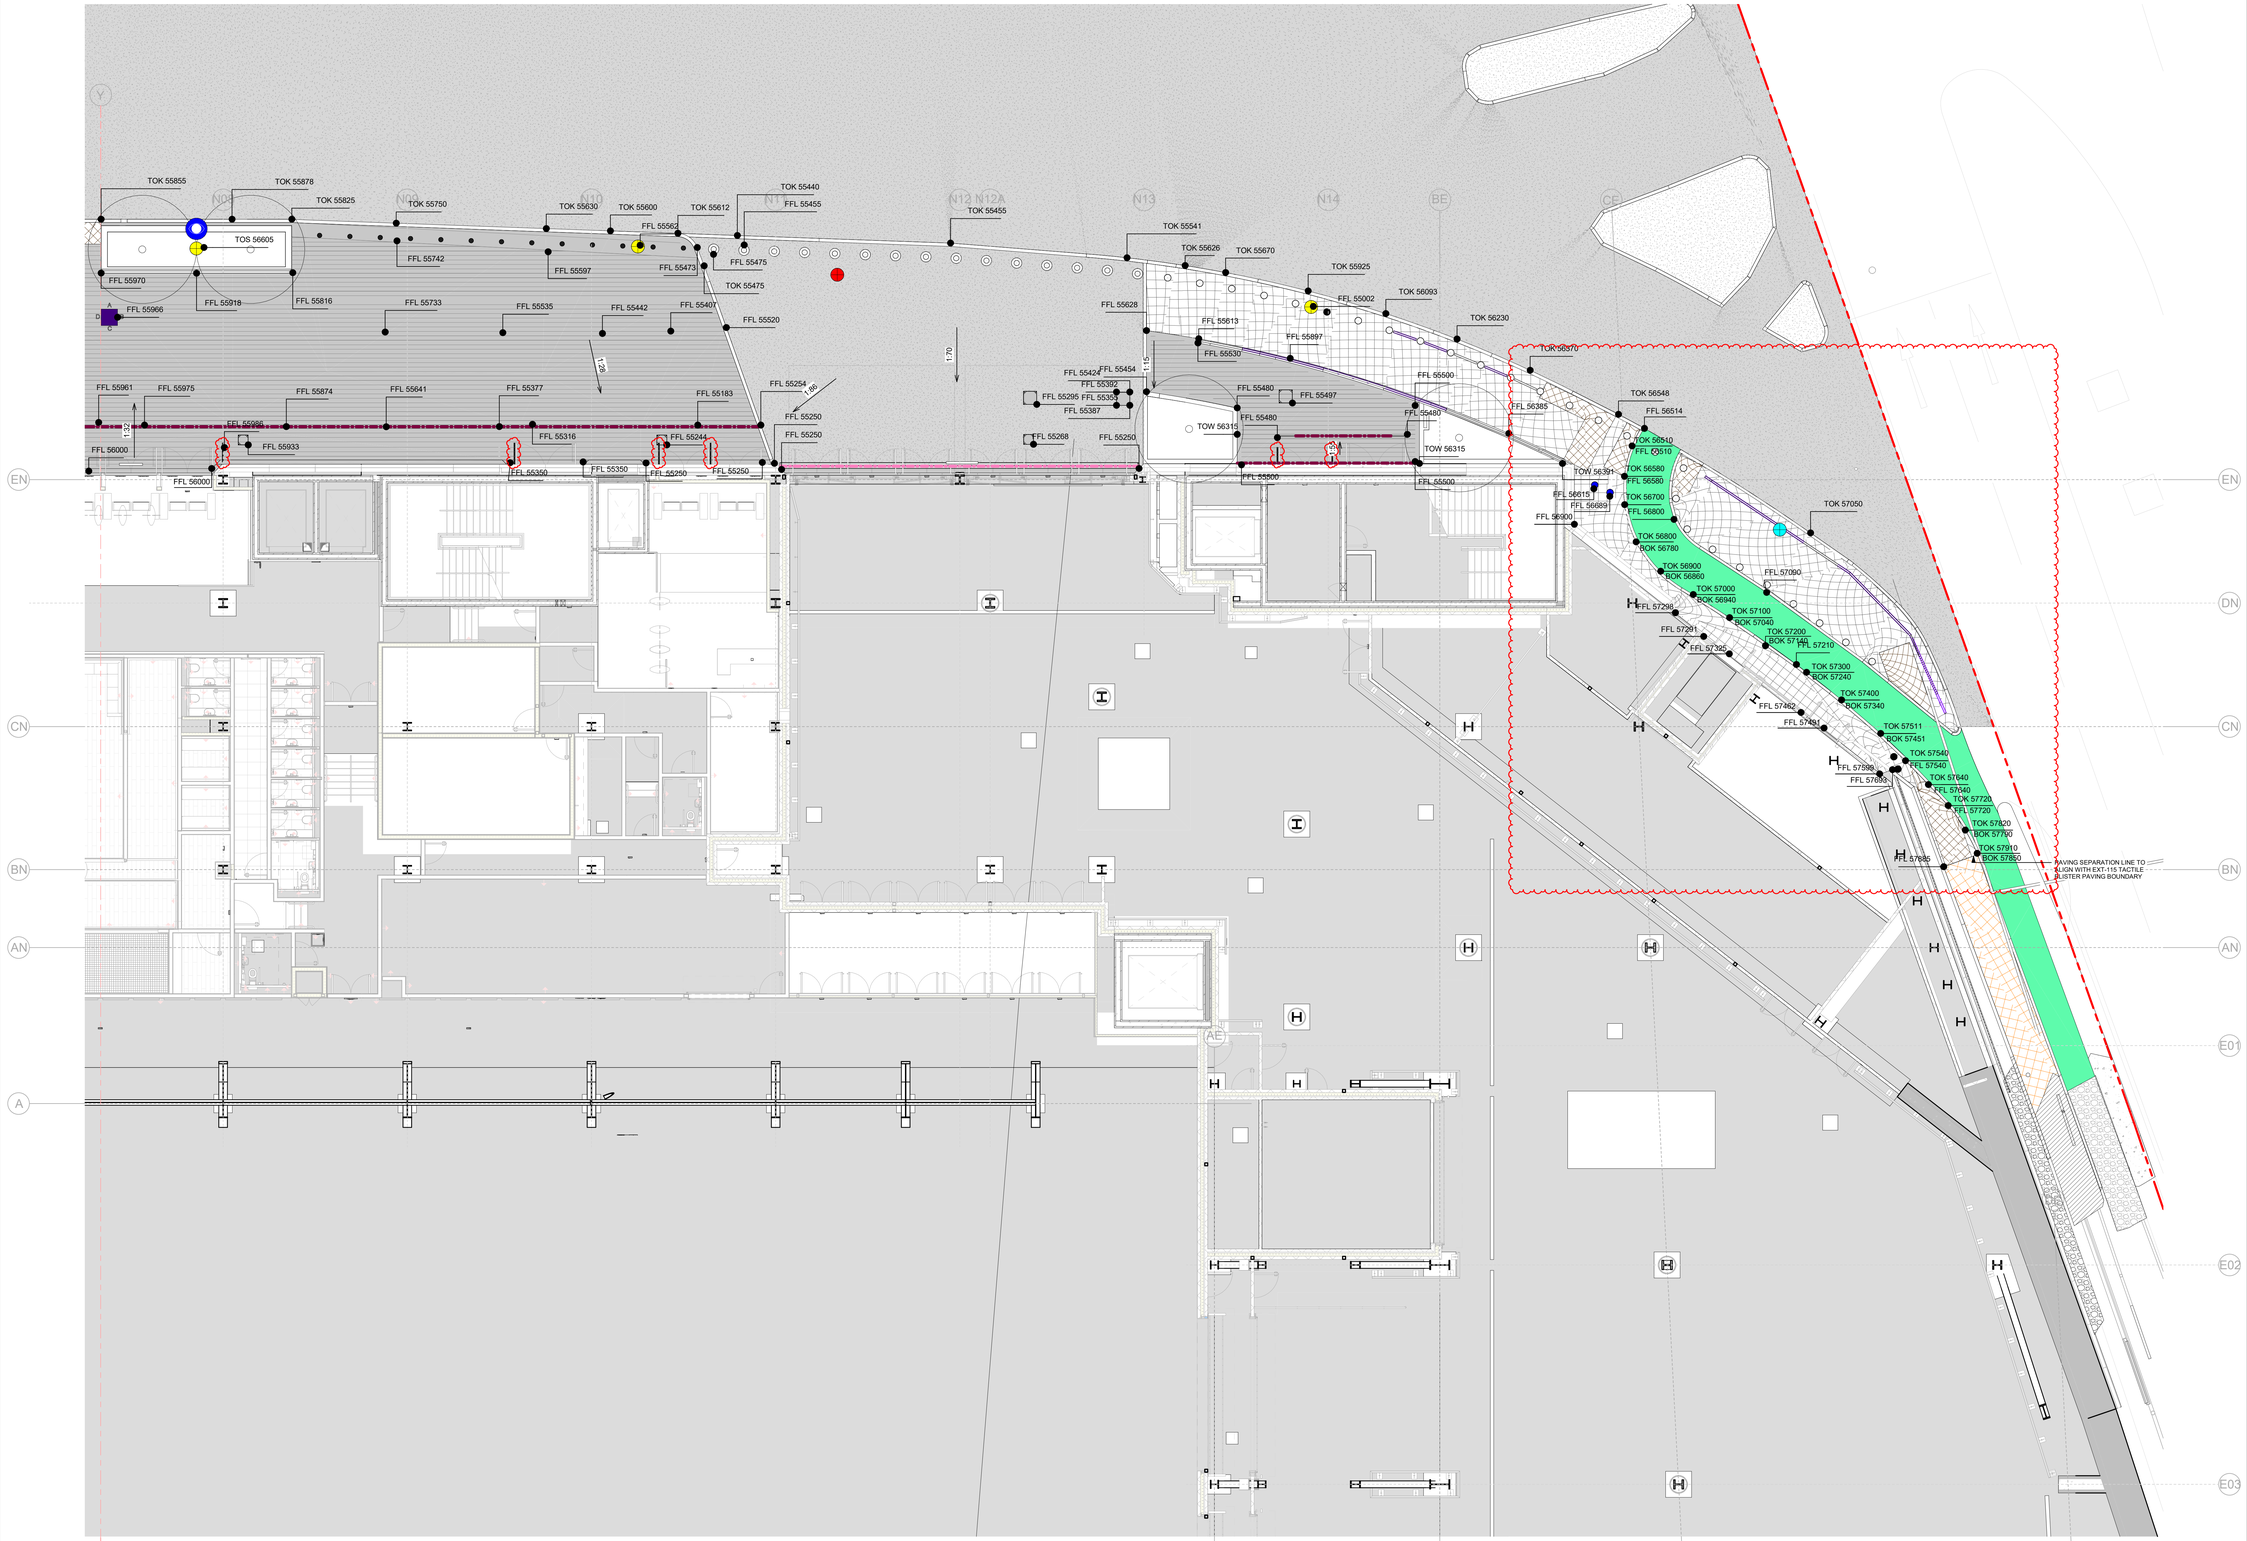

1 ENLARGED GRADING PLAN_GROUND FLOOR - NORTH EAST
1:100

Suitability Code (as defined in ISO 19650-2:2018)

Work in Progress (WIP)
S0 - Initial Status

Shared (Non- Contractual)
S1 - Suitable for co-ordination
S2 - Suitable for information
S3 - Suitable for review & comment
S4 - Suitable for stage approval
S5 - Withdrawn
S6 - Suitable for PIM authorisation
S7 - Suitable for AIM authorisation

Published (Contractual)
A1, A2, A3, Etc - Authorised and accepted
B1,B2,B3, Etc. - Partial sign-off (with comments)

Published (AIM Acceptance)
CR - As constructed record document

KEY PLAN

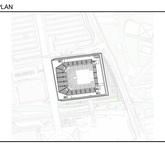

KEY

- PROJECT BOUNDARY
- EXT-801 SLOT DRAIN TYPE 1
- EXT-803 SLOT DRAIN TYPE 3
- EXT-815 SLOT DRAIN TYPE 4
- EXT-817 SLOT DRAIN TYPE 5
- EXT-811 FLOOR GULLY
- FFL XX.XX — FINISH FLOOR LEVEL
- TOB XX.XX — TOP OF BALUSTRADE
- TOP XX.XX — TOP OF PLANTER
- TOW XX.XX — TOP OF WALL
- TOK XX.XX — TOP OF KERB
- 1 : XX — FALL
- DRAINAGE OUTLET (50MM DIA) THROUGH RETAINING WALL
- DRAINAGE OUTLET ON STURCTURAL SLAB REFER TO SES DRAWINGS
- DRAINAGE OUTLET (25MM DIA) ON PLANTER WALL (ABOVE FFL)
- DRAINAGE OUTLET (50MM DIA) ON PLANTER CONNETING TO ACO DRAIN
- DRAINAGE OUTLET (20MM DIA) ON PLANTER WALL (ABOVE FFL)

THIS DRAWING IS ONLY TO SCALE IF IT IS REPRODUCED AT THE CORRECT PAPER SIZE

1:100@A0

0 1 2 3 4 5 m

ALL INTERNAL LAYOUTS AND USES ARE SHOWN FOR ILLUSTRATIVE PURPOSES ONLY AND ARE NOT FOR DETERMINATION

Safety, Health and Environmental Information

In addition to the hazards / risks normally associated with the types of work detailed on this drawing, note the following risks and information:

Construction	See risk register No abnormal risks identified with this package of work

For information relating to Use, Cleaning and Maintenance see the Health and Safety File. It is assumed that all works will be carried out by a competant contractor working, where appropriate, to an approved method statement.

client

OVG INTERNATIONAL

© COPYRIGHT. ALL RIGHTS RESERVED

THIS WORK IS COPYRIGHT AND CANNOT BE REPRODUCED OR COPIED IN ANY FORM OR BY ANY OTHER MEANS (GRAPHIC, ELECTRONIC OR MECHANICAL INCLUDING PHOTOCOPYING) WITHOUT THE WRITTEN PERMISSION OF POPULOUS ANY LICENSE, EXPRESS OR IMPLIED, TO USE THIS DOCUMENT FOR ANY PURPOSE WHATSOEVER IS RESTRICTED BY THE TERMS OF THE AGREEMENT OR IMPLIED AGREEMENT BETWEEN POPULOUS AND THE INSTRUCTING PARTY.

USE FIGURED DIMENSIONS IN PREFERENCE TO SCALED. CHECK ALL DIMENSIONS ON SITE BEFORE FABRICATION OR SETTING OUT

architect

POPULOUS®

14 BLADES COURT | DEODAR ROAD | LONDON | SW15 2NU | UNITED KINGDOM
TELEPHONE +44 (0)20 8874 7666 FACSIMILE +44 (0)20 8874 7470
ALL PRODUCTION & INTELLECTUAL PROPERTY RIGHTS RESERVED © POPULOUS 2009

REVISIONS

REV	DATE	DESCRIPTION
00	22.06.2020	ISSUED FOR T2 STAGE 4a
01	23.04.2021	STAGE 4B HARD LANDSCAPE
C01	02.12.2021	HARD LANDSCAPE PACKAGE FOR CONSTRUCTION
C02	24.04.2023	DRAINAGE UPDATE
C03	05.06.2023	PLANTERS UPDATE
C04	02.06.2023	KERBS UPDATE
C05	07.06.2023	NE KERB LINE UPDATE
C06	11.08.2023	ADDITIONAL INFORMATION INCLUDED
C07	15.08.2023	ADDITIONAL INFORMATION INCLUDED
C08	12.09.2023	ADDITIONAL INFORMATION INCLUDED
C09	13.10.2023	SA, HARD LANDSCAPE, GRADING & DRAINAGE AND SETTING OUT UPDATE
C010	23.01.2024	LANDSCAPE UPDATE SUBJECT TO DCR #153 AND #5157
C011	19.03.2024	SPOT LEVELS ADDED

project name **Co-op Live**

title GRADING ENLARGED PLAN
SPORTCITY WAY JUNCTION
GROUND FLOOR

purpose of issue **CONSTRUCTION RECORD**

scale 1:100@A0 drawn FP Project no. Suitability
date 22.06.2020 checked TJ 4933 **S3**

reference project code originator volume level type role number **BRA-POP-ZZ-GF-DR-L-8165** rev. **C011**