


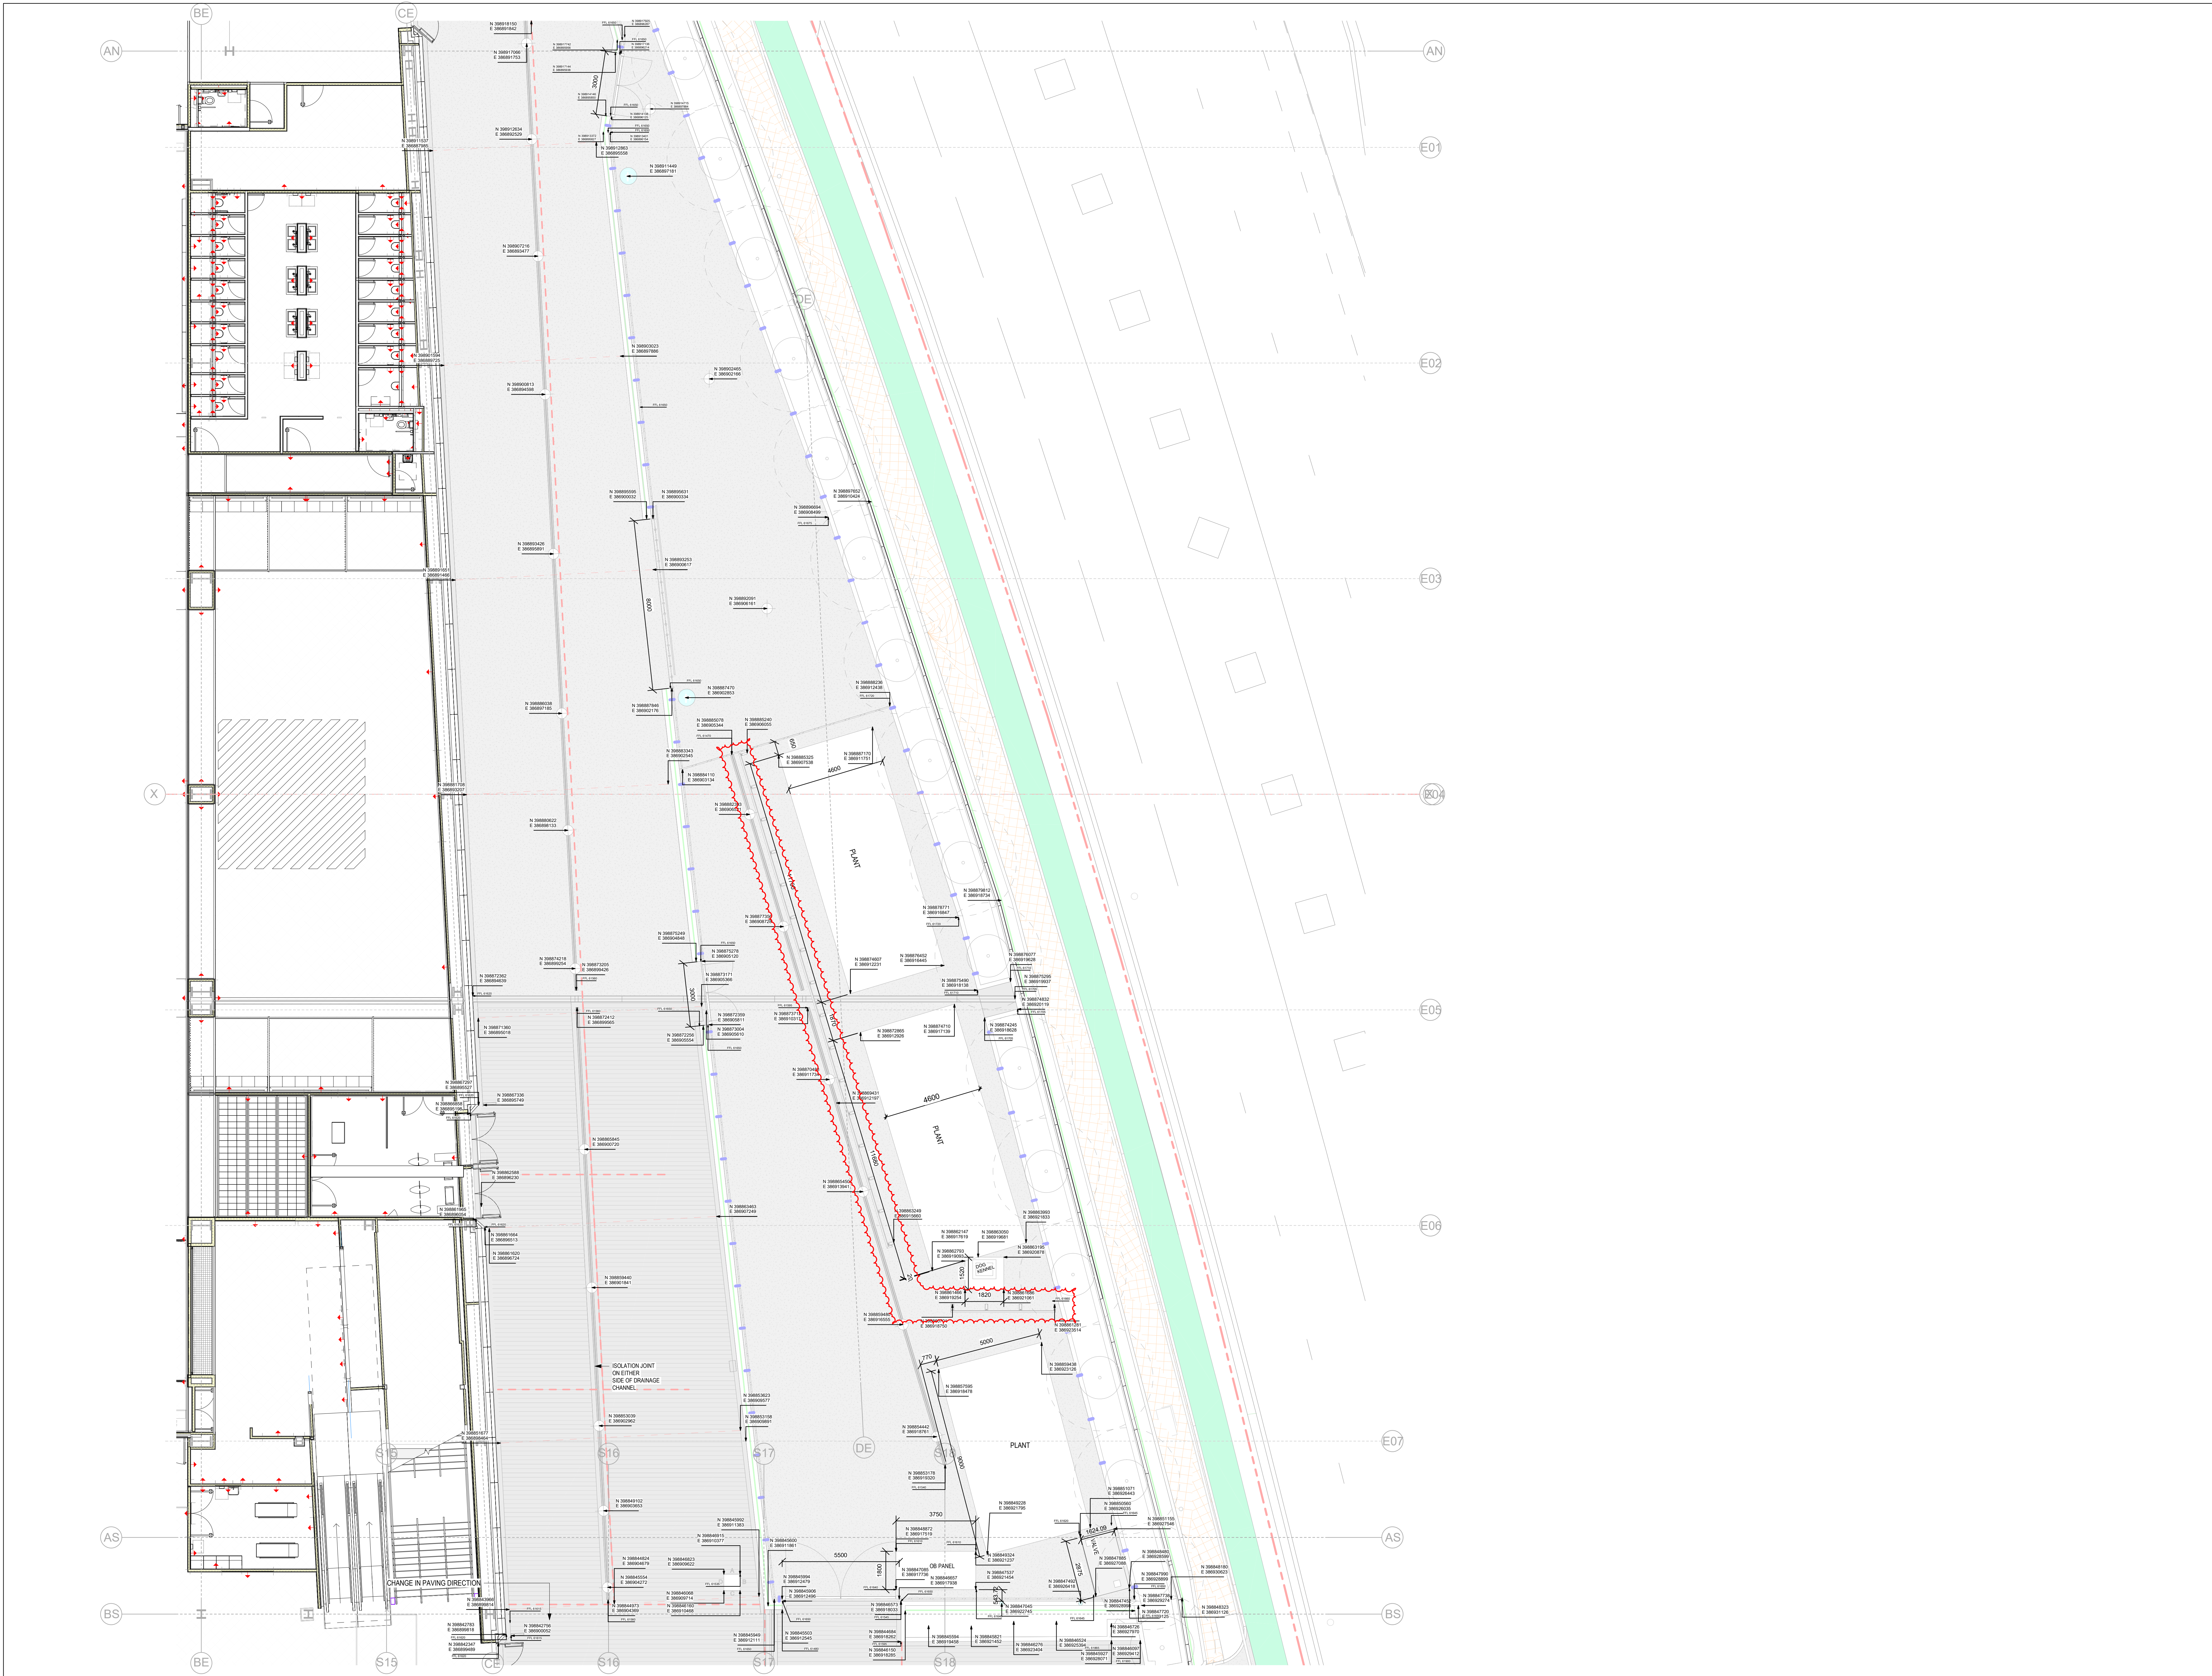

Suitability Code (as defined in ISO 19650-2:2018)

Work in Progress (WIP)

S0 - Initial Status

Shared (Non-Contractual)

S1 - Suitable for co-ordination
S2 - Suitable for information
S3 - Suitable for review & comment
S4 - Suitable for stage approval
S5 - Withdrawn
S6 - Suitable for PM authorisation
S7 - Suitable for AM authorisation

Published (Contractual)

A1, A2, A3, Etc - Authorised and accepted
B1, B2, B3, Etc - Partial sign-off (with comments)

Published (AIM Acceptance)

CR - As constructed record document

KEY PLAN

KEY

--- PLANNING APPLICATION BOUNDARY

• N XXXXXXXXXX
• E XXXXXXXXXX COORDINATES AT SPOT

⊕ DRAINAGE PENETRATION OUTLET IN STRUCTURAL SLAB

⊕ BB TAP

THIS DRAWING IS ONLY TO SCALE IF IT IS REPRODUCED AT THE CORRECT PAPER SIZE

1:100@A0

0 1 2 3 4 5

ALL INTERNAL LAYOUTS AND USES ARE SHOWN FOR ILLUSTRATIVE PURPOSES ONLY AND ARE NOT FOR DETERMINATION

Safety, Health and Environmental Information

In addition to the hazards / risks normally associated with the types of work detailed on this drawing, note the following risks and information:

Construction See risk register. No abnormal risks identified with this package of work.

For information relating to Live, Closing and Maintenance see the Health and Safety File. It is assumed that all works will be carried out by a competent contractor working, where appropriate, to an approved method statement.

POPULOUS[®]

14 BLADES COURT | DEODAR ROAD | LONDON | SW15 2NU | UNITED KINGDOM
TELEPHONE +44 (0)20 8874 7686 FACSIMILE +44 (0)20 8874 7470
ALL PRODUCTION & INTELLECTUAL PROPERTY RIGHTS RESERVED © POPULOUS 2023

REVISIONS

REV	DATE	DESCRIPTION
002	02.12.2021	HARD LANDSCAPE PACKAGE FOR CONSTRUCTION
003	13.07.2022	EAST PODIUM PLANTER AND MOVEMENT JOINT LANDSCAPE UPDATE FOLLOWING DCR 0099 / RFI 0005
004	23.12.2022	LEVEL 01 AMENDMENT FOLLOWING DCRs 0096 & 0114 AND UPDATED LEVEL 01 SETTING OUT
005	17.03.2023	ADDITIONAL INFORMATION INCLUDED
006	09.08.2023	ADDITIONAL INFORMATION INCLUDED
007	11.08.2023	ISSUED FOR CONSTRUCTION
008	21.08.2023	ADDITIONAL INFORMATION INCLUDED
009	05.09.2023	ADDITIONAL INFORMATION INCLUDED
010	28.09.2023	ADDITIONAL INFORMATION INCLUDED
011	09.10.2023	PODIUM DRAINAGE UPDATE
012	13.10.2023	FOR HARD LANDSCAPE, GRADING & DRAINAGE AND SETTING OUT UPDATE
013	08.02.2024	LANDSCAPE BARRIER UPDATE

Co-op Live

1st SETTING OUT ENLARGED PLAN
COMPOUND AREA
LEVEL 01

scale 1:100@A0
date 26/03/21
drawn FP
checked TJ
Project no. 4933
Suitability S3

project code original volume level type role number
revision BRA-POP-ZZ-01-DR-L-8174 C013