


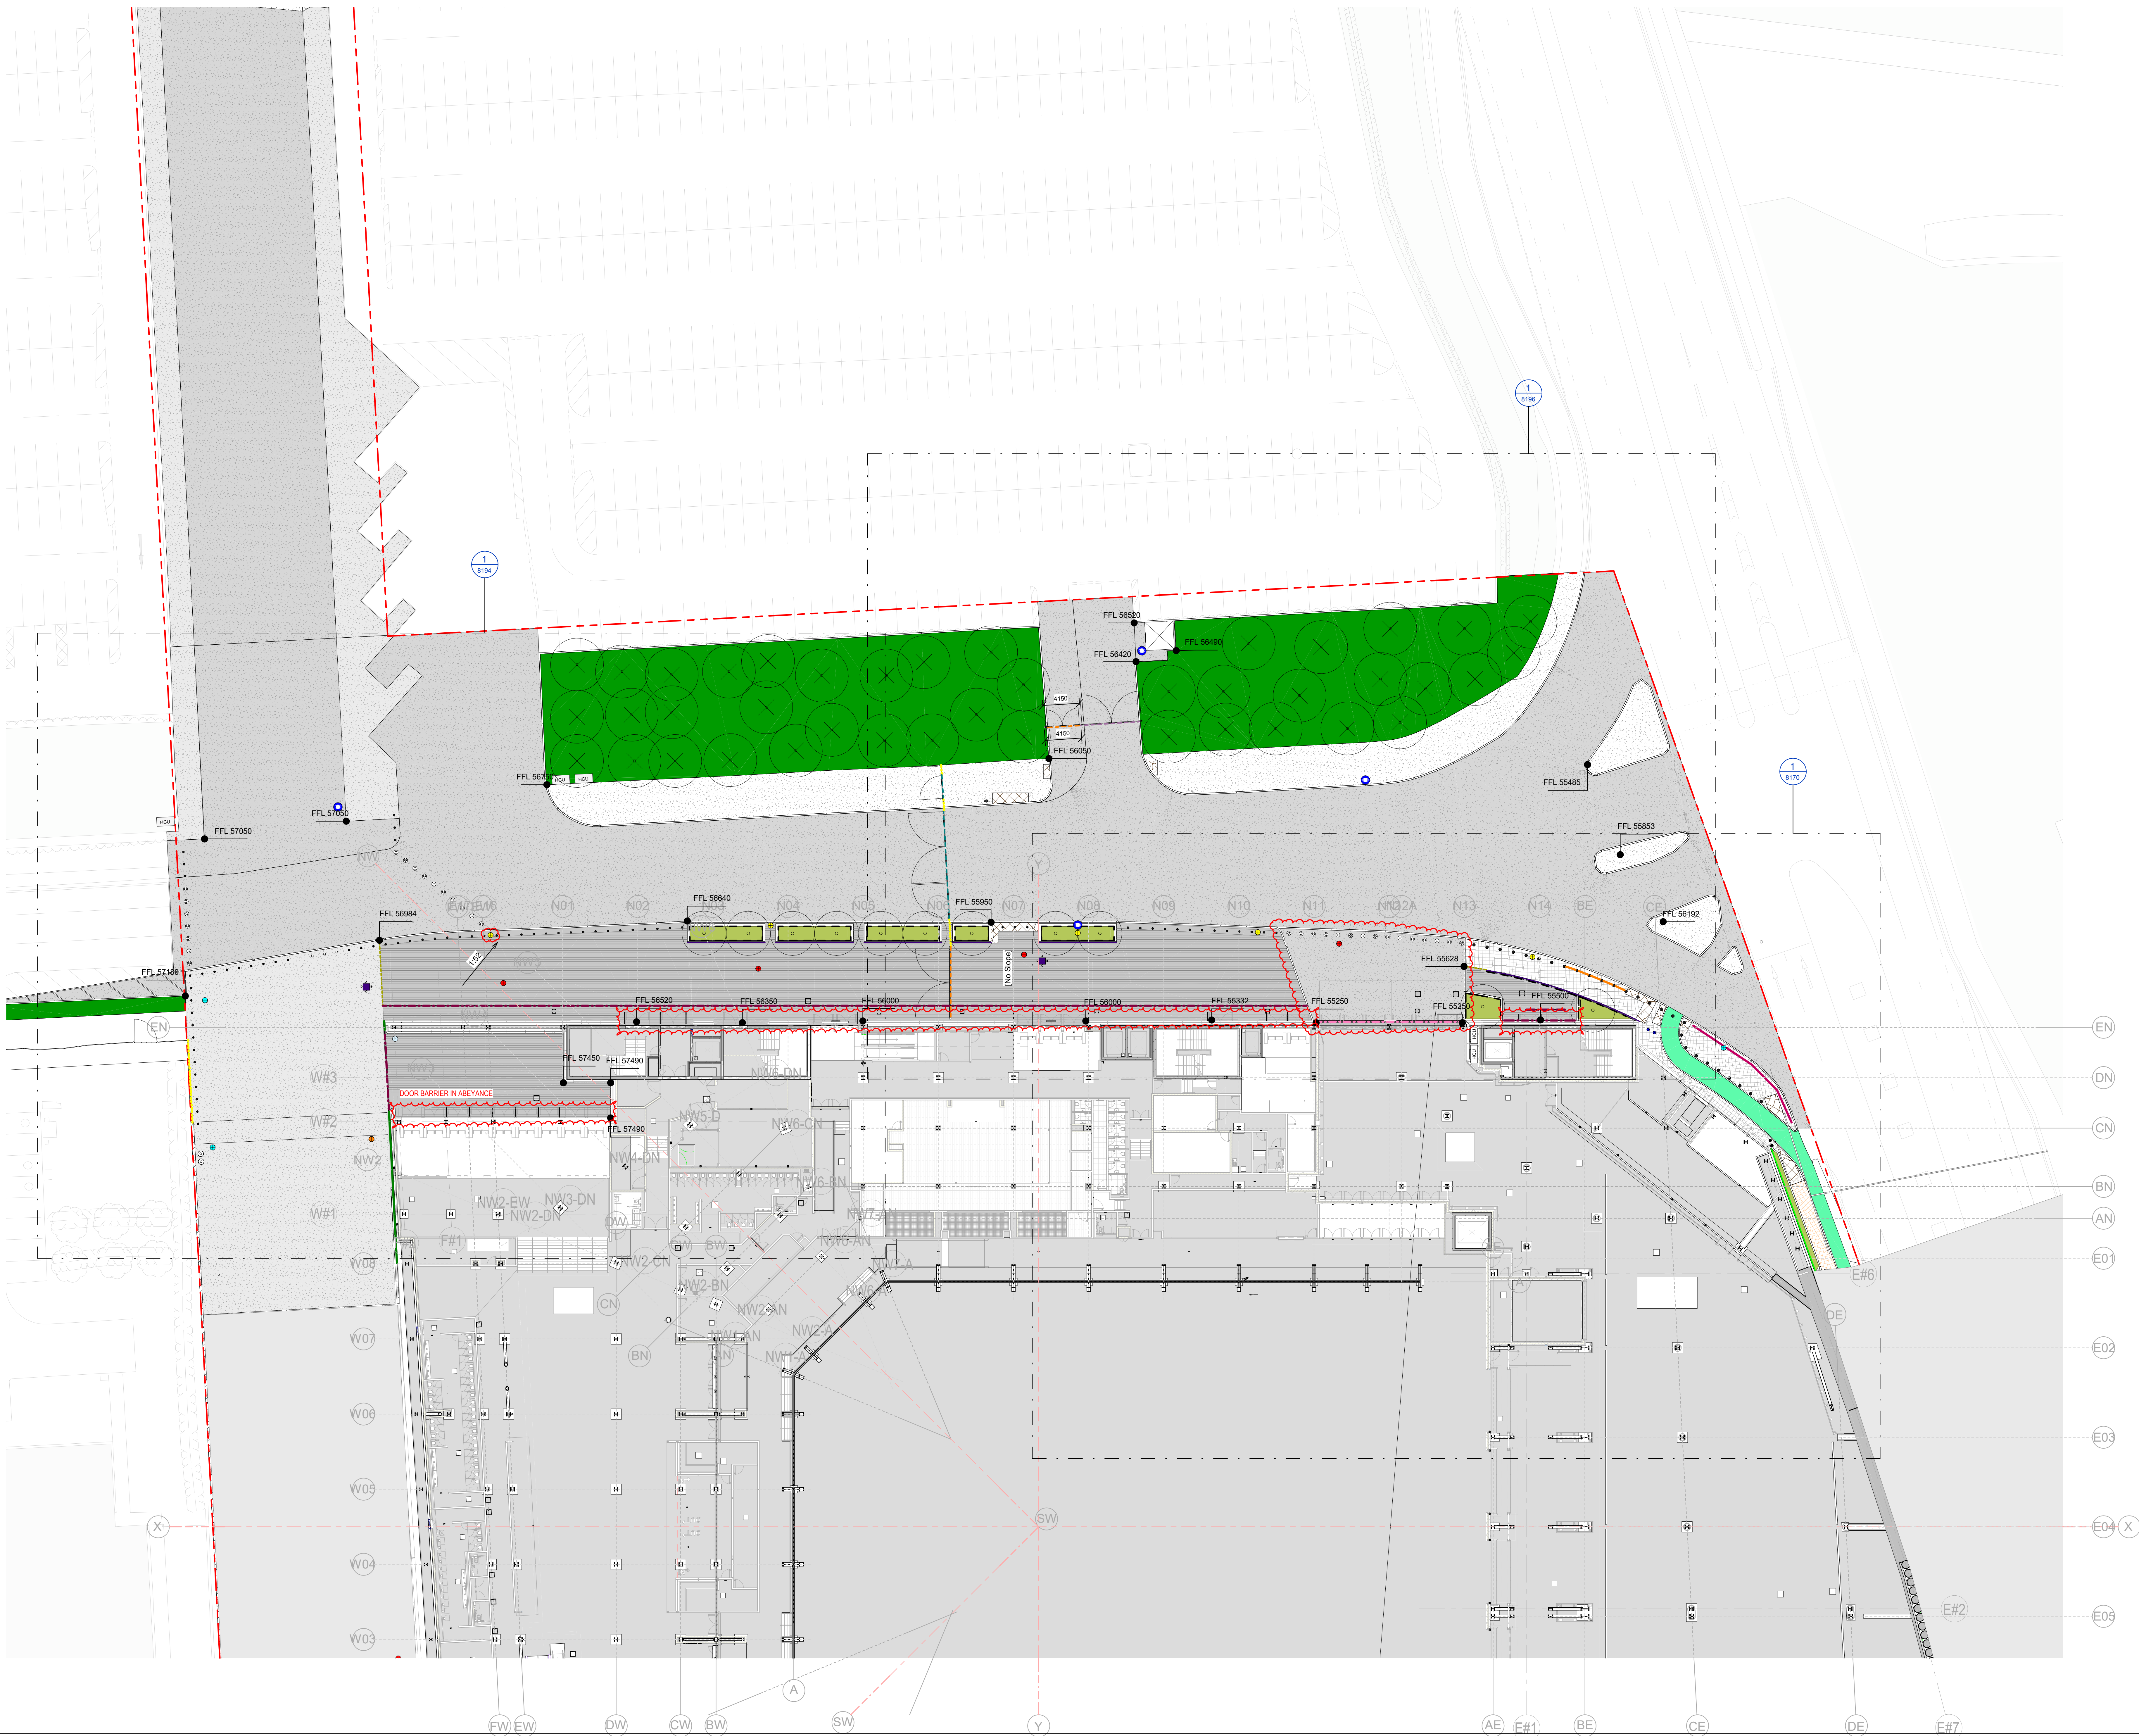

Suitability Code (as defined in ISO 19650-2:2018)

Work in Progress (WIP)

50 - Under Construction

Shared (Non-Contractual)

S1 - Suitable for co-ordination

S2 - Suitable for information

S3 - Suitable for review & comment

S4 - Suitable for sign-off

S5 - Withdrawn

S6 - Suitable for PM authorisation

S7 - Suitable for AM authorisation

Published (Contractual)

A1, A2, A3, Etc - Authorised and accepted

B1, B2, B3, Etc - Partial sign-off (with comments)

Published (AIM Acceptance)

CR - As constructed record document

KEY PLAN

KEY

PROJECT BOUNDARY

CONCRETE BLOCK PAVING IMPERMEABLE

EXT-131 TARMAC

EXT-135 COATED MACADAM PAVING - WITH

TEXTUREFLEX TOP COAT

EXT-112 CONCRETE PAVING SLAB

EXT-201, EXT-202, EXT-203 CONCRETE KERB

EXT-221 METAL EDGING

EXT-333 CONCRETE PLANTER

EXT-301 PAS RATED STATIC BOLLARD

EXT-303 PAS RATED RETRACTABLE BOLLARD - TYPE 1

EXISTING BOLLARD TO BE RELOCATED

RELOCATED EXISTING STATIC BOLLARD

RELOCATED EXISTING RETRACTABLE BOLLARD

RELOCATED EXISTING LITTER BIN

RELOCATED EXISTING CONCRETE BENCHES

EXT-423 DOOR BARRIER

EXT-405, EXT-429 GATE

RELOCATED EXISTING GATE

EXISTING GATE TO BE RETAINED

EXT-401, EXT-402 SECURITY FENCE

EXT-471 CONCRETE WALL

EXT-411, EXT-412 BALUSTRADE

EXT-413 BALUSTRADE PANEL FIXED ON THE

BOLLARDS BASE PLATE

EXT-414 BALUSTRADE PANEL FIXED ON THE

FOUNDATION IN THE GROUND

EXT-541 GREEN SCREEN

EXT-544 LIVING WALL

EXT-801 SLOT DRAIN TYPE 1

EXT-803 SLOT DRAIN TYPE 3

EXT-811 FLOOR GULLY

WAYFINDING ITEM

EXT-335 SECURITY HUT

EXT-561 PROPOSED TREES

EXISTING TREES TO BE RETAINED

EXISTING TREES TO BE REMOVED

EXT-568 SHRUB AND UNDERSTORY PLANTING

EXISTING PLANTING

PROPOSED LIGHTING COLUMN

EXISTING LIGHTING COLUMN TO BE RETAINED

EXISTING LIGHTING COLUMN TO BE REMOVED

EXISTING LIGHTING COLUMN TO BE RELOCATED

RELOCATED EXISTING LIGHTING COLUMN

CCTV CAMERA

THIS DRAWING IS ONLY TO SCALE IF IT IS

REPRODUCED AT THE CORRECT PAPER SIZE

1:250@A0

ALL INTERNAL LAYOUTS AND USES ARE SHOWN

FOR ILLUSTRATIVE PURPOSES ONLY AND ARE

NOT FOR DETERMINATION

drawn

OVG

INTERNATIONAL

© COPYRIGHT. ALL RIGHTS RESERVED.

THIS WORK IS COPYRIGHTED AND CANNOT BE REPRODUCED OR COPIED IN ANY FORM OR BY

ANY MEANS WITHOUT THE WRITTEN PERMISSION OF POPULOUS. ANY LICENSE, EXPRESS OR IMPLIED,

TO USE THIS DOCUMENT OR ANY PART THEREOF IS HEREBY RESTRICTED TO THE TERMS

OF THE AGREEMENT OR IMPLIED AGREEMENT BETWEEN POPULOUS AND THE INSTRUCTING

PARTY.

USE FOR PRELIMINARY DESIGN PURPOSES ONLY. CHECK ALL DIMENSIONS ON SITE

BEFORE PROCEEDING WITH CONSTRUCTION.

drawn

POPULOUS®

14 BLADES COURT | DODDAR ROAD | LONDON | SW15 2NU | UNITED KINGDOM

TELEPHONE +44 (0)20 8874 7666 | FACSIMILE +44 (0)20 8874 7470

ALL PRODUCTION & INTELLECTUAL PROPERTY RIGHTS RESERVED © POPULOUS 2020

REVISIONS

REV DATE DESCRIPTION

00 30.10.2020 STAGE 4A - INCREASE IN SCOPE TO PLANNING

01 16.11.2020 STAGE 4A - INCREASE IN SCOPE TO PLANNING

02 09.07.2021 STAGE 4B TO INCORPORATE VE UPDATE

03 02.12.2021 HARD LANDSCAPE PACKAGE FOR CONSTRUCTION

04 13.06.2022 FLOOR GULLY TO BE NORTH WEST ENTRANCE

RELOCATED FOLLOWING CIVIL UPDATE RFI #2140

05 13.10.2022 GRASSY LANDSCAPE, GRADING & DRAINAGE AND

SETTING OUT UPDATE

06 22.02.2023 PAVING UPDATES IN RESPONSE TO RFI 4897, B&M IN

1730152, E&I 272 AND LIGHTING COLUMN LOCATION

UPDATES BASED ON RFI 4688-4833, TOTEM SETTING

OUT BASED ON RFI 4577

project name

Co-op Live

the EXTENDED NORTH WALKWAY

GENERAL ARRANGEMENT PLAN

GROUND FLOOR

scale 1: 250 @ A0

drawn FP

checked TJ

Project no. 4933

date 30.10.2020

revised

project code original version level type role number

BRA-POP-ZZ-GF-DR-L-8120

revised

C04

submittal

S3