



Land Parcel Affected in Red existing in blue

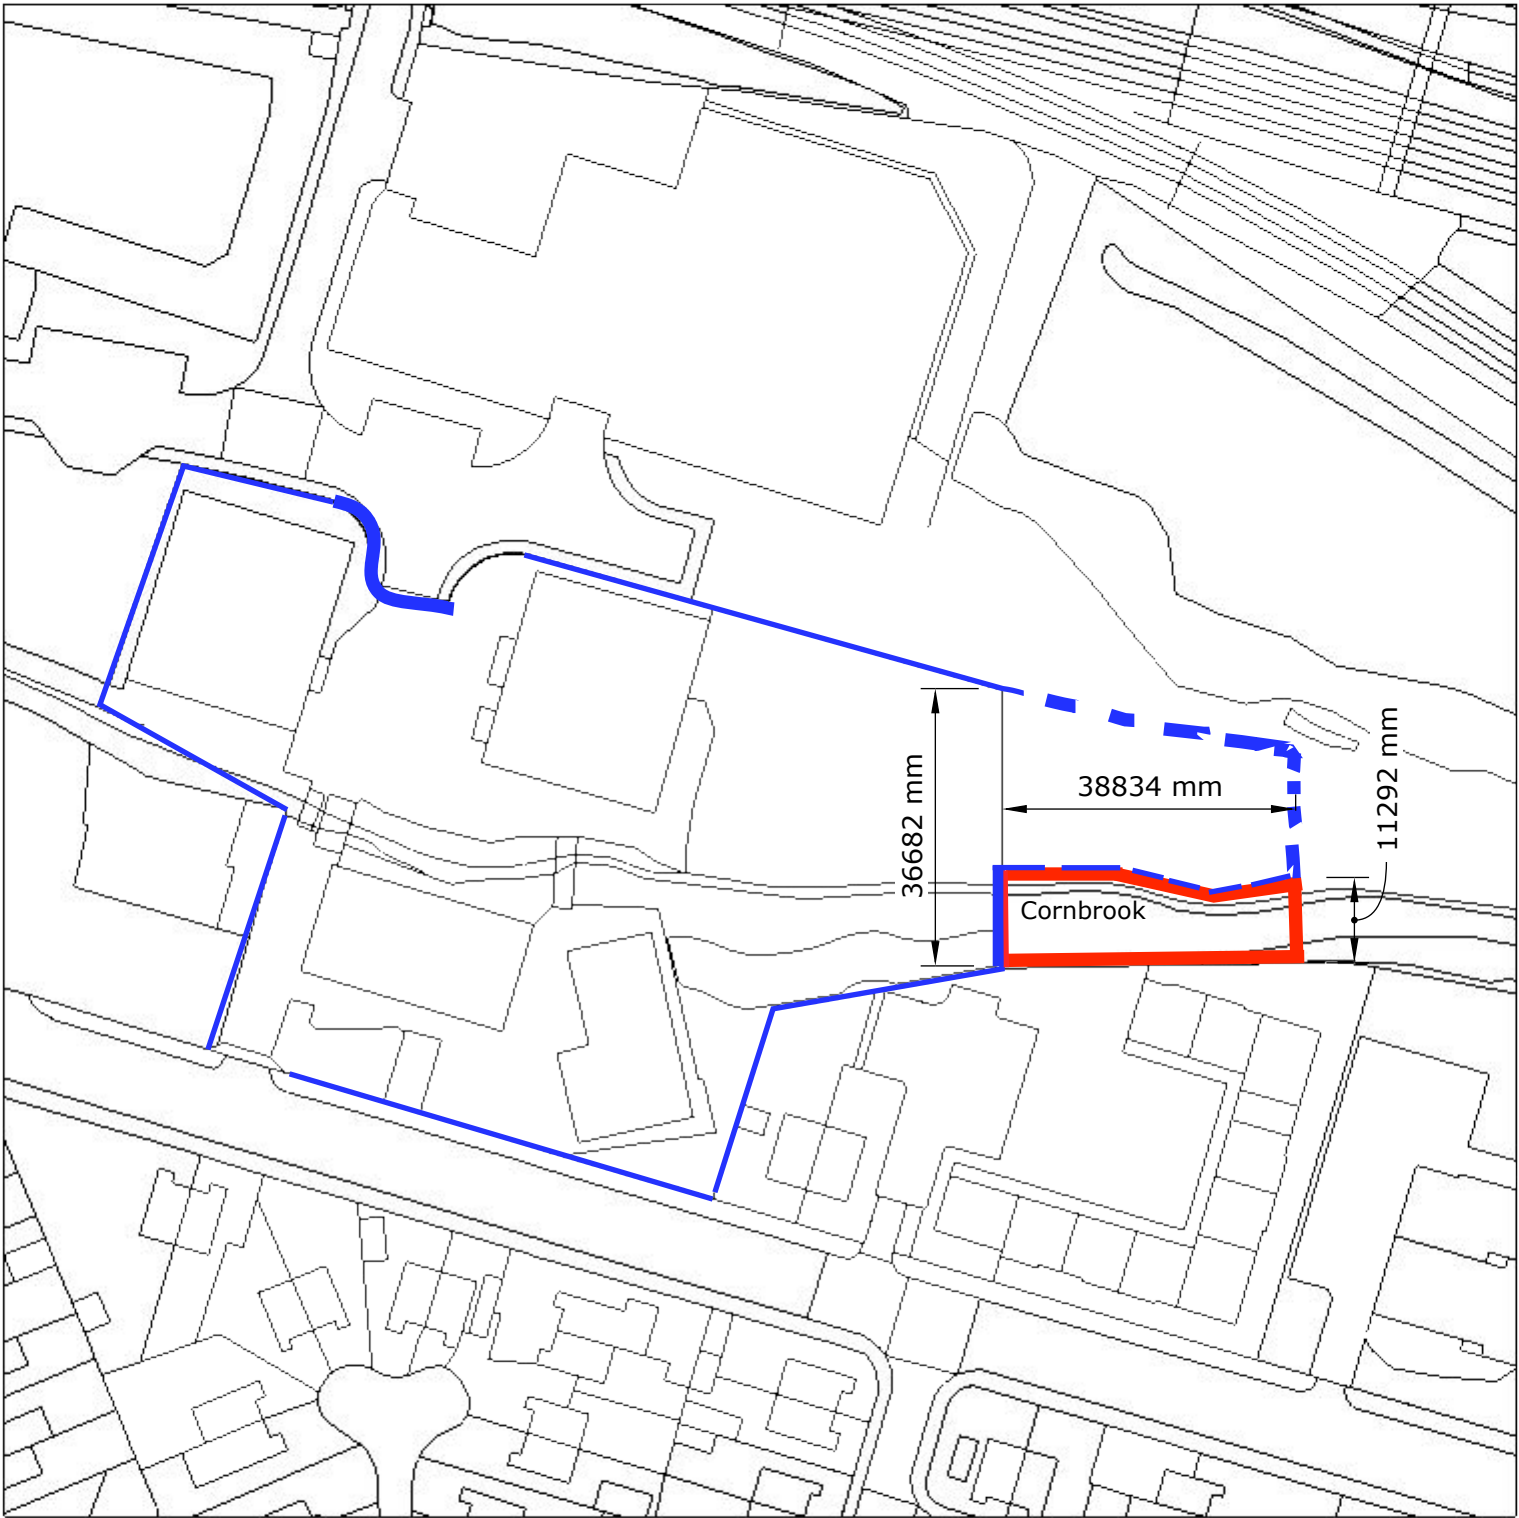


Previously Approved
not yet fenced


Application

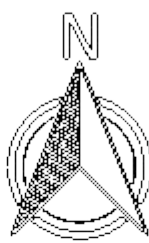


Paladin fencing for new enclosure to be painted

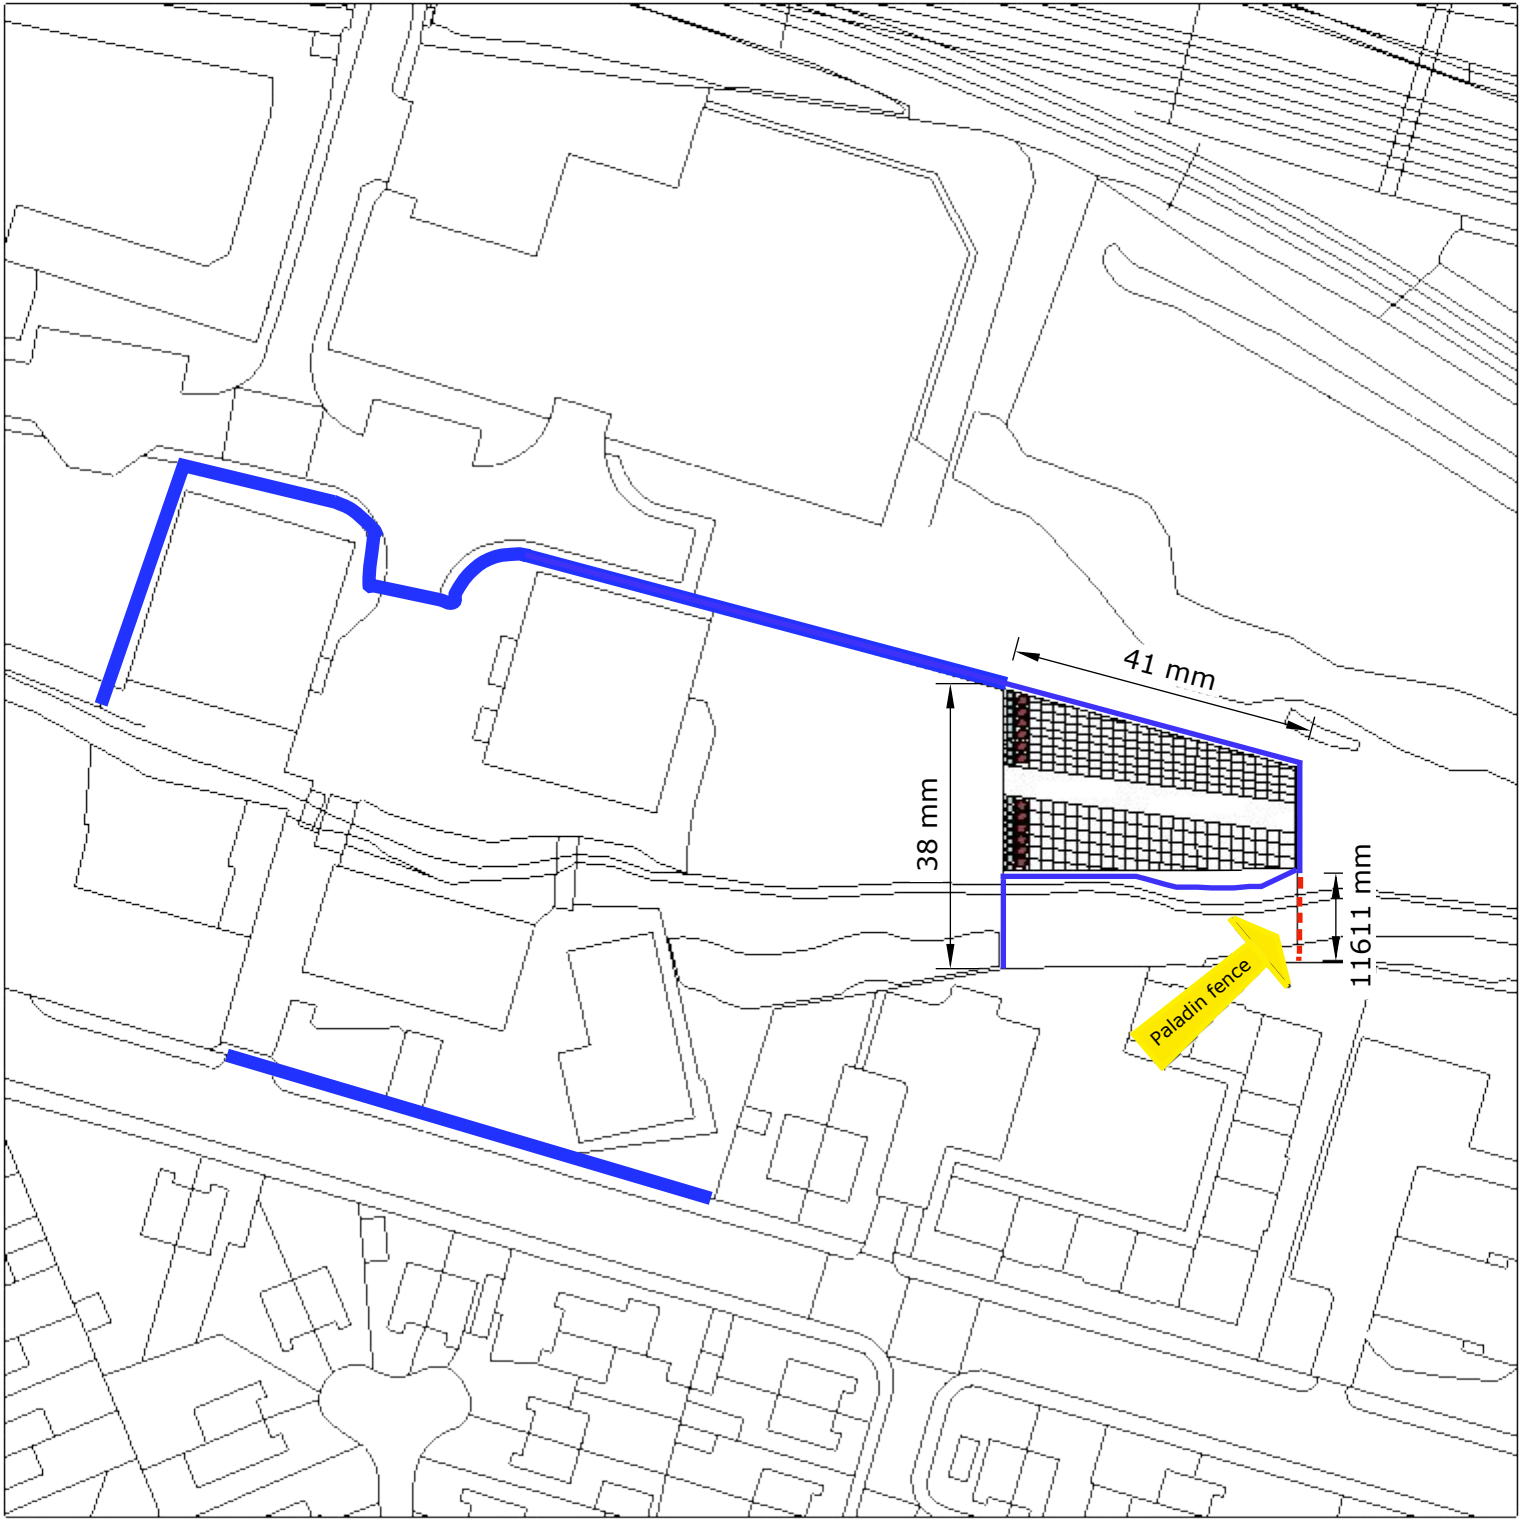

New colour fence location (As per yellow arrow marker)

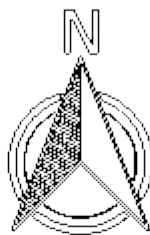


The thinner blue lines are fencing enclosures for existing plans not yet implemented as at the date of this application

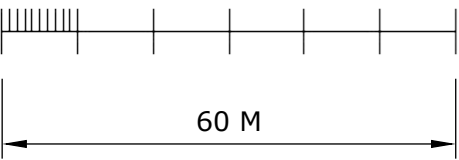

Revised boundary from former application
Now extends across the Cornbrook



Existing Boundary Of J Allcock and Sons

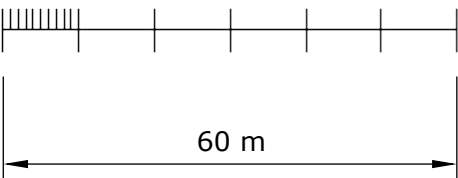

Proposed paladin 2.5m Fencing



Existing boundary Fencing
Comprising 250m of Palisade

This drawing represents the design and function of the equipment depicted. The final product may vary in precise detail subject to suitability of component manufacture. Structural performance is not warranted, such information is available by separate warrant only where requested in writing from us and may be subject to charges. We take no responsibility for existing structures, patent infringements or design variations. We reserve the right to modify or change any features which do not fit with our final build programs as we see fit in the reasonable pursuit of best engineering practices and safe design without notice.

REVISIONS		
MM/DD/YY	REMARKS	
1 15/10/2022	Colour coding and boundary correction display	
2 --/--/--	...	
3 --/--/--	...	
4 --/--/--	...	
5 --/--/--	...	




© MMXXII IP	IMPORTANT Property of Engineered Solutions (Projects) Ltd. You MUST NOT copy or re-use this drawing without written permission. We reserve an enduring right in respect of the aforementioned and we do not concede this statement irrespective of any terms and conditions of purchase stated or otherwise. The copy rights and IP are retained. Wherever you may see these products, you are NOT free to copy them or use them for your own financial gain. If you wish to do this it will be by separate treaty as a design only contract.
This drawing represents the design and function of the equipment depicted. The final product may vary in precise detail subject to suitability of component manufacture. Structural performance is not warranted, such information is available by separate warrant only where requested in writing from us and may be subject to charges. We take no responsibility for existing structures, patent infringements or design variations. We reserve the right to modify or change any features which do not fit with our final build programs as we see fit in the reasonable pursuit of best engineering practices and safe design without notice. Checking the proposed works to ensure they don't result in unbudgeted conflicting site activities is the responsibility of the client or their appointed agents or officials.	

Scale	As stated	Status		
Title	Adjusted fence boundary	Design ☐	Production ☐	Other ☒
Drg No.	010622.2	Estimating ☐	As Built ☐	DRN PRC
Issue No.	A.01	Approval ☐	Records ☐	Date 04.04.2024

Approved site

Subject to conditions

Landlord permission granted to extend fence boundary straight across Cornbrook at this location, in place of parallel to Corn Brook planning consent required

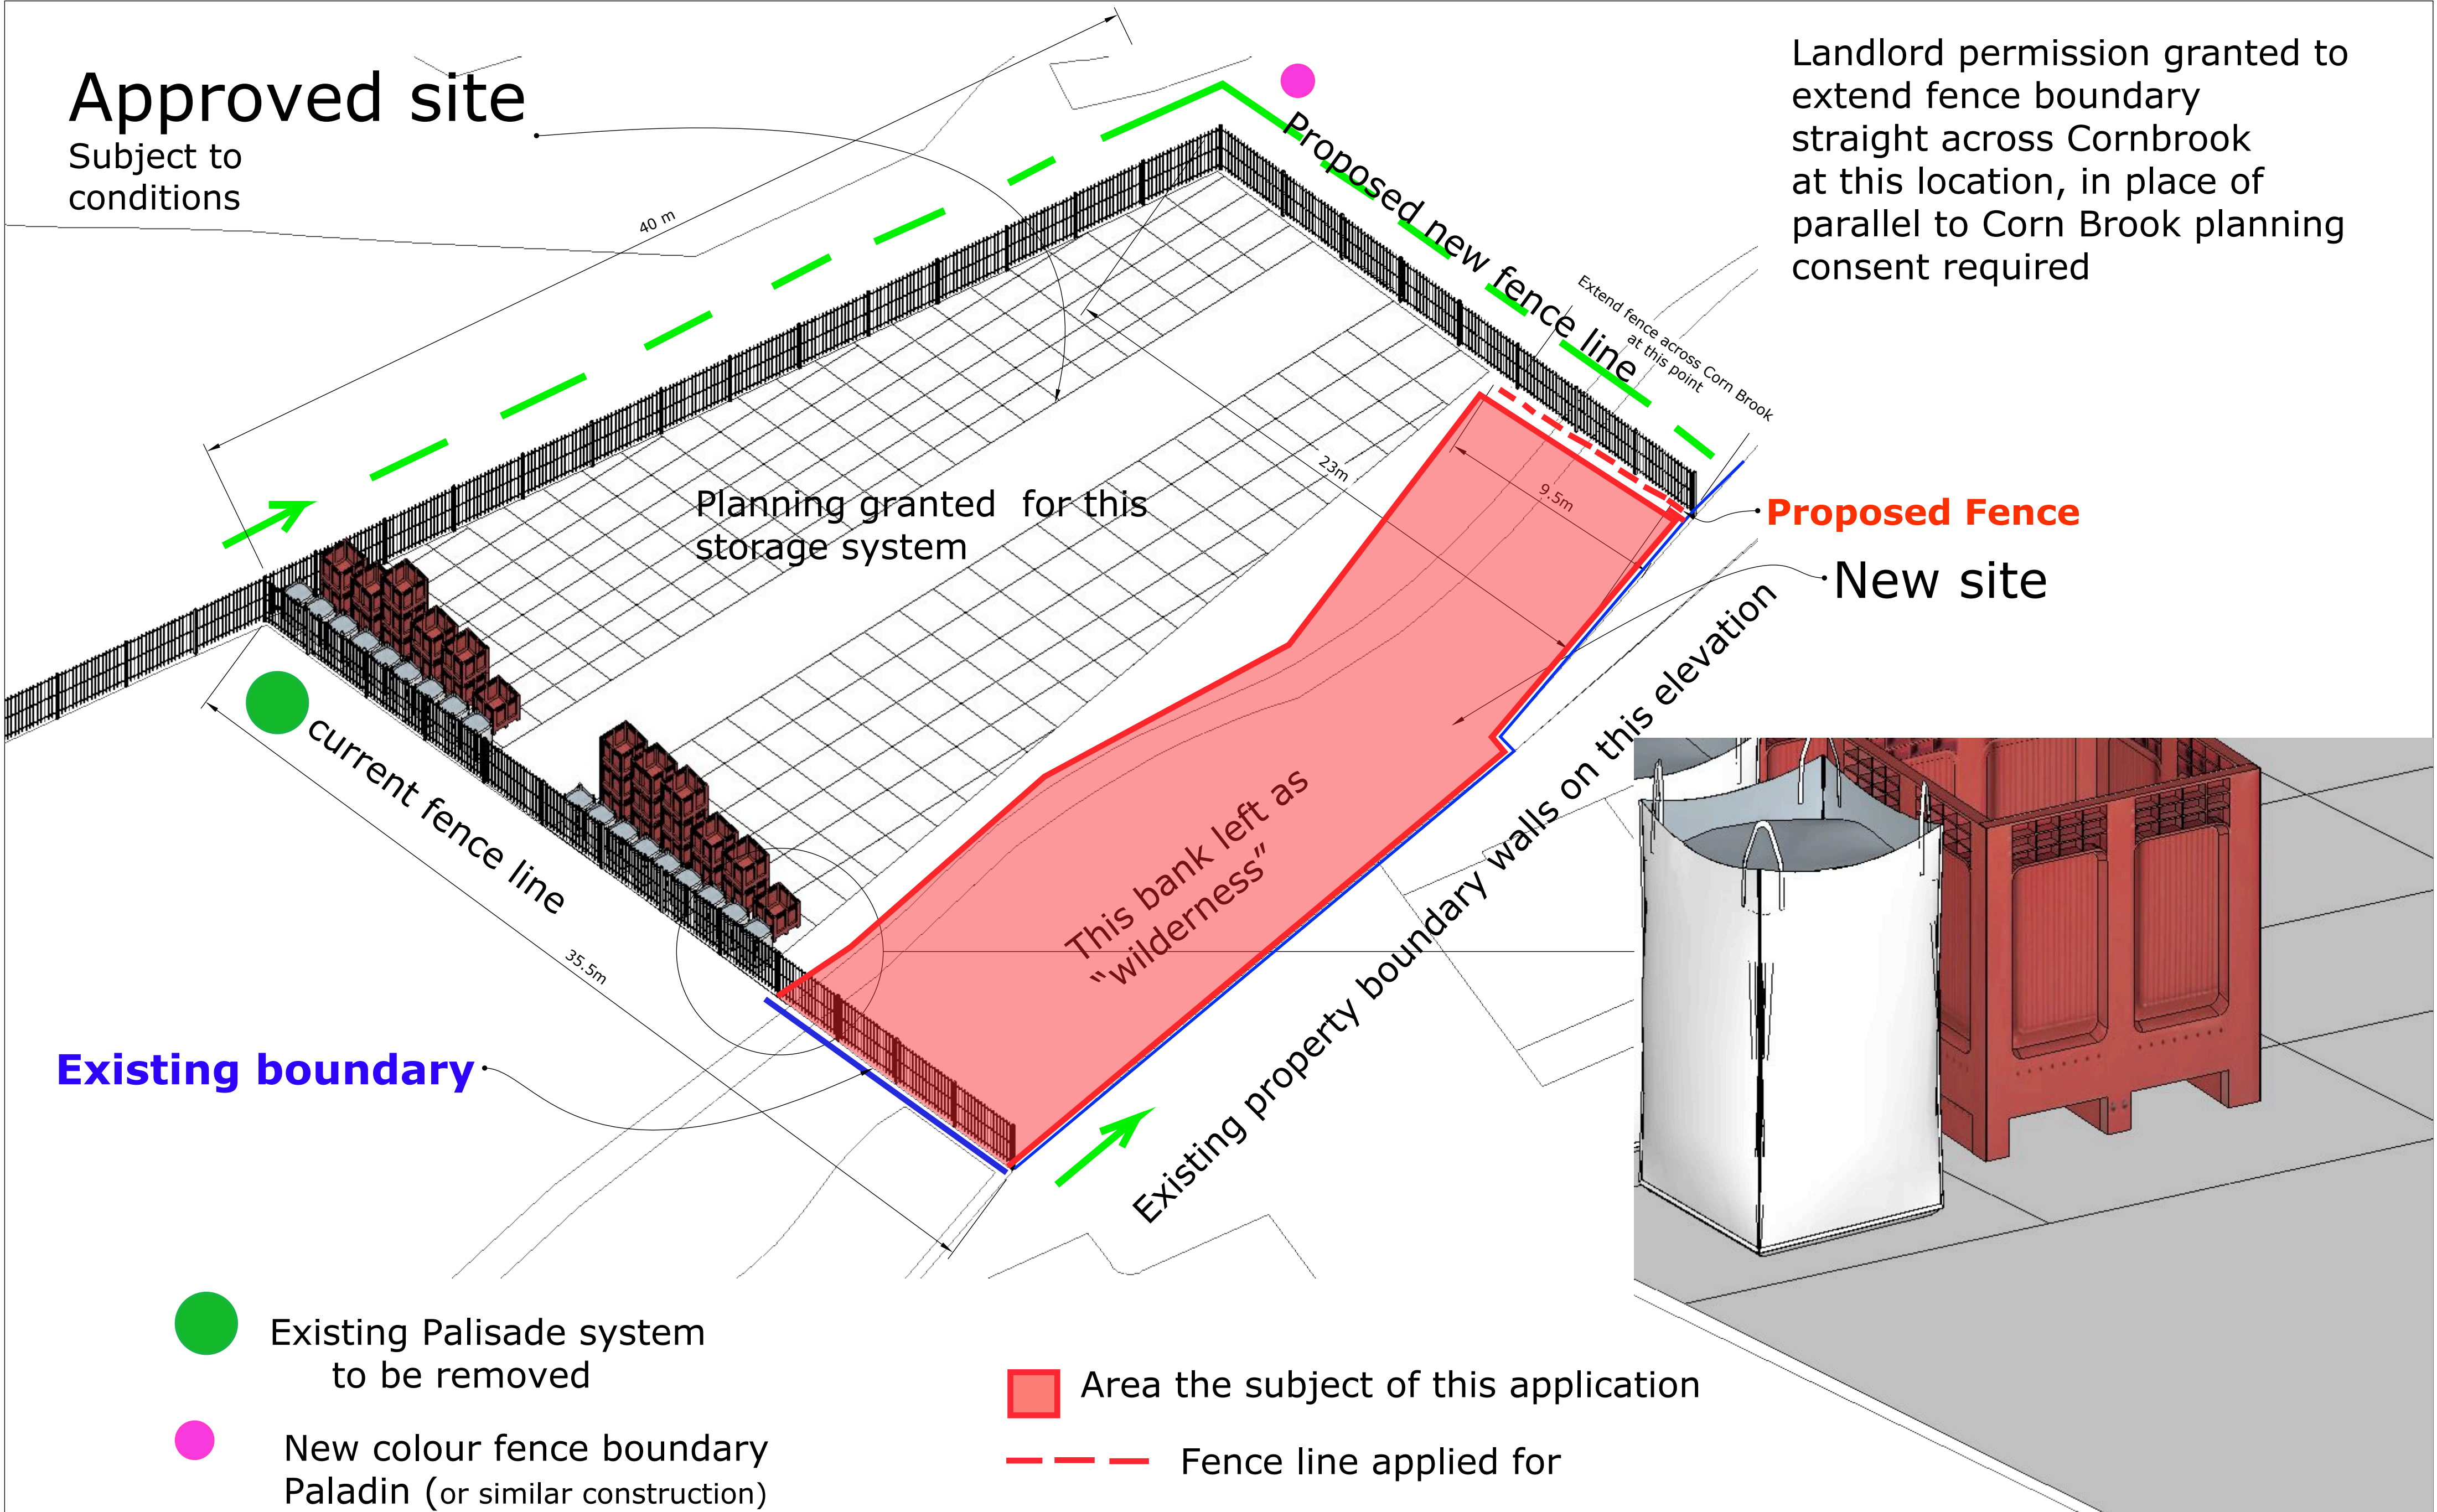

Existing boundary

- Existing Palisade system to be removed
- New colour fence boundary Paladin (or similar construction)

- Area the subject of this application
- Fence line applied for

This drawing represents the design and function of the equipment depicted. The final product may vary in precise detail subject to suitability of component manufacture. Structural performance is not warranted, such information is available by separate warrant only where requested in writing from us and may be subject to charges. We take no responsibility for existing structures, patent infringements or design variations. We reserve the right to modify or change any features which do not fit with our final build programs as we see fit in the reasonable pursuit of best engineering practices and safe design without notice.

REVISIONS	
MM/DD/YY	REMARKS
1	MM/DD/YY
2	MM/DD/YY
3	MM/DD/YY
4	MM/DD/YY
5	MM/DD/YY

2

A4

ENGINEERED SOLUTIONS
HANDLING & STORAGE PROBLEMS SOLVED

© MMXXII IP

IMPORTANT
Property of Engineered Solutions (Projects) Ltd.
You MUST NOT copy or re-use this drawing without written permission.
We reserve an enduring right in respect of the aforementioned and we do not concede this statement irrespective of any terms and conditions of purchase stated or otherwise. The copy rights and IP are retained. Wherever you may see these products, you are NOT free to copy them or use them for your own financial gain. If you wish to do this it will be by separate treaty as a design only contract.

This drawing represents the design and function of the equipment depicted. The final product may vary in precise detail subject to suitability of component manufacture. Structural performance is not warranted, such information is available by separate warrant only where requested in writing from us and may be subject to charges. We take no responsibility for existing structures, patent infringements or design variations. We reserve the right to modify or change any features which do not fit with our final build programs as we see fit in the reasonable pursuit of best engineering practices and safe design without notice. Checking the proposed works to ensure they don't result in unbudgeted conflicting site activities is the responsibility of the client or their appointed agents or officials

Scale	As stated	Status			
Title	Adjusted fence boundary	Design ☐	Production ☐	Other ☒	
Drg No.	010622.3	Estimating ☐	As Built ☐	DRN	PRC
Issue No.	A.01	Approval ☐	Records ☐	Date	04.04.24