

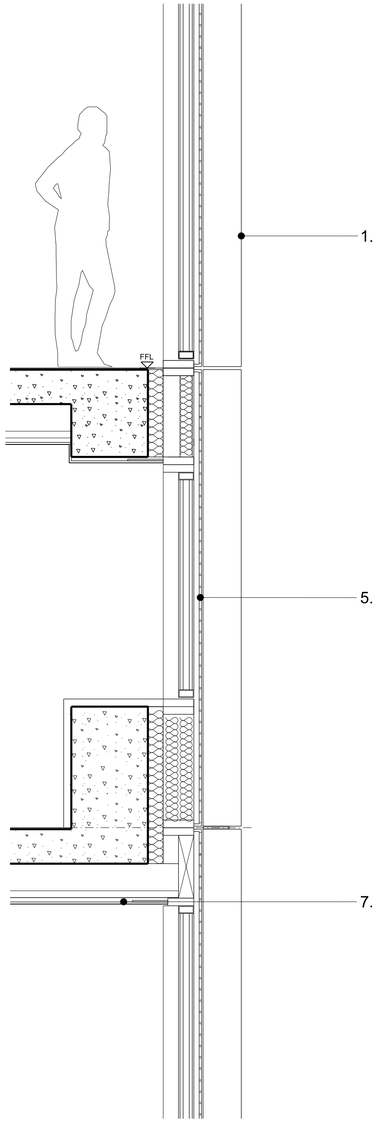



Detail Section | 1:20

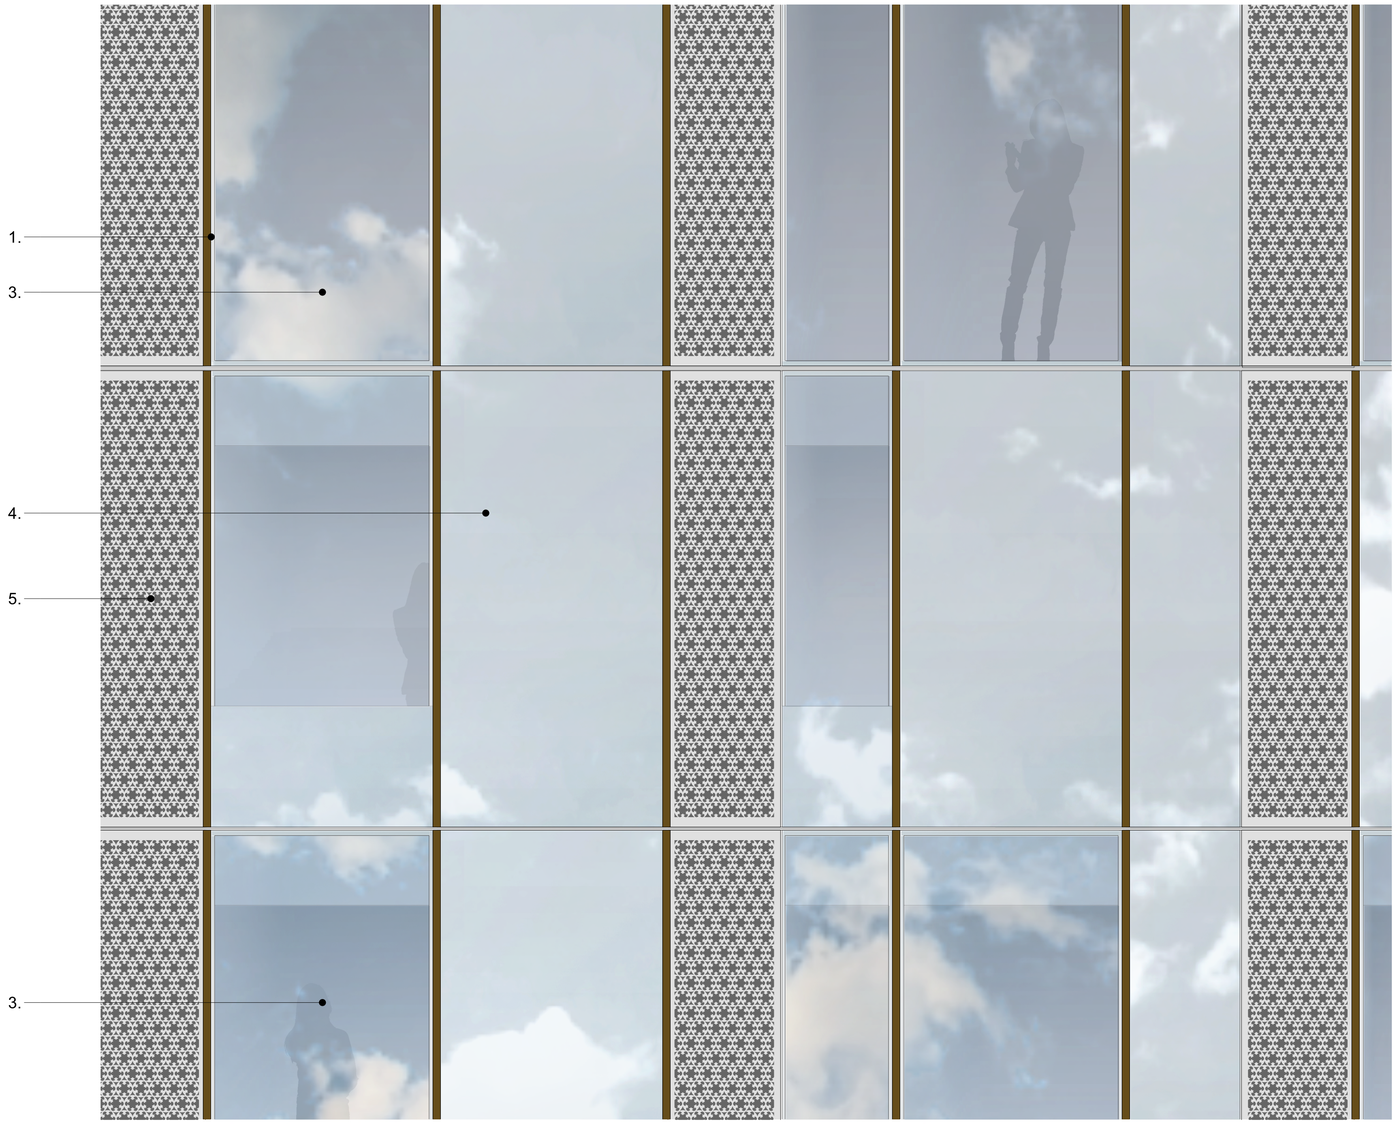

Detail Elevation | 1:20

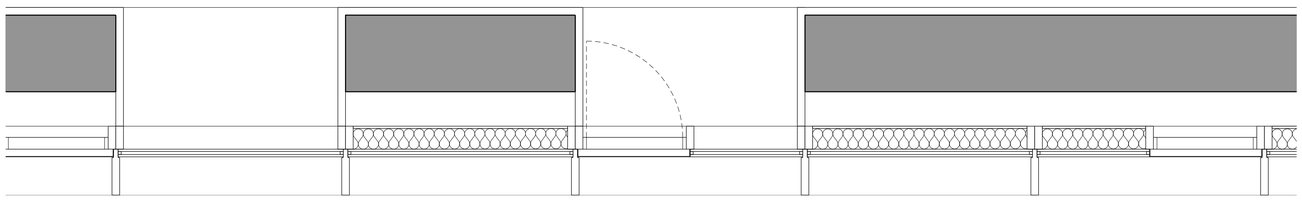

Detail Plan | 1:20

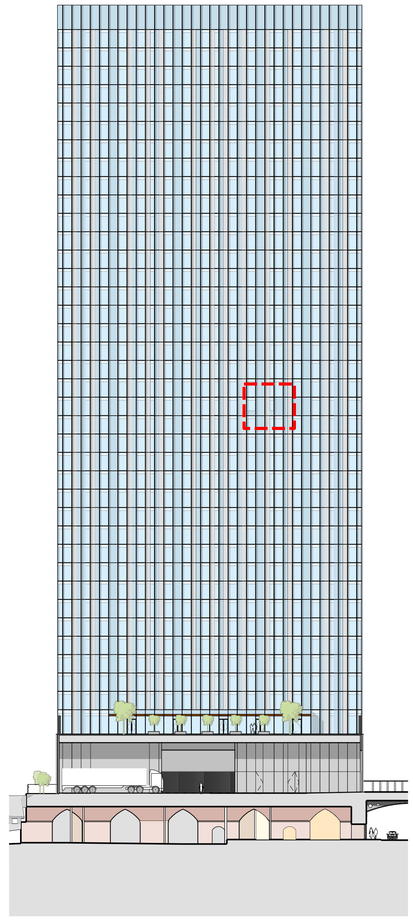

Key Elevation | NTS

Key

1. Projecting curtain wall vertical mullion. Colour - Grey.

~~2. Projecting curtain wall horizontal transom. Colour - Grey.~~

3. Full height clear double glazed units (unitised). Silicone jointing between glass to glass interfaces.

4. Glass fronted insulated solid panel. 100% Enamelled frit spandrel glass

5. Perforated metal screen (rapid vent) in plane of facade to conceal glazed inward opening door

~~6. Glass louvred panels~~

7. Ceiling

~~8. Openable doors with bird protection for maintenance of louvers~~

This drawing is copyright
Do not scale off dimensions.
All dimensions to be checked on site by contractor.
Contractor to report any dimensional discrepancies,
errors or omissions prior to commencing on site.

Rev	Date	Description
00	17-03-2017	Planning Issue
01	30-04-2020	Minor Material Amendment Application
02	08-01-2024	Non-Material Amendment Application

North

Project Title: Former Bauer Millet Site

Drawing Title: Building 2 - External wall detail - Level 19

Status: Planning

Scale: 1:20 @ A1

Date: March 2017

Job No: 10053

Drawing No: 10053-B2-A-B5D9-G251-D-19-001

Revision: 02

simpsonhaugh

MANCHESTER
Riverside, 4 Commercial St
Manchester M15 4RQ
+44 (0)161 835 2340
www.simpsonhaugh.com

LONDON
5-8 Roberts Place
London EC1R 0EB
+44 (0)20 7549 4000
mail@simpsonhaugh.com

© SimpsonHaugh Architects Ltd 2024