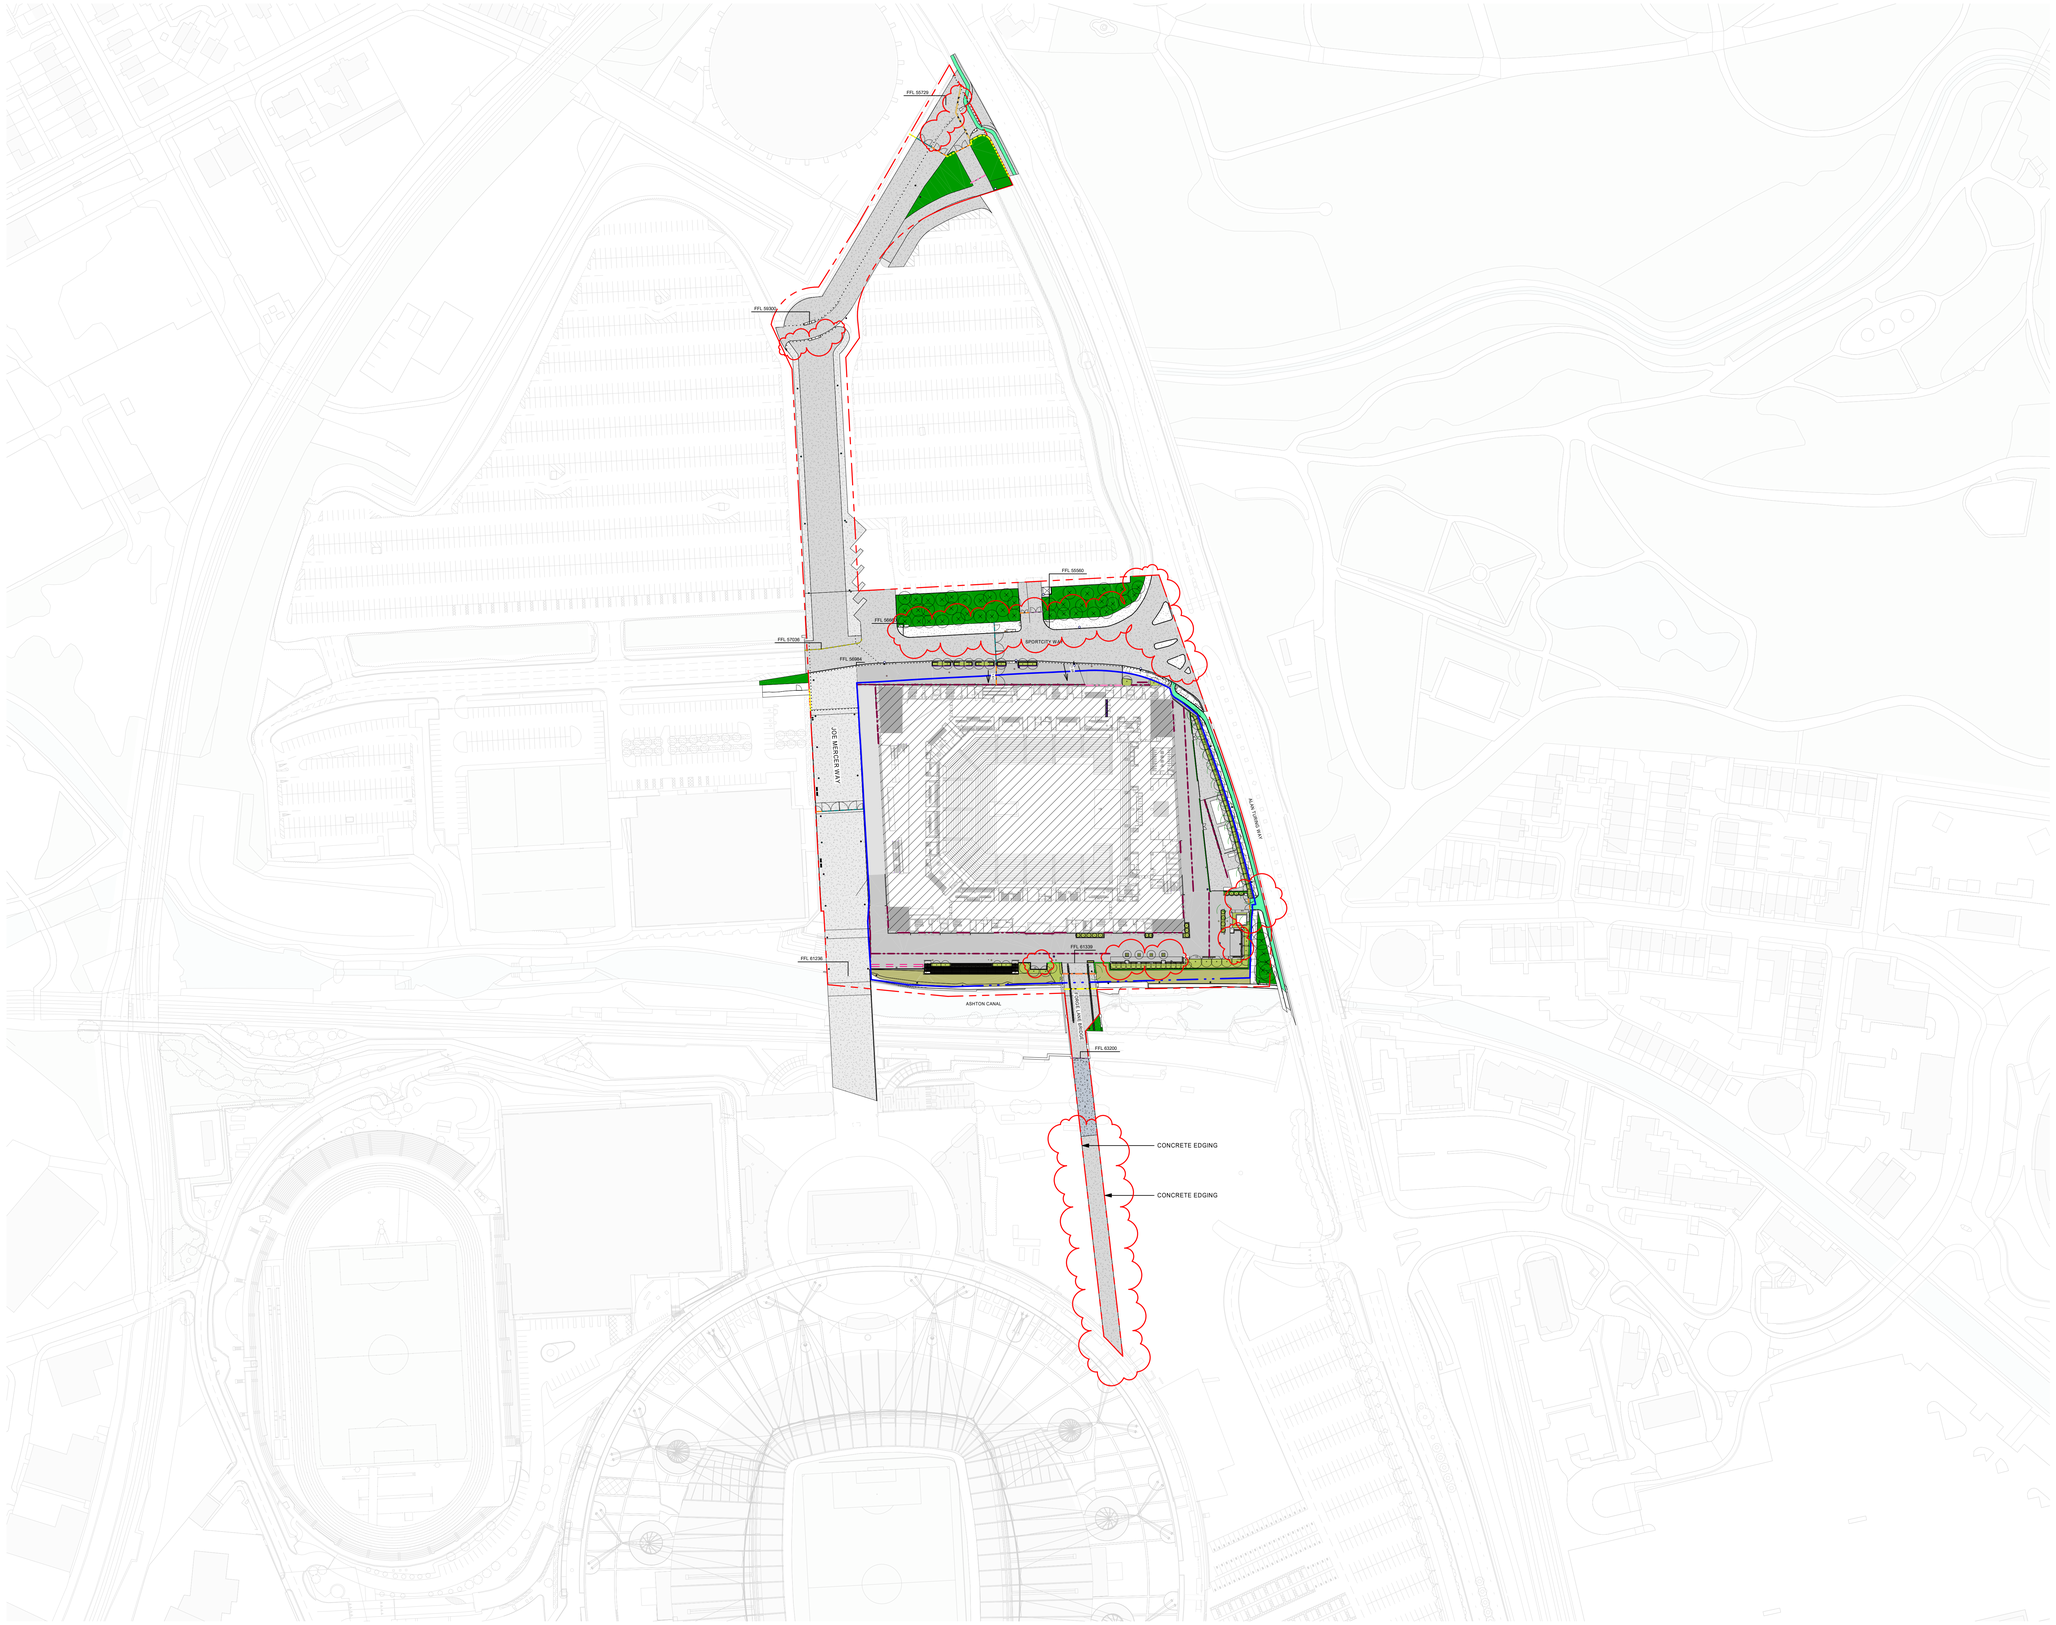


**Suitability Code (as defined in ISO 19650-2:2018).**

**Work in Progress (WIP)**
**S0 -** Initial Status

**Shared (Non- Contractual)**
**S1 -** Suitable for co-ordination
**S2 -** Suitable for information
**S3 -** Suitable for review & comment
**S4 -** Suitable for stage approval
**S5 -** Withdrawn
**S6 -** Suitable for PIM authorisation
**S7 -** Suitable for AIM authorisation

**Published (Contractual)**
**A1, A2, A3, Etc -** Authorised and accepted
**B1,B2,B3, Etc. -** Partial sign-off (with comments)

**Published (AIM Acceptance)**
**CR -** As constructed record document

KEY PLAN

KEY

- PLANNING APPLICATION BOUNDARY
- OWNERSHIP BOUNDARY
- CONCRETE BLOCK PAVING IMPERMEABLE
- CONCRETE BLOCK PAVING PERMEABLE
- EXT-181, EXT-183 TIMBER DECKING
- EXT-141 RESIN BONDED GRAVEL SURFACE
- EXT-112 CONCRETE PAVING SLAB
- EXT-131 TARMAC
- EXT-136 PERMEABLE TARMAC
- EXT-135 COATED MACADAM PAVING - WITH TEXTURED EX TOP COAT
- EXT-115 TACTILE ASTEN PAVING
- EXT-191 TACTILE HAZARD WARNING STRIP
- EXT-201, EXT-202, EXT-203 CONCRETE KERB
- EXT-312 TIMBER TOP TO SEATING WALL
- EXT-311 NATURAL STONE SEATING WALL
- EXT-313 ACCESSIBLE ARMREST FOR SEATING WALL
- EXT-331 METAL PLANTER
- EXT-333 CONCRETE PLANTER
- EXISTING KERB LINE ADJUSTED
- EXT-301 PAS RATED SHALLOW MOUNTED STATIC BOLLARD
- EXT-303 PAS RATED RETRACTABLE BOLLARD
- EXT-305 PAS RATED REMOVABLE BOLLARD
- EXT-307 FLEXIBLE POST
- RELOCATED EXISTING STATIC BOLLARD
- RELOCATED EXISTING RETRACTABLE BOLLARD
- EXISTING BOLLARD TO BE RETAINED
- EXISTING BOLLARD TO BE REMOVED
- EXISTING BOLLARD TO BE RELOCATED
- RELOCATED EXISTING LITTER BIN
- RELOCATED EXISTING CONCRETE BENCHES
- FIRE HYDRANT
- CCTV CAMERA
- EXT-401, EXT-402 SECURITY FENCE
- EXT-801 SLOT DRAINAGE TYPE 1
- EXT-803 SLOT DRAINAGE TYPE 3
- EXT-804 SLOT DRAINAGE TYPE 4
- EXT-805 SLOT DRAINAGE TYPE 5
- EXT-806 SLOT DRAINAGE TYPE 6
- EXT-335 SECURITY BOOTH
- EXISTING GATE RELOCATED
- EXISTING GATE TO BE RETAINED
- EXT-405, EXT-407, EXT-428, EXT-429, EXT-431 GATE
- EXT-441 RISING ARM BARRIER AND INTERCOM
- EXT-445 VEHICLE MITIGATION CONCRETE BARRIER
- EXT-561 PROPOSED TREES
- EXISTING TREES TO BE RETAINED
- EXISTING TREES TO BE REMOVED
- EXT-568 SHRUB AND UNDERSTORY PLANTING
- EXT-571 WILDFLOWER
- EXISTING PLANTING TO BE RETAINED
- LIGHTING COLUMN INTEGRATED ON BOLLARD
- PROPOSED LIGHTING COLUMN
- EXISTING LIGHTING COLUMN TO BE RETAINED
- EXISTING LIGHTING COLUMN RELOCATED
- EXISTING LIGHTING COLUMN TO BE REMOVED
- EXISTING LIGHTING COLUMN TO BE RELOCATED
- ZONE FOR NAMING RIGHTS SIGNAGE

THIS DRAWING IS ONLY TO SCALE IF IT IS REPRODUCED AT THE CORRECT PAPER SIZE

1:1000@A0

0 10 20 30 40 60 m

ALL INTERNAL LAYOUTS AND USES ARE SHOWN FOR ILLUSTRATIVE PORPOSES ONLY AND ARE NOT FOR DETERMINATION

client

OVG INTERNATIONAL

© COPYRIGHT. ALL RIGHTS RESERVED

THIS WORK IS COPYRIGHT AND CANNOT BE REPRODUCED OR COPIED IN ANY FORM OR BY ANY MEANS (GRAPHIC, ELECTRONIC OR MECHANICAL INCLUDING PHOTOCOPYING) WITHOUT THE WRITTEN PERMISSION OF POPULOUS ANY LICENCE, EXPRESS OR IMPLIED, TO USE THIS DOCUMENT FOR ANY PURPOSE WHATSOEVER IS RESTRICTED TO THE TERMS OF THE AGREEMENT OR IMPLIED AGREEMENT BETWEEN POPULOUS AND THE INSTRUCTING PARTY.

USE FIGURED DIMENSIONS IN PREFERENCE TO SCALED. CHECK ALL DIMENSIONS ON SITE BEFORE FABRICATION OR SETTING OUT

architect

POPULOUS®

14 BLADES COURT | DEODAR ROAD | LONDON | SW15 2NU | UNITED KINGDOM
TELEPHONE +44 (0)20 8874 7666 FACSIMILE +44 (0)20 8874 7470

ALL PRODUCTION & INTELLECTUAL PROPERTY RIGHTS RESERVED © POPULOUS 2009

REVISIONS

| REV | DATE | DESCRIPTION |
|---|---|---|
| P00 | 04.09.2020 | STAGE 3 |
| P01 | 30.10.2020 | STAGE 4A - INCREASE IN SCOPE TO PLANNING BOUNDARY |
| P02 | 16.11.2020 | STAGE 4A - INCREASE IN SCOPE TO PLANNING BOUNDARY |

project name **Co-op Live**

title LANDSCAPE SITE
GENERAL ARRANGEMENT PLAN

purpose of issue
STAGE 4B

scale 1:1000 @ A0 drawn FP Project no. Suitability
date 04.09.2020 checked TJ 4933 S3

reference project code originator volume level type role number **BRA-POP-ZZ-ZZ-DR-L-8001** rev. **P02**