
Legend.

Exceedance Flow Path

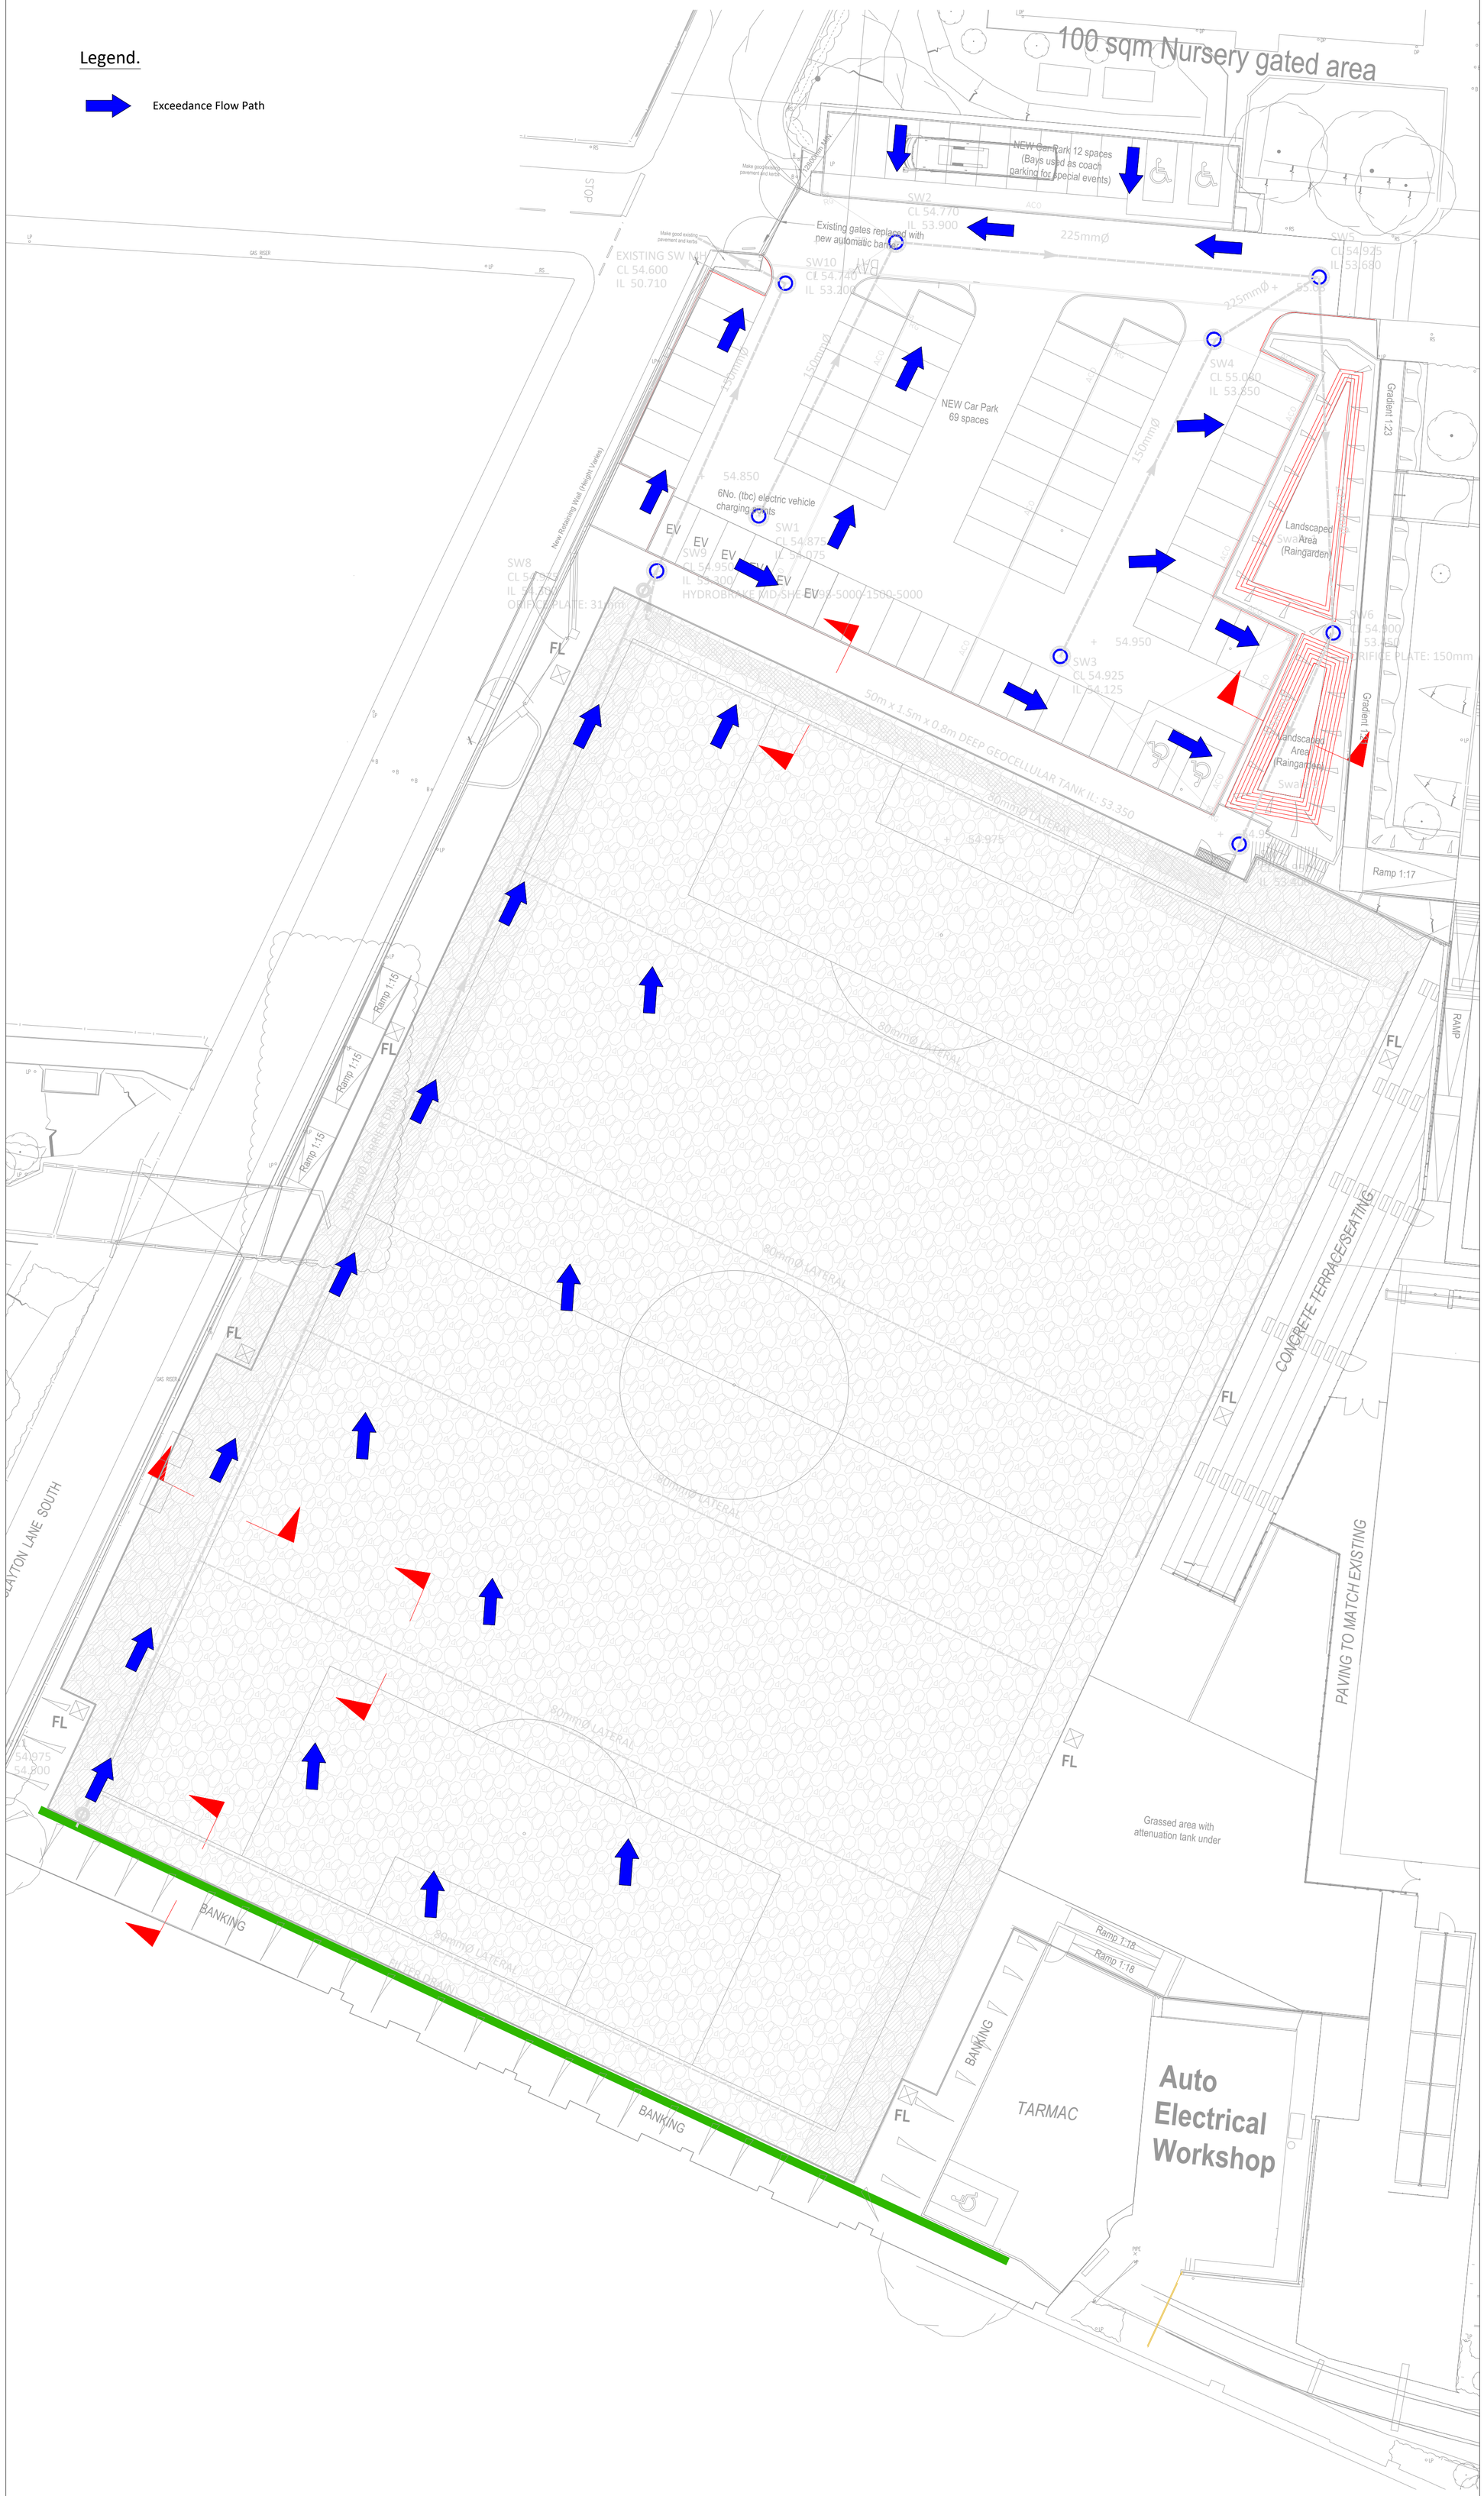

Notes.

1. Roadway and footpath surfacing design and construction to Engineer's Specification (by others).

2. All dimensions are in millimetres unless otherwise stated.

3. Do not scale from this drawing. If in doubt ask.

4. This drawing to be read in conjunction with all relevant EPG, Architects & Engineers drawings.

5. Should there be any conflict between the details indicated on this drawing and those on other drawings the Engineer should be informed PRIOR to construction on site.

6. At all times the works are to be executed in accordance with the requirements of the Health And Safety at Work Act 1974 and CDM Regulations 2015.

CR	AB1	30.05.23	As-built issue	GH | GH | SW| PW
S3	P01	15.08.22	Issued for comment and discussion	GH | GH | SW| PW
STATUS	REV	DATE	REVISION HISTORY	DSG | DRW | CHK | APP

ALL REVISIONS

CLIENT

Celebrating Fifty Years
blakedown sport &play.

KEY PLAN

ORIGINATOR

Part of the STRI Group
epg
The Environmental Protection Group Ltd
Warrington Business Park
Long Lane
Warrington
T: 01925 652 980
F: 01925 652 983
W: www.epg-ltd.co.uk
E: consultantrequest@epg-ltd.co.uk

© The Environmental Protection Group Ltd

DRAWING TITLE

OPENSHAW COLLEGE
EXCEEDANCE ROUTING

	Name	Signature	Date
Designed by	GH		30.05.2023
Drawn by	GH		30.05.2023
Checked	SW		30.05.2023
Approved	PW		30.05.2023

EPG REF	SCALE @ A1	BIM FILE NAME - REVISION
9705	1:250	-
	CR - As constructed record document	

PROJECT	ISSUER	VOLUME	LEVEL	TYPE	ROLE	NUMBER	REV
9705	EPG	XX	XX	DR	Y	0002	AB1