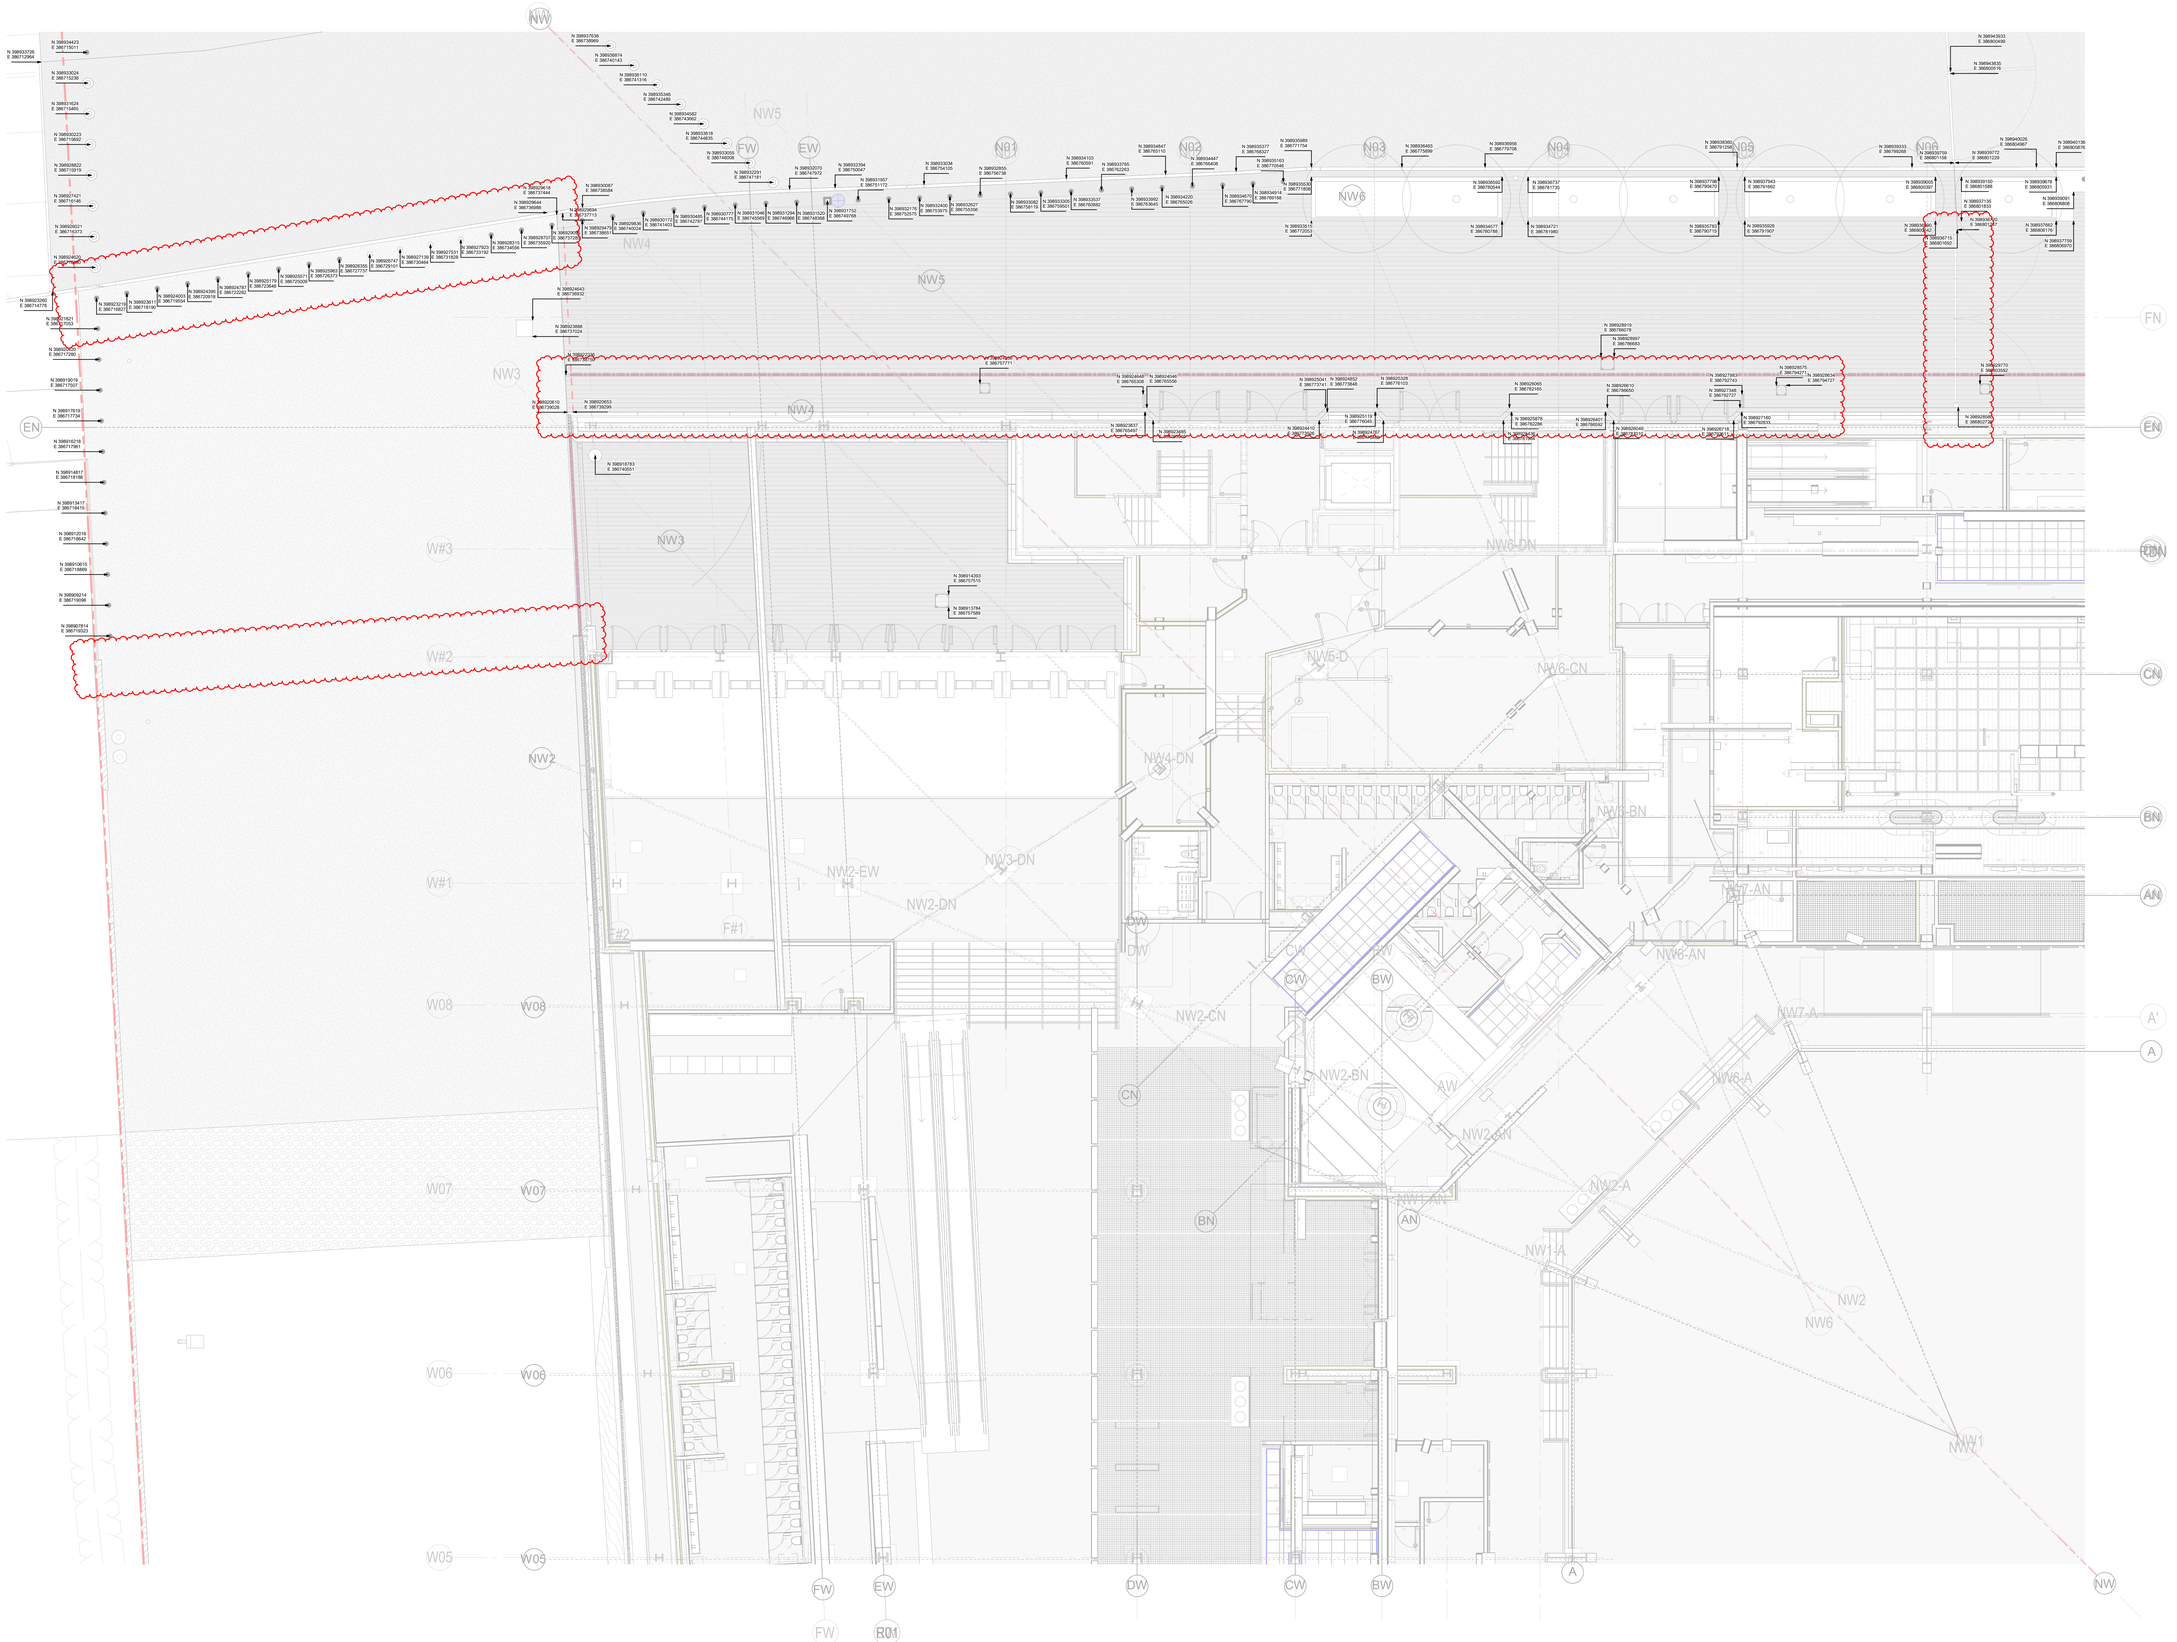


**Suitability Code (as defined in ISO 19650-2:2018)**

**Work in Progress (WIP)**
**S0 -** Initial Status

**Shared (Non- Contractual)**
**S1 -** Suitable for co-ordination
**S2 -** Suitable for information
**S3 -** Suitable for review & comment
**S4 -** Suitable for stage approval
**S5 -** Withdrawn
**S6 -** Suitable for PIM authorisation
**S7 -** Suitable for AIM authorisation

**Published (Contractual)**
**A1, A2, A3, Etc -** Authorised and accepted
**B1,B2,B3, Etc. -** Partial sign-off (with comments)

**Published (AIM Acceptance)**
**CR -** As constructed record document

KEY PLAN

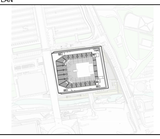

KEY

PLANNING APPLICATION BOUNDARY

N XXXXXXXXX
E XXXXXXXXX — COORDINATES AT SPOT

DRAINAGE PENETRATION OUTLET IN STRUCTURAL SLAB

THIS DRAWING IS ONLY TO SCALE IF IT IS REPRODUCED AT THE CORRECT PAPER SIZE

1:100@A0

0 1 2 3 4 6 m

ALL INTERNAL LAYOUTS AND USES ARE SHOWN FOR ILLUSTRATIVE PURPOSES ONLY AND ARE NOT FOR DETERMINATION

Safety, Health and Environmental Information

In addition to the hazards / risks normally associated with the types of work detailed on this drawing, note the following risks and information:

| | |
|---|---|
| Construction | See risk register<br>No abnormal risks identified with this package of work |

For information relating to Use, Cleaning and Maintenance see the Health and Safety File. It is assumed that all works will be carried out by a competant contractor working, where appropriate, to an approved method statement.

client

OVG INTERNATIONAL

© COPYRIGHT. ALL RIGHTS RESERVED

THIS WORK IS COPYRIGHT AND CANNOT BE REPRODUCED OR COPIED IN ANY FORM OR BY ANY OTHER MEANS (GRAPHIC, ELECTRONIC OR MECHANICAL INCLUDING PHOTOCOPYING) WITHOUT THE WRITTEN PERMISSION OF POPULOUS ANY LICENSE, EXPRESS OR IMPLIED, TO USE THIS DOCUMENT FOR ANY PURPOSE WHATSOEVER IS RESTRICTED TO THE TERMS OF THE AGREEMENT OR IMPLIED AGREEMENT BETWEEN POPULOUS AND THE INSTRUCTING PARTY.

USE FIGURED DIMENSIONS IN PREFERENCE TO SCALED. CHECK ALL DIMENSIONS ON SITE BEFORE FABRICATION OR SETTING OUT

architect

POPULOUS®

**14 BLADES COURT | DEODAR ROAD | LONDON | SW15 2NU | UNITED KINGDOM**
**TELEPHONE +44 (0)20 8874 7666 FACSIMILE +44 (0)20 8874 7470**
**ALL PRODUCTION & INTELLECTUAL PROPERTY RIGHTS RESERVED © POPULOUS 2009**

REVISIONS

| REV | DATE | DESCRIPTION |
|---|---|---|
| C01 | 02.12.2021 | HARD LANDSCAPE PACKAGE FOR CONSTRUCTION |
| C02 | 03.08.2022 | FLOOR GULLY TO GF NORTH WEST ENTRANCE RELOCATED FOLLOWING CIVIL UPDATE RFI #2146 |
| C03 | 17/03/2023 | ADDITIONAL INFORMATION INCLUDED |
| C04 | 24.04.2023 | DRAINAGE UPDATE |
| C05 | 02.06.2023 | ADDITIONAL INFORMATION INCLUDED |

project name **Co-op Live**

title SETTING OUT ENLARGED PLAN
JOE MERCER WAY JUNCTION
GROUND FLOOR

purpose of issue **CONSTRUCTION**

scale As indicated @ A0 drawn FP Project no. Suitability
date checked TJ 4933 **S3**

reference project code originator volume level type role number **BRA-POP-ZZ-GF-DR-L-8173** rev. **C05**