
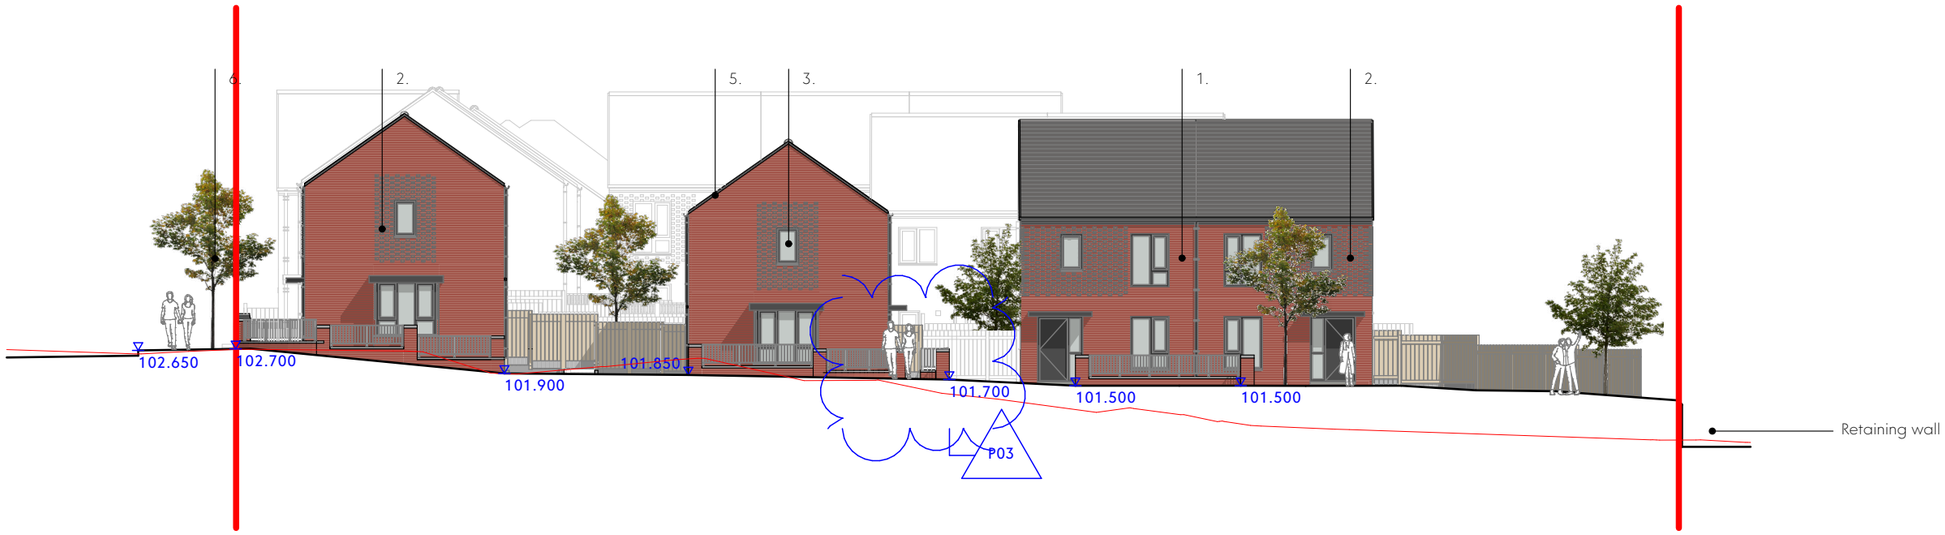


Elevation B (Part 1) - 1:200 @A3

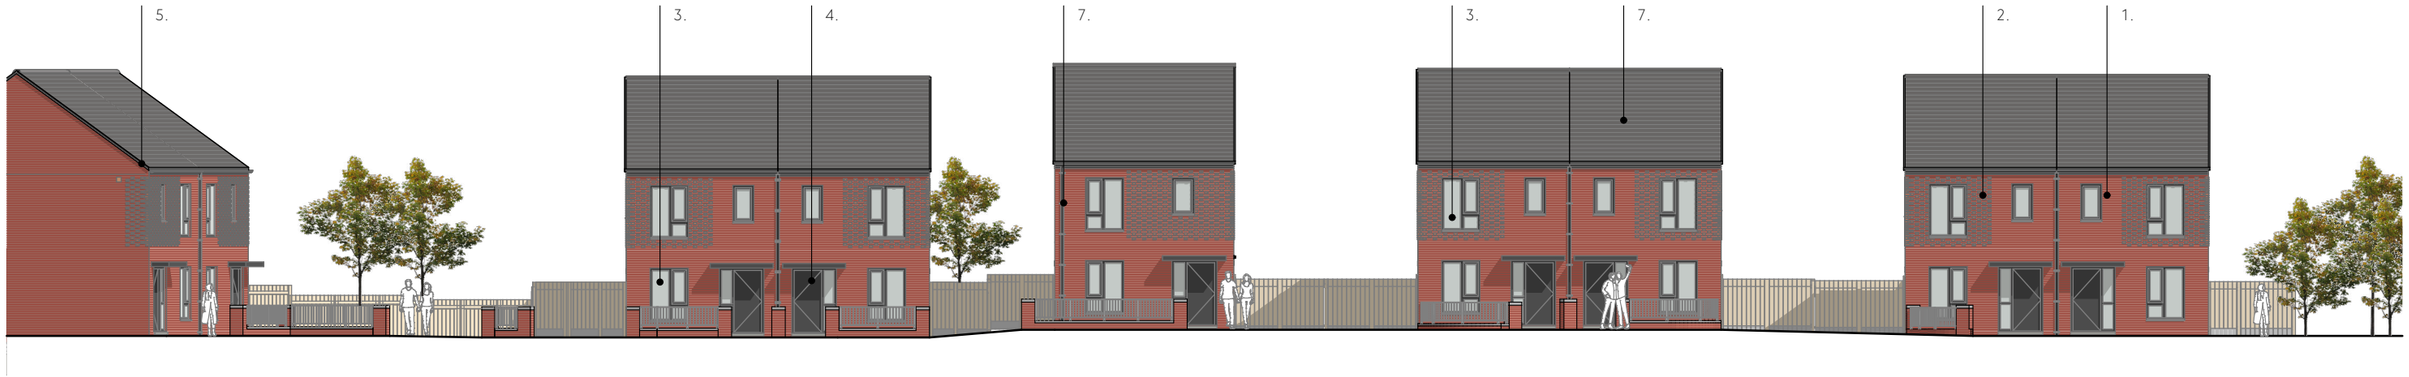

Elevation C (Part 2) - 1:200 @A3

MATERIALS KEY

1. Red brickwork. Michelmerch Hadley Red Wirecut
2. Projecting (15mm) headers (as above)
3. uPVC windows. RAL 7016, dark grey
4. Composite doors. RAL 7016, dark grey
5. Soffits and fascias. RAL 7016
6. uPVC Rainwater goods. Black
7. Thin edge concrete roof tiles. Marley Edgemere Anthracite

This drawing is the property of GWP Architecture. Copyright is reserved by them and the drawing is issued on the condition that it is not copied, reproduced, retained, or disclosed to any unauthorised person, either wholly or in part, without the consent in writing of GWP Architecture.

All drawings and specifications should be read in conjunction with the project health and safety plan, any possible conflicts should be presented to the Planning Coordinator.

All work to be carried out in accordance with current Building Regulations.

Contractors must verify all dimensions at the job before commencing any work or making shop drawings.

Written dimensions should be taken. Do not scale off drawing. Do not take digital dimensions from this drawing.

Any discrepancies to be reported to the Architect.

0 1m 5m 10m

Scale - 1:200 @A3

KEY

- Redline Boundary
- Existing Level
- 100.510 Proposed Level



Rev	Date	Comment	Dr	Ch
P03	29.08.23	Update as clouded	CT	DT
P02	01.03.23	General Update	CT	DT
P01	10.02.23	First Issue	CT	DT

/Volumes/Data/CAD/(515)2240 Victoria Ave/A_Architects_(GWP)/Model/(515)2240-GWP-XX-ZZ-M3-A-1B-VicSite-P01.pln

GWP Job Reference (515)2240

Job Title Victoria Ave, Blackley

Client JOHN SOUTHWORTH BUILDING FUTURES TODAY

Contextual Street Elevations 2 of 2

Name	2240-GWP-00-XX-DR-A-(00)-0011		
Scale	1:200@A3	Revision	P03
Drawn/Checked	CT / DT	First Issue	10.02.23
Drawing Status	A4 - Technical Drawing		

CHARTERED ARCHITECTS
INTERIOR DESIGNERS
SPACE PLANNERS
PROJECT MANAGERS
LANDSCAPE ARCHITECTS

Bracken House, Lidgett Lane. Leeds LS8 1PQ
+44(0)113 266 6044 (t) +44(0)113 268 1859 (f)
architecture@gwp-arch.com | www.gwp-arch.com