


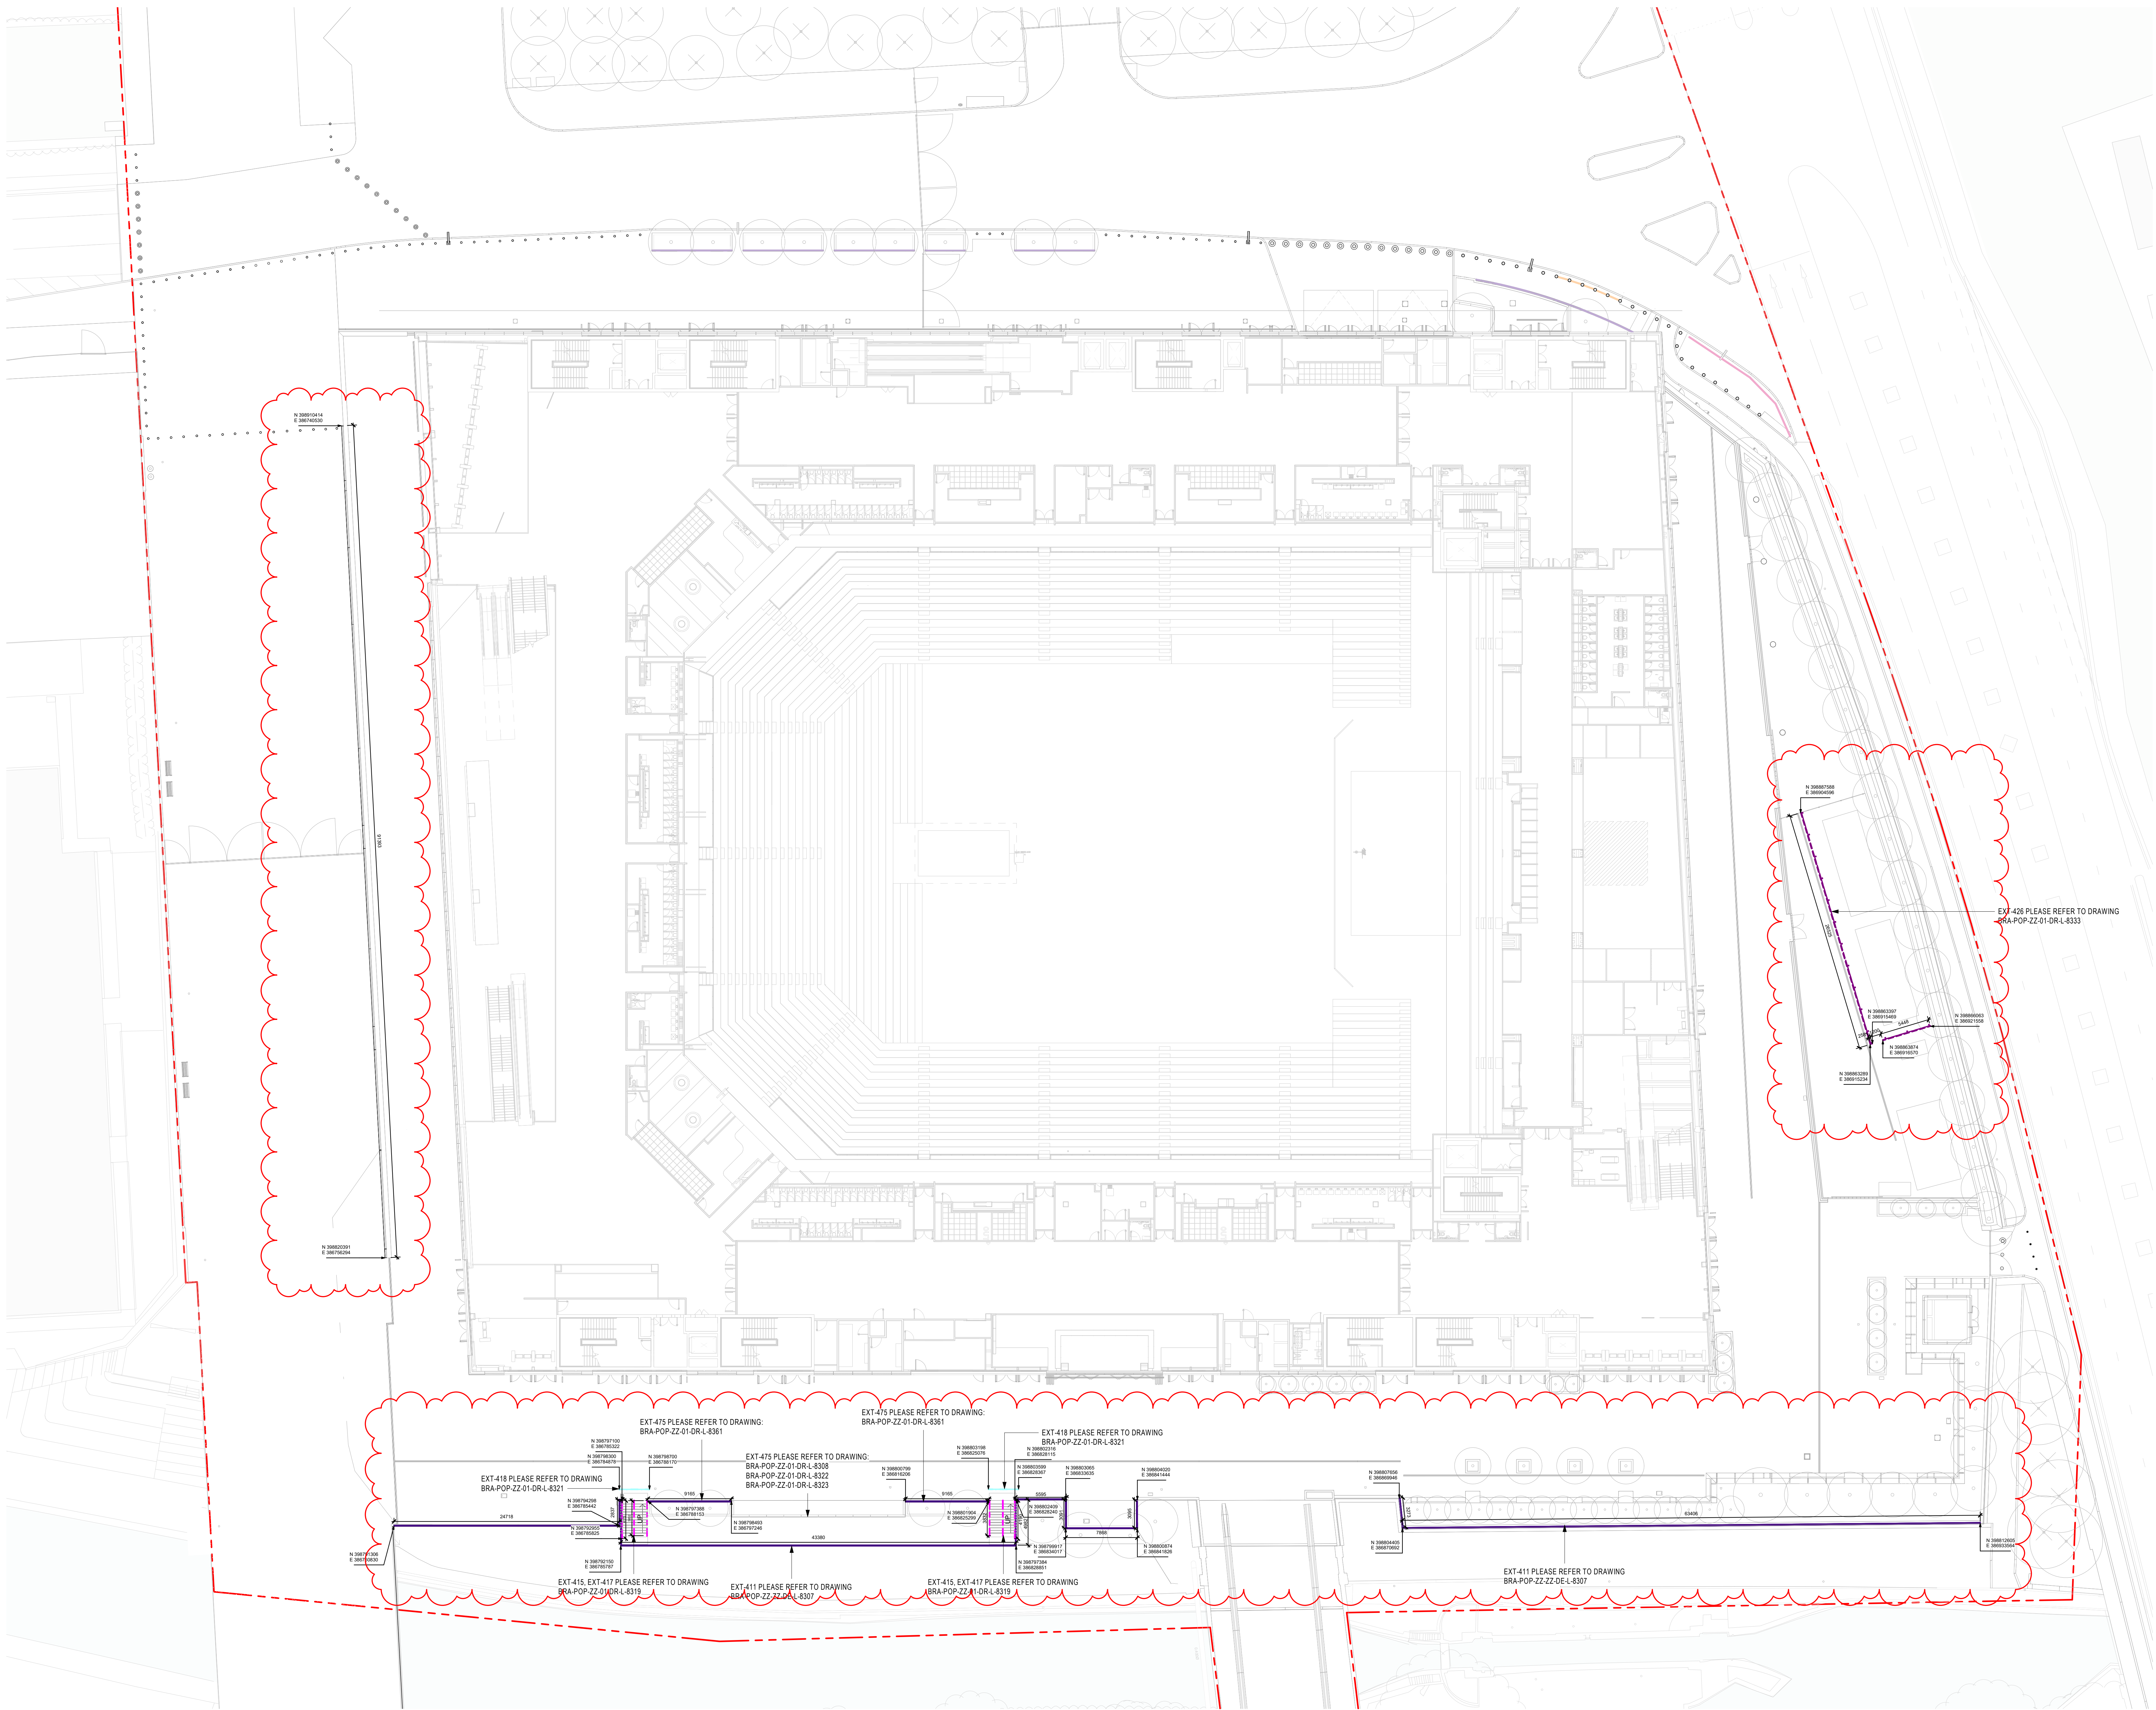

Suitability Code (as defined in ISO 19650-2:2018)

Work in Progress (WIP)

- S0 - Initial Status
- S1 - Shared (Non-Contractual)
- S2 - Suitable for co-ordination
- S3 - Suitable for information
- S4 - Suitable for review & comment
- S5 - Suitable for stage approval
- S6 - Withdrawn
- S7 - Suitable for FIM authorisation


Published (Contractual)

- A1, A2, A3, Etc - Authorised and accepted
- B1, B2, B3, Etc - Partial sign-off (with comments)

Published (AIM Acceptance)

- CR - As constructed record document

KEY PLAN

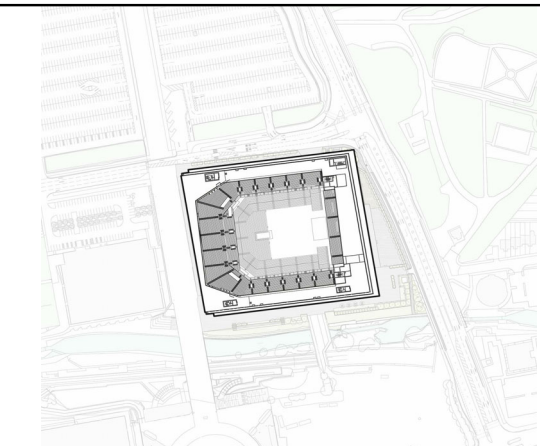

KEY

- PROJECT BOUNDARY
- EXT-411, EXT-412 BALUSTRADE
- EXT-413 BALUSTRADE PANEL FIXED ON THE BOLLARDS BASE PLATE
- EXT-414 BALUSTRADE PANEL FIXED ON THE FOUNDATION IN THE GROUND
- EXT-415, EXT-416 HANDRAIL
- EXT-411, EXT-412, EXT-415 BALUSTRADE
- EXT-419 BARRIER INTEGRATED WITH SHELF
- EXT-418, HEAD OF STEP BARRIER
- EXT-427 VEHICLE SAFETY BARRIER

THIS DRAWING IS ONLY TO SCALE IF IT IS REPRODUCED AT THE CORRECT PAPER SIZE

1:250@A0



ALL INTERNAL LAYOUTS AND USES ARE SHOWN FOR ILLUSTRATIVE PURPOSES ONLY AND ARE NOT FOR DETERMINATION

Safety, Health and Environmental Information

In addition to the hazards / risks normally associated with the types of work detailed on this drawing, note the following risks and information:

Construction See risk register No abnormal risks identified with this package of work.

For information relating to Live, Cleaning and Maintenance see the Health and Safety File. It is assumed that all works will be carried out by a competent contractor working, where appropriate, to an approved method statement.

client



© COPYRIGHT. ALL RIGHTS RESERVED

THIS WORK IS COPYRIGHT AND CANNOT BE REPRODUCED OR COPIED IN ANY FORM OR BY ANY MEANS, INCLUDING ELECTRONIC OR MECHANICAL, WITHOUT THE WRITTEN PERMISSION OF POPULOUS. ANY UNLAWFUL REPRODUCTION OR USE OF THIS DOCUMENT FOR ANY PURPOSE WHATSOEVER IS PROHIBITED BY THE TERMS OF THE AGREEMENT OR IMPLIED AGREEMENT BETWEEN POPULOUS AND THE INSTRUCTING PARTY.

USE PROVIDED DIMENSIONS IN PREFERENCE TO SCALES. CHECK ALL DIMENSIONS ON SITE BEFORE FABRICATION OR SETTING OUT.

author

POPULOUS®

14 BLADES COURT | DEODAR ROAD | LONDON | SW15 2NU | UNITED KINGDOM
TELEPHONE +44 (0)20 8874 7686 FACSIMILE +44 (0)20 8874 7470
ALL PRODUCTION & INTELLECTUAL PROPERTY RIGHTS RESERVED © POPULOUS 2020

REVISIONS

REV	DATE	DESCRIPTION
00	09/07/2021	STAGE 48 TO INCORPORATE UPDATE
001	12/01/2022	EXTERNAL METALWORK ISSUED FOR CONSTRUCTION

project name

Co-op Live

the EXTERNAL METALWORK

SCOPE PLAN

LEVEL 01



scale 1 : 250 @ A0 drawn FP Project no. 4933 Suitability S3
date 07/04/21 checked TJ

revision BRA-POP-ZZ-01-DR-L-8118 C01