


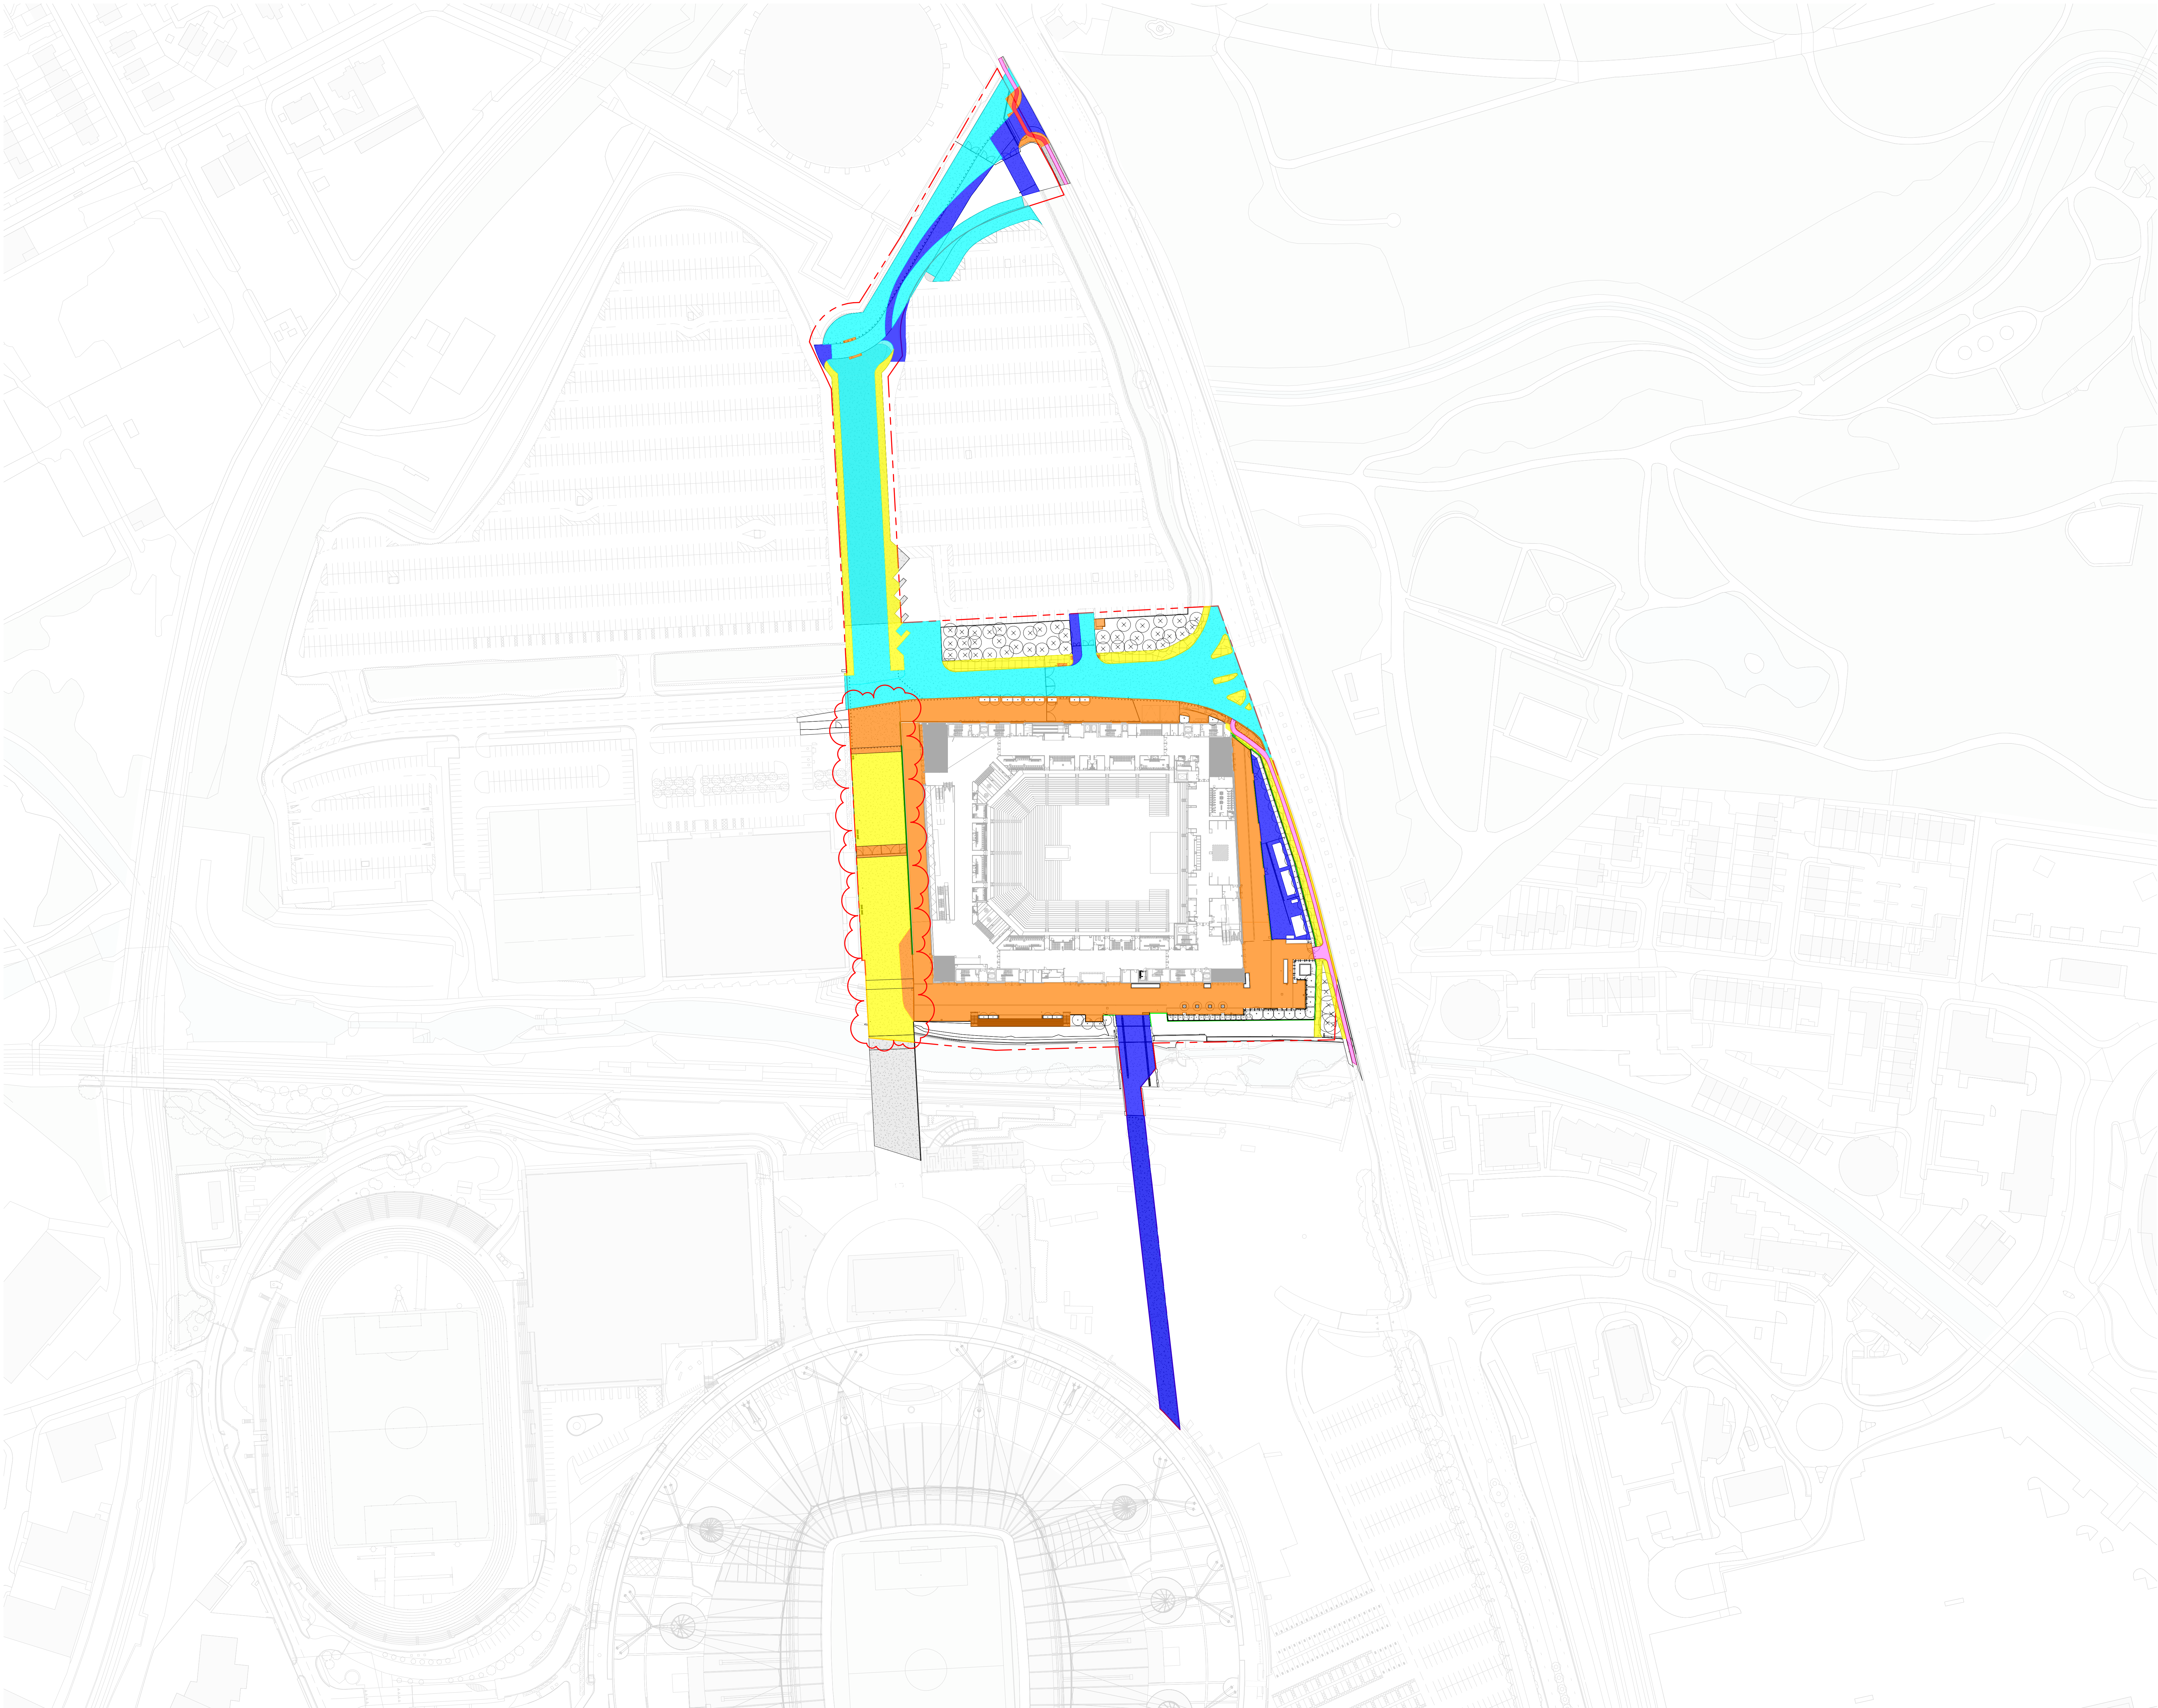

Suitability Code (as defined in ISO 19650-2:2018)

Work in Progress (WIP)

S0 - Initial Status

Shared (Non-Contractual)

S1 - Suitable for co-ordination

S2 - Suitable for information

S3 - Suitable for review & comment

S4 - Suitable for stage approval

S5 - Withdrawn

S6 - Suitable for FIM authorisation

S7 - Suitable for AIM authorisation

Published (Contractual)


A1, A2, A3, Etc - Authorised and accepted

B1, B2, B3, Etc - Partial sign-off (with comments)

Published (AIM Acceptance)

CR - As constructed record document

KEY PLAN

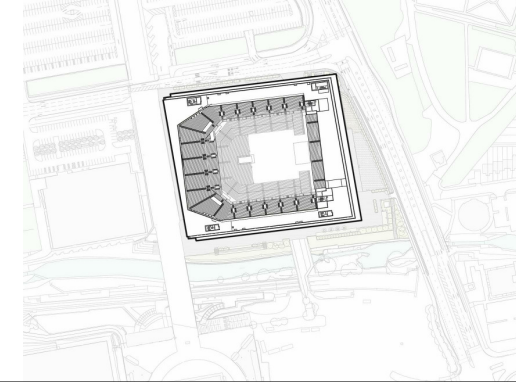

KEY

EXISTING TARMAC

PROPOSED TARMAC

EXISTING PAVING


PROPOSED PAVING

EXISTING CYCLE LANE

PROPOSED CYCLE LANE

THIS DRAWING IS ONLY TO SCALE IF IT IS
REPRODUCED AT THE CORRECT PAPER SIZE

1:1000@A0

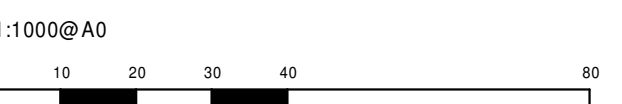

ALL INTERNAL LAYOUTS AND USES ARE SHOWN
FOR ILLUSTRATIVE PURPOSES ONLY AND ARE
NOT FOR DETERMINATION

client



© COPYRIGHT. ALL RIGHTS RESERVED

THIS WORK IS COPYRIGHT AND CANNOT BE REPRODUCED OR COPIED IN ANY FORM OR BY
ANY OTHER MEANS, GRAPHIC, ELECTRONIC OR MECHANICAL, INCLUDING PHOTOCOPYING,
WITHOUT THE WRITTEN PERMISSION OF POPULOUS. ANY LICENSE, EXPRESS OR IMPLIED,
TO USE THIS DOCUMENT FOR ANY PURPOSE, WHATSOEVER, IS RESTRICTED TO THE TERMS
OF THE AGREEMENT OR IMPLIED AGREEMENT BETWEEN POPULOUS AND THE INSTRUCTING
PARTY.

USE REQUIRED DIMENSIONS IN PREFERENCE TO SCALES. CHECK ALL DIMENSIONS ON SITE
BEFORE FABRICATION OR SETTING OUT.

advisor

POPULOUS®

16 BLADES COURT | DEodar ROAD | LONDON | SW15 2NU | UNITED KINGDOM
TELEPHONE: +44 (0)20 8874 7666 FACSIMILE: +44 (0)20 8874 7470
ALL PROPOSITIONS & INTELLECTUAL PROPERTY RIGHTS RESERVED © POPULOUS 2009

REVISIONS

REV	DATE	DESCRIPTION
P00	30.10.2020	STAGE 4A - INCREASE IN SCOPE TO PLANNING BOUNDARY
P01	16.11.2020	STAGE 4A - INCREASE IN SCOPE TO PLANNING BOUNDARY

project
name

OVG Manchester

the

LANDSCAPE SITE

EXISTING/ PROPOSED PLAN



portion of plan

STAGE 4A

scale 1:1000 @ A0

drawn

FP

Project no.

4933

Suitability

S4

date

30.10.2020

checked

TJ

revision

BRA-POP-ZZ-ZZ-DR-L-8006 P01