4 EXT-411 TIMBER STEP SIDE BALUSTRADE - ELEVATION
1 : 10

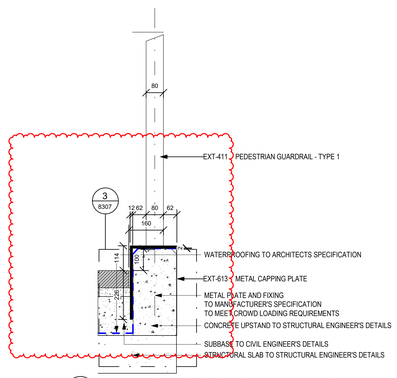

2 EXT-411 BALUSTRADE DETAIL - SECTION
1 : 10

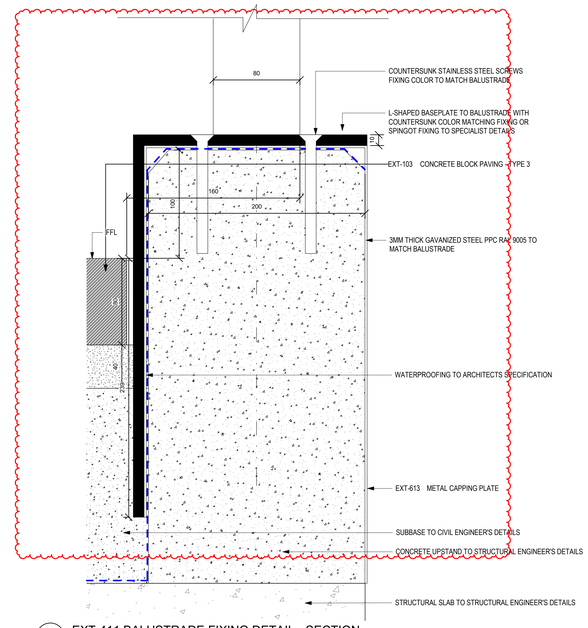

3 EXT-411 BALUSTRADE FIXING DETAIL - SECTION
1 : 2

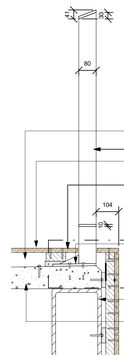

5 EXT-411 TIMBER STEP SIDE BALUSTRADE DETAIL - SECTION
1 : 10

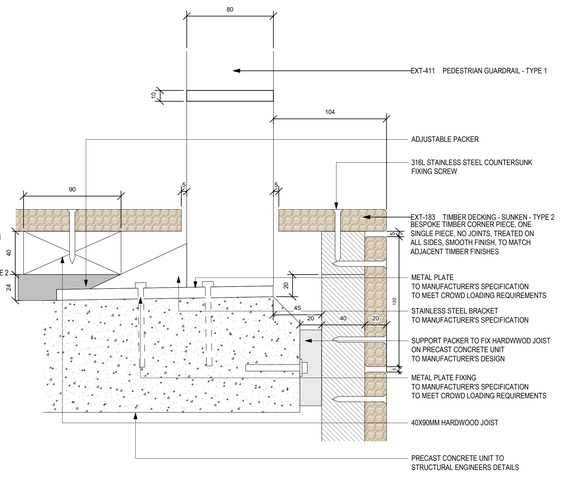

6 EXT-411 TIMBER STEP SIDE BALUSTRADE FIXING DETAIL - SECTION
1 : 2

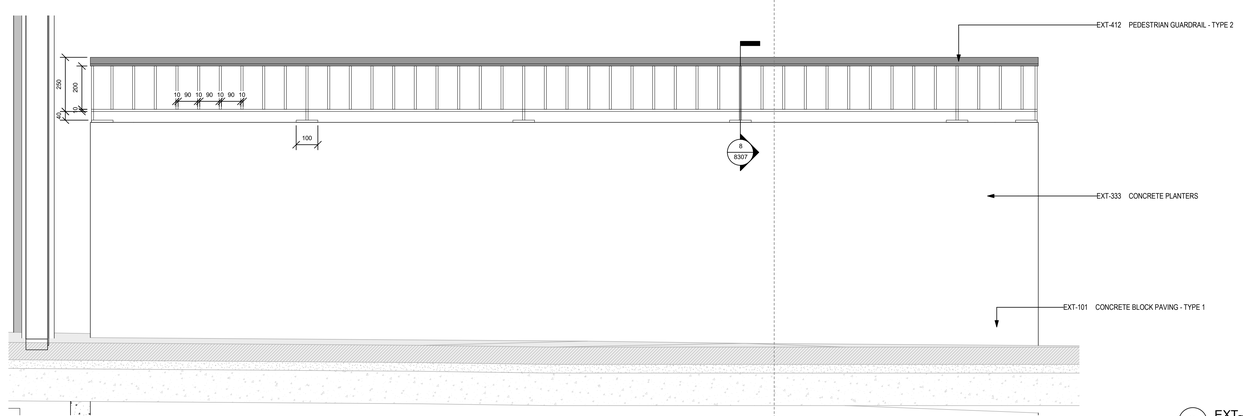

7 EXT-412 TYPICAL PEDESTRIAN GUARDRAIL TYPE 2 DETAIL - ELEVATION
1 : 10

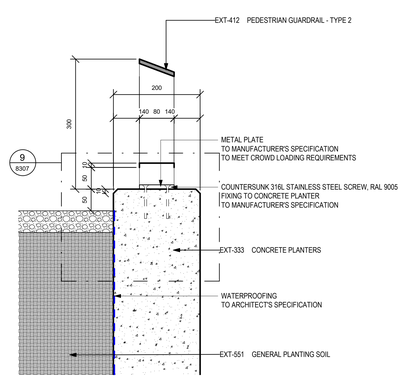

8 EXT-412 TYPICAL PEDESTRIAN GUARDRAIL TYPE 2 DETAIL - SECTION
1 : 5

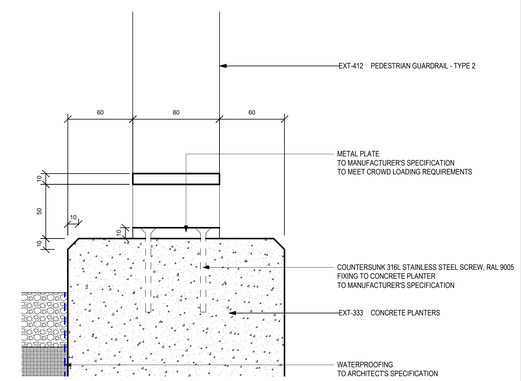

9 EXT-412 TYPICAL PEDESTRIAN GUARDRAIL TYPE 2 FIXING DETAIL - SECTION
1 : 2

Suitability Code (as defined in ISO 19650-2:2018)

Work in Progress (WIP)
S0 - Initial Status

Shared (Non- Contractual)
S1 - Suitable for co-ordination
S2 - Suitable for information
S3 - Suitable for review & comment
S4 - Suitable for stage approval
S5 - Withdrawn
S6 - Suitable for PIM authorisation
S7 - Suitable for AIM authorisation

Published (Contractual)
A1, A2, A3, Etc - Authorised and accepted
B1,B2,B3, Etc. - Partial sign-off (with comments)

Published (AIM Acceptance)
CR - As constructed record document

KEY PLAN

NOTES.

1. ALL FIXINGS, BASE PLATES AND UPSTANDS MUST MEET LOADING REQUIREMENT OF 3KN/M
2. FOR HANDRAIL DETAILS REFER TO BRA-POP-ZZ-01-DR-L-8319

THIS DRAWING IS ONLY TO SCALE IF IT IS REPRODUCED AT THE CORRECT PAPER SIZE
1:10@A0
0 0.1 0.2 0.3 0.4 0.8 m

ALL INTERNAL LAYOUTS AND USES ARE SHOWN FOR ILLUSTRATIVE PORPOSES ONLY AND ARE NOT FOR DETERMINATION

THIS DRAWING IS ONLY TO SCALE IF IT IS REPRODUCED AT THE CORRECT PAPER SIZE
1:5@A0
0 0.05 0.1 0.15 0.2 0.4 m

ALL INTERNAL LAYOUTS AND USES ARE SHOWN FOR ILLUSTRATIVE PORPOSES ONLY AND ARE NOT FOR DETERMINATION

THIS DRAWING IS ONLY TO SCALE IF IT IS REPRODUCED AT THE CORRECT PAPER SIZE
1:2@A0
0 0.025 0.05 0.075 0.1 0.2 m

ALL INTERNAL LAYOUTS AND USES ARE SHOWN FOR ILLUSTRATIVE PORPOSES ONLY AND ARE NOT FOR DETERMINATION

Safety, Health and Environmental Information
In addition to the hazards / risks normally associated with the types of work detailed on this drawing, note the following risks and information:

Construction	See risk register No abnormal risks identified with this package of work

For information relating to Use, Cleaning and Maintenance see the Health and Safety File. It is assumed that all works will be carried out by a competent contractor working, where appropriate, to an approved method statement.

client
OVG INTERNATIONAL

© COPYRIGHT. ALL RIGHTS RESERVED
THIS WORK IS COPYRIGHT AND CANNOT BE REPRODUCED OR COPIED IN ANY FORM OR BY ANY OTHER MEANS (GRAPHIC, ELECTRONIC OR MECHANICAL INCLUDING PHOTOCOPYING) WITHOUT THE WRITTEN PERMISSION OF POPULOUS. ANY LICENSE, EXPRESS OR IMPLIED, TO USE THIS DOCUMENT FOR ANY PURPOSE WHATSOEVER IS RESTRICTED TO THE TERMS OF THE AGREEMENT OR IMPLIED AGREEMENT BETWEEN POPULOUS AND THE INSTRUCTING PARTY.
USE FIGURED DIMENSIONS IN PREFERENCE TO SCALED. CHECK ALL DIMENSIONS ON SITE BEFORE FABRICATION OR SETTING OUT

architect
POPULOUS®

14 BLADES COURT | DEODAR ROAD | LONDON | SW15 2NU | UNITED KINGDOM
TELEPHONE +44 (0)20 8874 7666 FACSIMILE +44 (0)20 8874 7470
ALL PRODUCTION & INTELLECTUAL PROPERTY RIGHTS RESERVED © POPULOUS 2009

REVISIONS

REV	DATE	DESCRIPTION
00	29.11.2019	DRAFT RIBA STAGE 3
01	14.04.2020	ISSUED FOR T1 DRAFT STAGE 4A
02	22.06.2020	ISSUED FOR T2 STAGE 4a
03	05.07.2021	STAGE 4B EXTERNAL METALWORKS
C01	27/02/2023	METALWORK AMENDENT
C02	10/03/2023	AMENDMENT FOLLOWING RFI
C03	17/03/2023	ADDITIONAL INFORMATION INCLUDED

project name **Co-op Live**

title TYPICAL BALUSTRADE DETAILS

purpose of issue **CONSTRUCTION**

scale 1:10,1:5, 1:2 @ A0 drawn FP Project no. 4933 Suitability **S3**
date 29/11/19 checked TJ

project code originator volume level type role number — rev.
reference **BRA-POP-ZZ-ZZ-DR-L-8307** **C03**