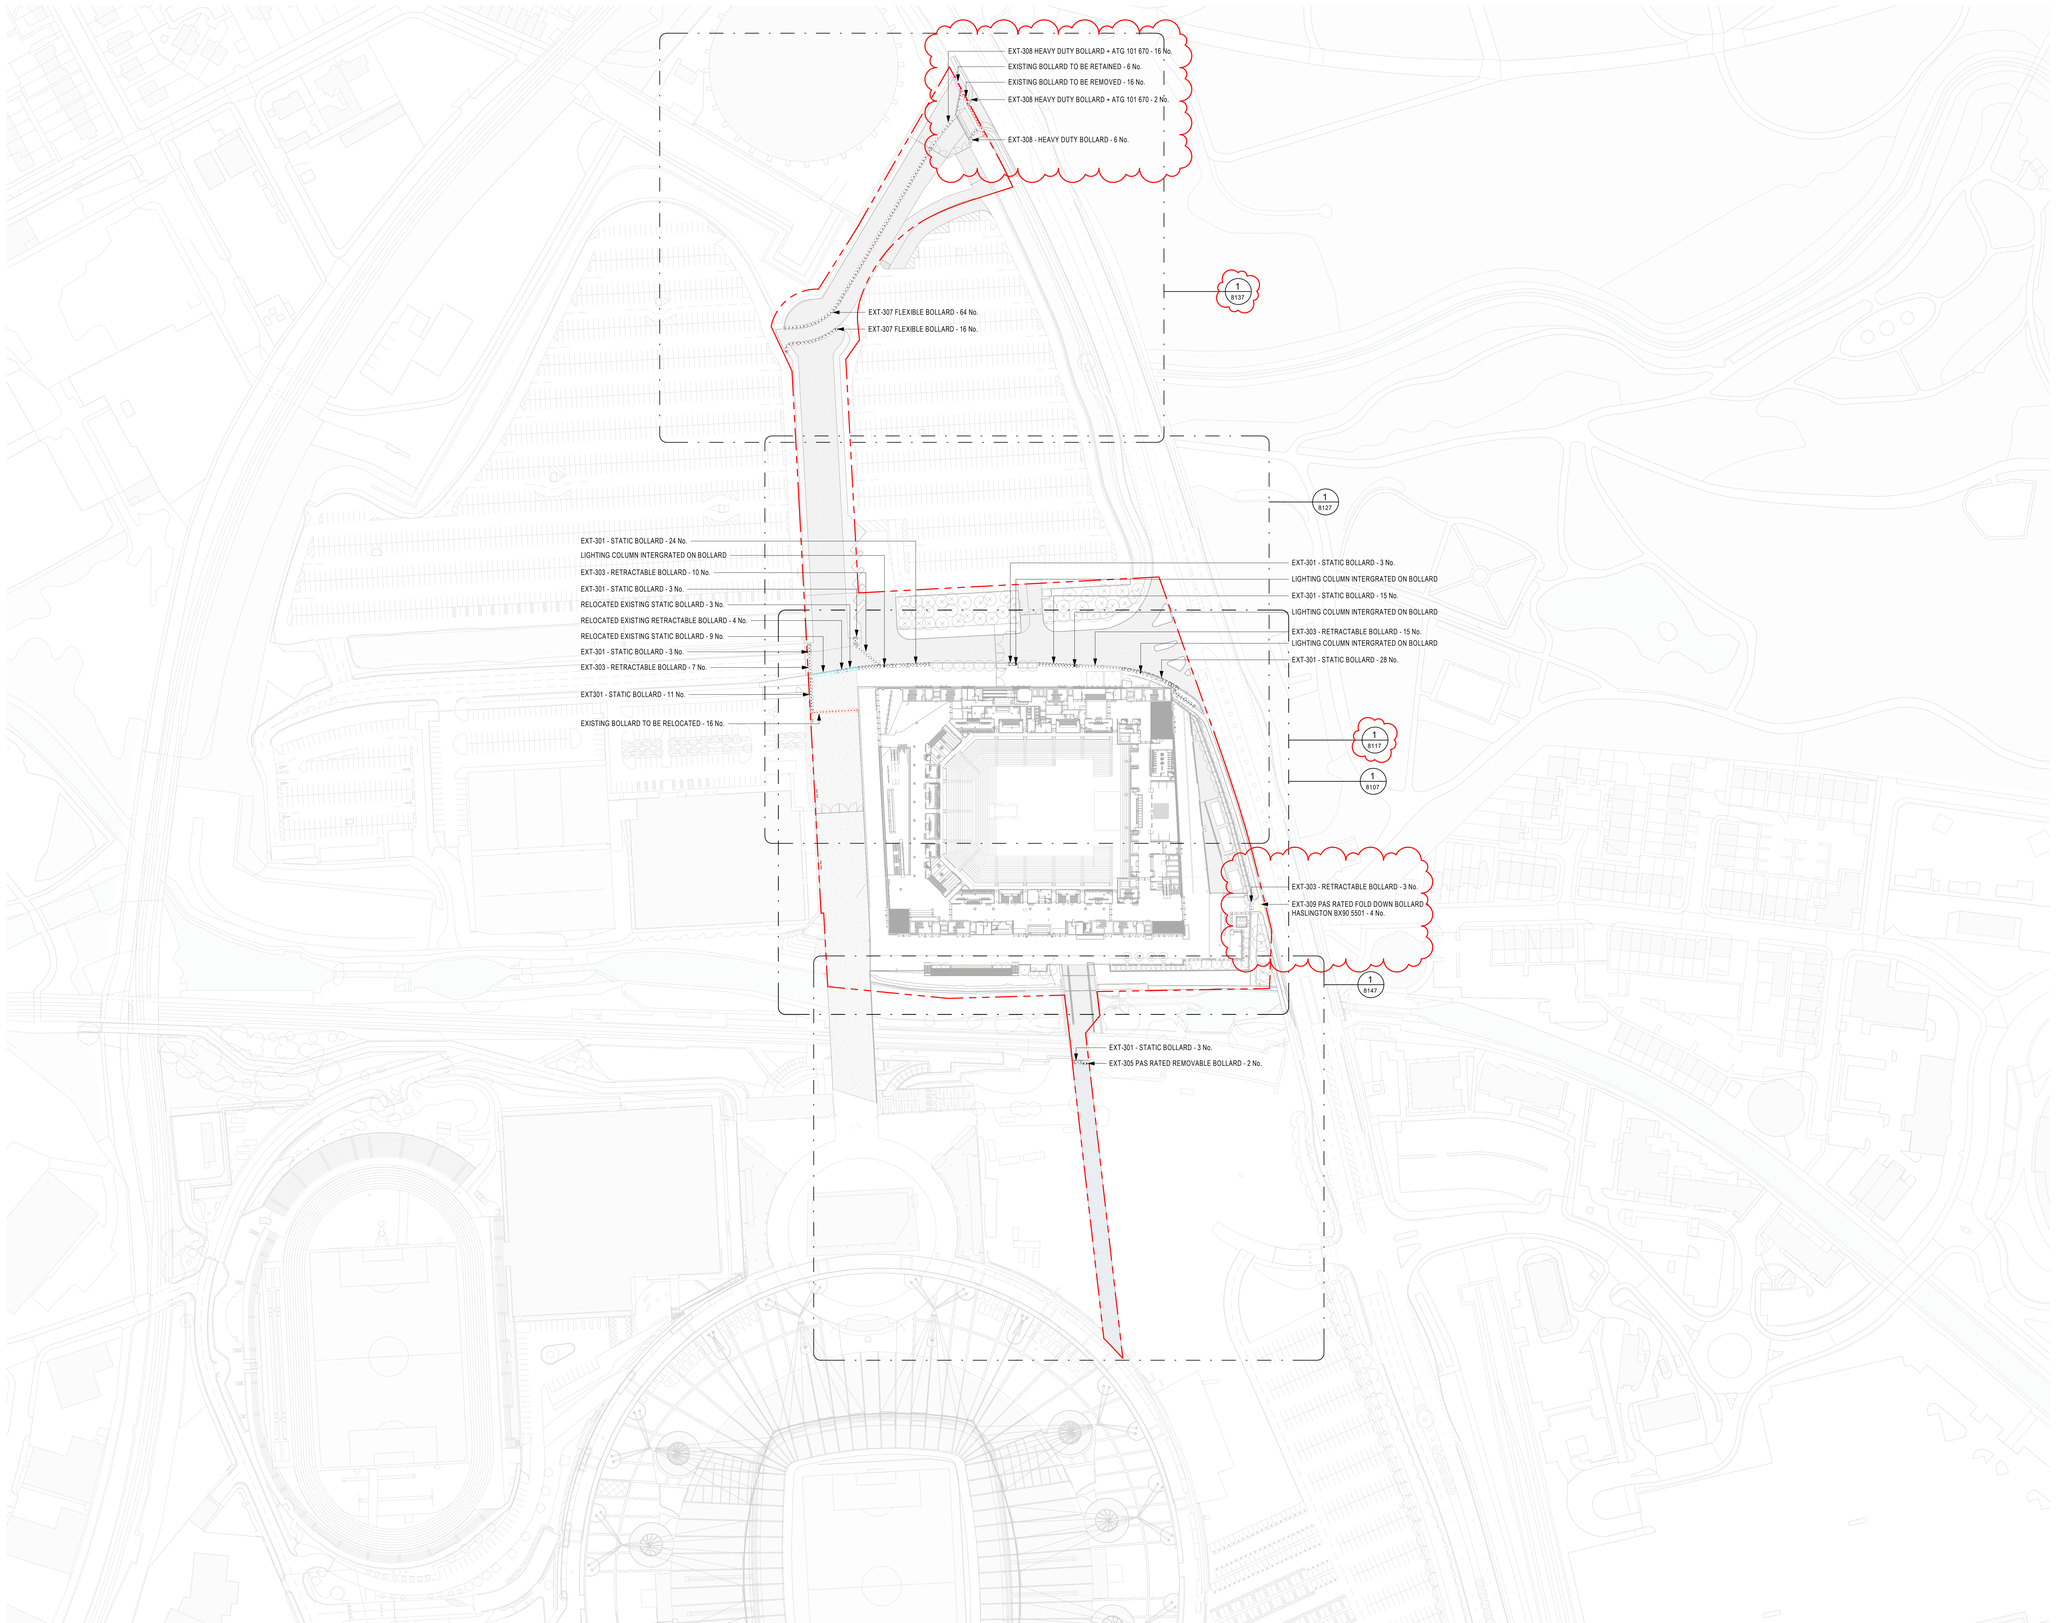

Suitability Code (as defined in ISO 19650-2:2018)

Work in Progress (WIP)
S0 - Initial Status

Shared (Non- Contractual)
S1 - Suitable for co-ordination
S2 - Suitable for information
S3 - Suitable for review & comment
S4 - Suitable for stage approval
S5 - Withdrawn
S6 - Suitable for PIM authorisation
S7 - Suitable for AIM authorisation

Published (Contractual)
A1, A2, A3, Etc. - Authorised and accepted
B1,B2,B3, Etc. - Partial sign-off (with comments)

Published (AIM Acceptance)
CR - As constructed record document

KEY PLAN

KEY

- PLANNING APPLICATION BOUNDARY
- EXT-301 PAS RATED STATIC BOLLARD - TYPE 1 85 No. TOTAL
- EXT-303 PAS RATED RETRACTABLE BOLLARD - TYPE 1 35 No. TOTAL
- EXT-305 PAS RATED REMOVABLE BOLLARD 2 No. TOTAL
- EXT-307 FLEXIBLE BOLLARD 80 No. TOTAL
- EXT-308 HEAVY DUTY BOLLARD + ATG 101 670 29 No. TOTAL
- EXT-309 PAS RATED FOLD DOWN BOLLARD + HASLINGTON BX90 5501 4 No. TOTAL
- EXISTING BOLLARD TO BE RELOCATED 16 No. TOTAL
- RELOCATED EXISTING STATIC BOLLARD 12 No. TOTAL
- RELOCATED EXISTING RETRACTABLE BOLLARD 4 No. TOTAL
- EXISTING BOLLARD TO BE RETAINED 6 No. TOTAL
- EXISTING BOLLARD TO BE REMOVED 16 No. TOTAL
- LIGHTING COLUMN INTERGRATED ON BOLLARD 4 No. TOTAL

THIS DRAWING IS ONLY TO SCALE IF IT IS REPRODUCED AT THE CORRECT PAPER SIZE

1:1000@A0

0 10 20 30 40 80 m

ALL INTERNAL LAYOUTS AND USES ARE SHOWN FOR ILLUSTRATIVE PORPOSES ONLY AND ARE NOT FOR DETERMINATION

client

OVG INTERNATIONAL

© COPYRIGHT. ALL RIGHTS RESERVED

THIS WORK IS COPYRIGHT AND CANNOT BE REPRODUCED OR COPIED IN ANY FORM OR BY ANY MEANS (GRAPHIC, ELECTRONIC OR MECHANICAL INCLUDING PHOTOCOPYING) WITHOUT THE WRITTEN PERMISSION OF POPULOUS ANY LICENSE, EXPRESS OR IMPLIED, TO USE THIS DOCUMENT FOR ANY PURPOSE WHATSOEVER IS RESTRICTED TO THE TERMS OF THE AGREEMENT OR IMPLIED AGREEMENT BETWEEN POPULOUS AND THE INSTRUCTING PARTY.

USE FIGURED DIMENSIONS IN PREFERENCE TO SCALED. CHECK ALL DIMENSIONS ON SITE BEFORE FABRICATION OR SETTING OUT

architect

POPULOUS®

14 BLADES COURT | DEODAR ROAD | LONDON | SW15 2NU | UNITED KINGDOM
TELEPHONE +44 (0)20 8874 7666 FACSIMILE +44 (0)20 8874 7470

ALL PRODUCTION & INTELLECTUAL PROPERTY RIGHTS RESERVED © POPULOUS 2009

REVISIONS

REV	DATE	DESCRIPTION
P00	12.02.2021	STAGE 4B BOLLARDS SCOPE ISSUE
C01	05.03.2021	STAGE 5 BOLLARDS ISSUED FOR CONSTRUCTION

project name: **OVG Manchester**

title: LANDSCAPE SITE SETTING OUT PLAN

purpose of issue: **STAGE 5**

scale 1:1000 @ A0 | drawn PS | Project no. | Suitability
date 12/02/21 | checked TJ | 4933 | S4

reference project code originator volume level type role number: **BRA-POP-ZZ-ZZ-DR-L-8007** | rev. **C01**