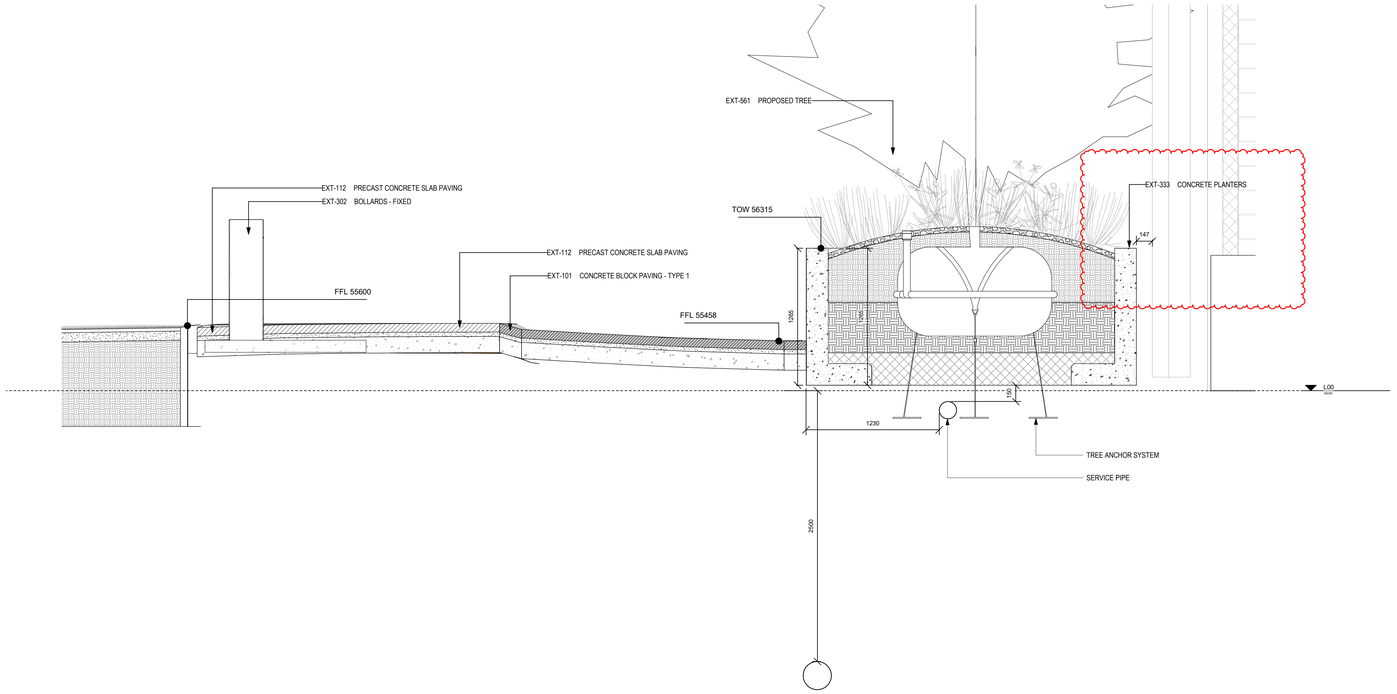

1 SECTION - NE PLANTER
1 : 20

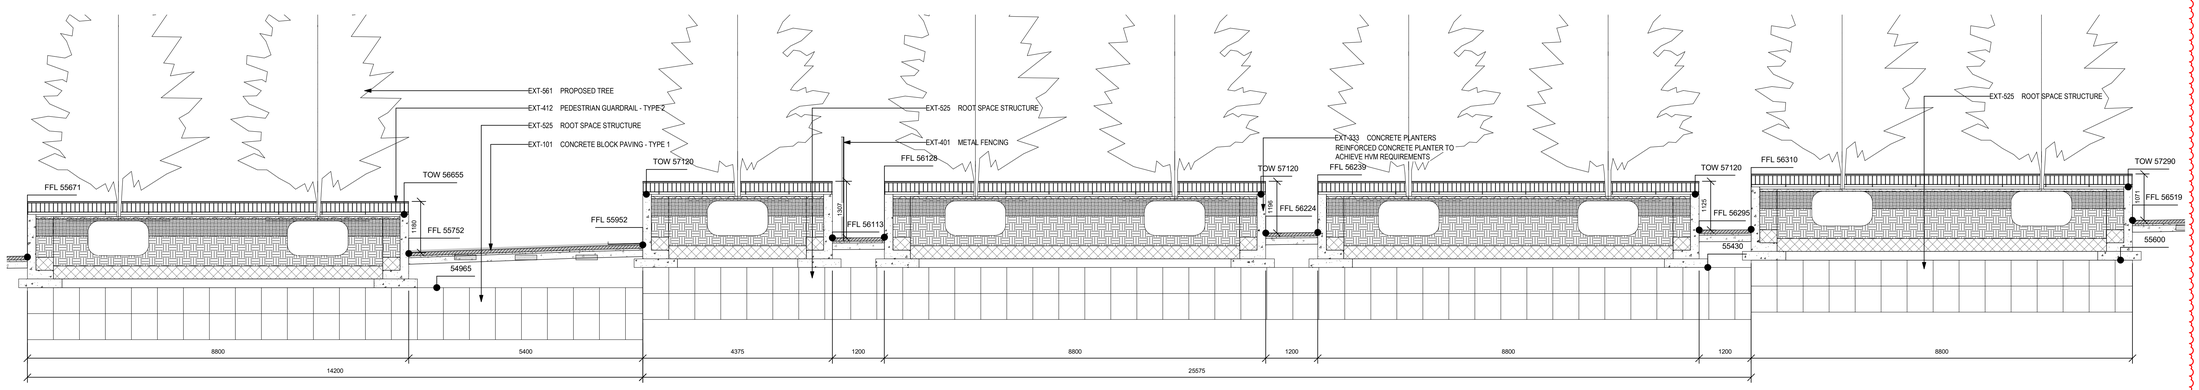

2 SECTION - NW HVM PLANTER
1 : 20

Suitability Code (as defined in ISO 19650-2:2018)

Work in Progress (WIP)
S0 - Initial Status

Shared (Non- Contractual)
S1 - Suitable for co-ordination
S2 - Suitable for information
S3 - Suitable for review & comment
S4 - Suitable for stage approval
S5 - Withdrawn
S6 - Suitable for PIM authorisation
S7 - Suitable for AIM authorisation

Published (Contractual)
A1, A2, A3, Etc - Authorised and accepted
B1,B2,B3, Etc. - Partial sign-off (with comments)

Published (AIM Acceptance)
CR - As constructed record document

KEY PLAN

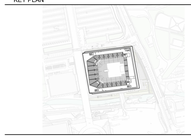

client
OVG INTERNATIONAL

© COPYRIGHT. ALL RIGHTS RESERVED
THIS WORK IS COPYRIGHT AND CANNOT BE REPRODUCED OR COPIED IN ANY FORM OR BY ANY OTHER MEANS (GRAPHIC, ELECTRONIC OR MECHANICAL INCLUDING PHOTOCOPYING) WITHOUT THE WRITTEN PERMISSION OF POPULOUS. ANY UNAUTHORISED USE OF, OR RELIANCE TO USE THIS DOCUMENT FOR ANY PURPOSE WHATSOEVER IS RESTRICTED TO THE TERMS OF THE AGREEMENT OR IMPLIED AGREEMENT BETWEEN POPULOUS AND THE INSTRUCTING PARTY.
USE FIGURED DIMENSIONS IN PREFERENCE TO SCALED. CHECK ALL DIMENSIONS ON SITE BEFORE FABRICATION OR SETTING OUT

architect
POPULOUS®

14 BLADES COURT | DEODAR ROAD | LONDON | SW15 2NJ | UNITED KINGDOM
TELEPHONE +44 (0)20 8874 7666 FACSIMILE +44 (0)20 8874 7470
ALL PRODUCTION & INTELLECTUAL PROPERTY RIGHTS RESERVED © POPULOUS 2009

REVISIONS

REV	DATE	DESCRIPTION
C01	05.05.2023	ISSUE FOR CONSTRUCTION
C02	22.05.2023	ISSUE FOR CONSTRUCTION

project name **Co-op Live**

title PLANTER DETAILS
NORTH EAST
LEVEL 00

purpose of issue

scale As indicated @ A0 drawn SA Project no. Suitability
date 05/05/23 checked TJ 4933 **S3**

reference project code originator volume level type role number rev.
BRA-POP-ZZ-00-DR-L-8203 **C02**