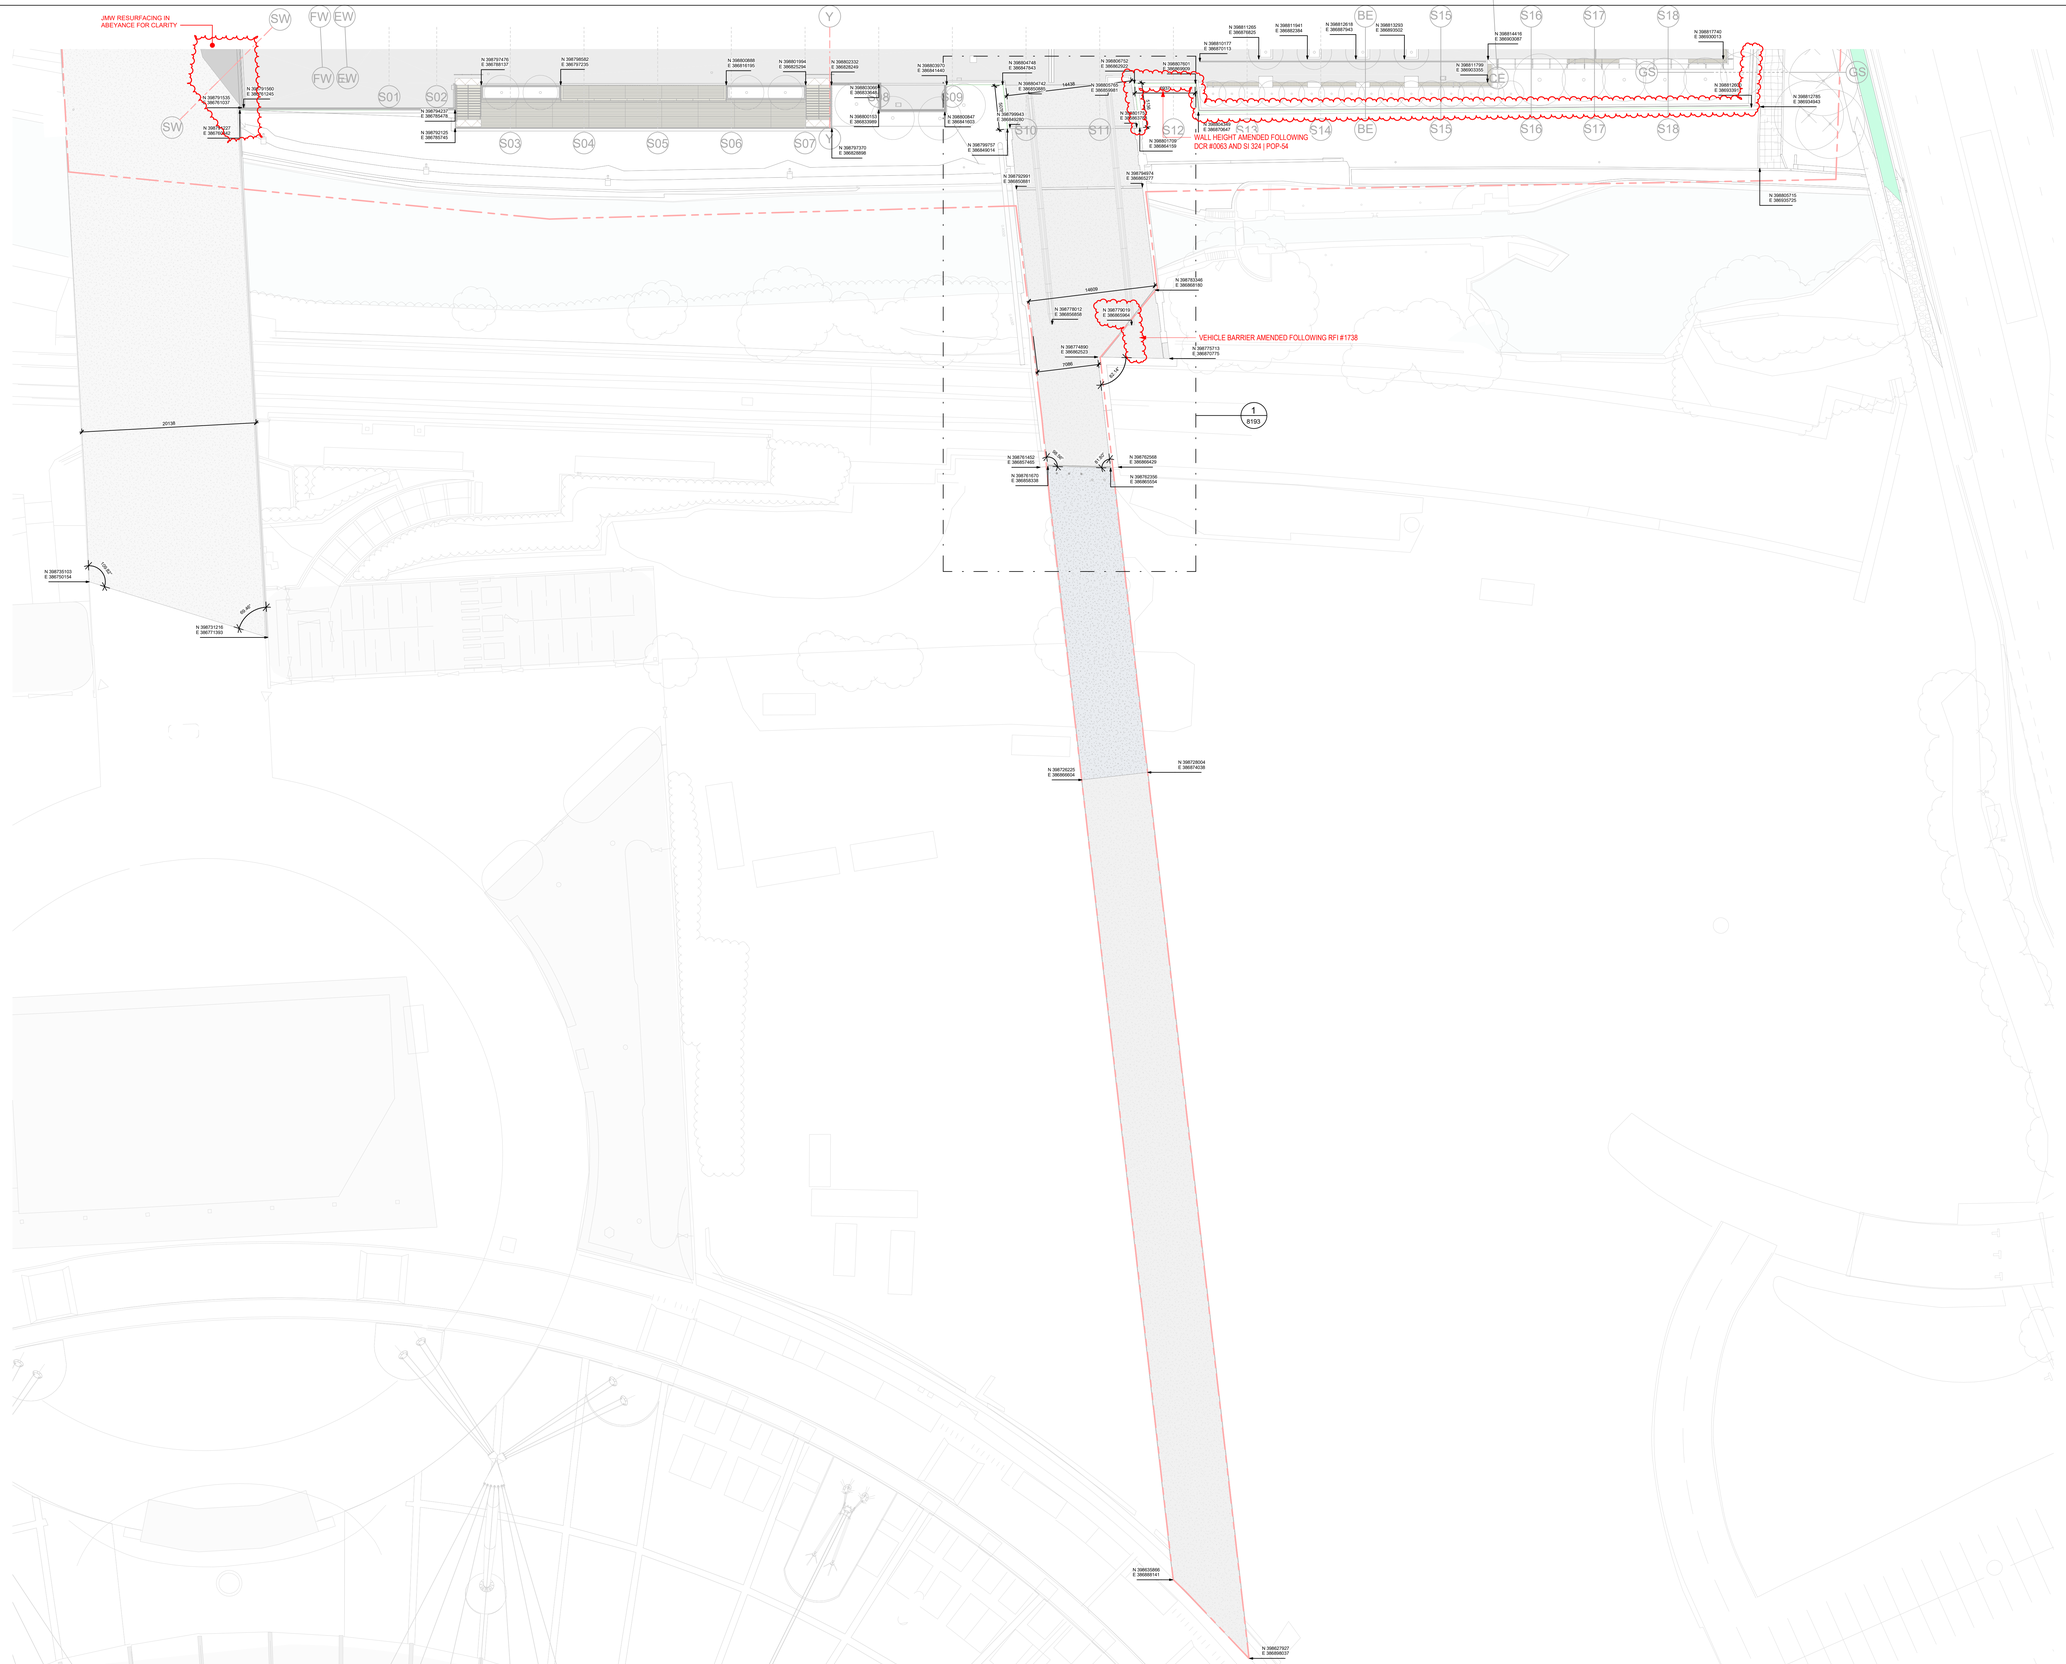

Suitability Code (as defined in ISO 19650-2:2018)

Work in Progress (WIP)
S0 - Initial Status

Shared (Non- Contractual)
S1 - Suitable for co-ordination
S2 - Suitable for information
S3 - Suitable for review & comment
S4 - Suitable for stage approval
S5 - Withdrawn
S6 - Suitable for PIM authorisation
S7 - Suitable for AIM authorisation

Published (Contractual)
A1, A2, A3, Etc - Authorised and accepted
B1,B2,B3, Etc. - Partial sign-off (with comments)

Published (AIM Acceptance)
CR - As constructed record document

KEY PLAN

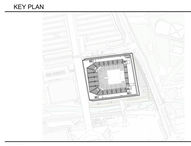

KEY

PLANNING APPLICATION BOUNDARY

N XXXXXXXXX
E XXXXXXXXX — COORDINATES AT SPOT

THIS DRAWING IS ONLY TO SCALE IF IT IS REPRODUCED AT THE CORRECT PAPER SIZE

1:250@A0

0 5 10 20 m

ALL INTERNAL LAYOUTS AND USES ARE SHOWN FOR ILLUSTRATIVE PURPOSES ONLY AND ARE NOT FOR DETERMINATION

client

OVG INTERNATIONAL

© COPYRIGHT. ALL RIGHTS RESERVED

THIS WORK IS COPYRIGHT AND CANNOT BE REPRODUCED OR COPIED IN ANY FORM OR BY ANY OTHER MEANS (GRAPHIC, ELECTRONIC OR MECHANICAL INCLUDING PHOTOCOPYING) WITHOUT THE WRITTEN PERMISSION OF POPULOUS ANY LICENSE, EXPRESS OR IMPLIED, TO USE THIS DRAWING IS LIMITED TO THE PURPOSES AND THE PERIOD SET OUT IN THE TERMS OF THE AGREEMENT OR IMPLIED AGREEMENT BETWEEN POPULOUS AND THE INSTRUCTING PARTY.

USE FIGURED DIMENSIONS IN PREFERENCE TO SCALED. CHECK ALL DIMENSIONS ON SITE BEFORE FABRICATION OR SETTING OUT

architect

POPULOUS®

14 BLADES COURT | DEODAR ROAD | LONDON | SW15 2NU | UNITED KINGDOM
TELEPHONE +44 (0)20 8874 7666 FACSIMILE +44 (0)20 8874 7470
ALL PRODUCTION & INTELLECTUAL PROPERTY RIGHTS RESERVED © POPULOUS 2009

REVISIONS

REV	DATE	DESCRIPTION
00	12.02.2021	STAGE 4B BOLLARDS SCOPE ISSUE
01	18.06.2021	STAGE 4B REVISED TO INCORPORATE VE
C01	11.02.2022	FOR CONSTRUCTION
C02	07.06.2022	LANDSCAPE UPDATE FOLLOWING DCR #0063 AND SI 324 | POP-54

project name: **Co-op Live**

title: FLB AND CONNECTION PATH SETTING OUT PLAN LEVEL 01

purpose of issue: **CONSTRUCTION**

scale 1 : 250 @ A0 | drawn FP | Project no. | Suitability
date 12/02/21 | checked TJ | 4933 | **S4**

reference project code originator volume level type role number: **BRA-POP-ZZ-01-DR-L-8147** | rev. **C02**