

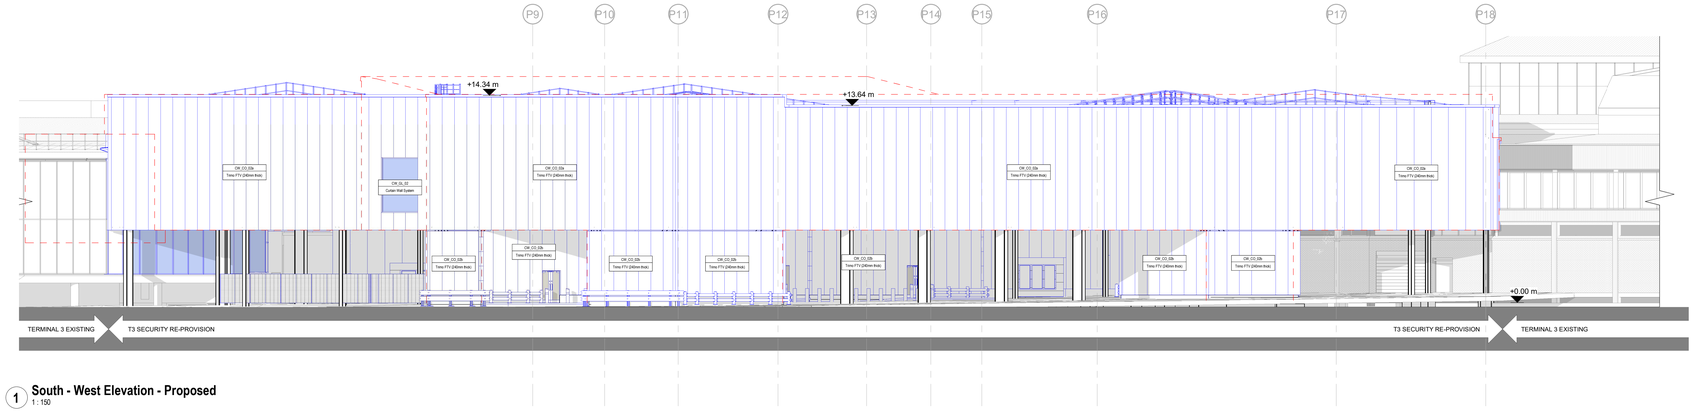


1 **South - West Elevation - Proposed**
1 : 150

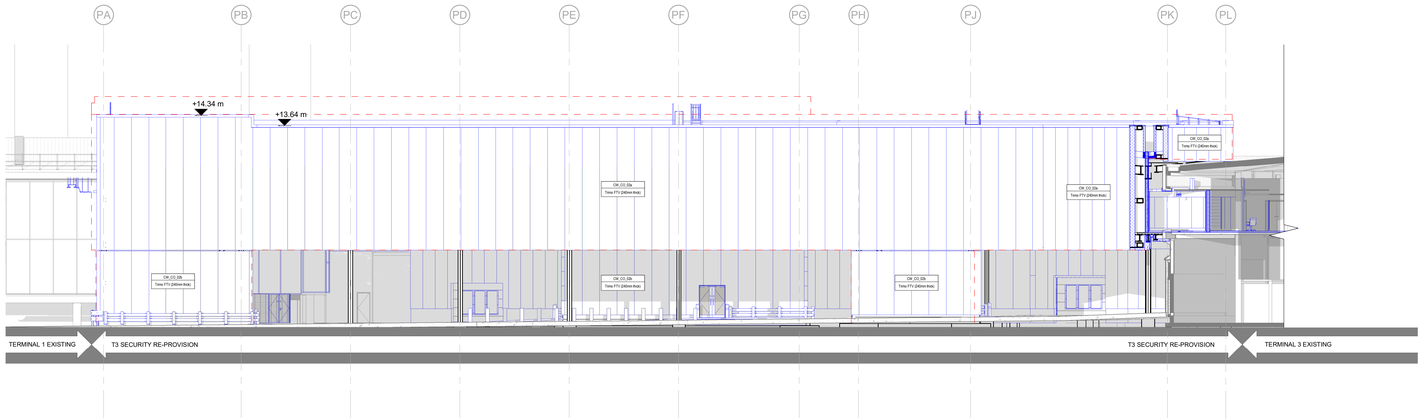


2 **South Elevation - Proposed**
1 : 150

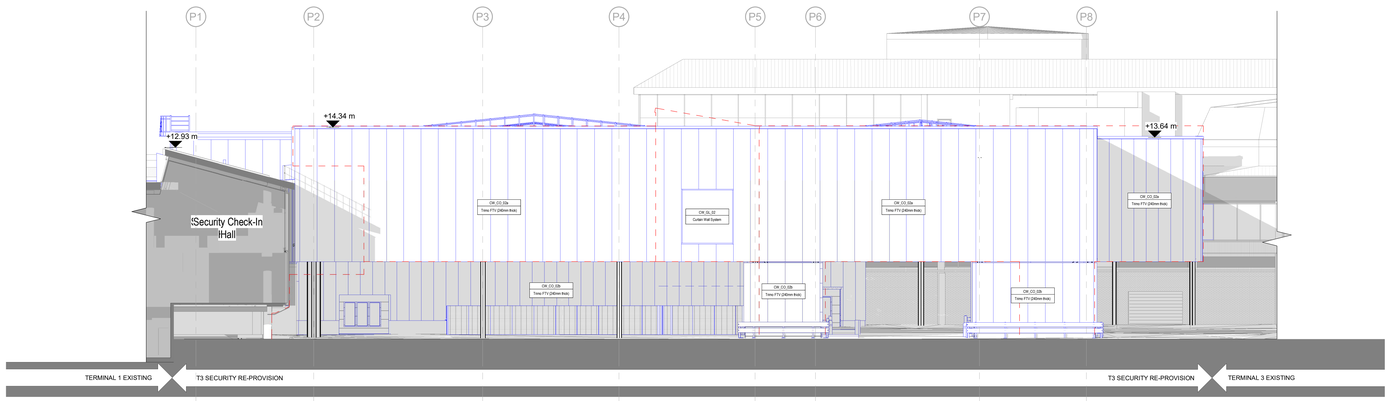

3 **West Elevation - Proposed**
1 : 150

NOTES:
1. SAFETY IS A PRIORITY. IF YOU HAVE ANY CONCERN ABOUT SAFETY IN THE CONSTRUCTION OR ULTIMATE USE OF THE WORKS DESCRIBED, PLEASE RAISE IT IMMEDIATELY WITH THE PROJECT MANAGER.
2. DO NOT SCALE FROM THIS DRAWING.
3. ALL DIMENSIONS TO BE CHECKED ON SITE.
4. THIS DRAWING SHALL BE READ IN CONJUNCTION WITH ALL OTHER ARCHITECTURAL, MECHANICAL, ELECTRICAL SERVICE AND STRUCTURAL DRAWINGS, SPECIFICATION, SCHEDULES, REPORTS AND ASSOCIATED DOCUMENTS.
5. THIS DRAWING SHOWS DESIGN INTENT AND SHALL NOT BE USED FOR CONSTRUCTION OR SHOP DRAWING PURPOSES.
6. DEVELOPMENT OF THIS DRAWING SHALL REQUIRE THE CONTRACTOR TO CONFIRM WITH ALL THEIR SPECIALISTS AND INSTALLERS ALL ASPECTS OF THE WORKS COVERED BY THE CONTRACT. THIS SHALL INCLUDE BUT NOT BE LIMITED TO FULL COORDINATION WITH THE BUILDING AND ALL ELEMENTS THEREIN: LEAD TIME, PROGRAMME OF WORKS, CONSTRUCTION MATERIALS / FINISHES, ACCESS FOR INSTALLATION AND MAINTENANCE, INTEGRATION WITH OTHER ELEMENTS TO ALLOW FULL FUNCTIONALITY OF ALL ELEMENTS, INCLUDING BUT NOT LIMITED TO SAFETY ETC.
7. REFER TO RECORD AND/OR SURVEY DRAWINGS WHERE THEY EXIST OR DETERMINE FROM SITE SURVEY DETAILS OF EXISTING.

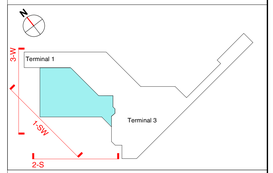

FOR PLANNING PURPOSES ONLY

LEGEND

- Existing Construction
- New Construction
- Planning Application Boundary
- Manchester Airport Land Ownership
- Dashed red line denotes previous profile of building

Rev	Dm	Date	Description
V1	JR	29/09/23	NMA Submittal

This drawing supersedes:

Client

manchester airport MAG

KIER BUROHAPPOLD ENGINEERING

PASCALL +WATSON HOARE LEA

The Warehouses 10 Black Friars Lane London EC4V 6EJ
T +44 (0)20 3837 2500 www.pascalls.co.uk

Title

MAN TERMINAL 3
SHELL & CORE
ELEVATIONS
PROPOSED

Project Name: T3 SECURITY AREA RE-PROVISION	Public: C1	Title: NA	Originators Job No.: 7074
			Discipline: Architecture
Client: Manchester Airport Group	Drawing Originator: Pascall + Watson		Purpose of Issue: For Information
Drawn By: A.Chana	Checked By: J.Gil	Review By: T.Ward	Approved By: J.Rogers
			Scale @ A0: As indicated

Proj.Number	Location/Ref	Orig.	Role	Type	ACC	Number	Rev.	Status
FSRMAN	MAN.TL3.XX.SE	PWK	A	EL	BLDSTR	4260	V1	S2

Note:
Contractors are responsible for the verification of all dimensions on site and the architect is to be informed of any discrepancy. Do not scale from this drawing. Use figured dimensions only. This drawing may contain Ordnance Survey Mastermap and Raster data. © Crown Copyright and database right 2013. Ordnance Survey Licence number 100006119.