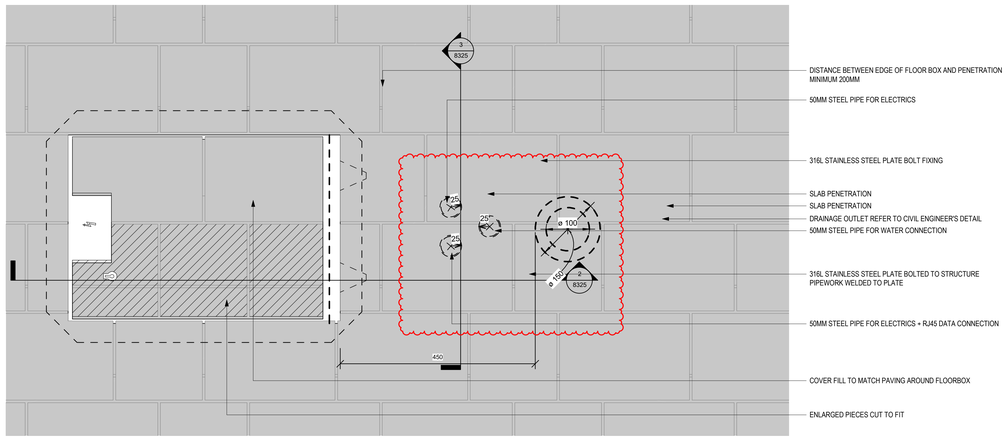

1 FLOOR BOX ON PAVING_DETAIL PLAN
1 : 5

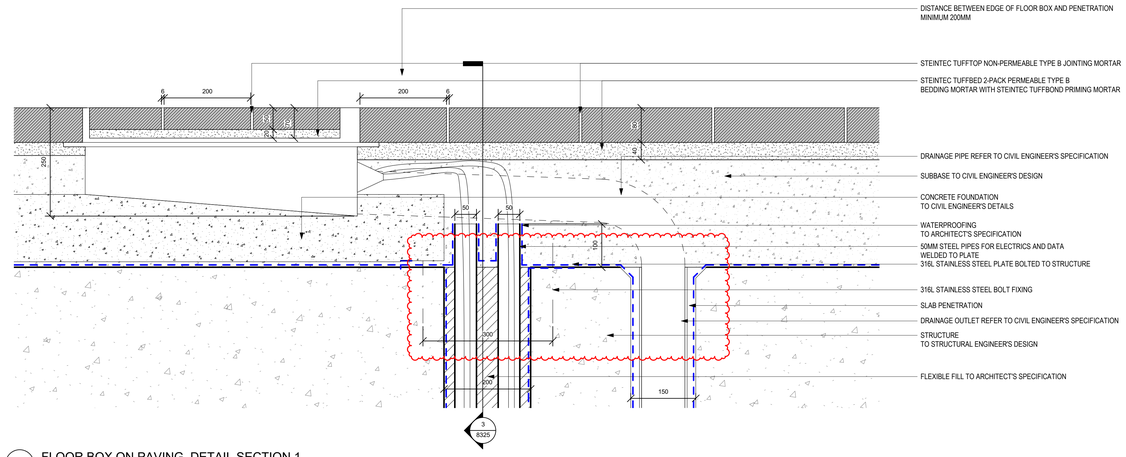

2 FLOOR BOX ON PAVING_DETAIL SECTION 1
1 : 5

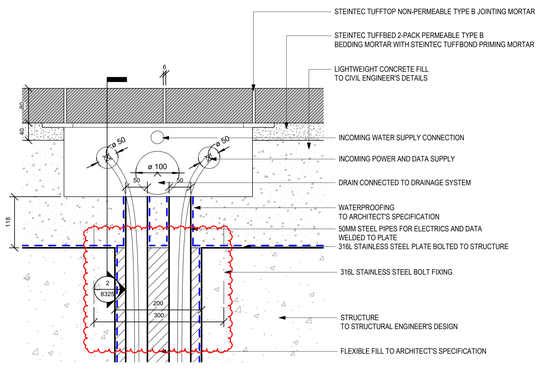

3 FLOOR BOX ON PAVING_DETAIL SECTION 2
1 : 5

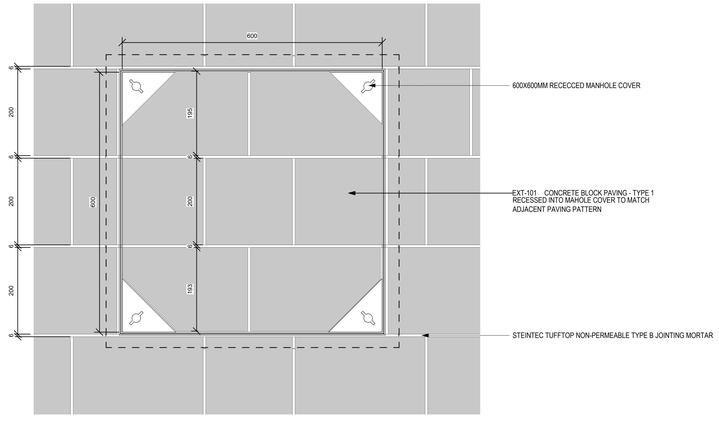

4 RECESSED MANHOLE COVER 600X600MM_DETAIL PLAN
1 : 5

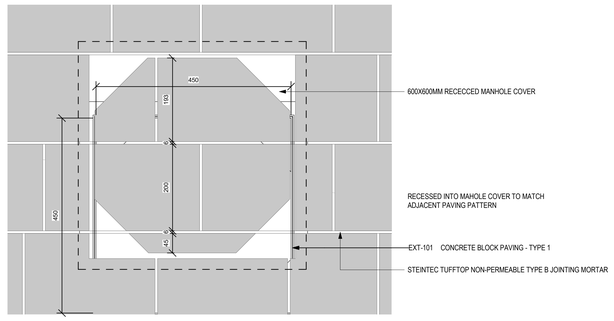

5 RECESSED MANHOLE COVER 450X450MM_DETAIL PLAN
1 : 5

Suitability Code (as defined in ISO 19650-2:2018)

Work in Progress (WIP)
S0 - Initial Status

Shared (Non- Contractual)
S1 - Suitable for co-ordination
S2 - Suitable for information
S3 - Suitable for review & comment
S4 - Suitable for stage approval
S5 - Withdrawn
S6 - Suitable for PIM authorisation
S7 - Suitable for AIM authorisation

Published (Contractual)
A1, A2, A3, Etc - Authorised and accepted
B1,B2,B3, Etc. - Partial sign-off (with comments)

Published (AIM Acceptance)
CR - As constructed record document

KEY PLAN

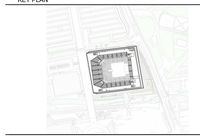

NOTES.

1. FOR PAVING DETAILS REFER TO BRA-POP-ZZ-ZZ-DR-L-8300
2. FOR SLAB PENETRATION DETAILS REFER TO BRA-POP-ZZ-01-DR-L-8324
3. ALL FLOOR BOXES TO PROVIDE POWER AND WATER PER SPECIFICATION PRODUCT
4. FOR STRUCTURE REFER TO STRUCTURAL ENGINEER'S PACKAGE

THIS DRAWING IS ONLY TO SCALE IF IT IS REPRODUCED AT THE CORRECT PAPER SIZE

1:5@A0

0 0.05 0.1 0.15 0.2 0.4 m

ALL INTERNAL LAYOUTS AND USES ARE SHOWN FOR ILLUSTRATIVE PORPOSES ONLY AND ARE NOT FOR DETERMINATION

Safety, Health and Environmental Information

In addition to the hazards / risks normally associated with the types of work detailed on this drawing, note the following risks and information:

Construction	See risk register No abnormal risks identified with this package of work

For information relating to Use, Cleaning and Maintenance see the Health and Safety File. It is assumed that all works will be carried out by a competant contractor working, where appropriate, to an approved method statement.

client

OVG INTERNATIONAL

© COPYRIGHT. ALL RIGHTS RESERVED

THIS WORK IS COPYRIGHT AND CANNOT BE REPRODUCED OR COPIED IN ANY FORM OR BY ANY OTHER MEANS (GRAPHIC, ELECTRONIC OR MECHANICAL INCLUDING PHOTOCOPYING) WITHOUT THE WRITTEN PERMISSION OF POPULOUS ANY LICENSE, EXPRESS OR IMPLIED, TO USE THIS DOCUMENT FOR ANY PURPOSE WHATSOEVER IS RESTRICTED TO THE TERMS OF THE AGREEMENT OR IMPLIED AGREEMENT BETWEEN POPULOUS AND THE INSTRUCTING PARTY.

USE FIGURED DIMENSIONS IN PREFERENCE TO SCALED. CHECK ALL DIMENSIONS ON SITE BEFORE FABRICATION OR SETTING OUT

architect

POPULOUS®

14 BLADES COURT | DEODAR ROAD | LONDON | SW15 2NU | UNITED KINGDOM
TELEPHONE +44 (0)20 8874 7666 FACSIMILE +44 (0)20 8874 7470
ALL PRODUCTION & INTELLECTUAL PROPERTY RIGHTS RESERVED © POPULOUS 2009

REVISIONS

REV	DATE	DESCRIPTION
00	22.06.2020	ISSUED FOR T2 STAGE 4a
C01	02.12.2021	HARD LANDSCAPE PACKAGE FOR CONSTRUCTION
C02	16.06.2023	ADDITIONAL INFORMATION INCLUDED
C03	24.07.2023	PODIUM DRAINAGE OUTLET UPDATE

project name **Co-op Live**

title TYPICAL FLOOR BOX DETAILS LEVEL 01

purpose of issue **CONSTRUCTION**

scale 1 : 5 @ A0 drawn FP Project no. Suitability

date 22.06.2020 checked TJ 4933 **S3**

reference project code originator volume level type role number **BRA-POP-ZZ-01-DR-L-8325** rev. **C03**