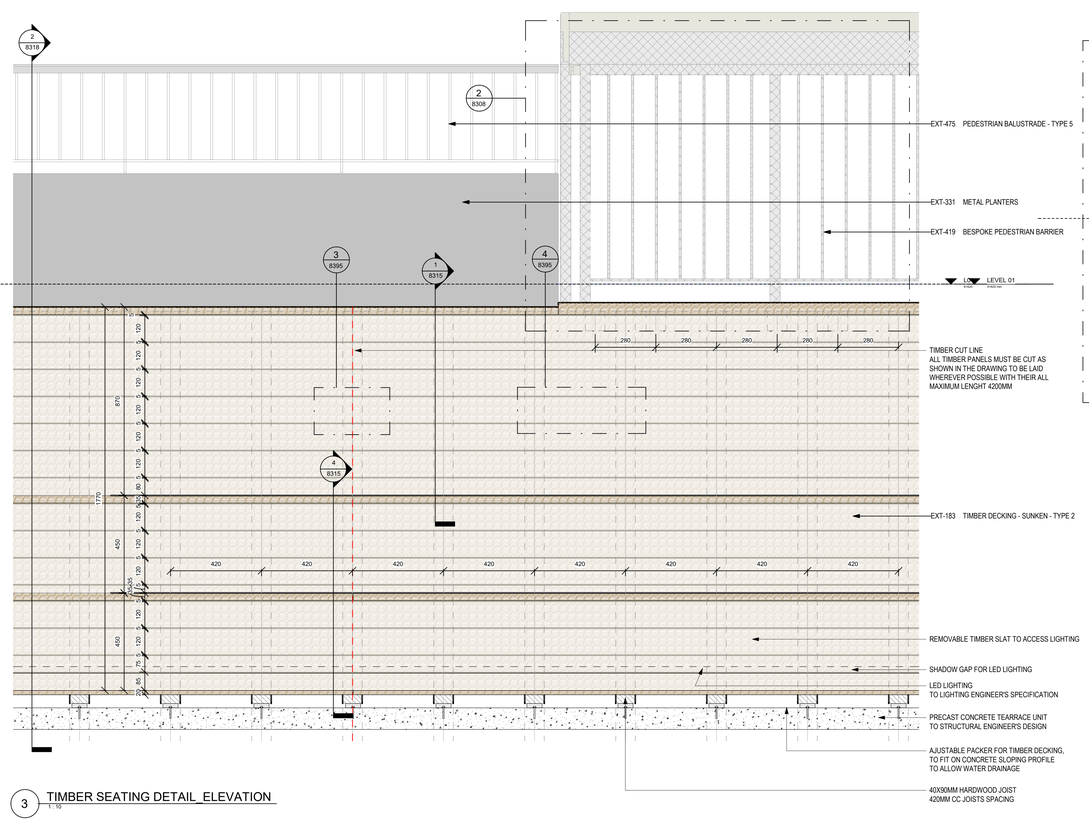

3 TIMBER SEATING DETAIL_ELEVATION
1 : 10

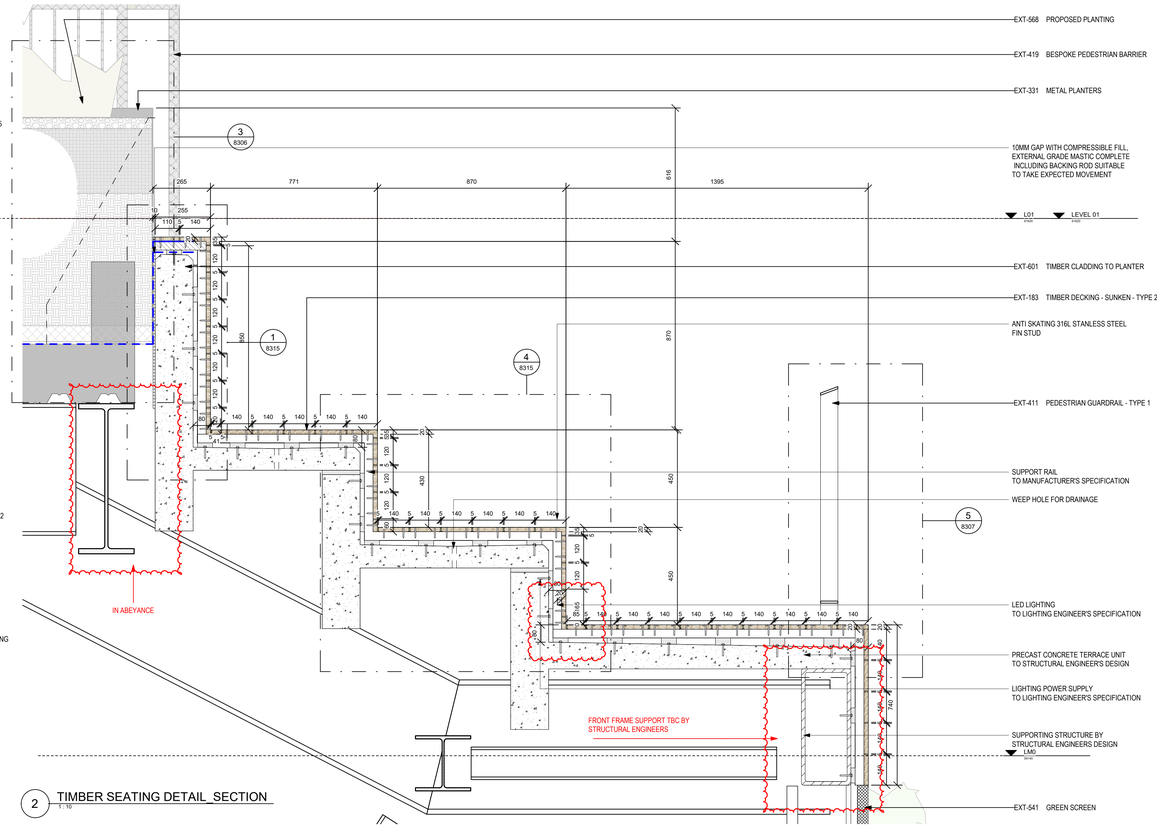

2 TIMBER SEATING DETAIL_SECTION
1 : 10

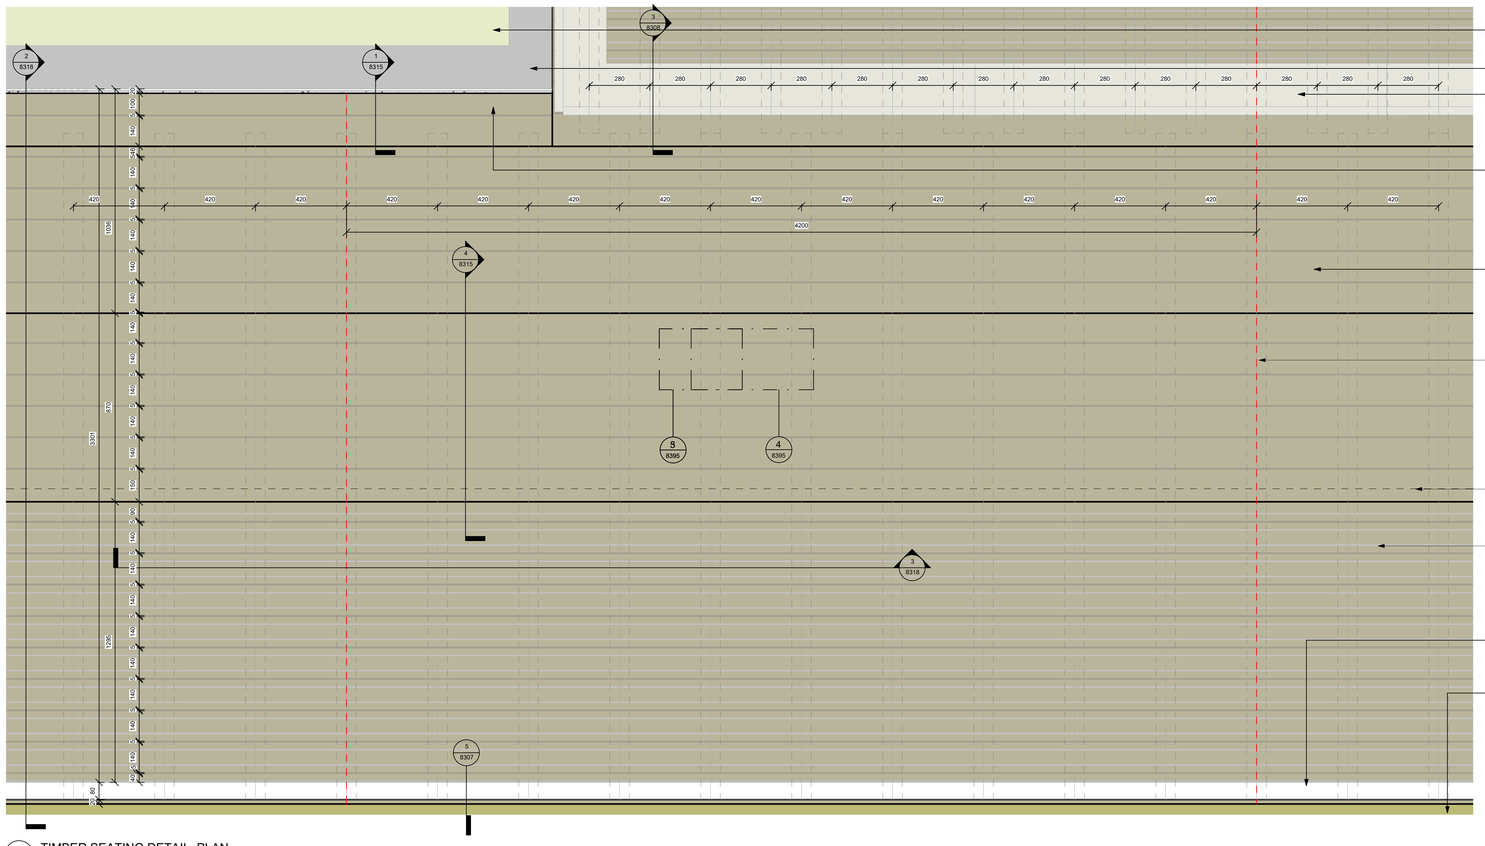

1 TIMBER SEATING DETAIL_PLAN
1 : 10

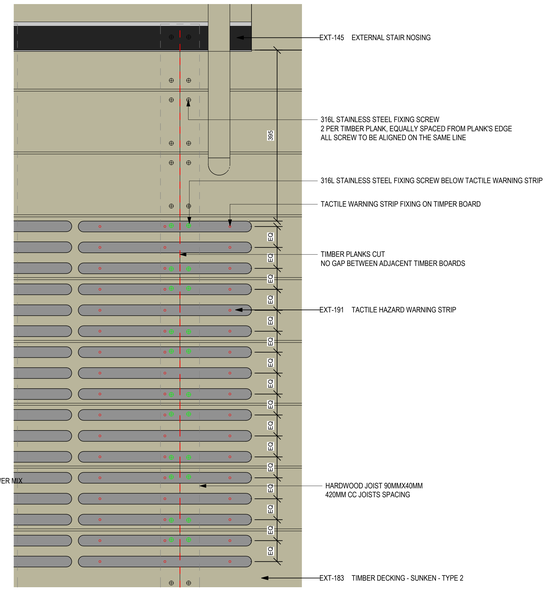

4 WARNING STRIP ON TIMBER DECKING DEATIL
1 : 5

Suitability Code (as defined in ISO 19650-2:2018)

Work in Progress (WIP)
S0 - Initial Status

Shared (Non- Contractual)
S1 - Suitable for co-ordination
S2 - Suitable for information
S3 - Suitable for review & comment
S4 - Suitable for stage approval
S5 - Withdrawn
S6 - Suitable for PIM authorisation
S7 - Suitable for AIM authorisation

Published (Contractual)
A1, A2, A3, Etc. - Authorised and accepted
B1,B2,B3, Etc. - Partial sign-off (with comments)

Published (AIM Acceptance)
CR - As constructed record document

KEY PLAN

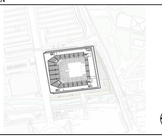

NOTES.

1. EACH HORIZONTAL TIMBER PLANKS AT VEHICULAR AREA. AT PEDESTRIAN AREA AT THE BASE OF THE SEATING AND ON STEP TREADS TO HAVE TWO SLIP RESISTANT AGGREGATE INSERTS IN ROUTED GROOVES. NO ANTI SLIP RESISTANT AGGREGATE TO BE INCULDED IN HORIZONTAL PLANKS ON SEATING DECKS.
2. LED LIGHTING TO BE INTEGRATED UNDER CENTRAL HANDRAIL FOLLOWING LIGHTING ENGINEERS SPECIFICATION.
3. FOR TIER DECKING GENERAL LAYOUT REFER TO BRA-POP-ZZ-01-DR-L-8302
4. FOR DETAILS REFER TO BRA-POP-ZZ-01-DR-L-8315
5. FOR AXONOMETRIC VIEW REFER TO BRA-POP-ZZ-01-DR-L-8316
6. FOR TIMBER SEATING REFER TO BRA-POP-ZZ-01-DR-L-8318
7. FOR BALUSTRADE REFER TO BRA-POP-ZZ-ZZ-DR-L-8307
8. FOR HANDRAIL REFER TO BRA-POP-ZZ-01-DR-L-8319

THIS DRAWING IS ONLY TO SCALE IF IT IS REPRODUCED AT THE CORRECT PAPER SIZE

1:10@A0

0 0.1 0.2 0.3 0.4 0.8 m

ALL INTERNAL LAYOUTS AND USES ARE SHOWN FOR ILLUSTRATIVE PORPOSES ONLY AND ARE NOT FOR DETERMINATION

Safety, Health and Environmental Information
In addition to the hazards / risks normally associated with the types of work detailed on this drawing, note the following risks and information:

Construction	See risk register No abnormal risks identified with this package of work

For information relating to Use, Cleaning and Maintenance see the Health and Safety File. It is assumed that all works will be carried out by a competant contractor working, where appropriate, to an approved method statement.

client
OVG INTERNATIONAL

© COPYRIGHT. ALL RIGHTS RESERVED

THIS WORK IS COPYRIGHT AND CANNOT BE REPRODUCED OR COPIED IN ANY FORM OR BY ANY OTHER MEANS (GRAPHIC, ELECTRONIC OR MECHANICAL INCLUDING PHOTOCOPYING) WITHOUT THE WRITTEN PERMISSION OF POPULOUS ANY LICENSE, EXPRESS OR IMPLIED, TO USE THIS DOCUMENT FOR ANY PURPOSE WHATSOEVER IS RESTRICTED TO THE TERMS OF THE AGREEMENT OR IMPLIED AGREEMENT BETWEEN POPULOUS AND THE INSTRUCTING PARTY.

USE FIGURED DIMENSIONS IN PREFERENCE TO SCALED. CHECK ALL DIMENSIONS ON SITE BEFORE FABRICATION OR SETTING OUT.

architect
POPULOUS®

14 BLADES COURT | DEODAR ROAD | LONDON | SW15 2NU | UNITED KINGDOM
TELEPHONE +44 (0)20 8874 7666 FACSIMILE +44 (0)20 8874 7470
ALL PRODUCTION & INTELLECTUAL PROPERTY RIGHTS RESERVED © POPULOUS 2009

REVISIONS

REV	DATE	DESCRIPTION
00	22.06.2020	ISSUED FOR T2 STAGE 4a
01	09.04.2021	STAGE 4B TIMBER DECKING
02	18.06.2021	STAGE 4B REVISED TO INCORPORATE VE
C01	08.09.2021	TIMBER DECKING ISSUED FOR CONSTRUCTION
C02	10/03/2023	AMENDMENT FOLLOWING RFI

project name: **Co-op Live**

title: SOUTH PODIUM TIER DECKING
TIMBER SEATING DETAIL
LEVEL 01

purpose of issue: STAGE 4B

scale 1:10,1:5 @ A0 | drawn FP | Project no. 4933 | Suitability S3
date 22.06.2020 | checked TJ

reference: project code BRA | originator POP | volume ZZ | level 01 | type DR | role L | number 8318 | rev. C02