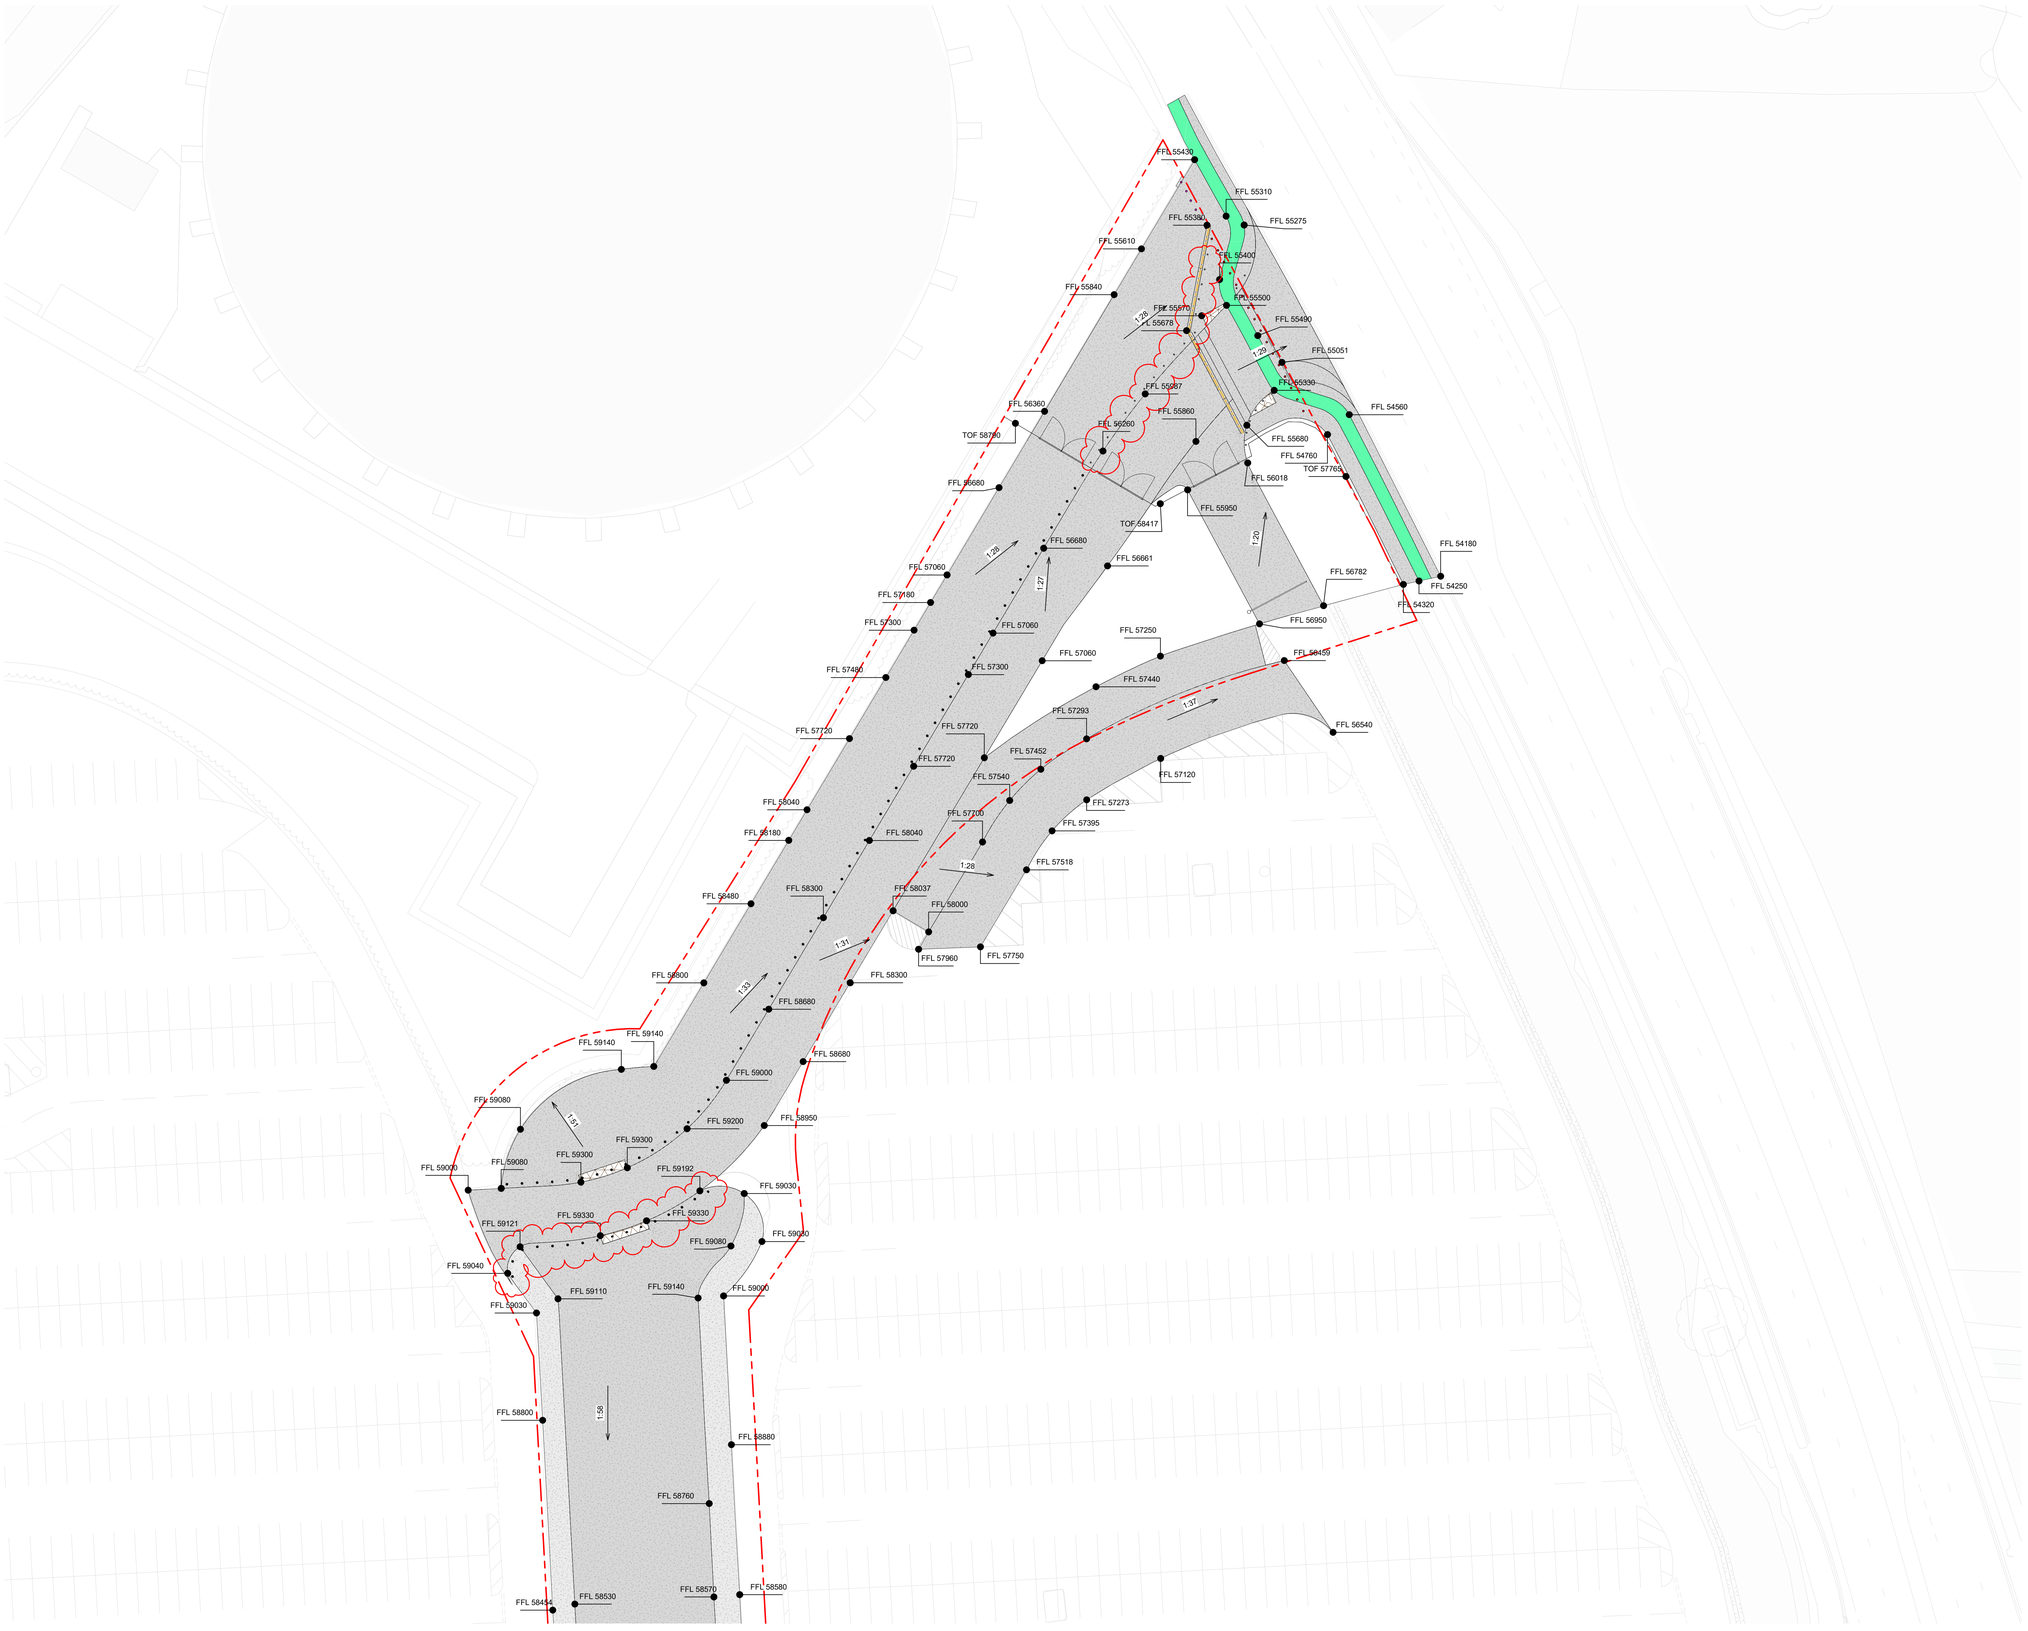


**Suitability Code (as defined in ISO 19650-2:2018)**

**Work in Progress (WIP)**
**S0** - Initial Status

**Shared (Non- Contractual)**
**S1** - Suitable for co-ordination
**S2** - Suitable for information
**S3** - Suitable for review & comment
**S4** - Suitable for stage approval
**S5** - Withdrawn
**S6** - Suitable for PIM authorisation
**S7** - Suitable for AIM authorisation

**Published (Contractual)**
**A1, A2, A3, Etc** - Authorised and accepted
**B1,B2,B3, Etc.** - Partial sign-off (with comments)

**Published (AIM Acceptance)**
**CR** - As constructed record document

KEY PLAN

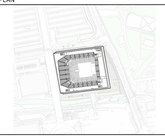

KEY

| | |
|---|---|
| | PLANNING APPLICATION BOUNDARY |
| | EXT-801 SLOT DRAINAGE TYPE 1 |
| | EXT-803 SLOT DRAINAGE TYPE 3 |
| | EXT-804 SLOT DRAINAGE TYPE 4 |
| | EXT-805 SLOT DRAINAGE TYPE 5 |
| | EXT-806 SLOT DRAINAGE TYPE 6 |
| FFL XX.XX | FINISH FLOOR LEVEL |
| TOB XX.XX | TOP OF BALUSTRADE |
| TOP XX.XX | TOP OF PLANTER |
| TOW XX.XX | TOP OF WALL |
| TOF XX.XX | TOP OF FENCE |
| 1 : XX | FALL |

THIS DRAWING IS ONLY TO SCALE IF IT IS REPRODUCED AT THE CORRECT PAPER SIZE

1:250@A0

0 5 10 20 m

ALL INTERNAL LAYOUTS AND USES ARE SHOWN FOR ILLUSTRATIVE PURPOSES ONLY AND ARE NOT FOR DETERMINATION

client

OVG INTERNATIONAL


© COPYRIGHT. ALL RIGHTS RESERVED

THIS WORK IS COPYRIGHT AND CANNOT BE REPRODUCED OR COPIED IN ANY FORM OR BY ANY OTHER MEANS GRAPHIC, ELECTRONIC OR MECHANICAL INCLUDING PHOTOCOPYING WITHOUT THE WRITTEN PERMISSION OF POPULOUS ANY LICENSE, EXPRESS OR IMPLIED, TO USE THIS DOCUMENT FOR ANY PURPOSE WHATSOEVER IS RESTRICTED TO THE TERMS OF THE AGREEMENT OR IMPLIED AGREEMENT BETWEEN POPULOUS AND THE INSTRUCTING PARTY.

USE FIGURED DIMENSIONS IN PREFERENCE TO SCALED. CHECK ALL DIMENSIONS ON SITE BEFORE FABRICATION OR SETTING OUT


architect

**POPULOUS®**


**14 BLADES COURT | DEODAR ROAD | LONDON | SW15 2NU | UNITED KINGDOM**
**TELEPHONE +44 (0)20 8874 7666 FACSIMILE +44 (0)20 8874 7470**



ALL PRODUCTION & INTELLECTUAL PROPERTY RIGHTS RESERVED © POPULOUS 2009


REVISIONS

| REV | DATE | DESCRIPTION |
|---|---|---|
| P00 | 30.10.2020 | STAGE 4A - INCREASE IN SCOPE TO PLANNING BOUNDARY |
| P01 | 30.04.2021 | STAGE 4B HARD LANDSCAPE WORKS OUTSIDE RED BOUNDARY |

project name

# Co-op Live

title NORTH JUNCTION
GRADING AND DRAINAGE PLAN
GROUND FLOOR

purpose of issue
STAGE 4A

| | | | | | |
|---|---|---|---|---|---|
| scale | 1 : 250 @ A0 | drawn | FP | Project no. | Suitability |
| date | 30.10.2020 | checked | TJ | 4933 | S4 |

project code originator volume level type role number rev.

reference **BRA-POP-ZZ-GF-DR-L-8135** P01