
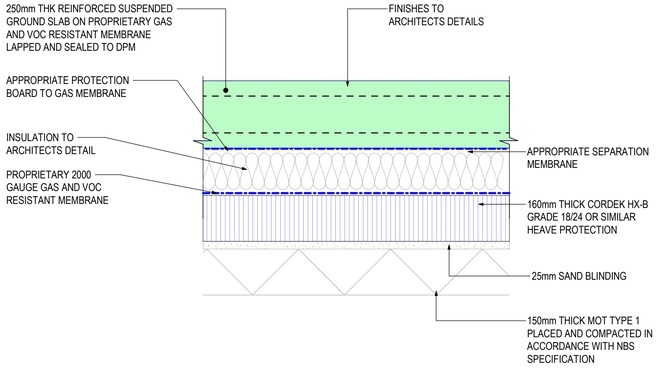



TYPICAL SUSPENDED GROUND SLAB DETAIL

(SCALE 1:10)

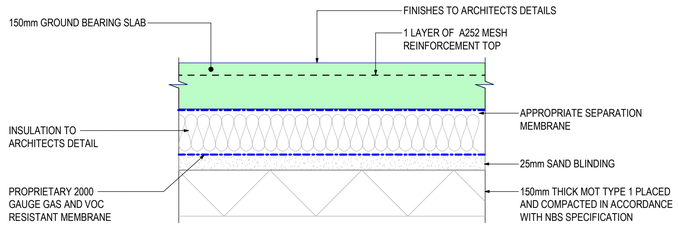


TYPICAL GROUND BEARING GROUND SLAB DETAIL

(SCALE 1:10)

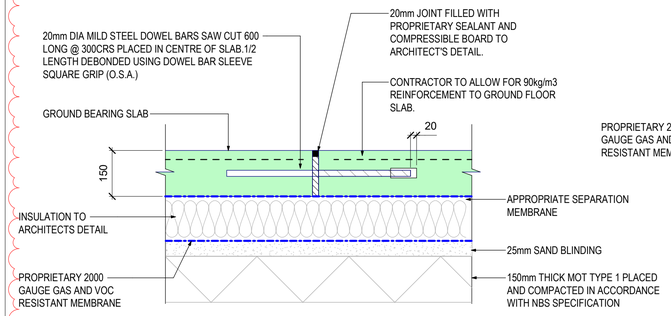


FORMED FREE MOVEMENT JOINT (F.F.M.J.)

(SCALE 1:10)

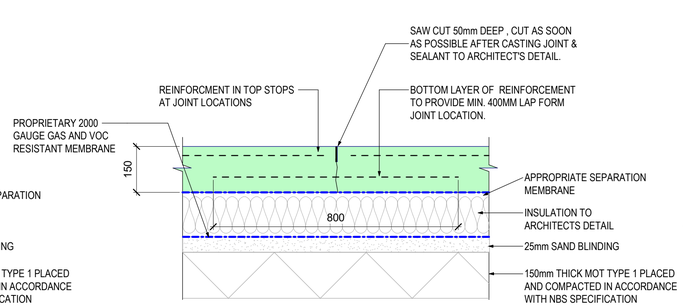


SAWN RESTRAINED MOVEMENT JOINT (S.R.S.J.)

(SCALE 1:10)

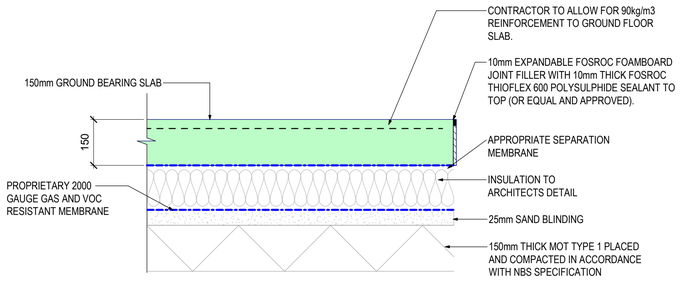


TYPICAL ISOLATION JOINT (I.J.)

(SCALE 1:10)

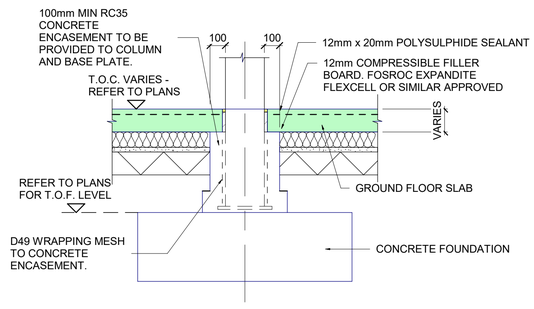

INTERNAL COLUMN TYPICAL SECTION A-A


(SCALE 1:20)

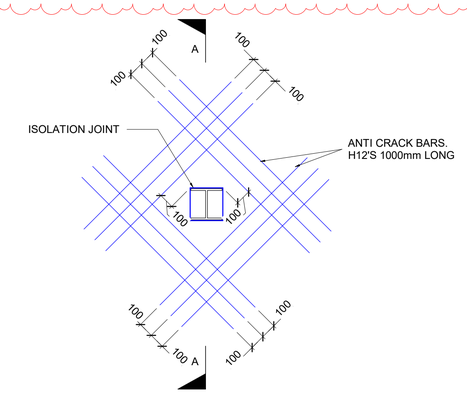

INTERNAL COLUMNS

TYPICAL CONCRETE ENCASEMENT DETAIL
COLUMNS AT NON JOINT INTERSECTION LOCATIONS


(SCALE 1:20)

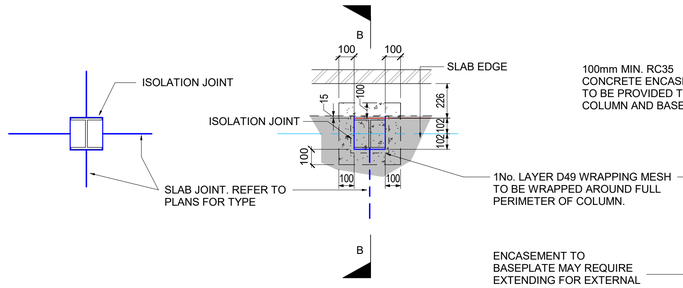

INTERNAL COLUMNS EXTERNAL COLUMNS

TYPICAL CONCRETE ENCASEMENT DETAIL TO
COLUMNS AT JOINT INTERSECTION LOCATIONS

(SCALE 1:20)

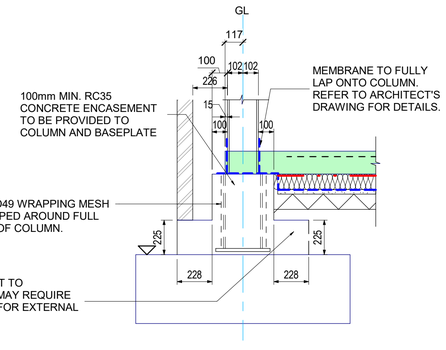

PERIMETER COLUMN TYPICAL SECTION B-B

(SCALE 1:20)

DISCLAIMER NOTES:

- THIS DOCUMENT IS COPYRIGHT OF THE ORIGINATOR AND MUST BE TREATED AS CONFIDENTIAL.
- THIS DOCUMENT MUST NOT BE ALTERED, REPRODUCED OR DISTRIBUTED WITHOUT PRIOR WRITTEN CONSENT OF THE ORIGINATOR
- THIS DOCUMENT MUST NOT BE ALTERED - THE ORIGINATOR ACCEPTS NO RESPONSIBILITY FOR ANY DISCREPANCIES ARISING AS A RESULT OF THE ORIGINATORS INFORMATION BEING ALTERED BY OTHERS
- ANY DISCREPANCY MUST BE REPORTED TO THE ORIGINATOR
- DO NOT SCALE THIS DOCUMENT - USE FIGURED DIMENSIONS ONLY
- ALL DIMENSIONS MUST BE CHECKED ON SITE PRIOR TO COMMENCEMENT OF ANY RELATED WORKS
- THIS DOCUMENT MUST BE READ IN CONJUNCTION WITH ALL SUPPORTING DOCUMENTS PRODUCED BY THE ORIGINATOR AND OTHER PROJECT DISCIPLINES
- THE ORIGINATOR ACCEPTS NO RESPONSIBILITY FOR THE ACCURACY OF BACKGROUND INFORMATION PRODUCED BY THIRD PARTIES - THIS MUST BE TREATED AS INDICATIVE ONLY
- USERS OF THIS DOCUMENT ARE RESPONSIBLE FOR CHECKING WHICH REVISION IS CURRENT
- THE DOCUMENT STATUS "INFORMATION" OR "PRELIMINARY", INDICATES THAT THIS DRAWING IS FOR REFERENCE PURPOSES ONLY - THE ORIGINATOR WILL ACCEPT NO RESPONSIBILITY FOR THE COMPLETENESS OF INFORMATION UNDER THIS STATUS
- THE DOCUMENT STATUS "RECORD" OR "AS BUILT" HAS BEEN PREPARED, IN PART, BASED UPON INFORMATION FURNISHED BY OTHERS. WHILE THIS INFORMATION IS BELIEVED TO BE RELIABLE, THE ORIGINATOR ASSUMES NO RESPONSIBILITY FOR THE ACCURACY OF THIS "RECORD" OR "AS BUILT" DOCUMENT OR FOR ANY ERRORS OR OMISSIONS THAT MAY HAVE BEEN INCORPORATED INTO IT AS A RESULT OF INCORRECT INFORMATION PROVIDED TO THE ORIGINATOR. THOSE RELYING ON THE "RECORD" OR "AS BUILT" DOCUMENT ARE ADVISED TO OBTAIN INDEPENDENT VERIFICATION OF ITS ACCURACY

DRAWING NOTES:

- CDM REGULATIONS 2015
  SIGNIFICANT OR NON-OBVIOUS RISKS AND RISKS WHICH ARE DIFFICULT TO MANAGE ARE IDENTIFIED ON THIS DRAWING USING THE FOLLOWING SYMBOL IDENTIFIED TO THE RIGHT WITH BRIEF ACCOMPANYING TEXT. FOR FURTHER DETAILS OF THE RISKS IDENTIFIED BY DESIGNERS, REFERENCE SHOULD BE MADE TO CDM HAZARD REGISTER.

REV	DESCRIPTION	DATE	BY	CHKD
P03	AMENDED AS CLOUDED	24/08/23	LG	NB
P02	VOC RESISTANT MEMBRANE NOTES	07/08/23	MR	NB
P01	ISSUED FOR INFORMATION	17/07/23	LG	NB

ORIGINATOR:

RIDGE

RIDGE PROJECT No: 5020683

CLIENT:
MANCHESTER CITY COUNCIL

IN ASSOCIATION WITH:
ISG CONSTRUCTION

PROJECT:
VARLEY STREET SCHOOL

TITLE:
GROUND FLOOR DETAILS

DRAWN BY: LG CHECKED BY: AB APPROVED BY: NB

SCALE: 1:20 @ A1 DATE: 14.07.2023

STATUS: S2 DESCRIPTION: FOR INFORMATION

DRAWING No: VAR - RDG - ZZ - 00 - DR - S - 00011

PROJECT:	ORIGINATOR:	FUNCTION:	SPATIAL:	FORM:	DISCIPLINE:	NUMBER:	REV:
VAR	RDG	ZZ	00	DR	S	00011	P03