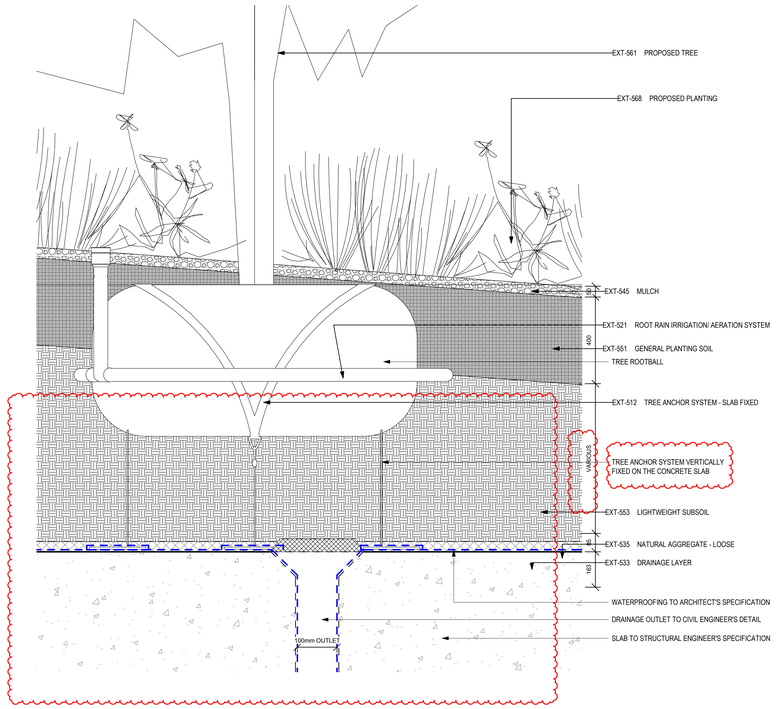

1 TYPICAL TREE DETAIL (LEVEL 01)
1 : 10

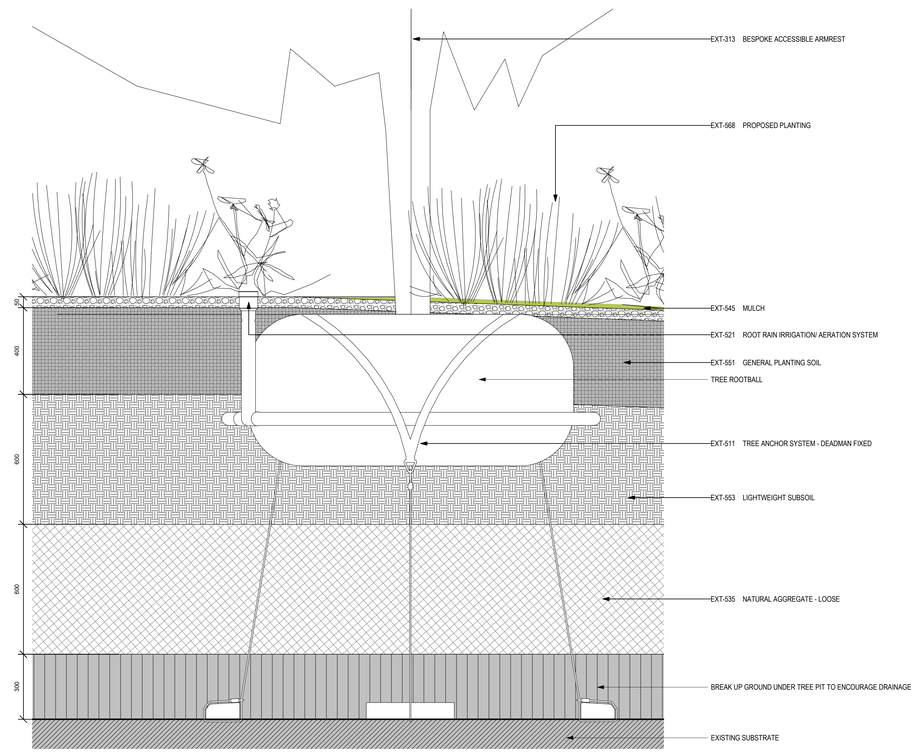

2 TYPICAL TREE DETAIL (GROUND FLOOR)
1 : 10

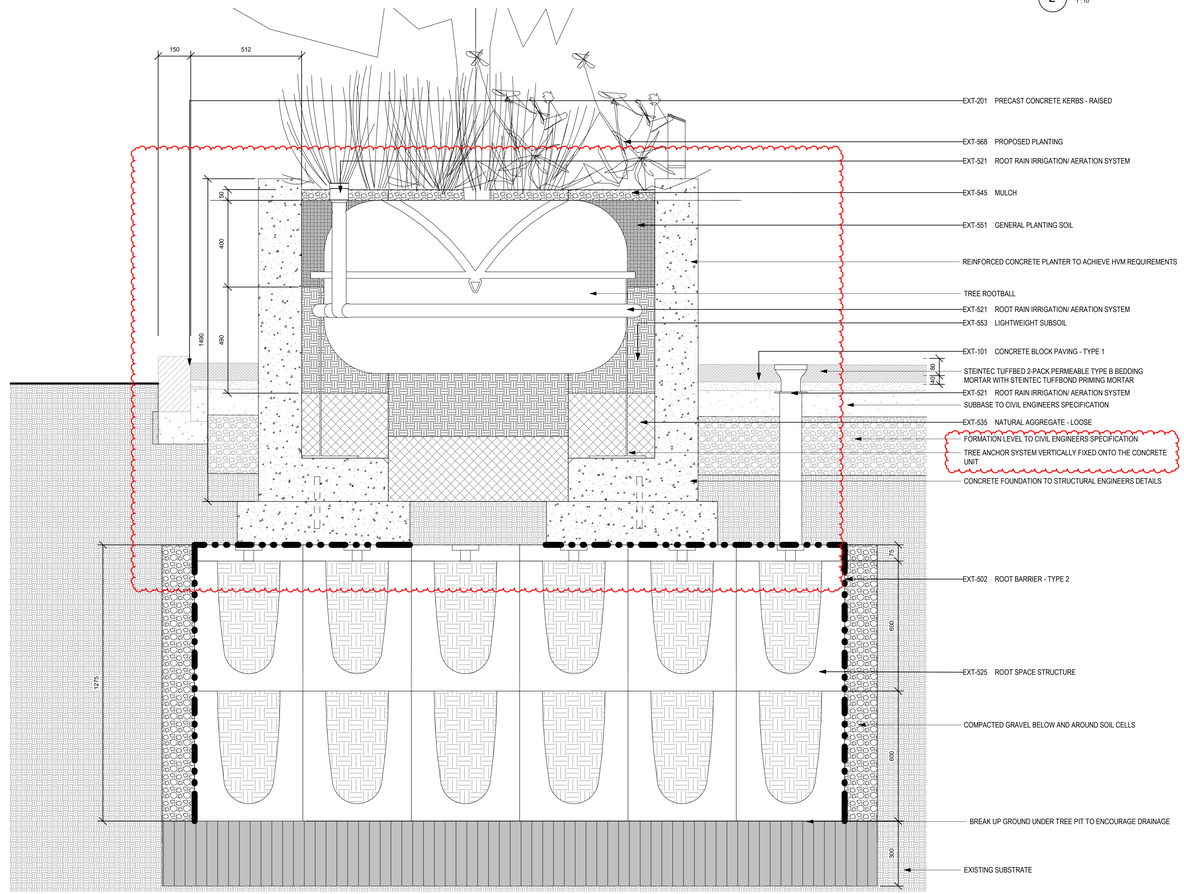

3 TYPICAL TREE DETAIL WITH TREE CELLS (SPORTCITY WAY)
1 : 10

Suitability Code (as defined in ISO 19650-2:2018)

Work in Progress (WIP)
S0 - Initial Status

Shared (Non- Contractual)
S1 - Suitable for co-ordination
S2 - Suitable for information
S3 - Suitable for review & comment
S4 - Suitable for stage approval
S5 - Withdrawn
S6 - Suitable for PIM authorisation
S7 - Suitable for AIM authorisation

Published (Contractual)
A1, A2, A3, Etc - Authorised and accepted
B1,B2,B3, Etc. - Partial sign-off (with comments)

Published (AIM Acceptance)
CR - As constructed record document

KEY PLAN

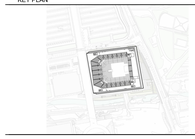

NOTES.

1. FOR SOFT LANDSCAPE ENLARGED PLANS REFER TO DRAWINGS
   BRA-POP-ZZ-GF-DR-L-8160
   BRA-POP-ZZ-01-DR-L-8161
   BRA-POP-ZZ-01-DR-L-8162
   BRA-POP-ZZ-GF-DR-L-8153
   BRA-POP-ZZ-01-DR-L-8164
   BRA-POP-ZZ-GF-DR-L-8183
2. FOR VERNTILATION TOWER SECTION REFER TO BRA-POP-XX-01-DR-A-4407
3. FOR PLANTING SCHEDULE REFER TO BRA-POP-ZZ-ZZ-SH-L-7801

THIS DRAWING IS ONLY TO SCALE IF IT IS REPRODUCED AT THE CORRECT PAPER SIZE

1:10@A0

0 0.1 0.2 0.3 0.4 0.8 m

ALL INTERNAL LAYOUTS AND USES ARE SHOWN FOR ILLUSTRATIVE PORPOSES ONLY AND ARE NOT FOR DETERMINATION

Safety, Health and Environmental Information

In addition to the hazards / risks normally associated with the types of work detailed on this drawing, note the following risks and information:

Construction	See risk register. No abnormal risks identified with this package of work

For information relating to Use, Cleaning and Maintenance see the Health and Safety File. It is assumed that all works will be carried out by a competant contractor working, where appropriate, to an approved method statement.

client

OVG INTERNATIONAL

© COPYRIGHT. ALL RIGHTS RESERVED

THIS WORK IS COPYRIGHT AND CANNOT BE REPRODUCED OR COPIED IN ANY FORM OR BY ANY OTHER MEANS (GRAPHIC, ELECTRONIC OR MECHANICAL INCLUDING PHOTOCOPYING) WITHOUT THE WRITTEN PERMISSION OF POPULOUS ANY LICENSE, EXPRESS OR IMPLIED, TO USE THIS WORK CANNOT BE TRANSFERRED EXCEPT AS PROVIDED FOR IN THE TERMS OF THE AGREEMENT OR IMPLIED AGREEMENT BETWEEN POPULOUS AND THE INTELLECTING PARTY

USE FIGURED DIMENSIONS IN PREFERENCE TO SCALED. CHECK ALL DIMENSIONS ON SITE BEFORE FABRICATION OR SETTING OUT

architect

POPULOUS®

14 BLADES COURT | DEODAR ROAD | LONDON | SW15 2NU | UNITED KINGDOM
TELEPHONE +44 (0)20 8874 7666 FACSIMILE +44 (0)20 8874 7470

ALL PRODUCTION & INTELLECTUAL PROPERTY RIGHTS RESERVED © POPULOUS 2009

REVISIONS

REV	DATE	DESCRIPTION
00	29.11.2019	DRAFT RIBA STAGE 3
01	14.04.2020	ISSUED FOR T1 DRAFT STAGE 4A
02	22.06.2020	ISSUED FOR T2 STAGE 4A
03	01.07.2021	STAGE 4B SOFT LANDSCAPE
C01	17.12.2021	SOFT LANDSCAPE PACKAGE ISSUED FOR CONSTRUCTION
C02	22.05.2023	PLANTERS UPDATE.

project name **Co-op Live**

title TYPICAL TREE PIT DETAILS

purpose of issue **CONSTRUCTION**

scale 1 : 10 @ A0 drawn FP Project no. Suitability
date 29/11/19 checked TJ 4933 **S3**

reference project code originator volume level type role number **BRA-POP-ZZ-ZZ-DR-L-8401** rev. **C02**