


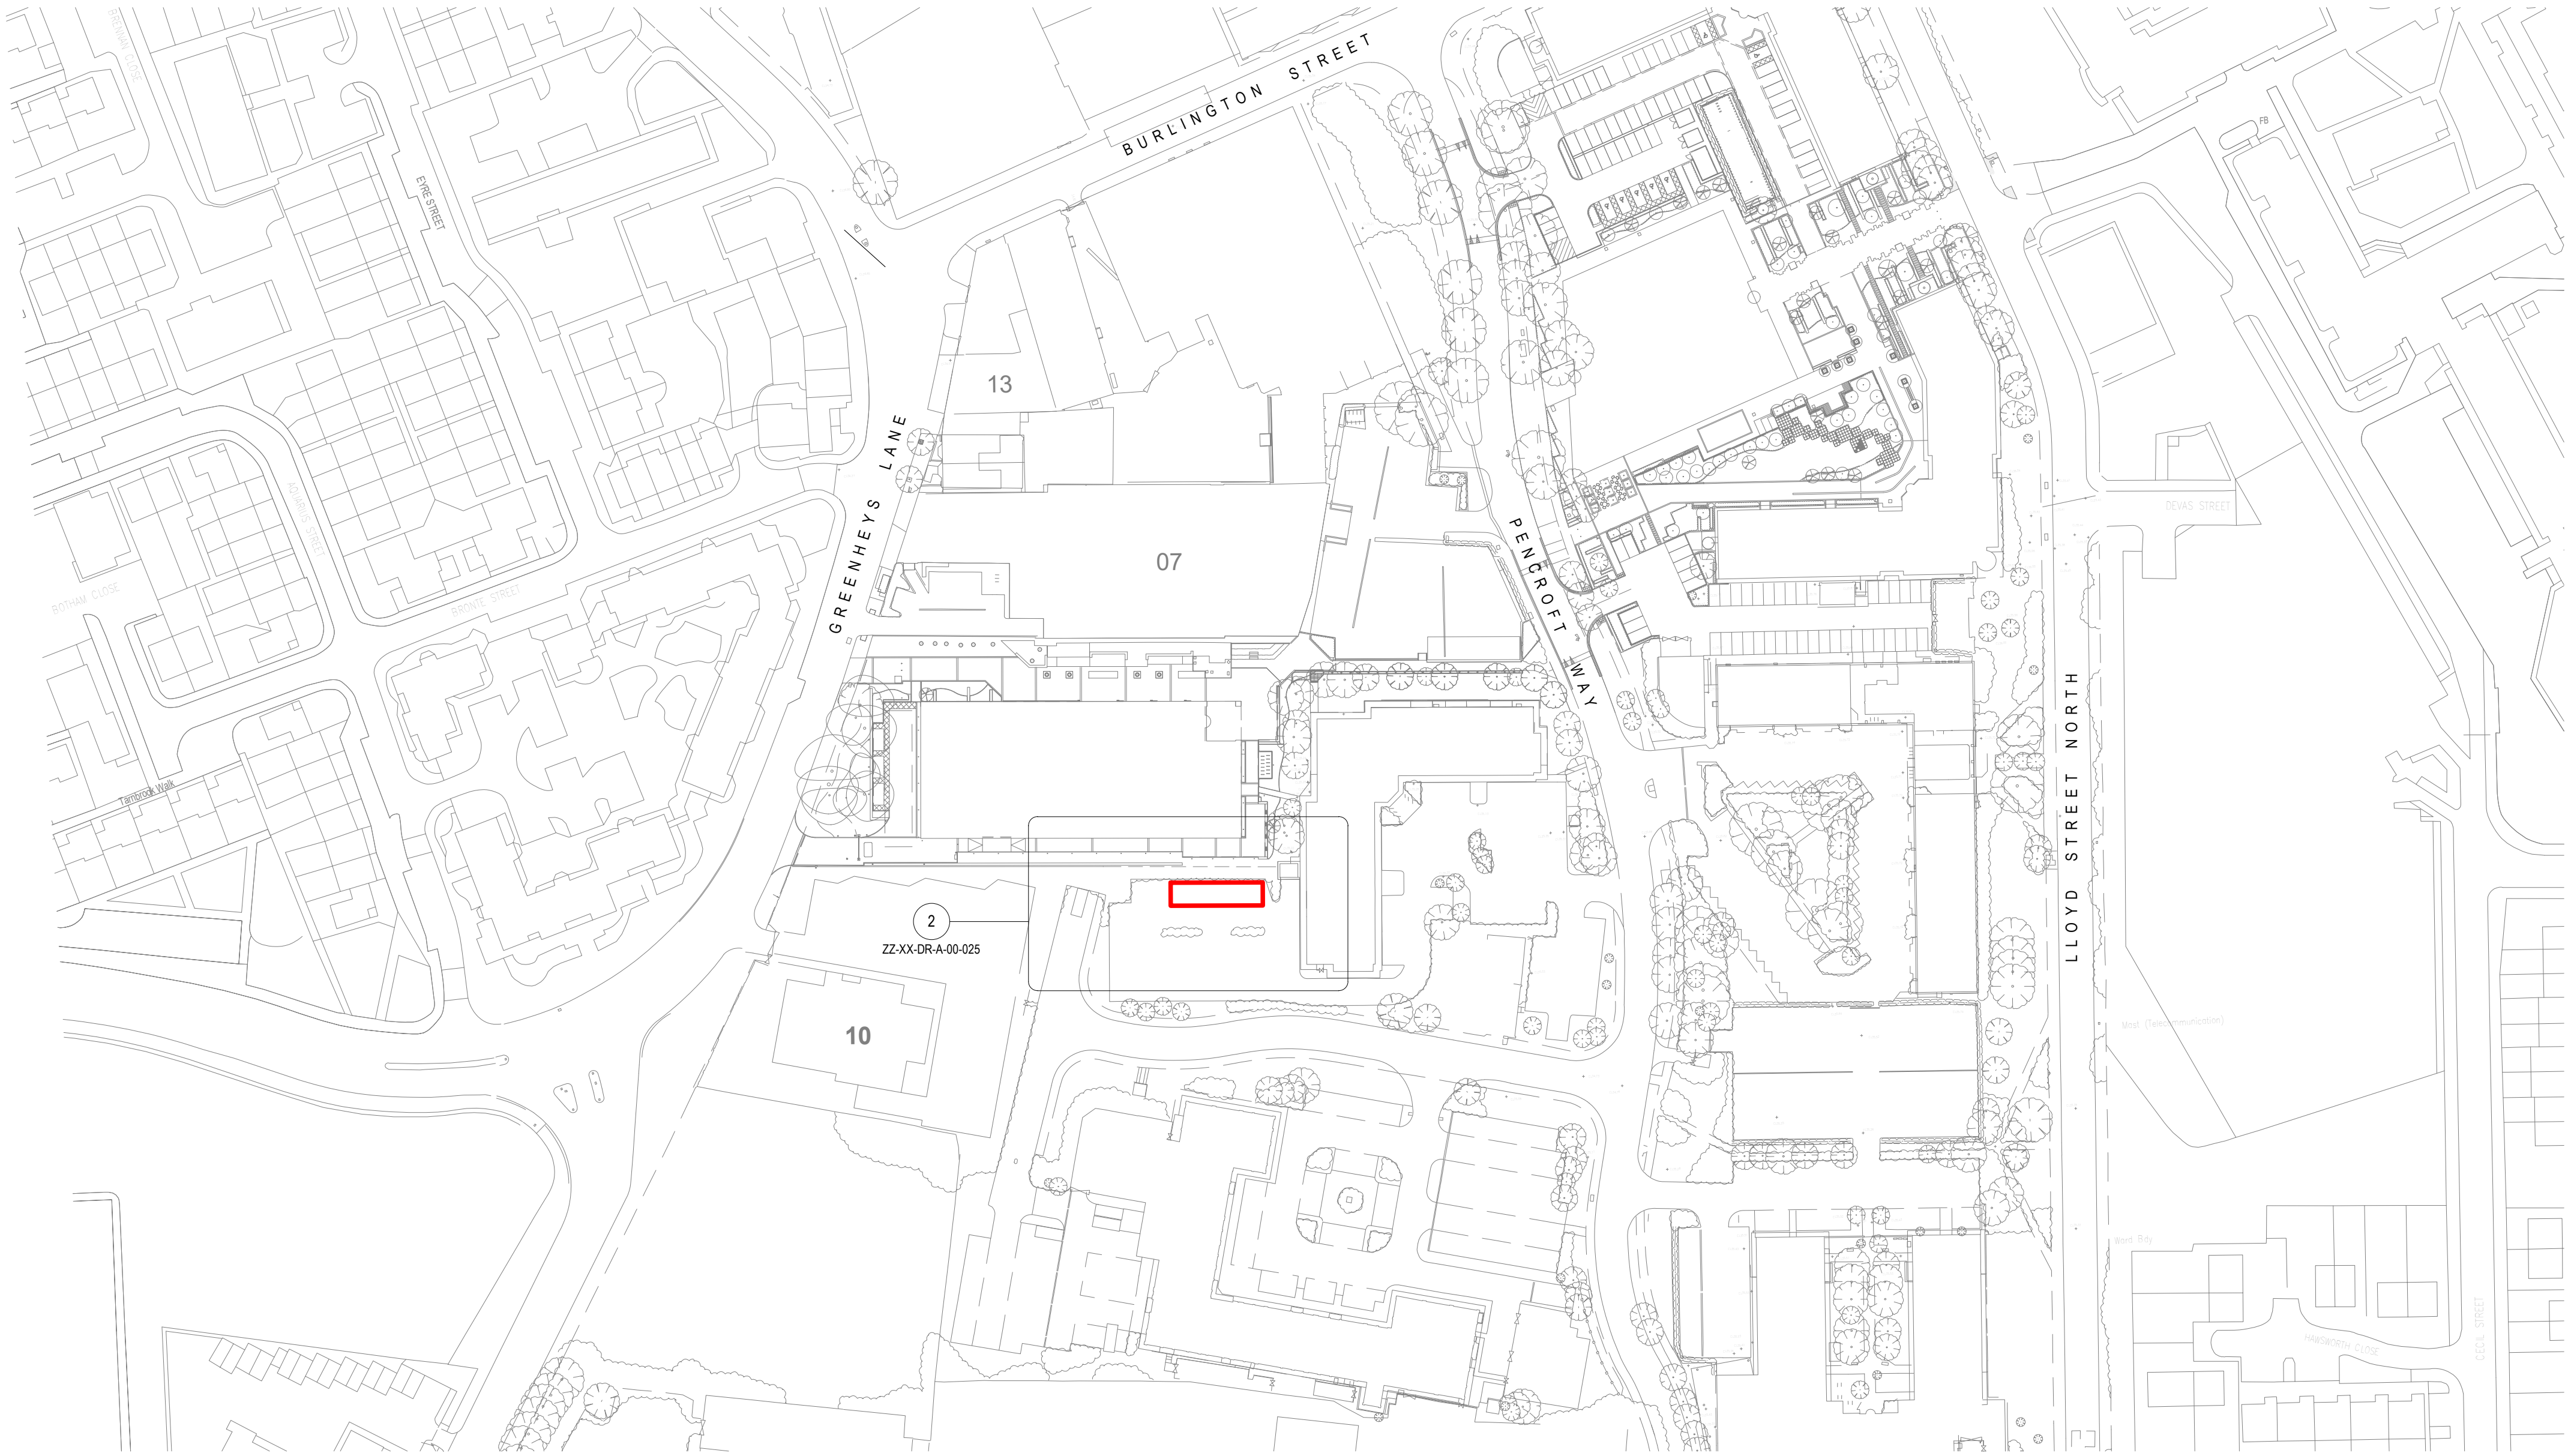


1

MSP - Relocated Cycle Store

1:1000

0m 10m 20m 30m 40m 50m

VISUAL SCALE 1:1000 @ A1

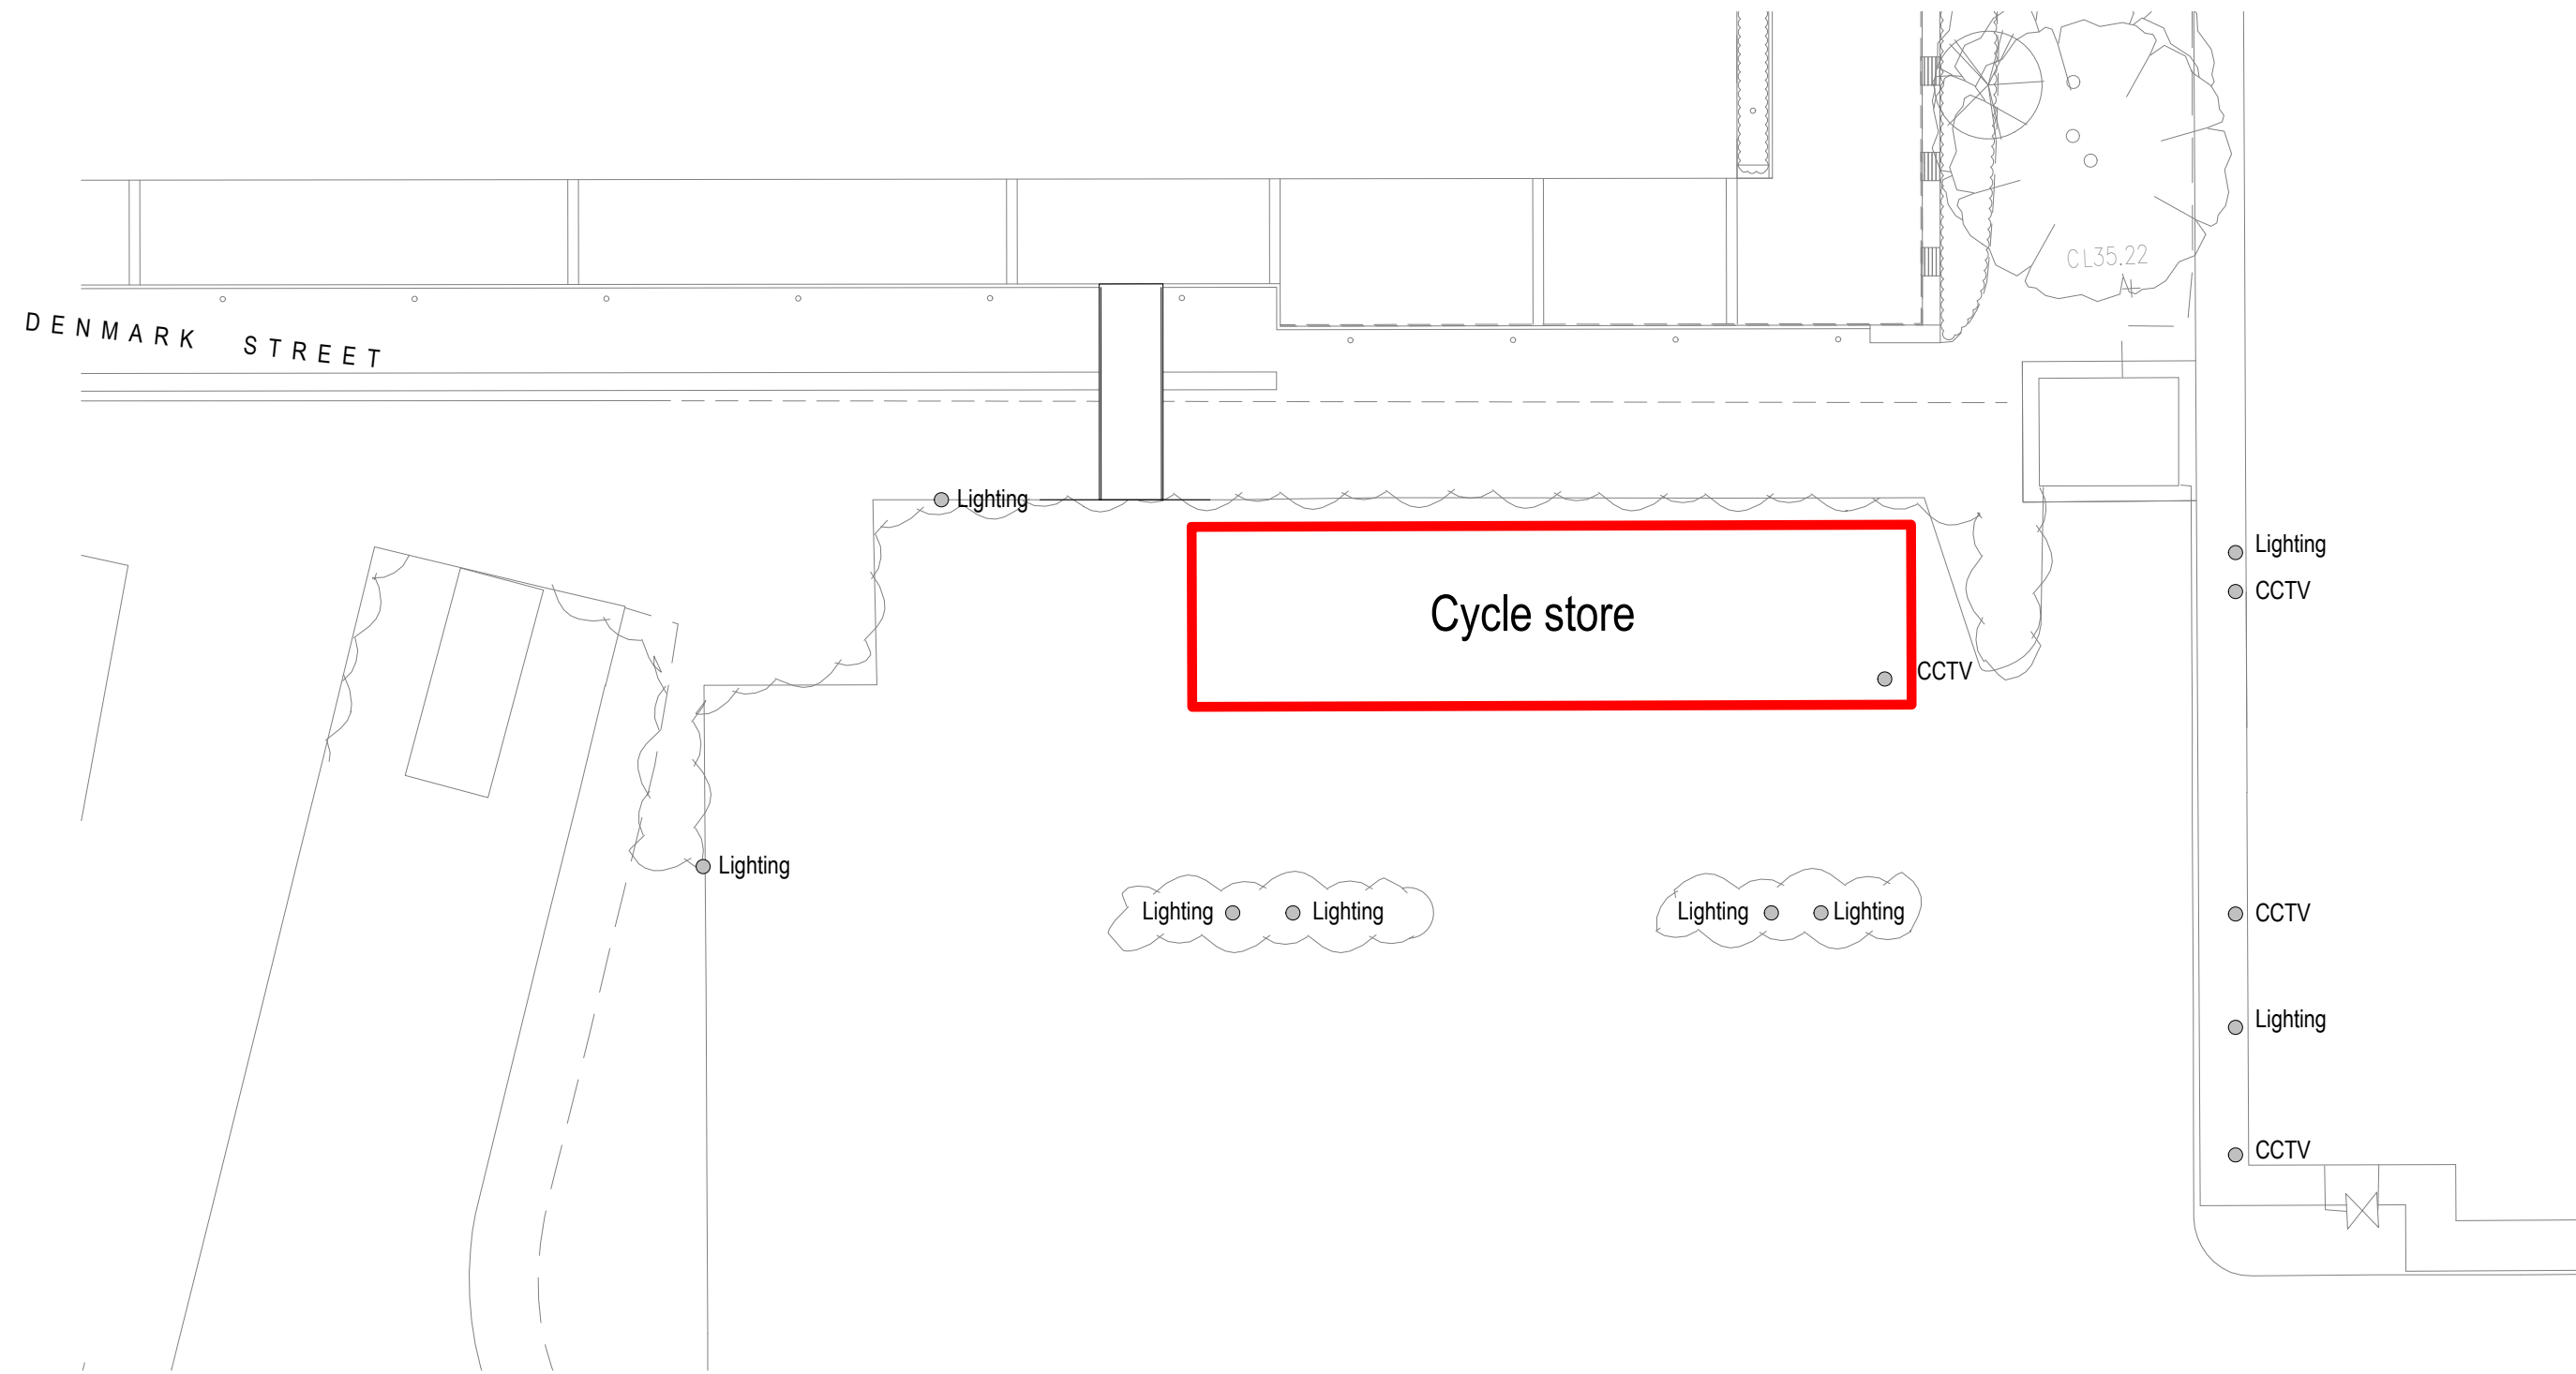

2

MSP - Relocated Cycle Store (Callout)

1:200

BUILDING DESIGN PARTNERSHIP SHALL HAVE NO RESPONSIBILITY FOR ANY USE MADE OF THIS DOCUMENT OTHER THAN FOR THAT WHICH IT WAS PREPARED AND ISSUED.
ALL DIMENSIONS SHOULD BE CHECKED ON SITE.
DO NOT SCALE FROM THIS DRAWING
ANY DRAWING ERRORS OR DIVERGENCIES SHOULD BE BROUGHT TO THE ATTENTION OF BUILDING DESIGN PARTNERSHIP AT THE ADDRESS SHOWN BELOW.
DRAWINGS SHALL BE READ IN CONJUNCTION WITH THE FOLLOWING BEFORE WORK COMMENCES:
• THE CDM DESIGN ISSUES REGISTER
• THE BOP RISK SERIES OF DRAWINGS
• THE PROJECT CDM RISK REGISTER

NOTES

Subject to design development, survey, consultant input & statutory approval.

P02	General update	PE	PE	27.10.23
P01	First Issue	PE	PE	03.10.23

REVISION	DESCRIPTION	DRAWN	CHECKED	DATE
----------	-------------	-------	---------	------

REVISION

CLIENT



BDP.

11 Ducie Street
PO Box 85
Piccadilly Basin
Manchester
M60 3JA
United Kingdom
T +44 (0)161 828 2200
www.bdp.com

PROJECT TITLE
MSP Greenheys (Private & Confidential)

REF: 00000000
P3001624

DRAWING TITLE
Proposed Cycle Parking Red Line

SCALE
As indicated

DATE FIRST ISSUED
Oct 2023

DRAWING NO.
GRE-BDP-ZZ-XX-DR-A-00-025

REVISION
P02