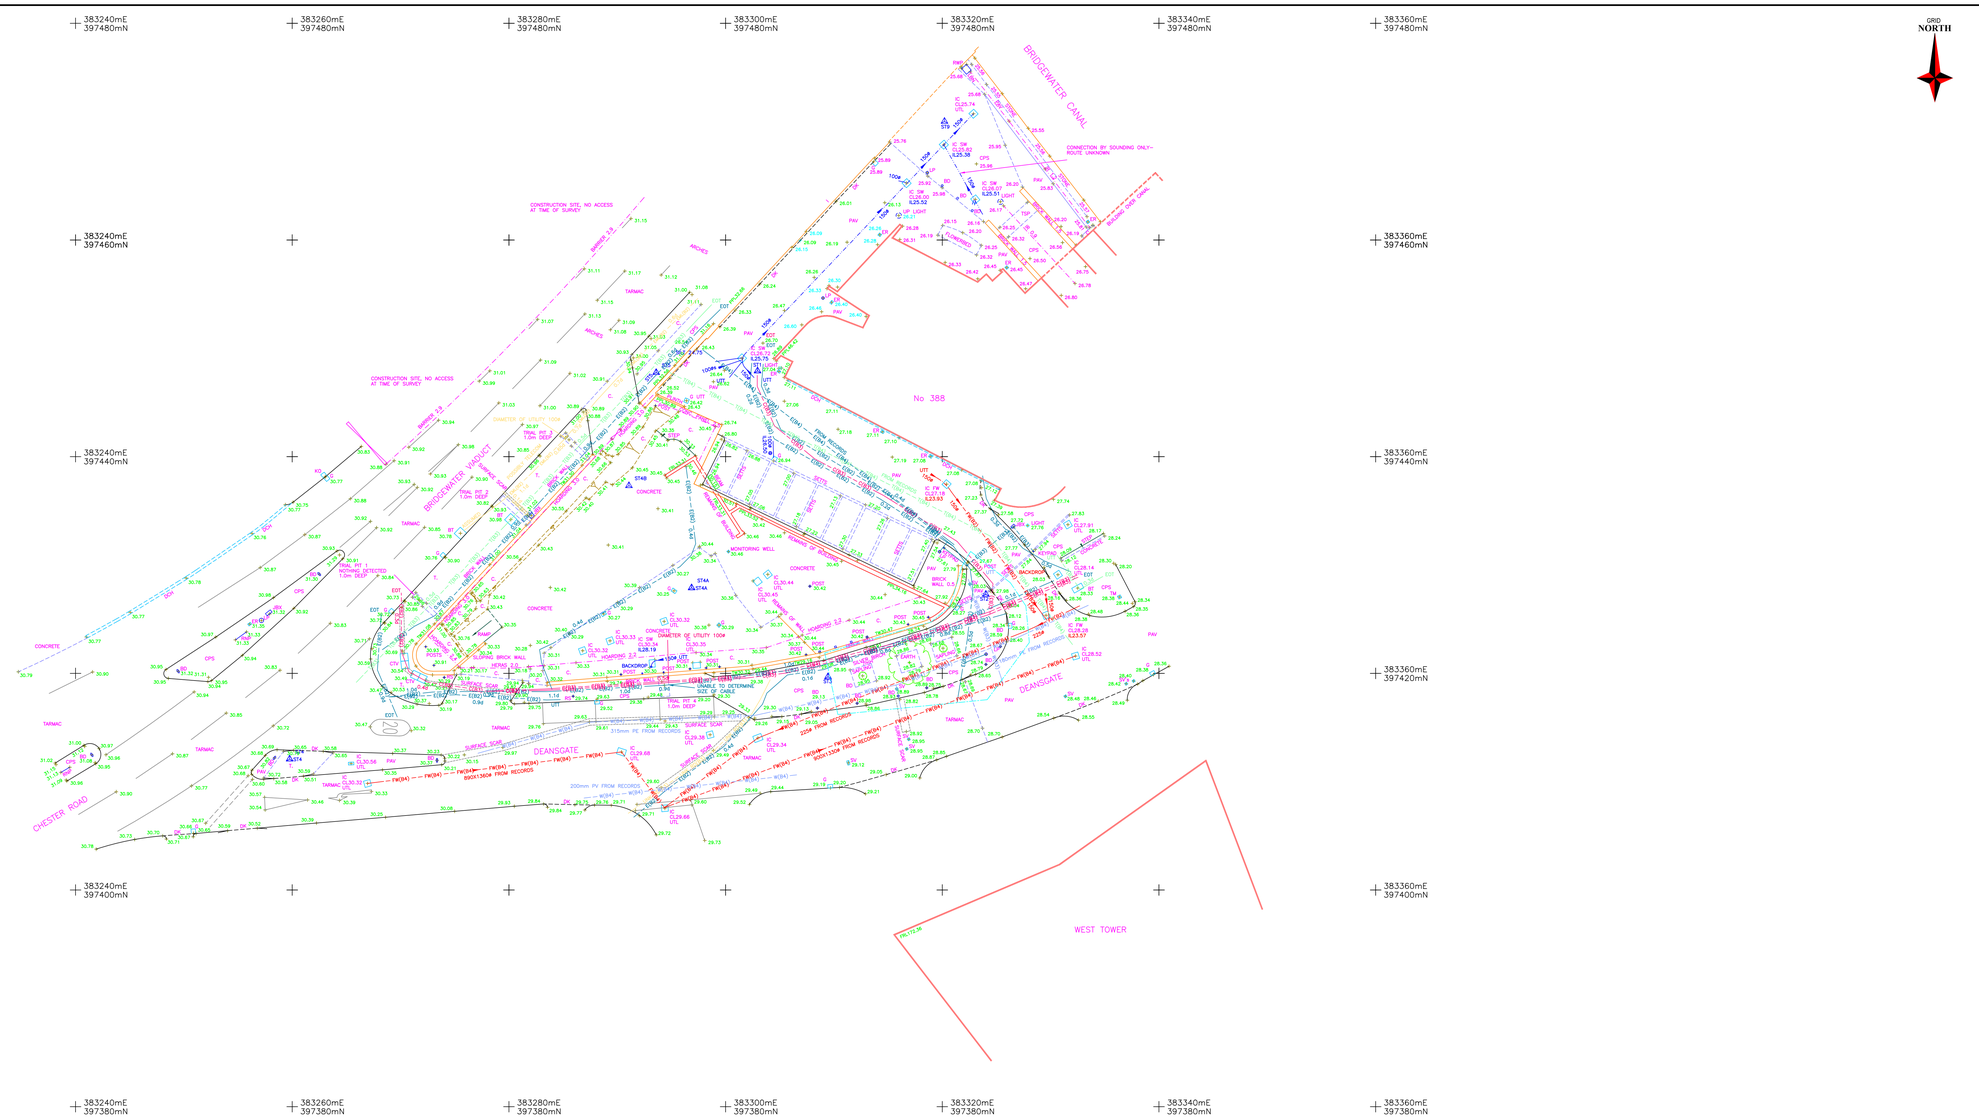


Original Drawing Size: A0

NOTES:-
The accuracy and content of this drawing are dependent on the original specification and EDI should be consulted before use of other scales.

Whilst all reasonable care to record as-built services data has been taken within the limits of the original specification and inquiries made, before use of this information the user should consult EDI and satisfy themselves of the completeness and accuracy of such detail before undertaking any works. Due to the nature of this work and limitations imposed by ground conditions and the detection equipment no guarantee can be given that all services have been recorded. Trial holes should be dug at critical locations.

An invisible service has been taken in the survey detail represented on this drawing but any services may exist which have not been found.

Our aim is to produce the best possible results within the specification and cost constraints of our clients. Any comments are most welcome.

Levels shown at kerbs are channel level unless stated.

LEGEND

Features:
AB Air Brick
ACU Air Conditioning Unit
AV Air Valve
BH Bollard
BH Borehole
BP Boundary Post
BT Bench Mark
BT British Telecom
CL Cover Level
CP Capstan
CTV Cable TV Cover
DCH Drainage Channel
DF Disabled Fountain
DIS Disused
DK Drop Kerb
EC Electricity Cut Off
EC Electricity IC
EJ Expansion Joint
FB Flower Bed
FB Flower Bed
FH Fire Hydrant
FR Fire Hose Reel
FS Flagstaff
GV Gas Valve
HH Hatchpit
HH Hatchpit
IC Inspection Cover
IL Invert Level
JBX Junction Box
KO Kerb Outlet
LB Letter Box
LBN Litter Bin
LLP Low Level LP
LP Lamp Post
MP Marker Post
OHL Overhead Line
PC Pedestrian Crossing
PM Parking Meter
PP Power Pole
RAD Radiator
RE Rodding Eye
RIS Road Name Plate
RS Road Sign
RSD Roller Shutter Door
SCP Soil Vent Pipe
SD Service Duct
SV Stop Valve
TBX Telephone Call Box
TCL Trivalent Level
TP Telegraph Pole
TRP Traffic Light
TW Top of Wall
UD Universal Beam
UP Universal Pier
UT Utility
UTL Unable To Lift
VP Vent Pipe
WM Water Meter
WP Weep Hole
WSP Waste Pipe
VSB Vehicle Safety Barrier

Building Level Details:
D Door
FL Floor Level
FFL Floor Level
FRL Flat Roof Level
PAV Pavement
PTL Parapet Level
RL Ridge Level
SL Sill Level
SP Springer of Arch
TA Top of Arch
W Window
EAVES Ceiling/Beam Soffit

Boundary Types:
BW Barbed Wire
BW Brick Wall
CB Close Boarded
CI Chain Link
CI Corrugated Iron
CP Chestnut Paling
GR Guard Rail
IR Iron Railing
IW Interwoven
PA Post & Rail
PAL Palisade
PI Picket
PR Post & Rail
PW Post & Wire
TKR Timber Knee Rail
WF Wire Fence
WMF Wire Mesh Fence

Surfaces & Finishes:
B Brickwork
BL Blue Brick
C Concrete
CLT Ceiling Tiles
CP Carpet
CPS Concrete Paving Slabs
CPT Carpet Tiles
CT Ceramic Powder
CT Ceramic Tiles
FT Floor Tiles
L Linoleum
L Linoleum
P Plaster
PT Plaster Mortars
S Steel work
T Terrazzo
TPP Tarmac Safety Paving
VT Vinyl Tiles

Building
Overhead Building Detail
Wall
Tree
Kerb/Drop Kerb
Survey Station
Fence
Gate
Painted Road Markings
Edge of Vegetation
Banks

Utilities
(CATV) CATV Cables
(ELEC) Electricity Cables
(FUEL) Fuel Pipes
(GAS) Gas Pipes
(SERV) Service ducts
(TRAFFIC) Traffic Control
(UNKNOWN) Unidentified GPR
(WATER) Water pipes
Overhead Lines
TFR Token From Records
(CCTV) CCTV Cables
(FIBRE) Fibre Optic
(FOUL) Foul Water Drain
(SEWER) Sewer Pipes
(STORM) Storm water drain
(TELE) Telecom cables
(UNKNOWN) Unidentified EML
(UNKNOWN) Unidentified Trace
EOT End Of Trace
UTT Unable To Trace
NPV No Pipes Visible
Extent of utility survey
100# Pipe Diameter/Flow

Control: All levels and co-ordinates are related to the datums described.
The horizontal control of this survey is based on Ordnance Survey grid as translated from GPS coordinates using Leica's SmartNet service. We have applied a reverse scale factor to the ground coordinates to convert them to grid values. The vertical control of this survey is based on OS datum as translated from GPS coordinates using the OSGM15 transformation as supplied by the OS. This may differ from the existing OS benchmarks in the area which should be disregarded; all levels should be taken from EDI survey stations.

This survey has been carried out to PAS 128 Detection Method M2: EML, search transects at 5m intervals and 2m for GPR.

Utility Depths:-
Depths obtained by EML are to the centre of the utility
Depths obtained by GPR are to the top of the utility
All depths are shown in metres in the format 0.76

Utility Confidence Levels:-
(E) Electricity equipment position verified visually
(Accuracy: Horizontal (±25mm) Vertical(±50mm)
(81) Horizontal and vertical position detected by multiple methods
(Estimated Accuracy: ±150mm OR ±10% of detected depth)
(82) Horizontal and vertical position detected by a single method
(Estimated Accuracy: ±150mm OR ±10% of detected depth)
(83) Horizontal position detected by a single method
(Estimated Accuracy: ±500mm in the Horizontal - Depth is undefined)
(84) A utility segment which is suspected to exist but has not been detected and is therefore shown as an assumed route
(91) Position of manhole, pit, marker post or other fixed feature related to visual indications and surface features (accuracy undefined)
(0) Route transcribed from utility asset plans (accuracy undefined)

Station Schedule

Station	Easting	Northing	Level	Type
1	383324.186	397477.344	25.768	HUB Nail
2	383324.219	397427.253	28.068	HUB Nail
3	383309.447	397419.879	29.078	HUB Nail
4	383259.756	397417.085	31.879	Road Nail
5	383253.590	397462.226	31.491	HUB Nail
6	383323.892	397482.245	31.261	HUB Nail
7	383348.891	397530.077	31.910	HUB Nail
4A	383348.808	397427.889	30.298	HUB Nail
9	383330.200	397470.948	25.749	HUB Nail

Rev.	Job No.	Date	Revision Detail	Surveyor	Chkd
C	21511	09/23	Trial Pits update	AR	RA
B	21511	09/23	Buried Utilities Recording of 3 Trial Pits	AK	LW
A	20755	09/22	Additional levels and survey extension	LF	TA

CLIENT
Fusion Manchester Devco Ltd
1st Floor
506 Centennial Park
Elstree
WD6 3FG

PROJECT
Topographic & Utilities Survey
Deansgate
Manchester
M3 4LB

Job No.	Surveyor	Checked	Date	Scale
19147	T.Cosgrove	AR	Nov. 2020	1:200

EDI SURVEYS LTD
163-165 Ranelagh Road, Ipswich, Suffolk IP2 0AH
Telephone | 01473 211222 Fax | 01473 221660
Email | enquiries@edisurveys.co.uk
Our Services:- Topographic Surveys, Measured Building Surveys, GPS Surveying and Control, 3D laser Scanning, Utility Surveying and Drainage Investigation.
Click the link below to visit our website and find out more.
www.edisurveys.co.uk

DRAWING No. 19147/T/01-01
REV. C