


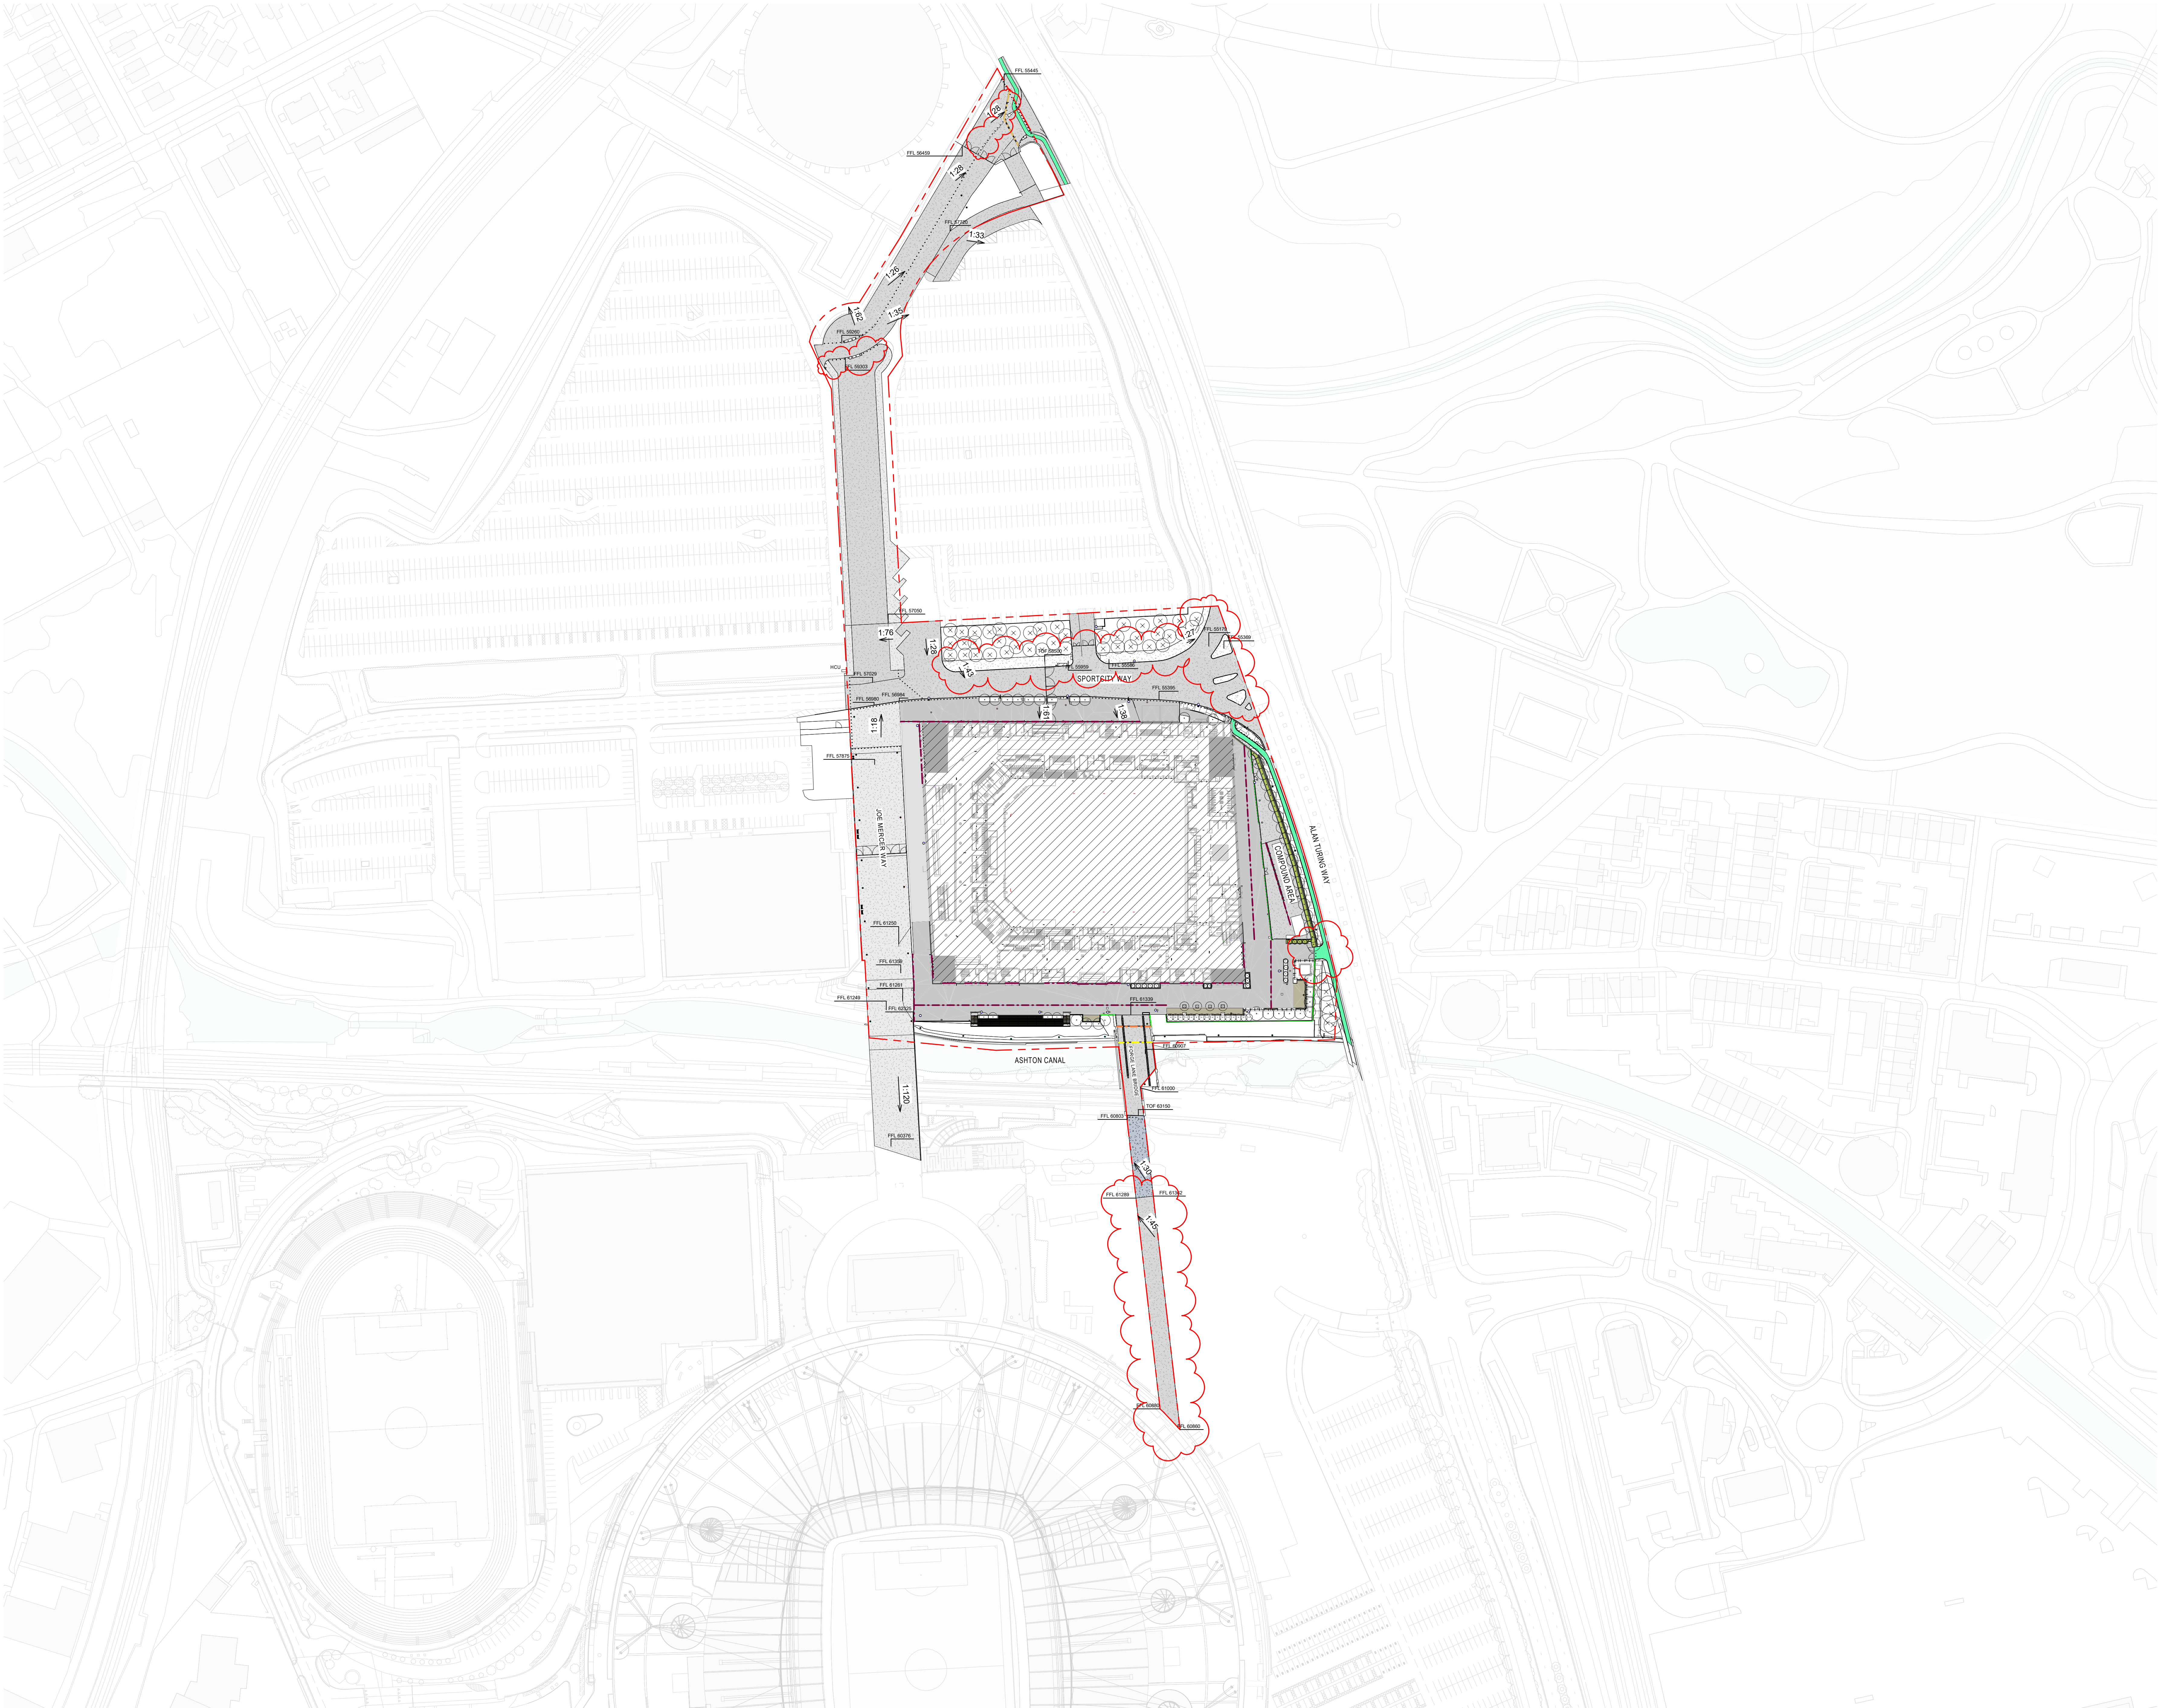

Suitability Code (as defined in ISO 19650-2:2018)

Work in Progress (WIP)

S0 - Initial Status

Shared (Non-Contractual)

S1 - Suitable for co-ordination

S2 - Suitable for information

S3 - Suitable for review & comment

S4 - Suitable for sign-off

S5 - Withdrawn

S6 - Suitable for FIM authorisation

S7 - Suitable for AIA authorisation

Published (Contractual)


A1, A2, A3, Etc - Authorised and accepted

B1, B2, B3, Etc - Partial sign-off (with comments)

Published (AIM Acceptance)

CR - As constructed record document

KEY PLAN

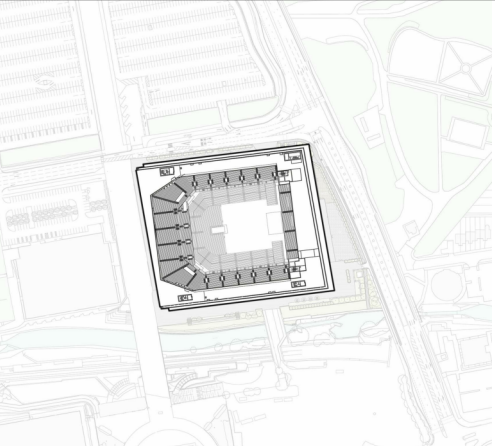

KEY

- PLANNING APPLICATION BOUNDARY
- EXT-801 SLOT DRAINAGE TYPE 1
- EXT-803 SLOT DRAINAGE TYPE 3
- EXT-804 SLOT DRAINAGE TYPE 4
- EXT-805 SLOT DRAINAGE TYPE 5
- EXT-806 SLOT DRAINAGE TYPE 6
- FFL XXX.XX FINISH FLOOR LEVEL
- TOB XXX.XX TOP OF BALUSTRADE
- TOP XXX.XX TOP OF PLANTER
- TOW XXX.XX TOP OF WALL
- TOF XXX.XX TOP OF FENCE
- 1:XX FALL

THIS DRAWING IS ONLY TO SCALE IF IT IS REPRODUCED AT THE CORRECT PAPER SIZE

1:1000@A0



ALL INTERNAL LAYOUTS AND USES ARE SHOWN FOR ILLUSTRATIVE PURPOSES ONLY AND ARE NOT FOR DETERMINATION

client



© COPYRIGHT. ALL RIGHTS RESERVED

THIS WORK IS COPYRIGHTED AND CANNOT BE REPRODUCED OR COPIED IN ANY FORM OR BY ANY MEANS WITHOUT THE WRITTEN PERMISSION OF POPULOUS. ANY UNLAWFUL REPRODUCTION OR USE OF THIS DOCUMENT OR ANY PARTS THEREOF WITHOUT THE WRITTEN PERMISSION OF POPULOUS IS PROHIBITED. THE USER OF THIS DOCUMENT AGREES TO HOLD POPULOUS HARMLESS FROM AND AGAINST ALL CLAIMS, DAMAGES, LOSSES AND EXPENSES, INCLUDING REASONABLE ATTORNEY'S FEES, ARISING OUT OF OR IN CONNECTION WITH THE USE OF THIS DOCUMENT.

USE DIMENSIONS IN PREFERENCE TO SCALES. CHECK ALL DIMENSIONS ON SITE BEFORE FABRICATION OR SETTING OUT.

author

POPULOUS®

14 BLADES COURT | DEodar ROAD | LONDON | SW15 2NU | UNITED KINGDOM
TELEPHONE +44 (0)20 874 7665 FACSIMILE +44 (0)20 874 7470
ALL PRODUCTION & INTELLECTUAL PROPERTY RIGHTS RESERVED © POPULOUS 2009

REVISIONS


REV	DATE	DESCRIPTION
P00	04.09.2020	STAGE 3
P01	30.10.2020	STAGE 4A - INCREASE IN SCOPE TO PLANNING BOUNDARY
P02	30.04.2021	STAGE 4B - HARD LANDSCAPE WORKS OUTSIDE RED BOUNDARY

project name

Co-op Live

the LANDSCAPE SITE

GRADING AND DRAINAGE PLAN

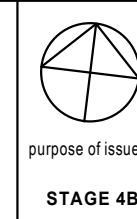

portion of team

STAGE 4B

scale 1:1000 @ A0 down FP Project no. 4933 Suitability S3

date 04.09.2020 checked TJ

project code original volume level type role number

reference BRA-POP-ZZ-ZZ-DR-L-8005 P02