
Two new condenser units (shown in red dotted lines) proposed to be hidden behind existing plant enclosure screen. No change proposed to the appearance of the existing enclosure.

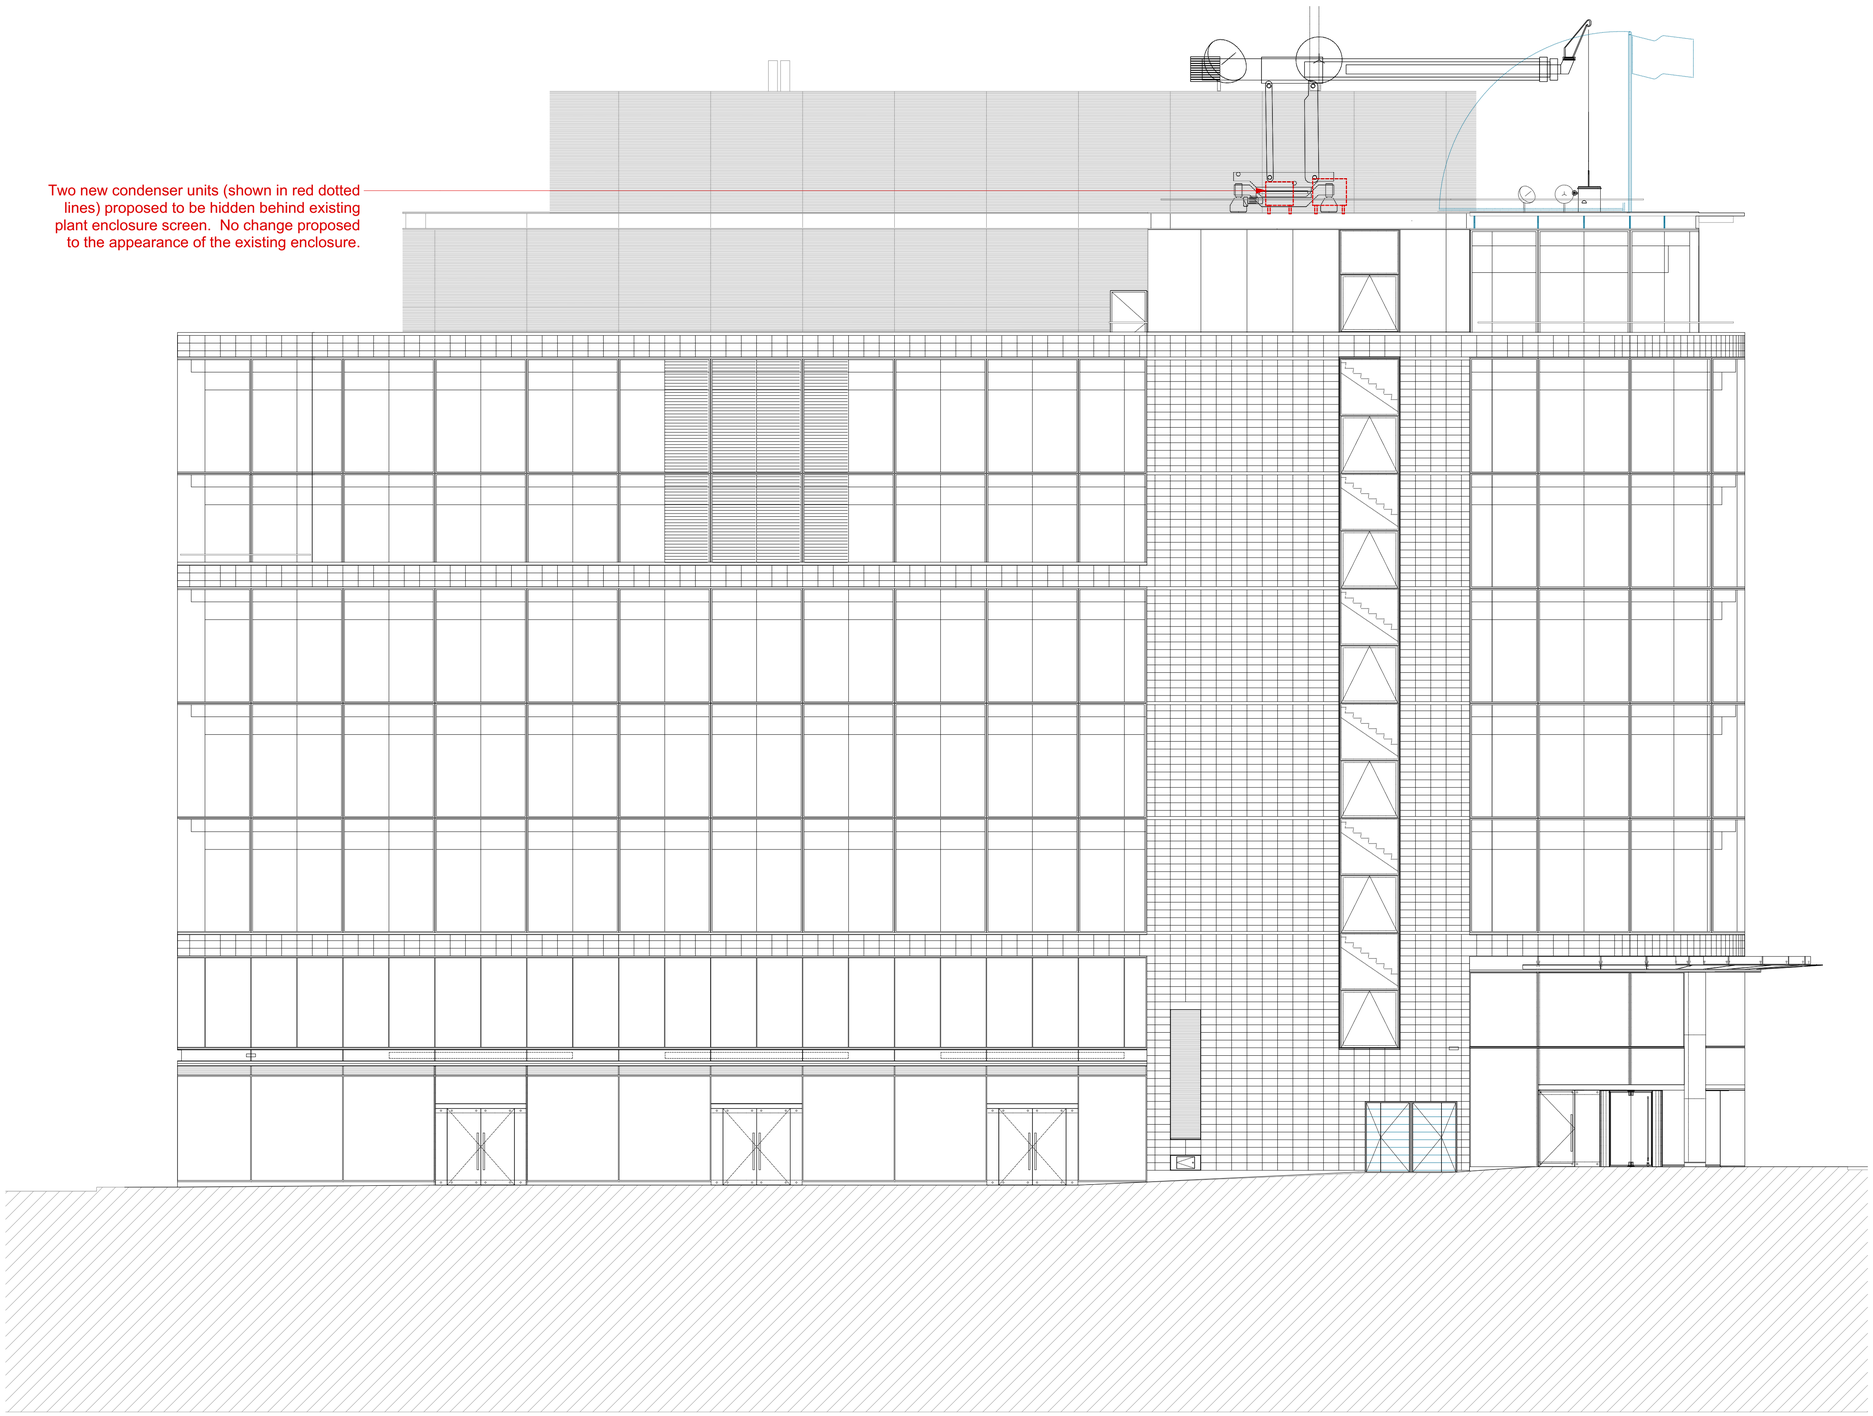

Proposed East Elevation 1:100@A1

0 100

Scale bar 100mm at 1:1

GENERAL NOTES:

EGG LIMITED SHALL HAVE NO RESPONSIBILITY FOR ANY USE MADE OF THIS DOCUMENT OTHER THAN FOR THAT WHICH IT WAS PREPARED AND ISSUED.


DO NOT SCALE FROM THIS DRAWING.

ALL DIMENSIONS AND LEVELS ARE TO BE CHECKED ON SITE.
ALL DISCREPANCIES, ERRORS AND OMISSIONS TO BE REPORTED IMMEDIATELY TO EGG LIMITED

ALL BUILDING WORKS TO BE IN ACCORDANCE WITH CURRENT STATUTORY REGULATIONS INCLUDING BUILDING REGULATIONS AND BRITISH STANDARDS/CODES OF PRACTICE.

THIS DRAWING AS BEEN PRODUCED FOR THE SPECIFIC PROJECT AND CLIENT NOTED IN THE TITLE BLOCK AND IS NOT INTENDED FOR USE BY ANY OTHER PERSON OR FOR ANY OTHER PURPOSE.

© EGG LIMITED, 27 THE AMBITION BROXBOURNE BUSINESS CENTRE PINDAR ROAD, HODDESDON, HERTFORDSHIRE, EN11 0FJ

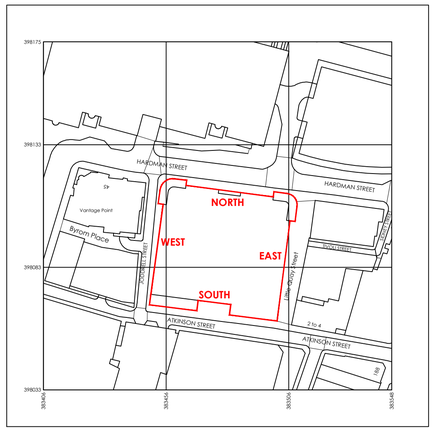

Produced on 26 March 2021 from the Ordnance Survey National Geographic Database and incorporating surveyed revision available at this date.
This map shows the area bounded by 383406 398033,383548 398033,383548 398175,383406 398175 383406 398033
Reproduction in whole or part is prohibited without the prior permission of Ordnance Survey.
Crown copyright 2021. Supplied by copia ltd trading as UKPlanningMaps.com a licensed Ordnance Survey partner (100054135).
Data licence expires 26 March 2022. Unique plan reference: v2c/601155/813394

10 0 10 20 30 40 50 meters

Site Location Plan 1:1250@A1

Rev	Date	Amendment
-	18.08.2023	Issued for Planning Application

Drawing Status

PLANNING

Project Title

Manchester

Client

Page Group

egg DESIGN

27 The Ambition Broxbourne
Business Centre, Pindar Road
Hoddesdon, EN11 0FJ
tel: 01279 217 389
www.egglimited.co.uk
email: info@egglimited.co.uk

Scale @ A1	1:100	Date	17-08-2023
Drawn	GY	Approved	JS

Drawing Title

PROPOSED EAST ELEVATION (LITTLE QUAY STREET)

Drawing Number	Rev
15465/P/021	**-**