


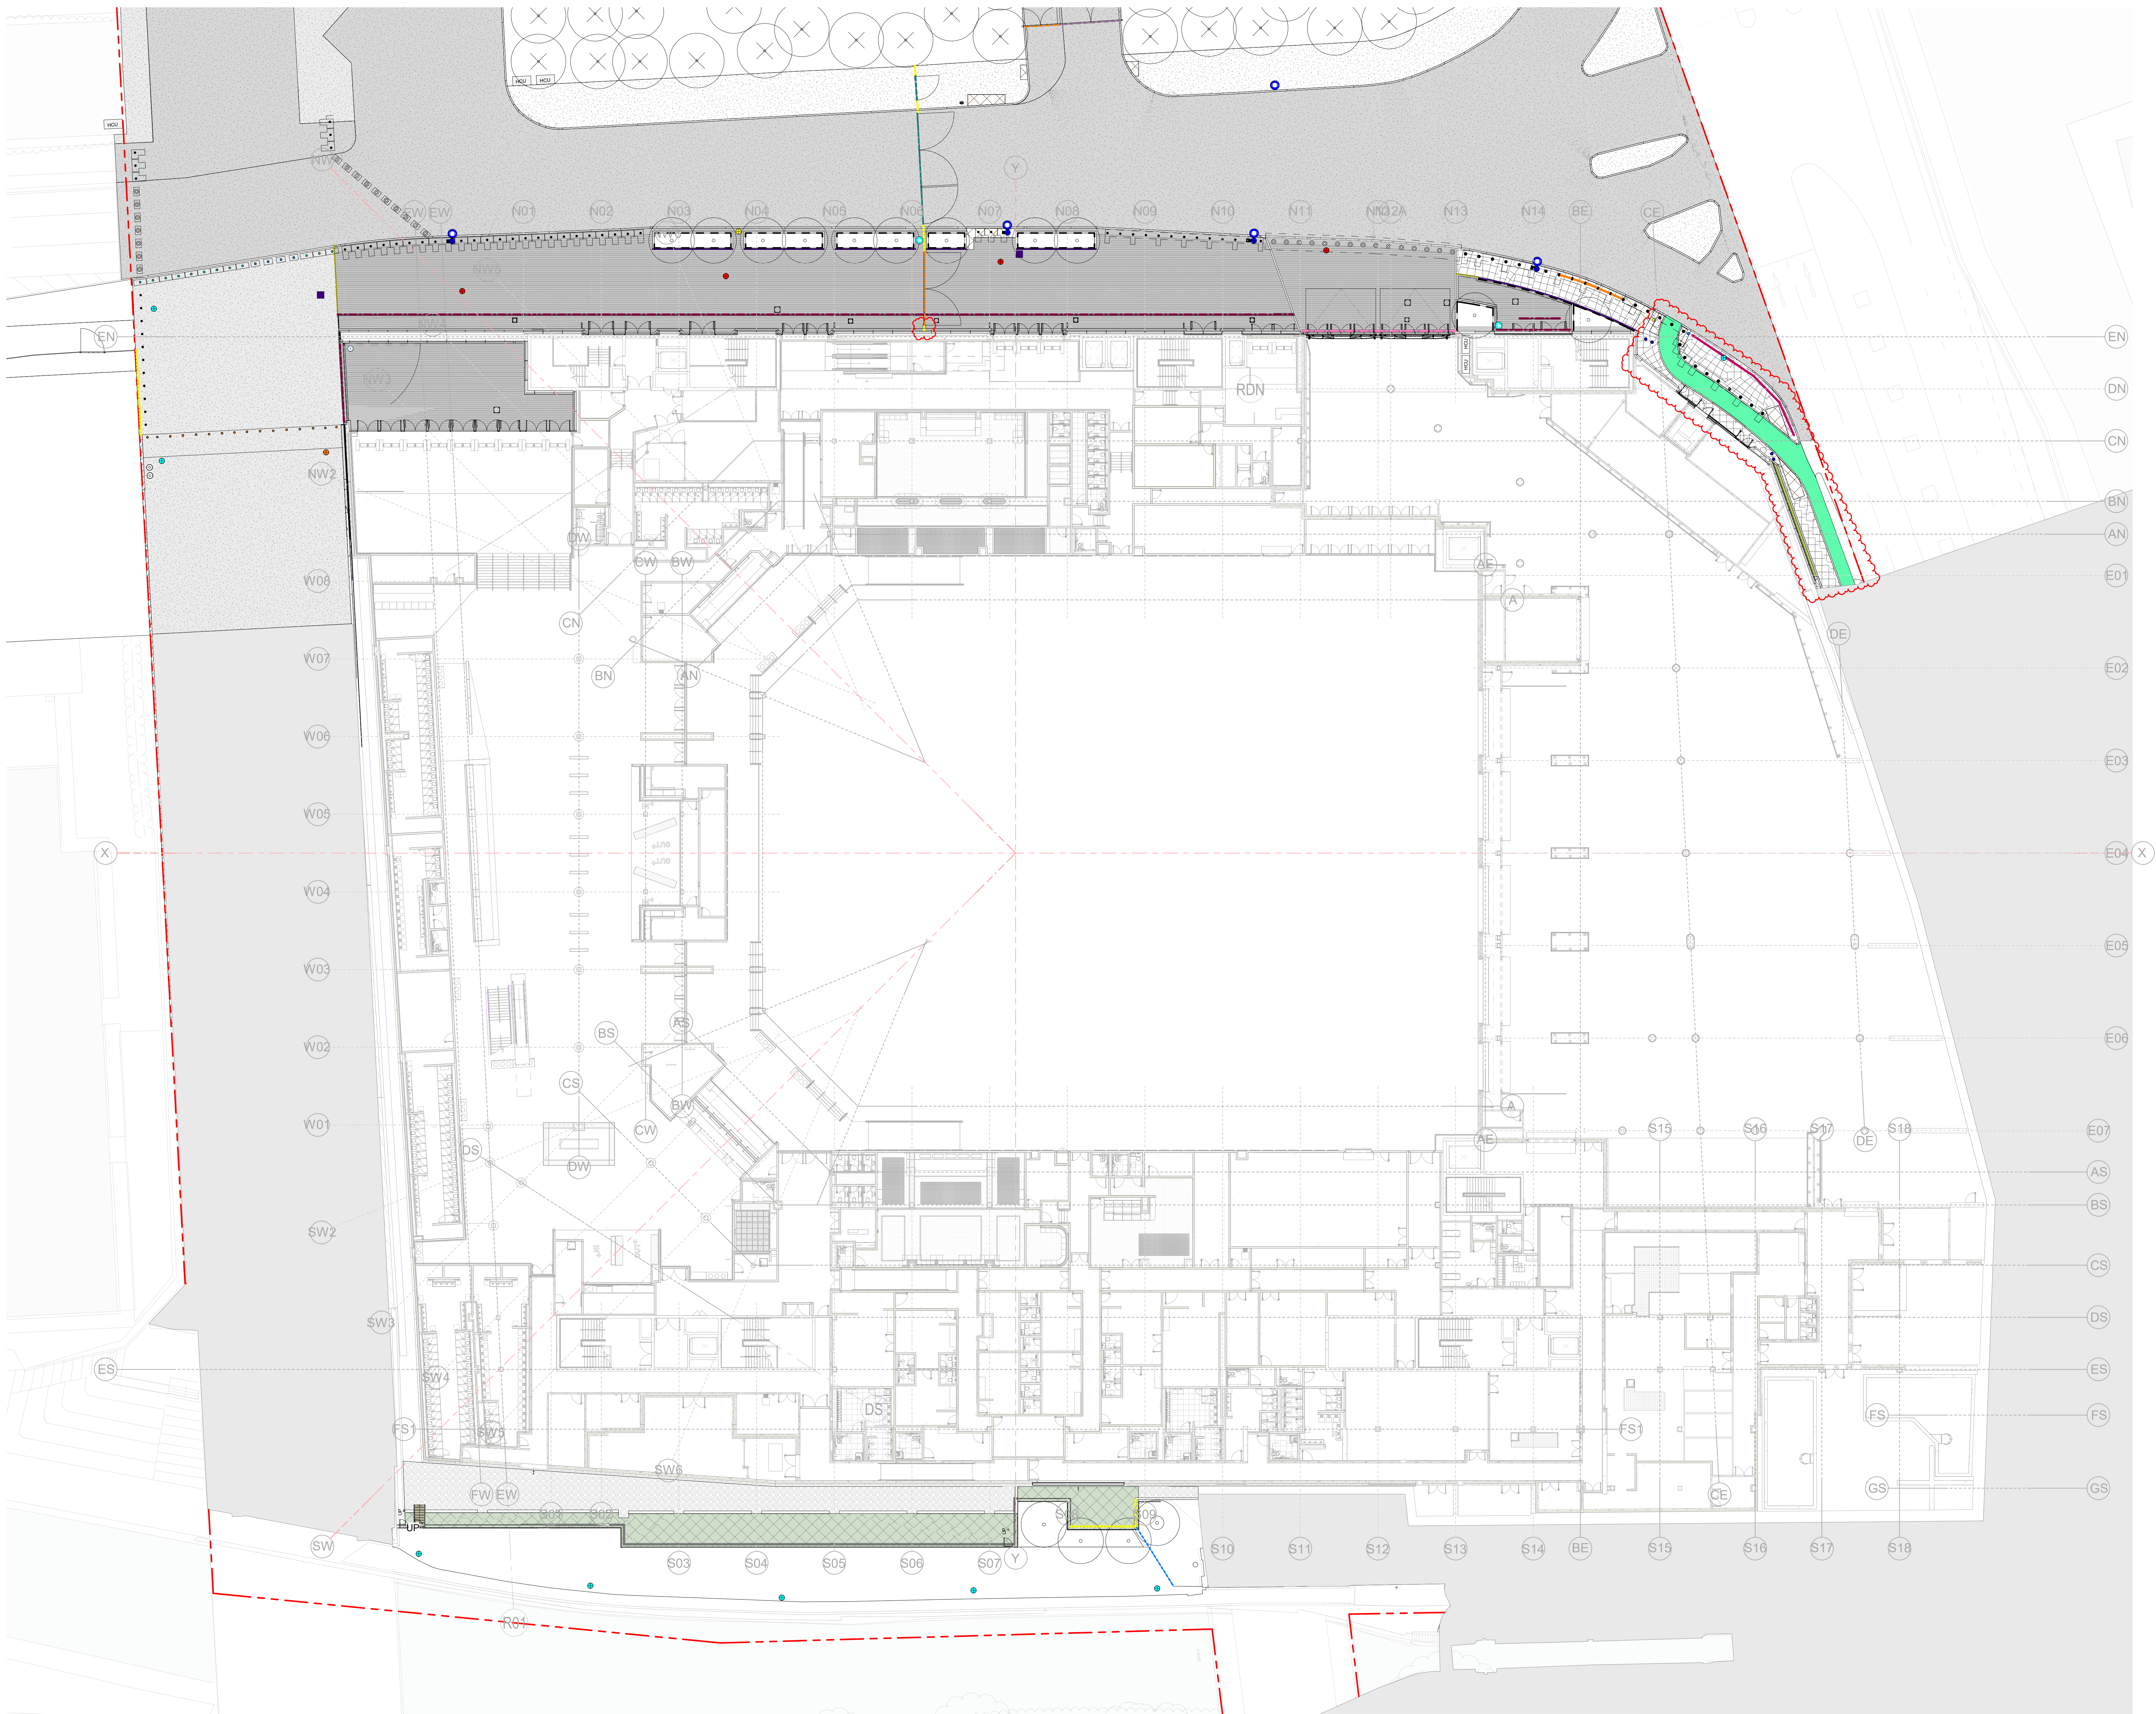

Suitability Code (as defined in ISO 19650-2:2018)

Work in Progress (WIP)

S0 - Under Review

Shared (Non-Contractual)

S1 - Suitable for co-ordination

S2 - Suitable for information

S3 - Suitable for review & comment

S4 - Suitable for stage approval

S5 - Withdrawn

S6 - Suitable for PM authorisation

S7 - Suitable for AM authorisation

Published (Contractual)

A1, A2, A3, Etc - Authorised and accepted

B1, B2, B3, Etc - Partial sign-off (with comments)

Published (AIM Acceptance)

CR - As constructed record document

KEY PLAN



KEY

PROJECT BOUNDARY

EXT-101, EXT-102, EXT-103, EXT-104 CONCRETE BLOCK

PAVING (NON-PERMEABLE BLOCK PAVING)

EXT-105, EXT-106 CONCRETE BLOCK PAVING

(PERMEABLE BOUND WITH 10MM JOINT)

EXT-112 CONCRETE PAVING SLAB

EXT-131 TARMAC

EXT-135 COATED MACADAM PAVING - WITH

TEXTURE/FLEX TOP COAT

EXISTING TARMAC

EXT-115 TACTILE BLISTER PAVING

EXT-535 NATURAL AGGREGATE LOOSE

EXT-201, EXT-202, EXT-203 CONCRETE KERB

EXT-221 METAL EDGING

EXT-211 METAL RAISED KERB

EXT-333 CONCRETE PLANTER

EXT-301 PAS RATED STATIC BOLLARD

EXT-303 PAS RATED RETRACTABLE BOLLARD - TYPE 1

EXISTING BOLLARD TO BE RELOCATED

RELOCATED EXISTING STATIC BOLLARD

RELOCATED EXISTING RETRACTABLE BOLLARD

RELOCATED EXISTING LITTER BIN

RELOCATED EXISTING CONCRETE BENCHES

EXT-425 DOOR BARRIER

EXT-405, EXT-429 GATE

RELOCATED EXISTING GATE

EXISTING GATE TO BE RETAINED

EXT-471 CONCRETE WALL

EXT-401, EXT-402 SECURITY FENCE

EXT-411, EXT-412 BALUSTRADE

EXT-413 BALUSTRADE PANEL FIXED ON THE

BOLLARDS BASE PLATE

EXT-414 BALUSTRADE PANEL FIXED ON THE

FOUNDATION IN THE GROUND

EXT-801 SLOT DRAIN TYPE 1

EXT-803 SLOT DRAIN TYPE 3

EXT-811 FLOOR GULLY

WAYFINDING ITEM

EXT-335 SECURITY HUT

PROPOSED LIGHTING COLUMN

EXISTING LIGHTING COLUMN TO BE RETAINED

EXISTING LIGHTING COLUMN TO BE REMOVED

EXISTING LIGHTING COLUMN TO BE RELOCATED

RELOCATED EXISTING LIGHTING COLUMN

LIGHTING COLUMN INTEGRATED ON BOLLARD

CCTV CAMERA

THIS DRAWING IS ONLY TO SCALE IF IT IS

REPRODUCED AT THE CORRECT PAPER SIZE

1:250@A0

ALL INTERNAL LAYOUTS AND USES ARE SHOWN

FOR ILLUSTRATIVE PURPOSES ONLY AND ARE

NOT FOR DETERMINATION

start



© COPYRIGHT ALL RIGHTS RESERVED

THIS WORK IS COPYRIGHT AND CANNOT BE REPRODUCED OR COPIED IN ANY FORM OR BY

ANY MEANS WITHOUT THE WRITTEN PERMISSION OF POPULOUS. ANY LICENSE, EXPRESS OR IMPLIED,

TO USE THIS DOCUMENT OR ANY PARTS HEREOF IS HEREBY REFUSED TO THE USER.

USE FOR RED DIMENSIONS IN PREFERENCE TO SCALED. CHECK ALL DIMENSIONS ON SITE

BEFORE PROCEEDING OR SETTING OUT

across

POPULOUS®

14 BLADES COURT | DODDAM ROAD | LONDON | SW16 2NU | UNITED KINGDOM

TELEPHONE +44 (0)20 8874 7666 FACSIMILE +44 (0)20 8874 7470

ALL PRODUCTION & INTELLECTUAL PROPERTY RIGHTS RESERVED © POPULOUS 2020

REVISIONS

| REV | DATE       | DESCRIPTION                                |
|-----|------------|--------------------------------------------|
| 01  | 29.11.2019 | DRAFT RIBA STAGE 4A                        |
| 02  | 14.04.2020 | ISSUED FOR T1 DRAFT STAGE 4A               |
| 03  | 23.06.2020 | ISSUED FOR T2 STAGE 4A                     |
| 04  | 23.06.2020 | STAGE 4B TO INCORPORATE VE UPDATE          |
| 05  | 02.12.2020 | HARD LANDSCAPE PACKAGE FOR CONSTRUCTION    |
| 06  | 03.08.2021 | FLOOR GULLY TO GF NORTH WEST ENTRANCE      |
| 07  | 12.10.2021 | RELOCATED FOLLOWING CIVIL UPDATE RFI 82146 |
| 08  | 24.04.2022 | DRAINAGE UPDATE                            |
| 09  | 22.05.2022 | 1578 UPDATE                                |

project name

Co-op Live

the HARD LANDSCAPE AND

FURNITURE PLAN

GROUND FLOOR

scale 1 : 250 @ A0

drawn FP

Project no. 4933

date 29/11/19

checked TJ

Subsity S3

reference BPA-POP-ZZ-GF-DR-L-8103

C05