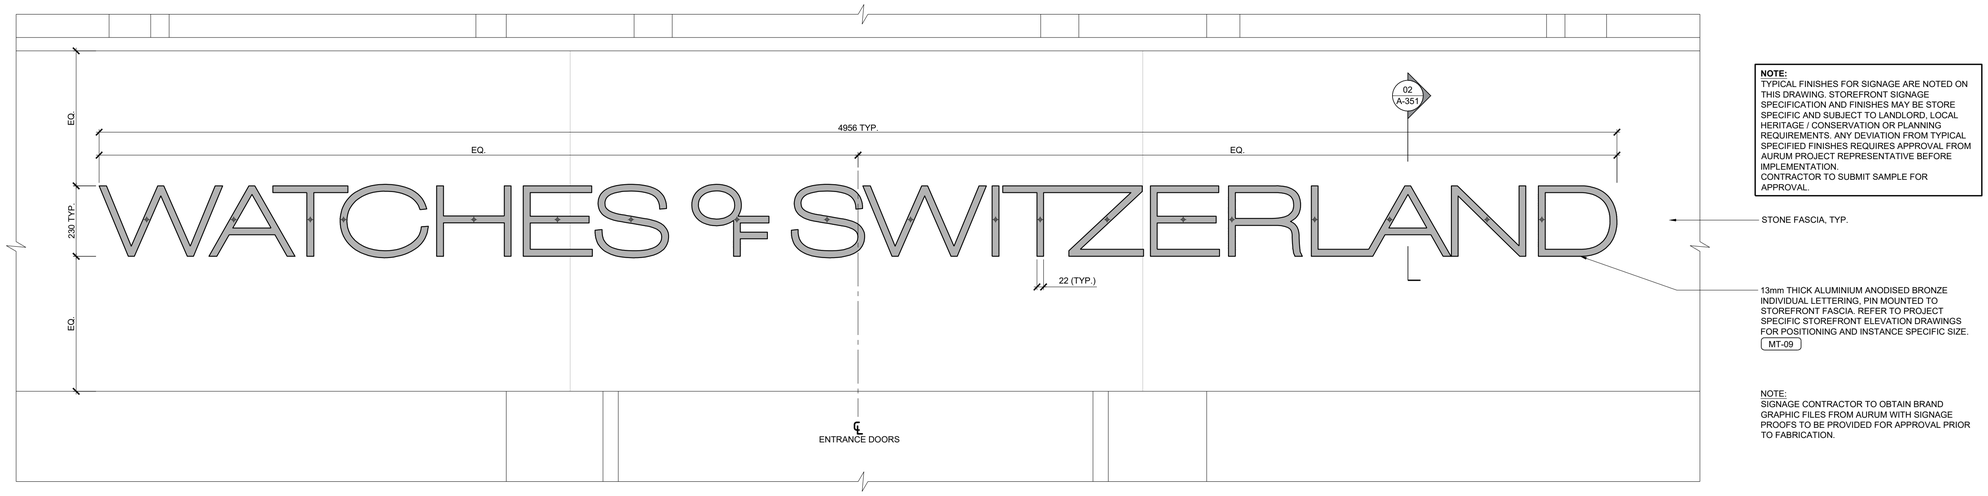



NOTE:
TYPICAL FINISHES FOR SIGNAGE ARE NOTED ON THIS DRAWING, STOREFRONT SIGNAGE SPECIFICATION AND FINISHES MAY BE STORE SPECIFIC AND SUBJECT TO LANDLORD, LOCAL HERITAGE / CONSERVATION OR PLANNING REQUIREMENTS. ANY DEVIATION FROM TYPICAL SPECIFIED FINISHES REQUIRES APPROVAL FROM AURUM PROJECT REPRESENTATIVE BEFORE IMPLEMENTATION.
CONTRACTOR TO SUBMIT SAMPLE FOR APPROVAL.

STONE FASCIA, TYP.

13mm THICK ALUMINIUM ANODISED BRONZE INDIVIDUAL LETTERING, PIN MOUNTED TO STOREFRONT FASCIA. REFER TO PROJECT SPECIFIC STOREFRONT ELEVATION DRAWINGS FOR POSITIONING AND INSTANCE SPECIFIC SIZE.
MT-09

NOTE:
SIGNAGE CONTRACTOR TO OBTAIN BRAND GRAPHIC FILES FROM AURUM WITH SIGNAGE PROOFS TO BE PROVIDED FOR APPROVAL PRIOR TO FABRICATION.

01 TYPICAL FASCIA SIGN - ELEVATION
1:10 @ A1

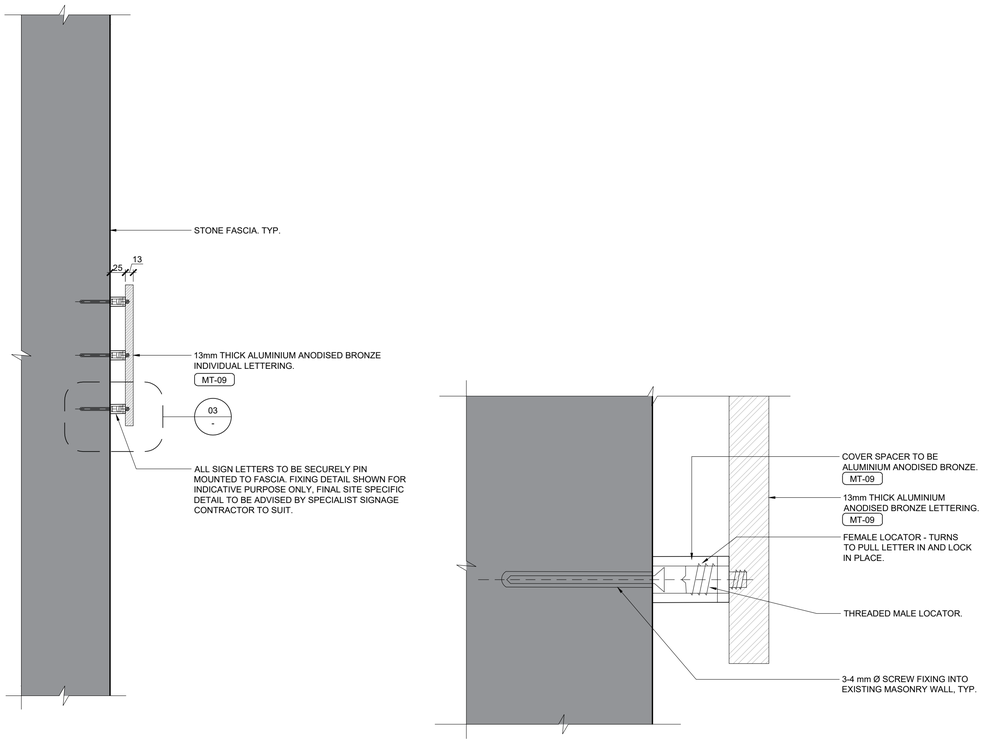

02 TYPICAL FASCIA SIGN - SECTION DETAIL
1:5 @ A1

03 TYPICAL FASCIA FIXING DETAIL
1:1 @ A1

NOTES

DRAWINGS ARE DESIGN INTENT ONLY. PRODUCTION DRAWINGS TO BE COMPLETED BY CONTRACTOR TO MEASURED SITE DIMENSIONS FOR DESIGNERS APPROVAL PRIOR TO CONSTRUCTION.

CONTRACTOR TO ENSURE ALL MATERIALS AND WORKMANSHIP COMPLIES WITH LOCAL AUTHORITY REGULATIONS.

STRUCTURAL ENGINEER MUST BE EMPLOYED WHERE APPLICABLE.

DO NOT SCALE OFF DRAWING. FIGURED DIMENSIONS TO BE TAKEN IN PREFERENCE TO THOSE SCALED. DIMENSIONS TO BE VERIFIED ON SITE. ANY DISCREPANCIES TO BE REPORTED TO DESIGNER PRIOR TO COMMENCEMENT OF WORKS.

THIS DRAWING IS THE COPYRIGHT OF AURUM HOLDINGS LTD. THIS DRAWING CANNOT BE COPIED, REPRODUCED, RETAINED OR DISCLOSED TO ANY UNAUTHORISED PERSON.

REVISION

REV	DESCRIPTION	DRAWN	DATE
-	1st ISSUE	MEC	21/04/17
A	FINISHES REVISED	MEC	26/04/17
A	PROG. CHECK ISSUE	MEC	01/05/17
A	ADVERT. CONSENT	MEC	02/05/17
Z	AS-BUILT	GA	18/10/17

DRAWING STATUS

- [x] FOR INFORMATION
- [ ] FOR APPROVAL
- [ ] FOR COSTING ONLY
- [ ] FOR CONSTRUCTION

AURUM

Aurum Holdings ltd.
Aurum House
2 Elland Road
Braunstone, Leicester
LE3 1TT

BRAND
WATCHES OF SWITZERLAND

PROJECT
STANDARD DETAILS

DESCRIPTION
STOREFRONT FASCIA SIGN - NON -ILLUMINATED

SCALE	DRAWN BY	DATE
1:10 @A1	MEC	FEB 17

DRAWING NO.	REVISION
ASD-351	Z

10/20/17 11:20 AM COPYRIGHT © AURUM HOLDINGS LTD.