


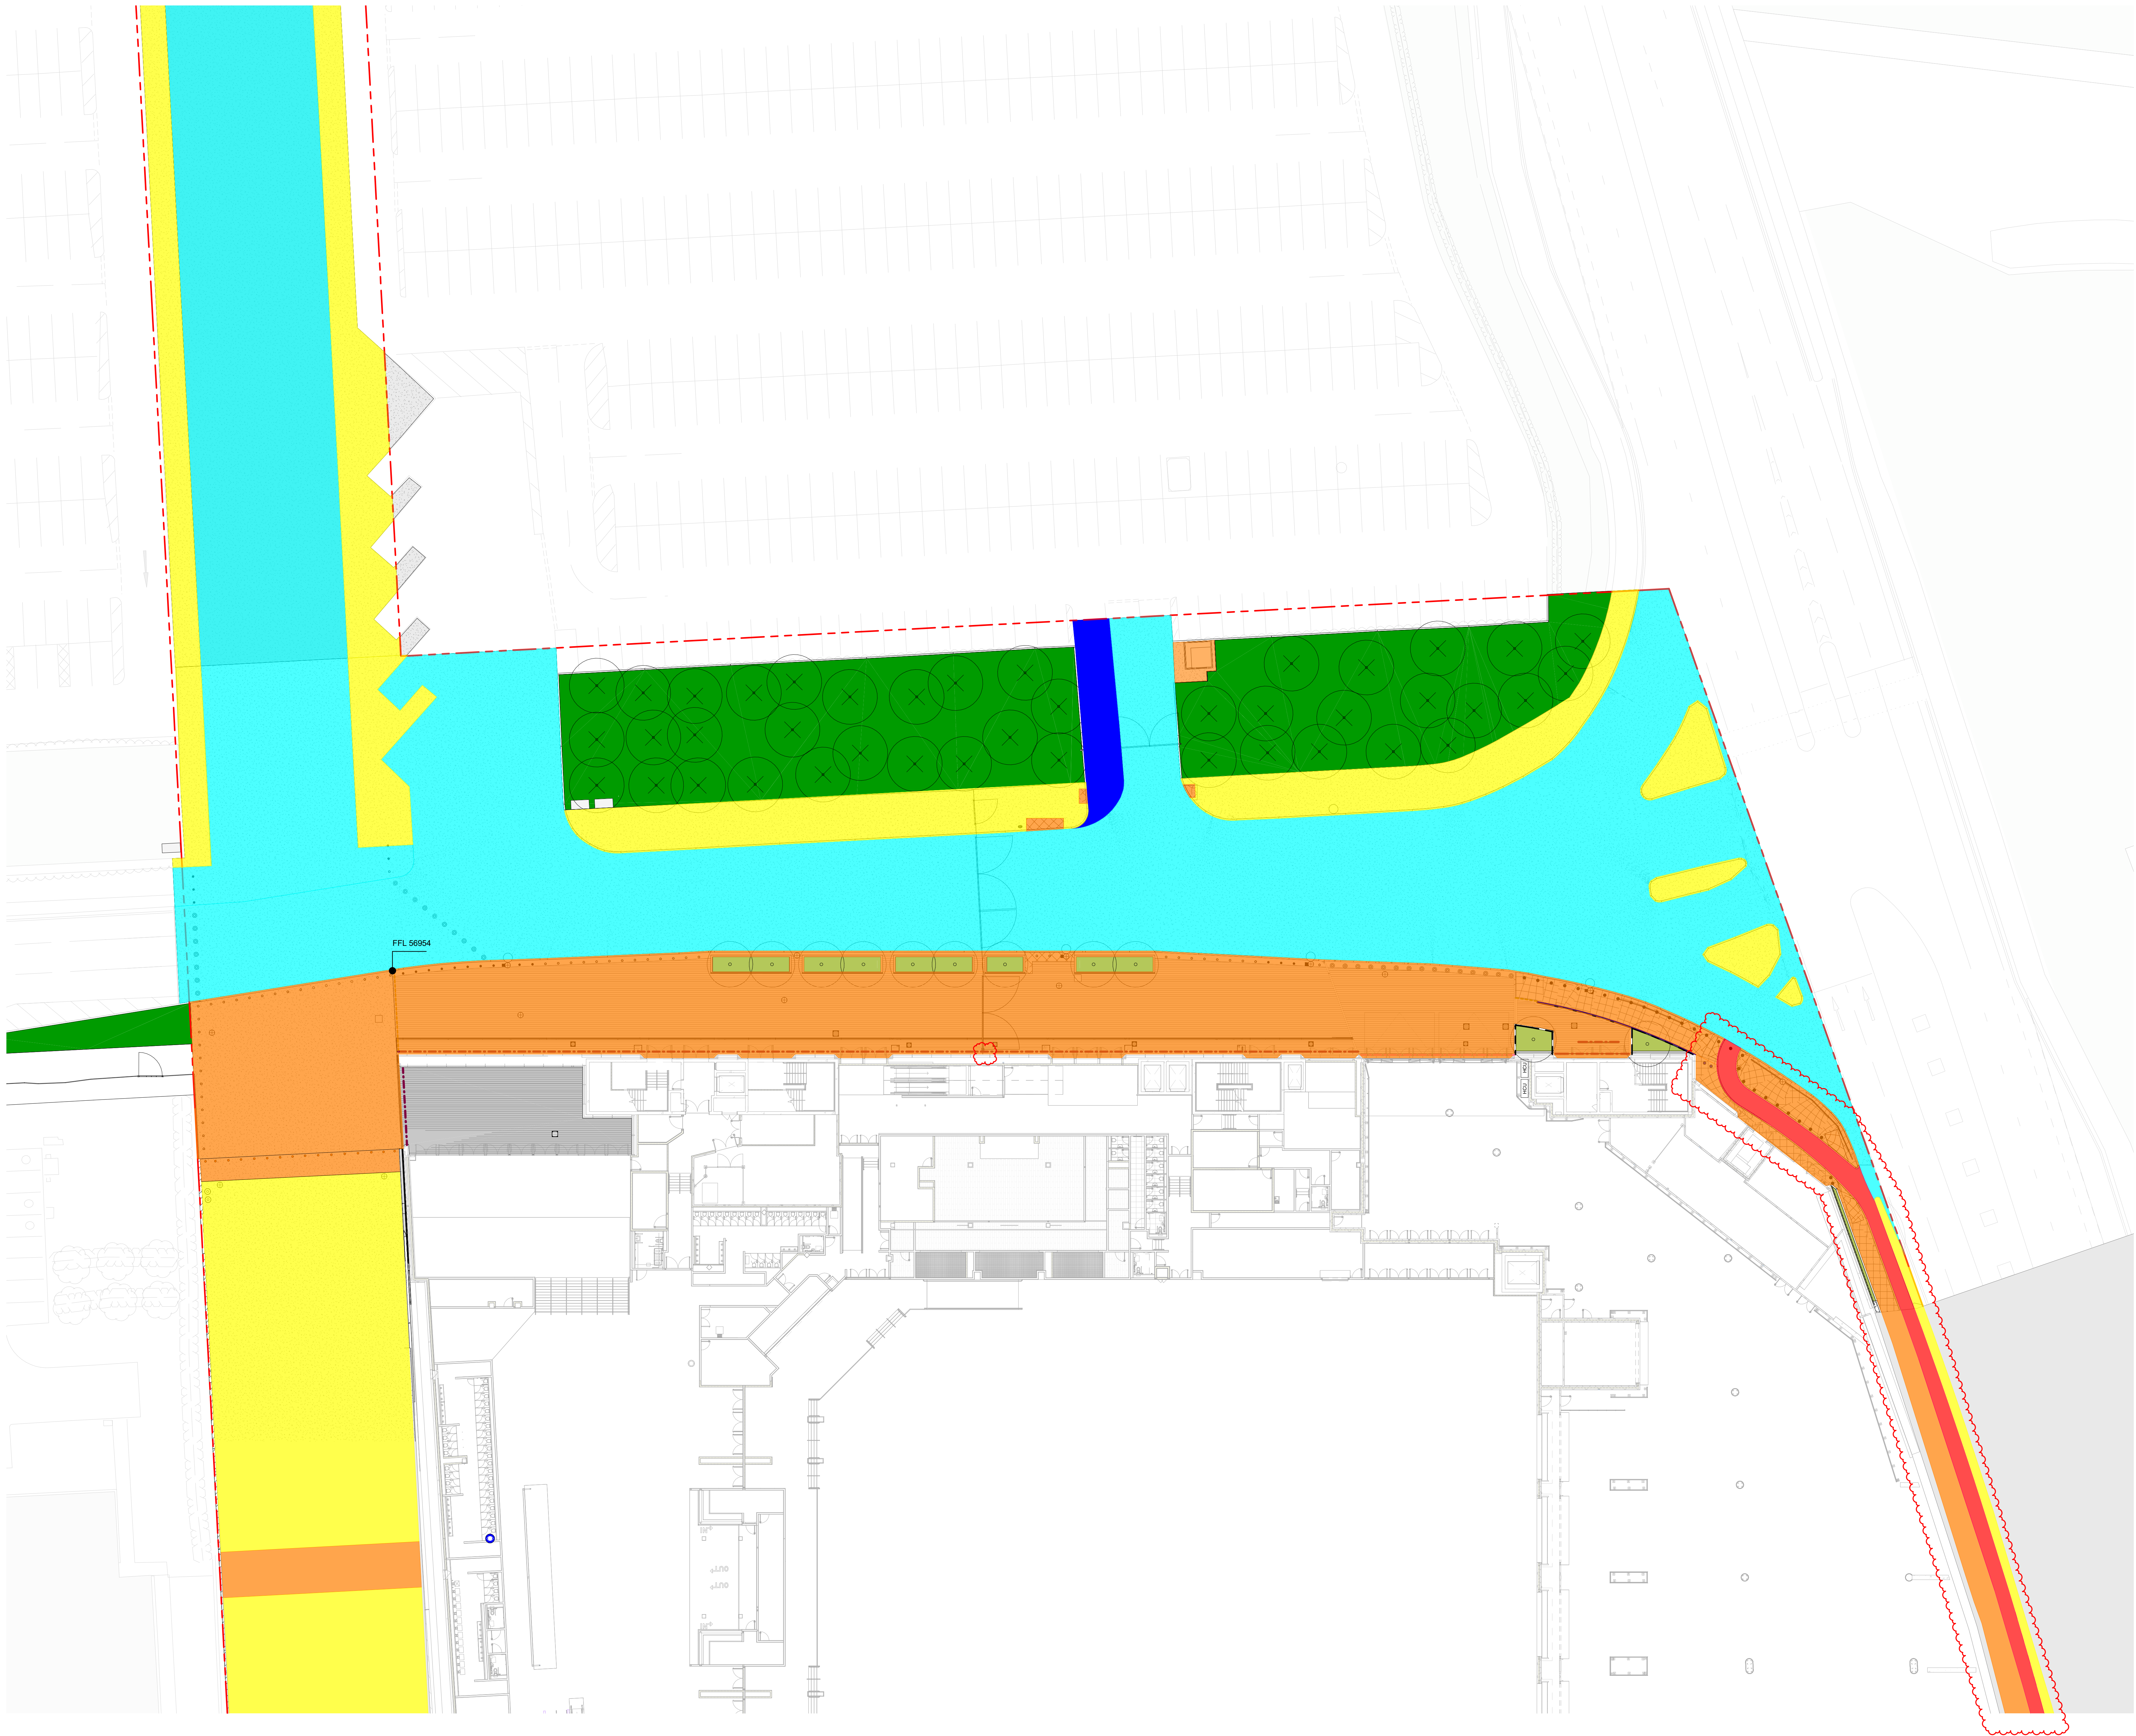

Suitability Code (as defined in ISO 19650-2:2018)

Work in Progress (WIP)

S0 - Initial Status

Shared (Non-Contractual)

S1 - Suitable for co-ordination

S2 - Suitable for information

S3 - Suitable for review & comment

S4 - Suitable for review & comment

S5 - Withdrawn

S6 - Suitable for BIM authorisation

S7 - Suitable for BIM authorisation

Published (Contractual)


A1, A2, A3, Etc - Authorised and accepted

B1, B2, B3, Etc - Partial sign-off (with comments)

Published (AIM Acceptance)

CR - As constructed record document

KEY PLAN

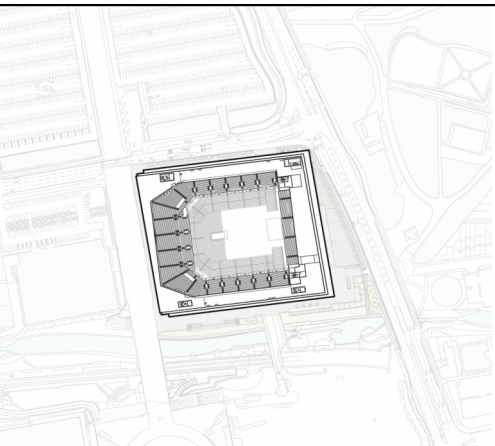


KEY

- EXISTING TARMAC
- PROPOSED TARMAC
- EXISTING PAVING
- PROPOSED PAVING
- EXISTING CYCLE LANE
- PROPOSED CYCLE LANE
- EXISTING PLANTING
- PROPOSED PLANTING

THIS DRAWING IS ONLY TO SCALE IF IT IS
REPRODUCED AT THE CORRECT PAPER SIZE

1:250@A0

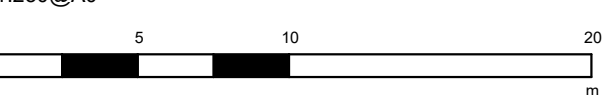

ALL INTERNAL LAYOUTS AND USES ARE SHOWN
FOR ILLUSTRATIVE PURPOSES ONLY AND ARE
NOT FOR DETERMINATION

date



© COPYRIGHT. ALL RIGHTS RESERVED

THIS WORK IS COPYRIGHT AND CANNOT BE REPRODUCED OR COPIED IN ANY FORM OR BY
ANY MEANS (ELECTRONIC, MECHANICAL, OR OTHERWISE) WITHOUT THE WRITTEN PERMISSION OF
POPOLOUS. ANY LICENSE, EXPRESS OR IMPLIED,
TO USE THIS DOCUMENT OR ANY PART OF IT IS HEREBY DENIED TO THE USER
OF THE AGREEMENT OR IMPLIED AGREEMENT BETWEEN POPOLOUS AND THE INSTRUCTING
PARTY

USE FOR ALL DIMENSIONS IN PREFERENCE TO SCALE. CHECK ALL DIMENSIONS ON SITE
BEFORE CONSTRUCTION OR SETTING OUT

author

POPOLOUS[®]

14 BLADES COURT | DODDAR ROAD | LONDON | SW15 2NU | UNITED KINGDOM
TELEPHONE +44 (0)20 8874 7685 FACSIMILE +44 (0)20 8874 7470
ALL PRODUCTIONS & INTELLECTUAL PROPERTY RIGHTS RESERVED © POPOLOUS 2023

REVISIONS

REV	DATE	DESCRIPTION
00	30.10.2020	STAGE 4A - INCREASE IN SCOPE TO PLANNING
01	16.11.2020	STAGE 4A - INCREASE IN SCOPE TO PLANNING
001	02.12.2021	HARD LANDSCAPE PACKAGE FOR CONSTRUCTION
002	22.05.2023	5278 UPDATE


project

Co-op Live

the EXTENDED NORTH WALKWAY

EXISTING/ PROPOSED PLAN

GROUND FLOOR

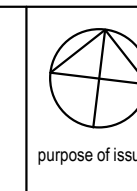

scale 1 : 250 @ A0 drawn FP Project no. 4933
date 30.10.2020 checked TJ

project code originator volume level type role number
reference BRA-POP-ZZ-GF-DR-L-8126 C02