




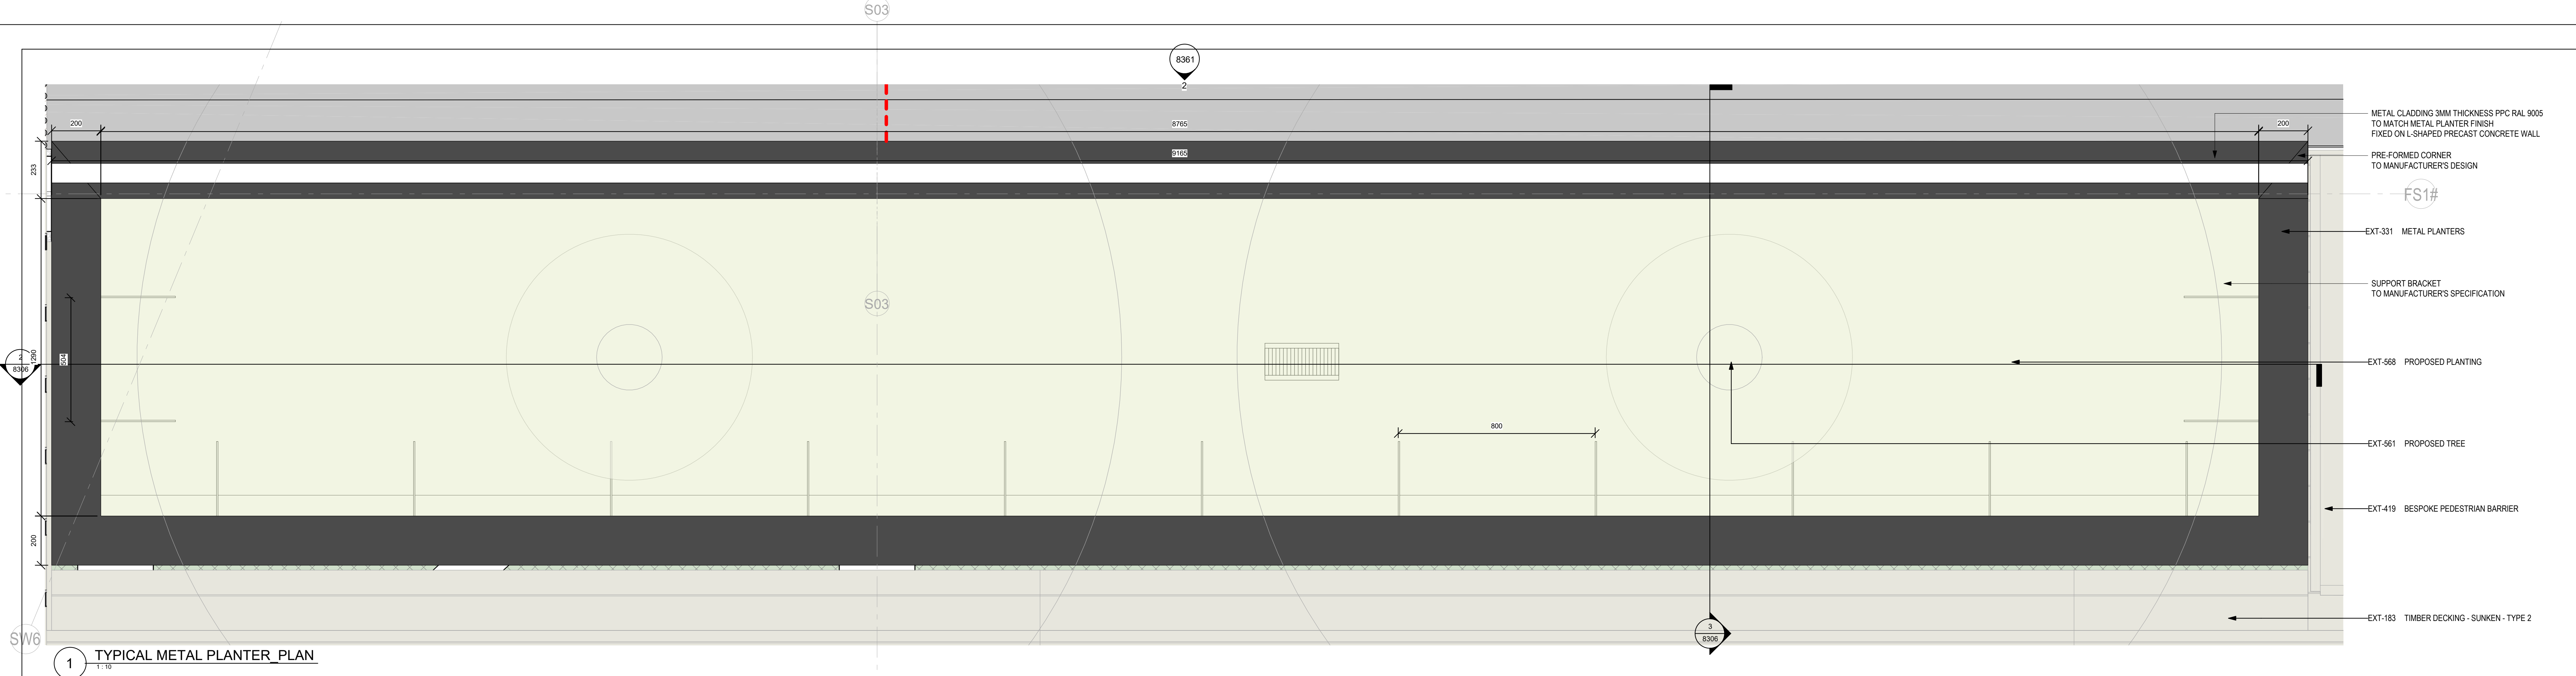


1 TYPICAL METAL PLANTER PLAN
1:10

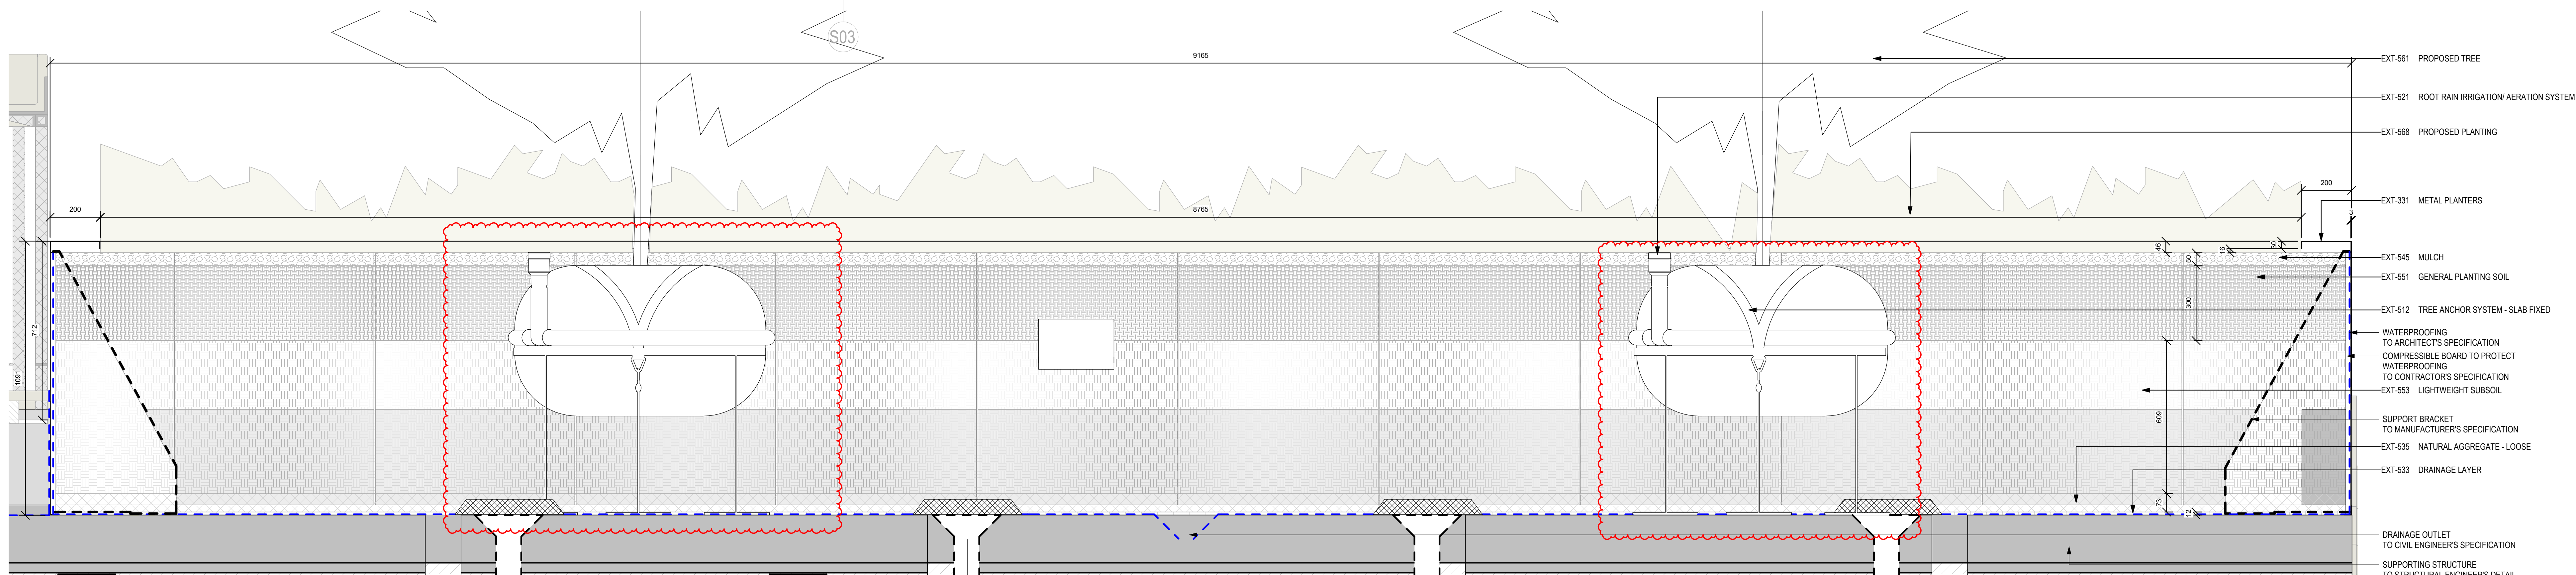

2 TYPICAL METAL PLANTER SECTION 1
1:10

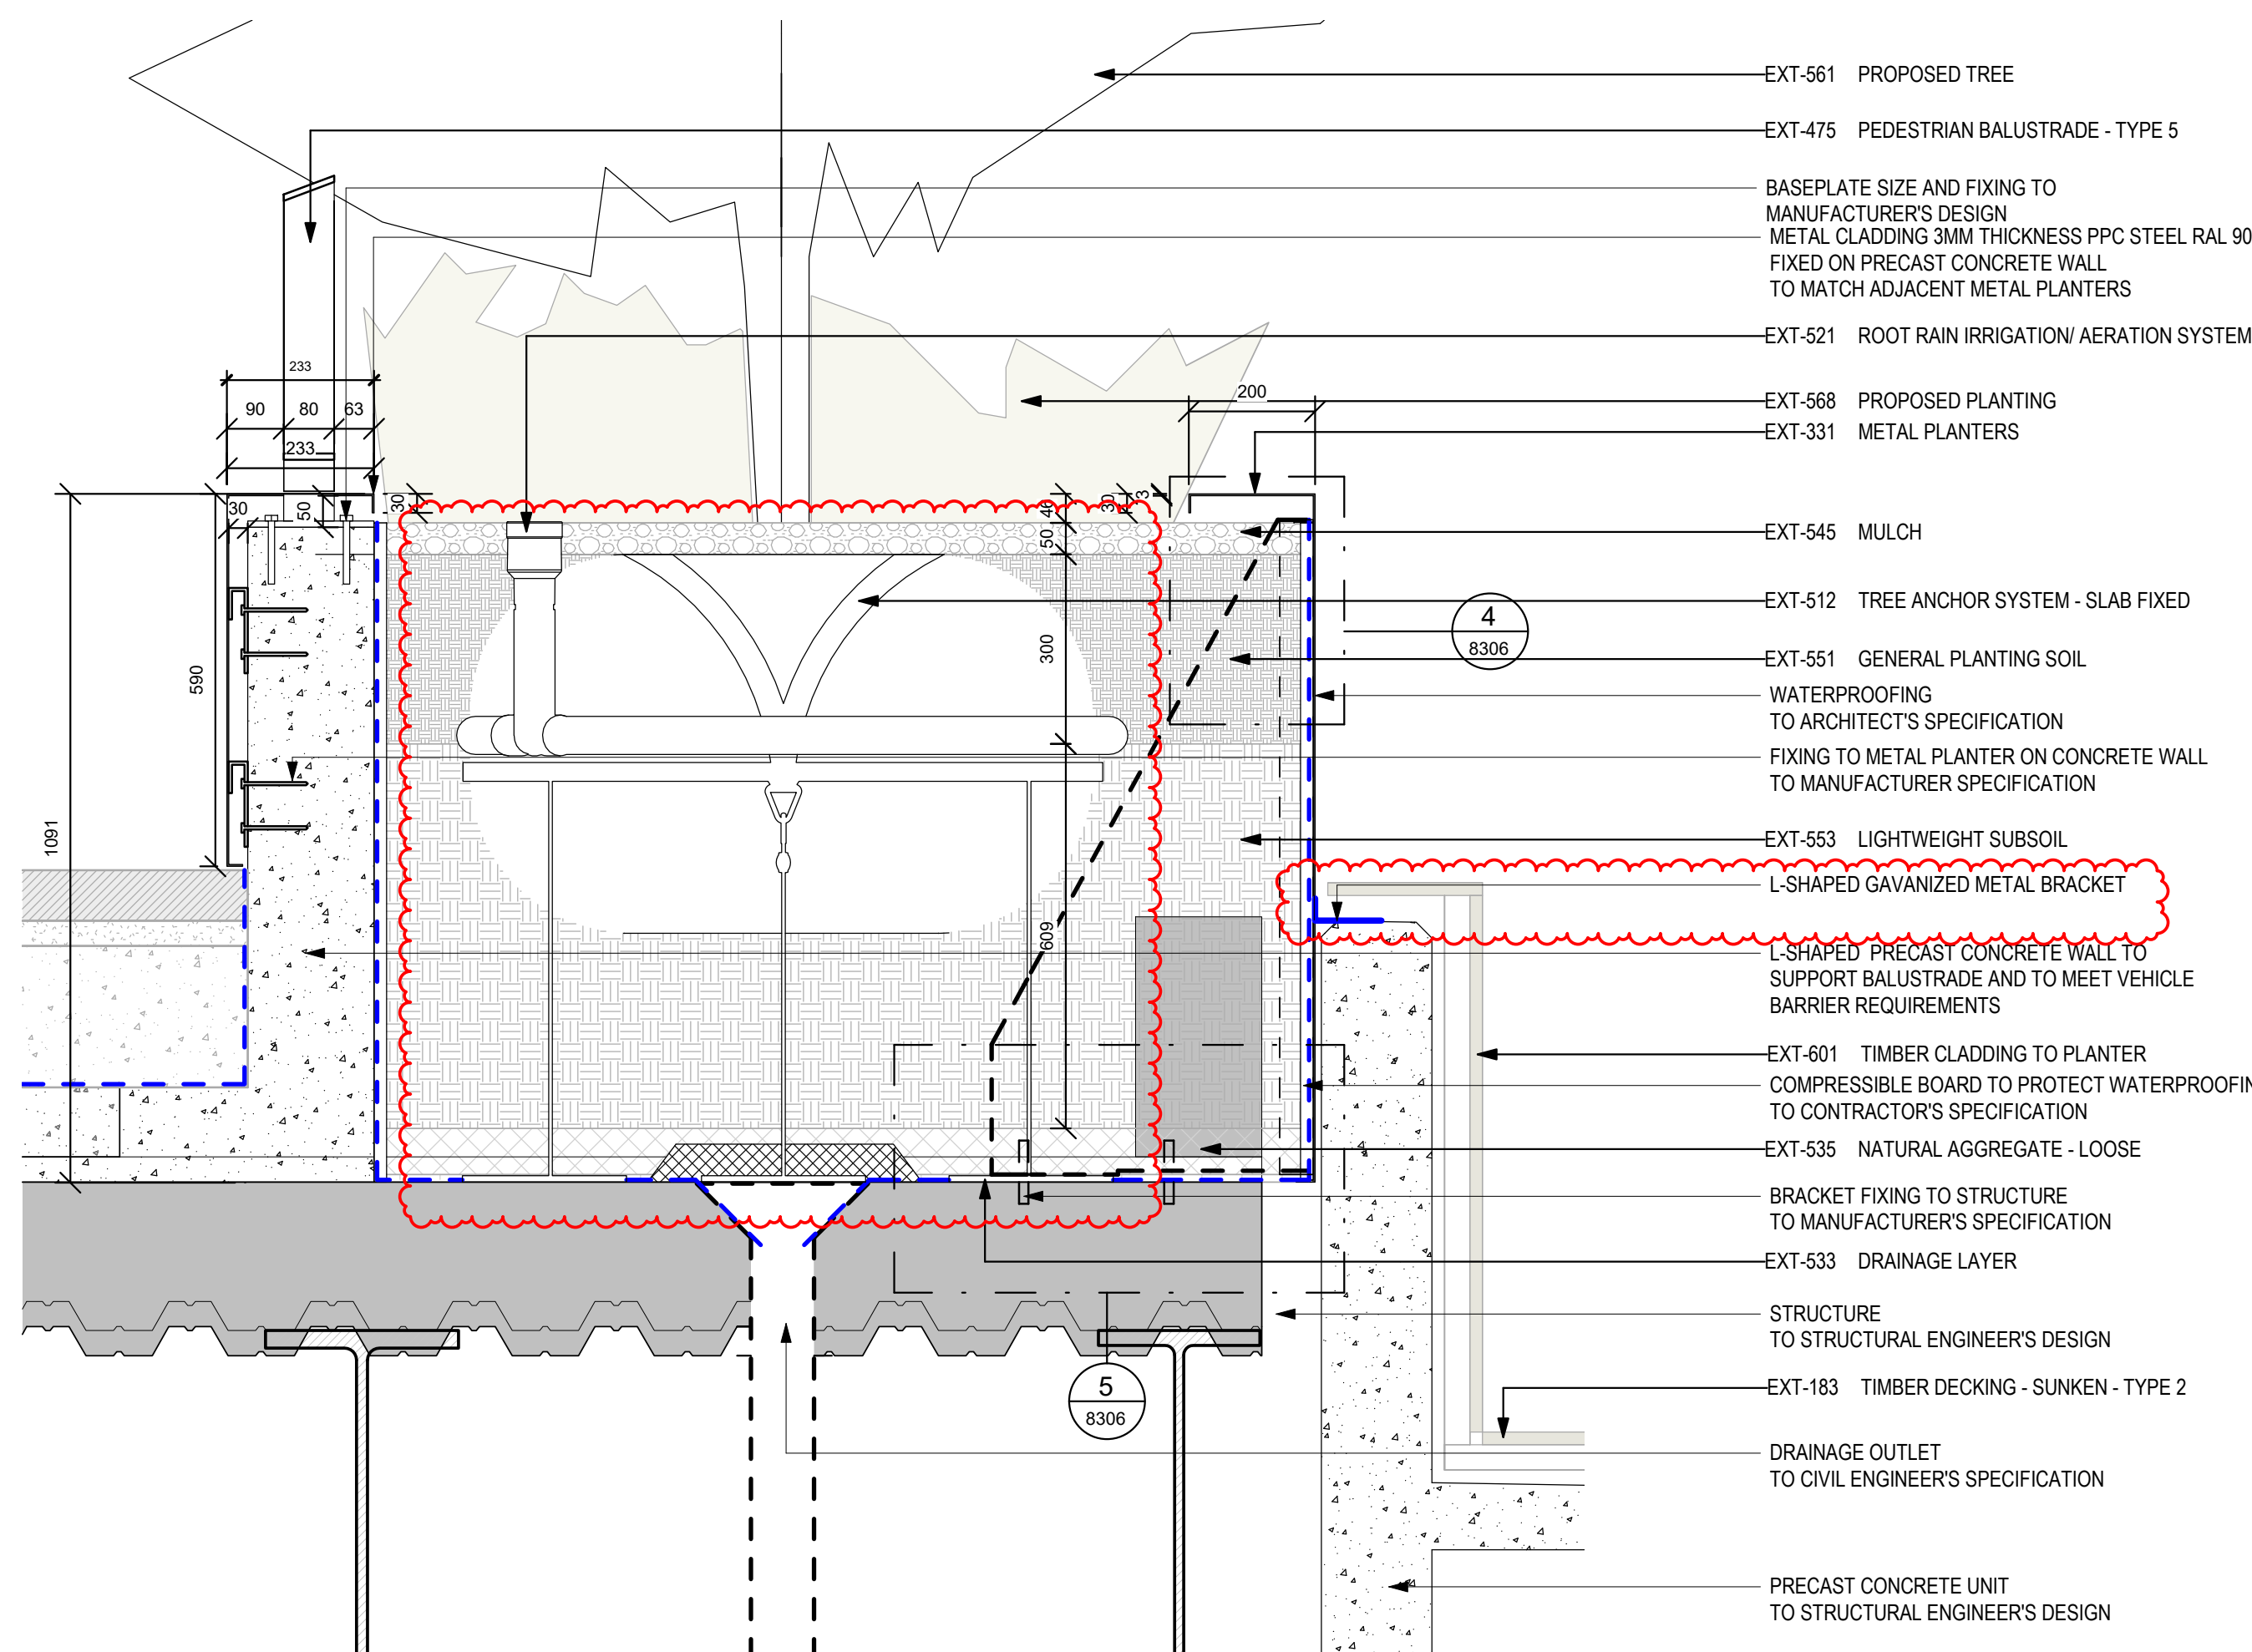

3 TYPICAL METAL PLANTER SECTION 2
1:10

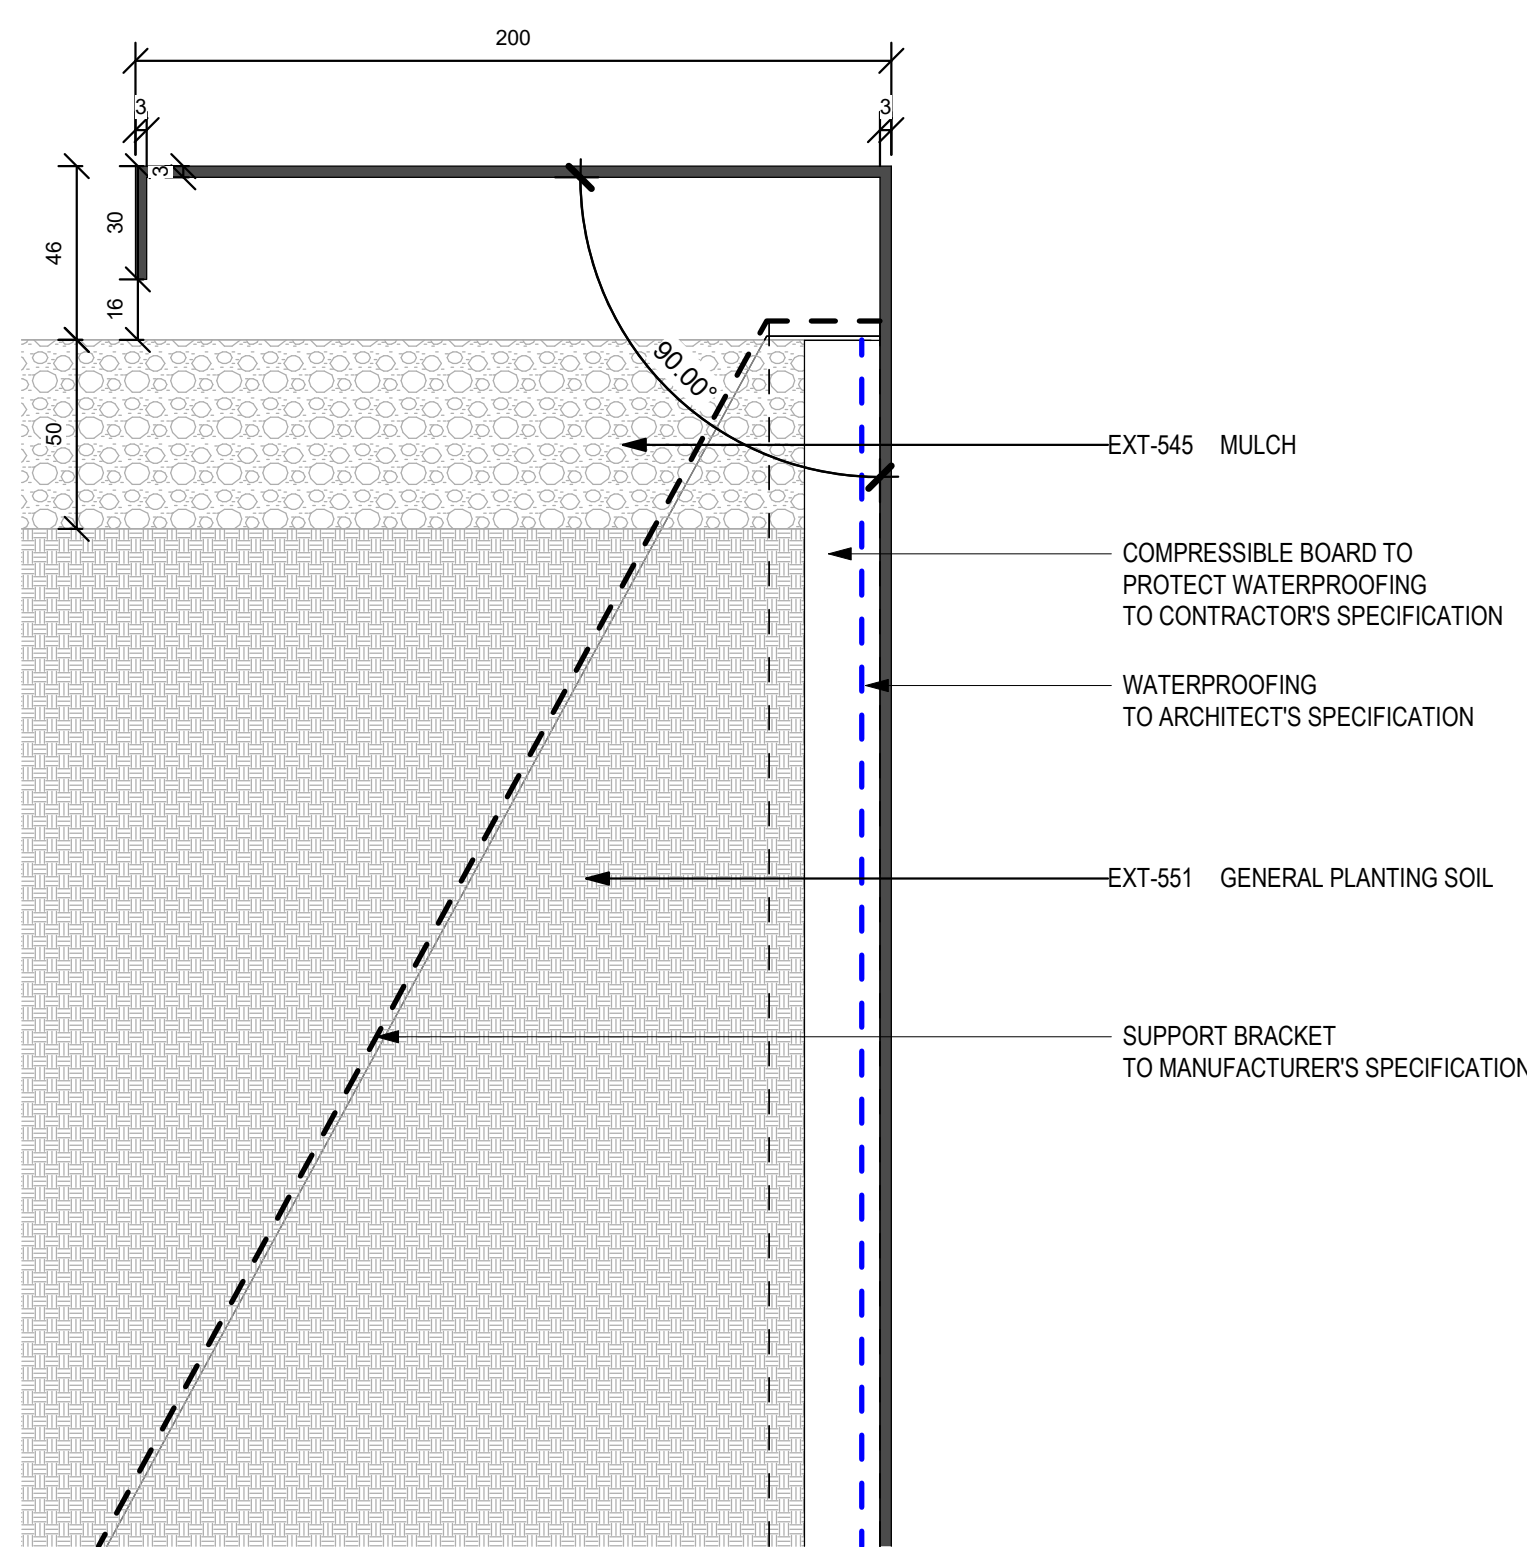

4 TYPICAL METAL PLANTER TOP DETAIL
1:2



5 TYPICAL METAL PLANTER FIXING DETAIL
1:2

Suitability Code (as defined in ISO 19650-2:2018)

Work in Progress (WIP)

50 - Under Review

Shared (Non-Contractual)

S1 - Suitable for co-ordination

S2 - Suitable for information

S3 - Suitable for review & comment

S4 - Suitable for review & comment

S5 - Withdrawn

S6 - Suitable for PM authorisation

S7 - Suitable for AM authorisation


Published (Contractual)

A1, A2, A3, Etc - Authorised and accepted

B1, B2, B3, Etc - Partial sign-off (with comments)

Published (AIM Acceptance)

CR - As constructed record document

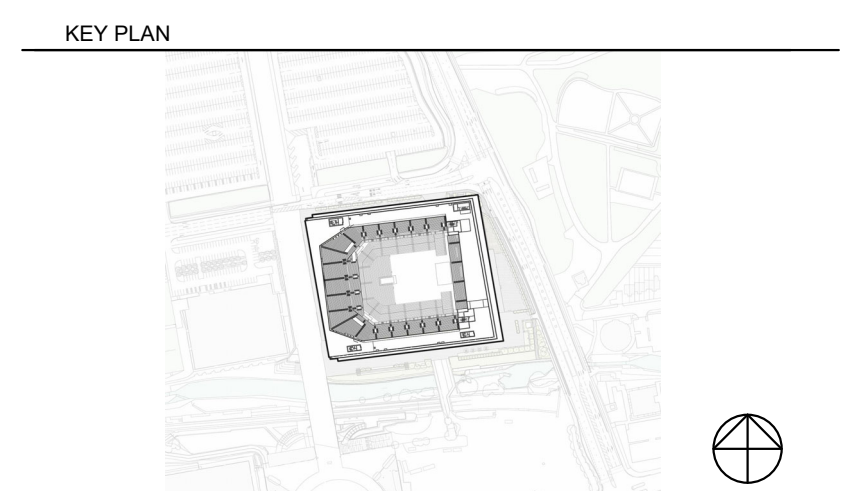

NOTES

- METAL PLANTERS WITH 200MM TOP FOLD
- CORNERS TO BE PRE-FORMED (NO JOINS ON CORNERS)
- SUPPORT BRACKET DISTANCING TO BE DETERMINED BY MANUFACTURER
- TRIANGULAR PLANTER SUPPORT BRACKETS TO BE FIXED DOWN WITH 120MM M10 THROUGH BOLT
- BLACK PPC FINISH BY SPECIFICATION

THIS DRAWING IS ONLY TO SCALE IF IT IS REPRODUCED AT THE CORRECT PAPER SIZE

1:10@A0

0 0.1 0.2 0.3 0.4 0.5

ALL INTERNAL LAYOUTS AND USES ARE SHOWN FOR ILLUSTRATIVE PURPOSES ONLY AND ARE NOT FOR DETERMINATION

THIS DRAWING IS ONLY TO SCALE IF IT IS REPRODUCED AT THE CORRECT PAPER SIZE

1:10@A0

0 0.025 0.05 0.075 0.1 0.2

ALL INTERNAL LAYOUTS AND USES ARE SHOWN FOR ILLUSTRATIVE PURPOSES ONLY AND ARE NOT FOR DETERMINATION

Safety, Health and Environmental Information

In addition to the hazards / risks normally associated with the types of work detailed on this drawing, note the following risks and information:

Construction

See risk register

No abnormal risks identified with this package of work.

For information relating to Use, Opening and Maintenance see the Health and Safety File. It is assumed that all works will be carried out by a competent contractor working, where appropriate, to an approved method statement.



© COPYRIGHT. ALL RIGHTS RESERVED

THIS WORK IS COPYRIGHT AND CANNOT BE REPRODUCED OR COPIED IN ANY FORM OR BY ANY MEANS, WITHOUT THE WRITTEN PERMISSION OF POPULOUS. ANY UNLAWFUL REPRODUCTION OR USE OF THIS DOCUMENT FOR ANY PURPOSE WHATSOEVER IS PROHIBITED TO THE FULLEST EXTENT OF THE LAW.

USE REQUIRED DIMENSIONS IN PREFERENCE TO SCALED. CHECK ALL DIMENSIONS ON SITE BEFORE FABRICATION OR SETTING OUT.

14 BLADES COURT (DEodar ROAD) LONDON | SW15 2NU | UNITED KINGDOM

TELEPHONE +44 (0)20 8874 7686 FACSIMILE +44 (0)20 8874 7470

ALL PRODUCTION & INTELLECTUAL PROPERTY RIGHTS RESERVED © POPULOUS 2020

REVISIONS	
REV	DESCRIPTION
01	20.11.2019 DRAFT RIBA STAGE 3
02	14.04.2020 ISSUED FOR T1 RIBA STAGE 4A
03	22.06.2020 ISSUED FOR T2 STAGE 4a
04	20.07.2021 STAGE 4B EXTERNAL FURNITURE
05	12.01.2022 EXTERNAL FURNITURE ISSUED FOR CONSTRUCTION
06	10/05/2022 AMENDMENT FOLLOWING RFI
07	17/05/2022 ADDITIONAL INFORMATION INCLUDED
08	16.06.2023 ADDITIONAL INFORMATION INCLUDED

project name Co-op Live

the TYPICAL METAL PLANTER DETAILS

LEVEL 01

purpose of issue CONSTRUCTION

scale 1:10, 1:2 @ A0	drawn FP	Project no. 4933	Suitability S3
date 29/11/19	checked TJ		
revision	project code	original	volume
BRA-POP-ZZ-01-DR-L-8306			

C04