


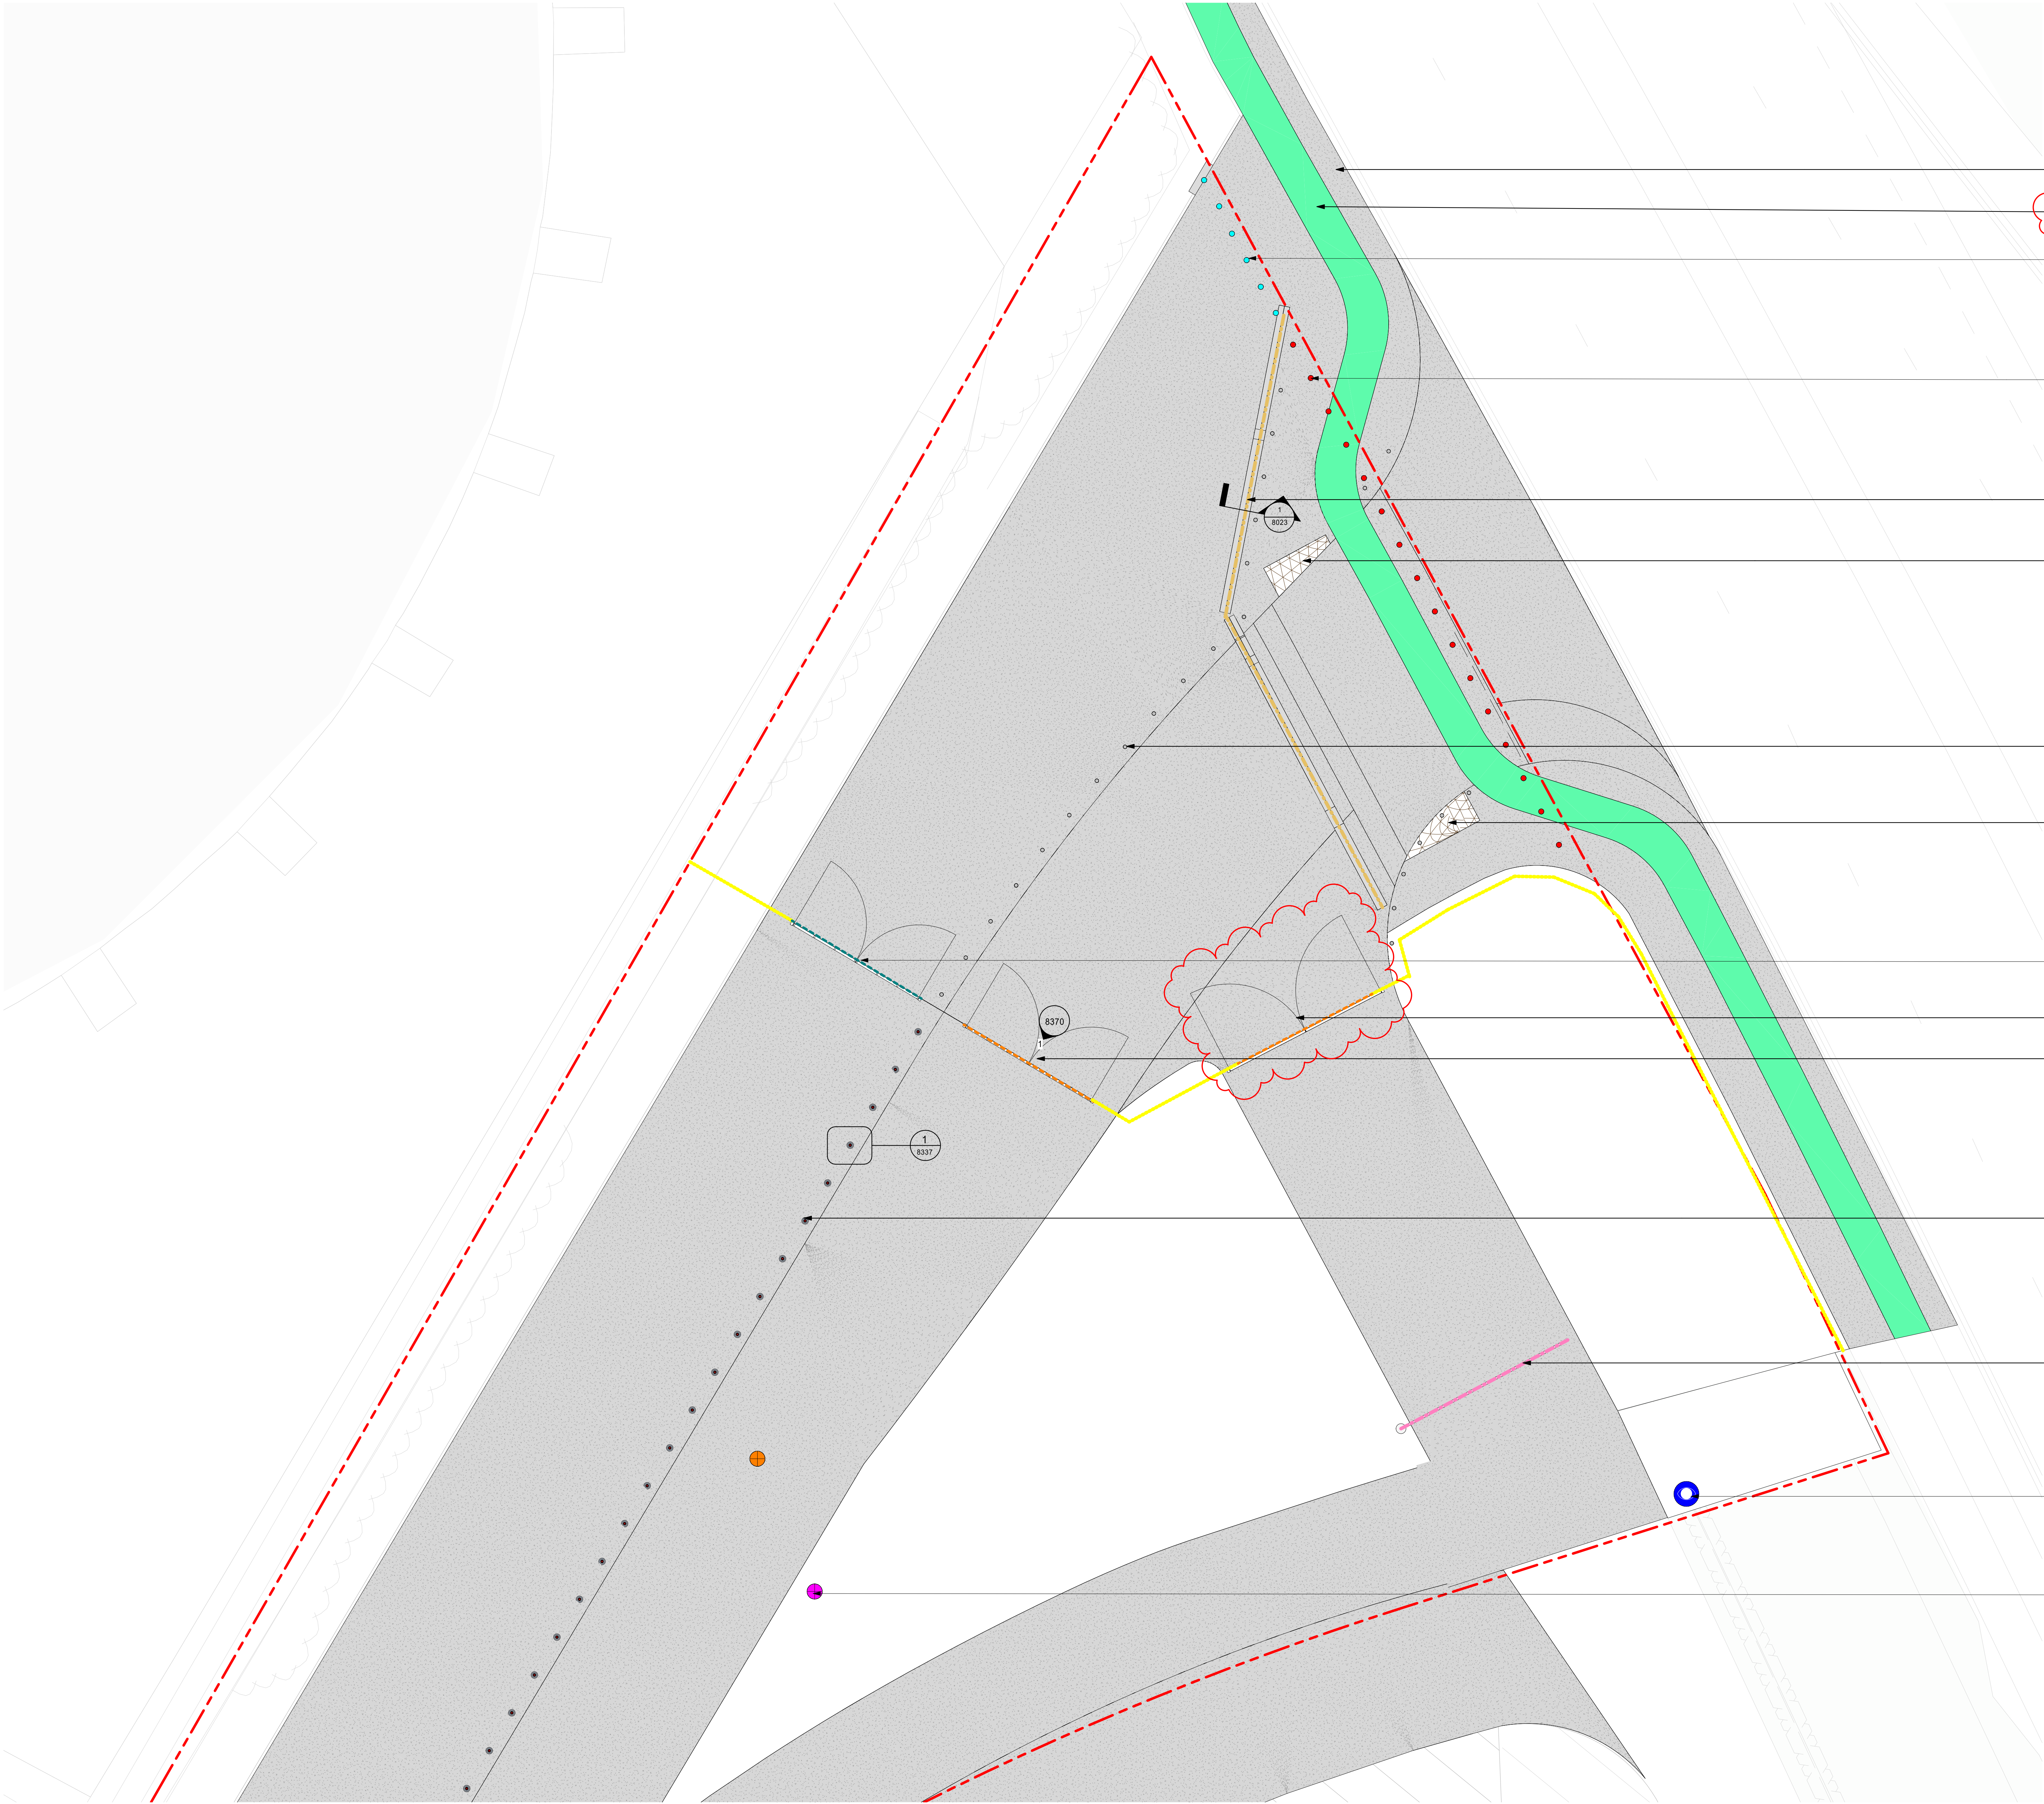

1 ENLARGED HARD PLAN, GROUND FLOOR - NORTH JUNCTION

Suitability Code (as defined in ISO 19650-2:2018)

Work in Progress (WIP)

S0 - Initial Status

Shared (Non-Contractual)
S1 - Suitable for co-ordination
S2 - Suitable for information
S3 - Suitable for review & comment
S4 - Suitable for stage approval
S5 - Withdrawn
S6 - Suitable for FIM authorisation
S7 - Suitable for AIM authorisation


Published (Contractual)

A1, A2, A3, Etc - Authorised and accepted
B1, B2, B3, Etc - Partial sign-off (with comments)

Published (AIM Acceptance)

CR - As constructed record document

KEY PLAN

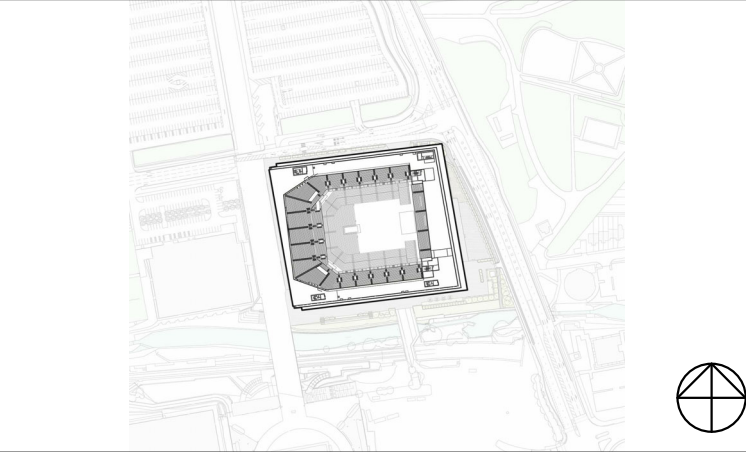


KEY

- PROJECT BOUNDARY
- EXT-131 TARMAC
- EXT-135 COATED MACADAM PAVING - WITH TEXTUREFLEX TOP COAT
- EXT-135 COATED MACADAM PAVING - WITH TEXTUREFLEX TOP COAT
- EXT-135 COATED MACADAM PAVING - WITH TEXTUREFLEX TOP COAT
- EXT-201, EXT-202, EXT-203 CONCRETE KERB
- BOLLARD TO BE RETAINED
- BOLLARD TO BE REMOVED
- EXT-307 FLEXIBLE POST
- EXT-308 HEAVY DUTY BOLLARD
- EXT-428 GATE TYPE 5
- EXISTING GATE TO BE RELOCATED
- EXT-401 FENCE TO TIE AND MATCH WITH EXISTING
- EXT-419 SLOT DRAIN TYPE 6
- RISEING ARM BARRIER AND INTERCOM
- EXISTING LIGHTING COLUMN TO BE RELOCATED
- EXISTING LIGHTING COLUMN RELOCATED
- CCTV CAMERA ON 3M HIGH POLE

THIS DRAWING IS ONLY TO SCALE IF IT IS REPRODUCED AT THE CORRECT PAPER SIZE

1:100@A0

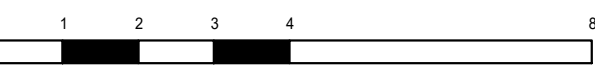

ALL INTERNAL LAYOUTS AND USES ARE SHOWN FOR ILLUSTRATIVE PURPOSES ONLY AND ARE NOT FOR DETERMINATION

client



© COPYRIGHT. ALL RIGHTS RESERVED

THIS WORK IS COPYRIGHT AND CANNOT BE REPRODUCED OR COPIED IN ANY FORM OR BY ANY MEANS (GRAPHIC, ELECTRONIC OR MECHANICAL, INCLUDING PHOTOCOPYING, RECORDING, OR BY ANY INFORMATION STORAGE AND RETRIEVAL SYSTEM) WITHOUT THE WRITTEN PERMISSION OF POPULOUS. ANY UNAUTHORIZED REPRODUCTION OR USE OF THIS DOCUMENT FOR ANY PURPOSE WHATSOEVER IS STRICTLY PROHIBITED. THE USER OF THIS DOCUMENT AGREES TO INDEMNIFY AND HOLD HARMLESS POPULOUS FROM AND AGAINST ALL CLAIMS, DAMAGES, LOSSES AND EXPENSES, INCLUDING REASONABLE ATTORNEY'S FEES, ARISING OUT OF OR RESULTING FROM SUCH REPRODUCTION OR USE.

USE DIMENSIONS IN PREFERENCE TO SCALES. CHECK ALL DIMENSIONS ON SITE BEFORE FABRICATION OR SETTING OUT.

author

POPULOUS®

14 BLADES COURT | DEODAR ROAD | LONDON | SW15 2NU | UNITED KINGDOM
TELEPHONE +44 (0)20 8874 7686 FACSIMILE +44 (0)20 8874 7470
ALL PRODUCTION & INTELLECTUAL PROPERTY RIGHTS RESERVED © POPULOUS 2020

REVISIONS

REV	DATE	DESCRIPTION
P00	30.10.2020	STAGE 4A - INCREASE IN SCOPE TO PLANNING BOUNDARY
P01	16.11.2020	STAGE 4A - INCREASE IN SCOPE TO PLANNING BOUNDARY
P02	30.04.2021	STAGE 4B HARD LANDSCAPE WORKS OUTSIDE RED BOUNDARY
P03	09.07.2021	STAGE 4B TO INCORPORATE VE UPDATE

project name

Co-op Live

the HARD LANDSCAPE ENLARGED PLAN
NORTH JUNCTION
GROUND FLOOR



scale 1:100@A0 drawn FP project no. 4933 suitability S3

date 30.10.2020 checked TJ

project code original volume level type role number

reference BRA-POP-ZZ-GF-DR-L-8180 P03