
NOTE:
ALL EXISTING BUS STOP SIGNS TO BE RETAINED. ONLY REPLACE SIGN PANEL WITH NEW SIGN PANEL BRAND LOGO DESIGN AND SIZE AS PER LANDLORD SIGNAGE GUIDELINES.

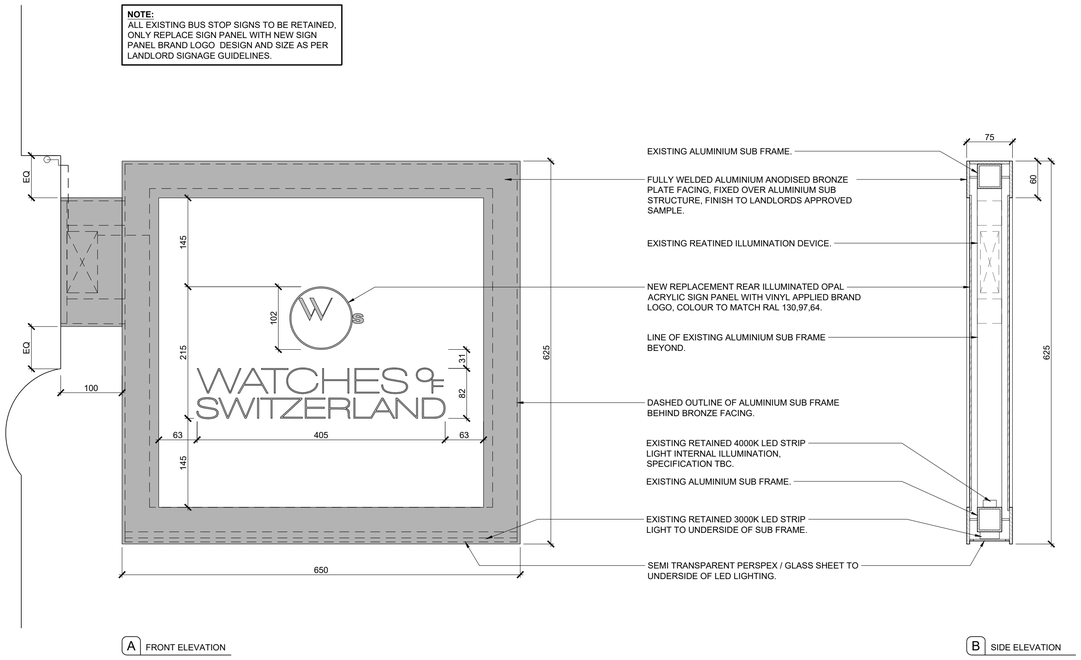


A FRONT ELEVATION

B SIDE ELEVATION

01 PROPOSED BUS STOP SIGN - WATCHES OF SWITZERLAND
1:5 @ A1

0 500mm

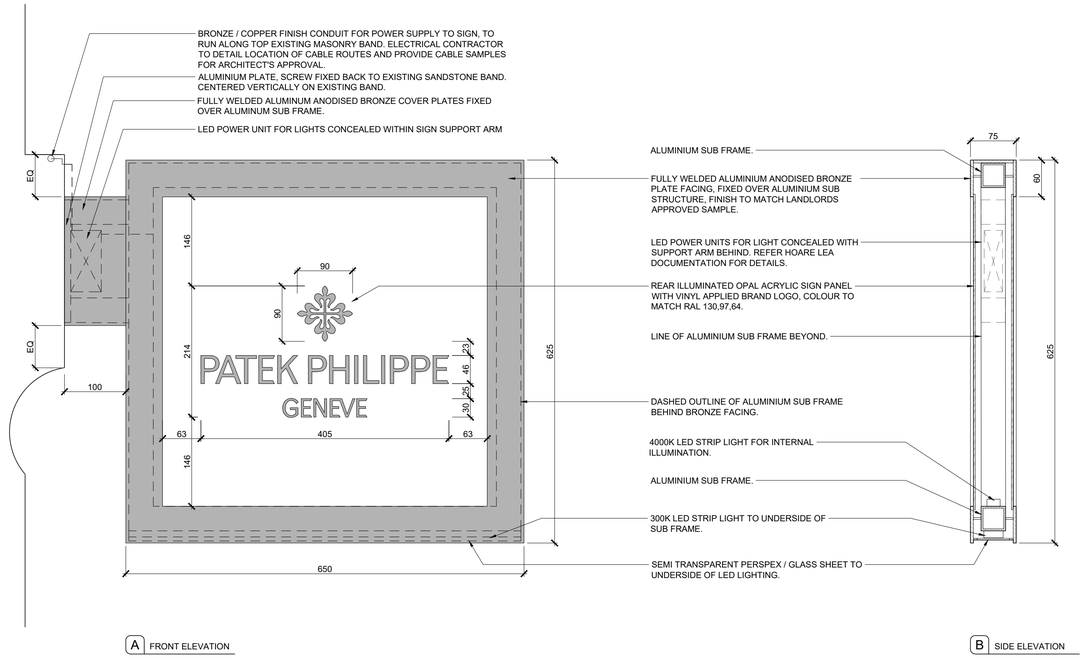

A FRONT ELEVATION

B SIDE ELEVATION

02 PROPOSED BUS STOP SIGN - PATEK PHILIPPE
1:5 @ A1

NOTES

DRAWINGS ARE DESIGN INTENT ONLY. PRODUCTION DRAWINGS TO BE COMPLETED BY CONTRACTOR TO MEASURED SITE DIMENSIONS FOR DESIGNERS / ARCHITECT'S APPROVAL PRIOR TO CONSTRUCTION.

CONTRACTOR TO ENSURE ALL MATERIALS AND WORKMANSHIP COMPLIES WITH LOCAL AUTHORITY REGULATIONS.

STRUCTURAL ENGINEER MUST BE EMPLOYED WHERE APPLICABLE.

DO NOT SCALE OFF DRAWING. FIGURED DIMENSIONS TO BE TAKEN IN PREFERENCE TO THOSE SCALED. DIMENSIONS TO BE VERIFIED ON SITE. ANY DISCREPANCIES TO BE REPORTED TO PROJECT DESIGNER / ARCHITECT PRIOR TO COMMENCEMENT OF WORKS.

THIS DRAWING IS THE COPYRIGHT OF CAPELO DESIGN LTD. THIS DRAWING CANNOT BE COPIED, REPRODUCED, RETAINED OR DISCLOSED TO ANY UNAUTHORISED PERSON.

REVISION

REV	DESCRIPTION	DRAWN	DATE
-	TENDER ISSUE	MEC	21/04/17
A	ADVERT. CONSENT	MEC	02/05/17
A	CONSTRUCT. ISSUE	MEC	26/06/17
B	REVISED AS CLOUDED	MEC	19/06/17
C	REVISED AS CLOUDED PATEK BRANDED PROJECTING SIGN ADDED TO ST ANN'S SQ ELEVATION	GA	29/08/17
Z	AS-BUILT	GA	18/10/17

DRAWING STATUS

- [x] FOR INFORMATION
- [ ] FOR APPROVAL
- [ ] FOR COSTING ONLY
- [ ] FOR CONSTRUCTION

CAPELO
www.capelo.design | hello@capelo.design | +44 (0)20 3870 4032

CLIENT
WATCHES OF SWITZERLAND

PROJECT
MANCHESTER

DESCRIPTION
PROPOSED BUS STOP SIGN

SCALE	DRAWN BY	DATE
1:5 @ A1	TD	MAR.'17

DRAWING NO. 17012-A-351

REVISION Z

COPYRIGHT © CAPELO DESIGN LTD.

10/20/17 4:03 PM