



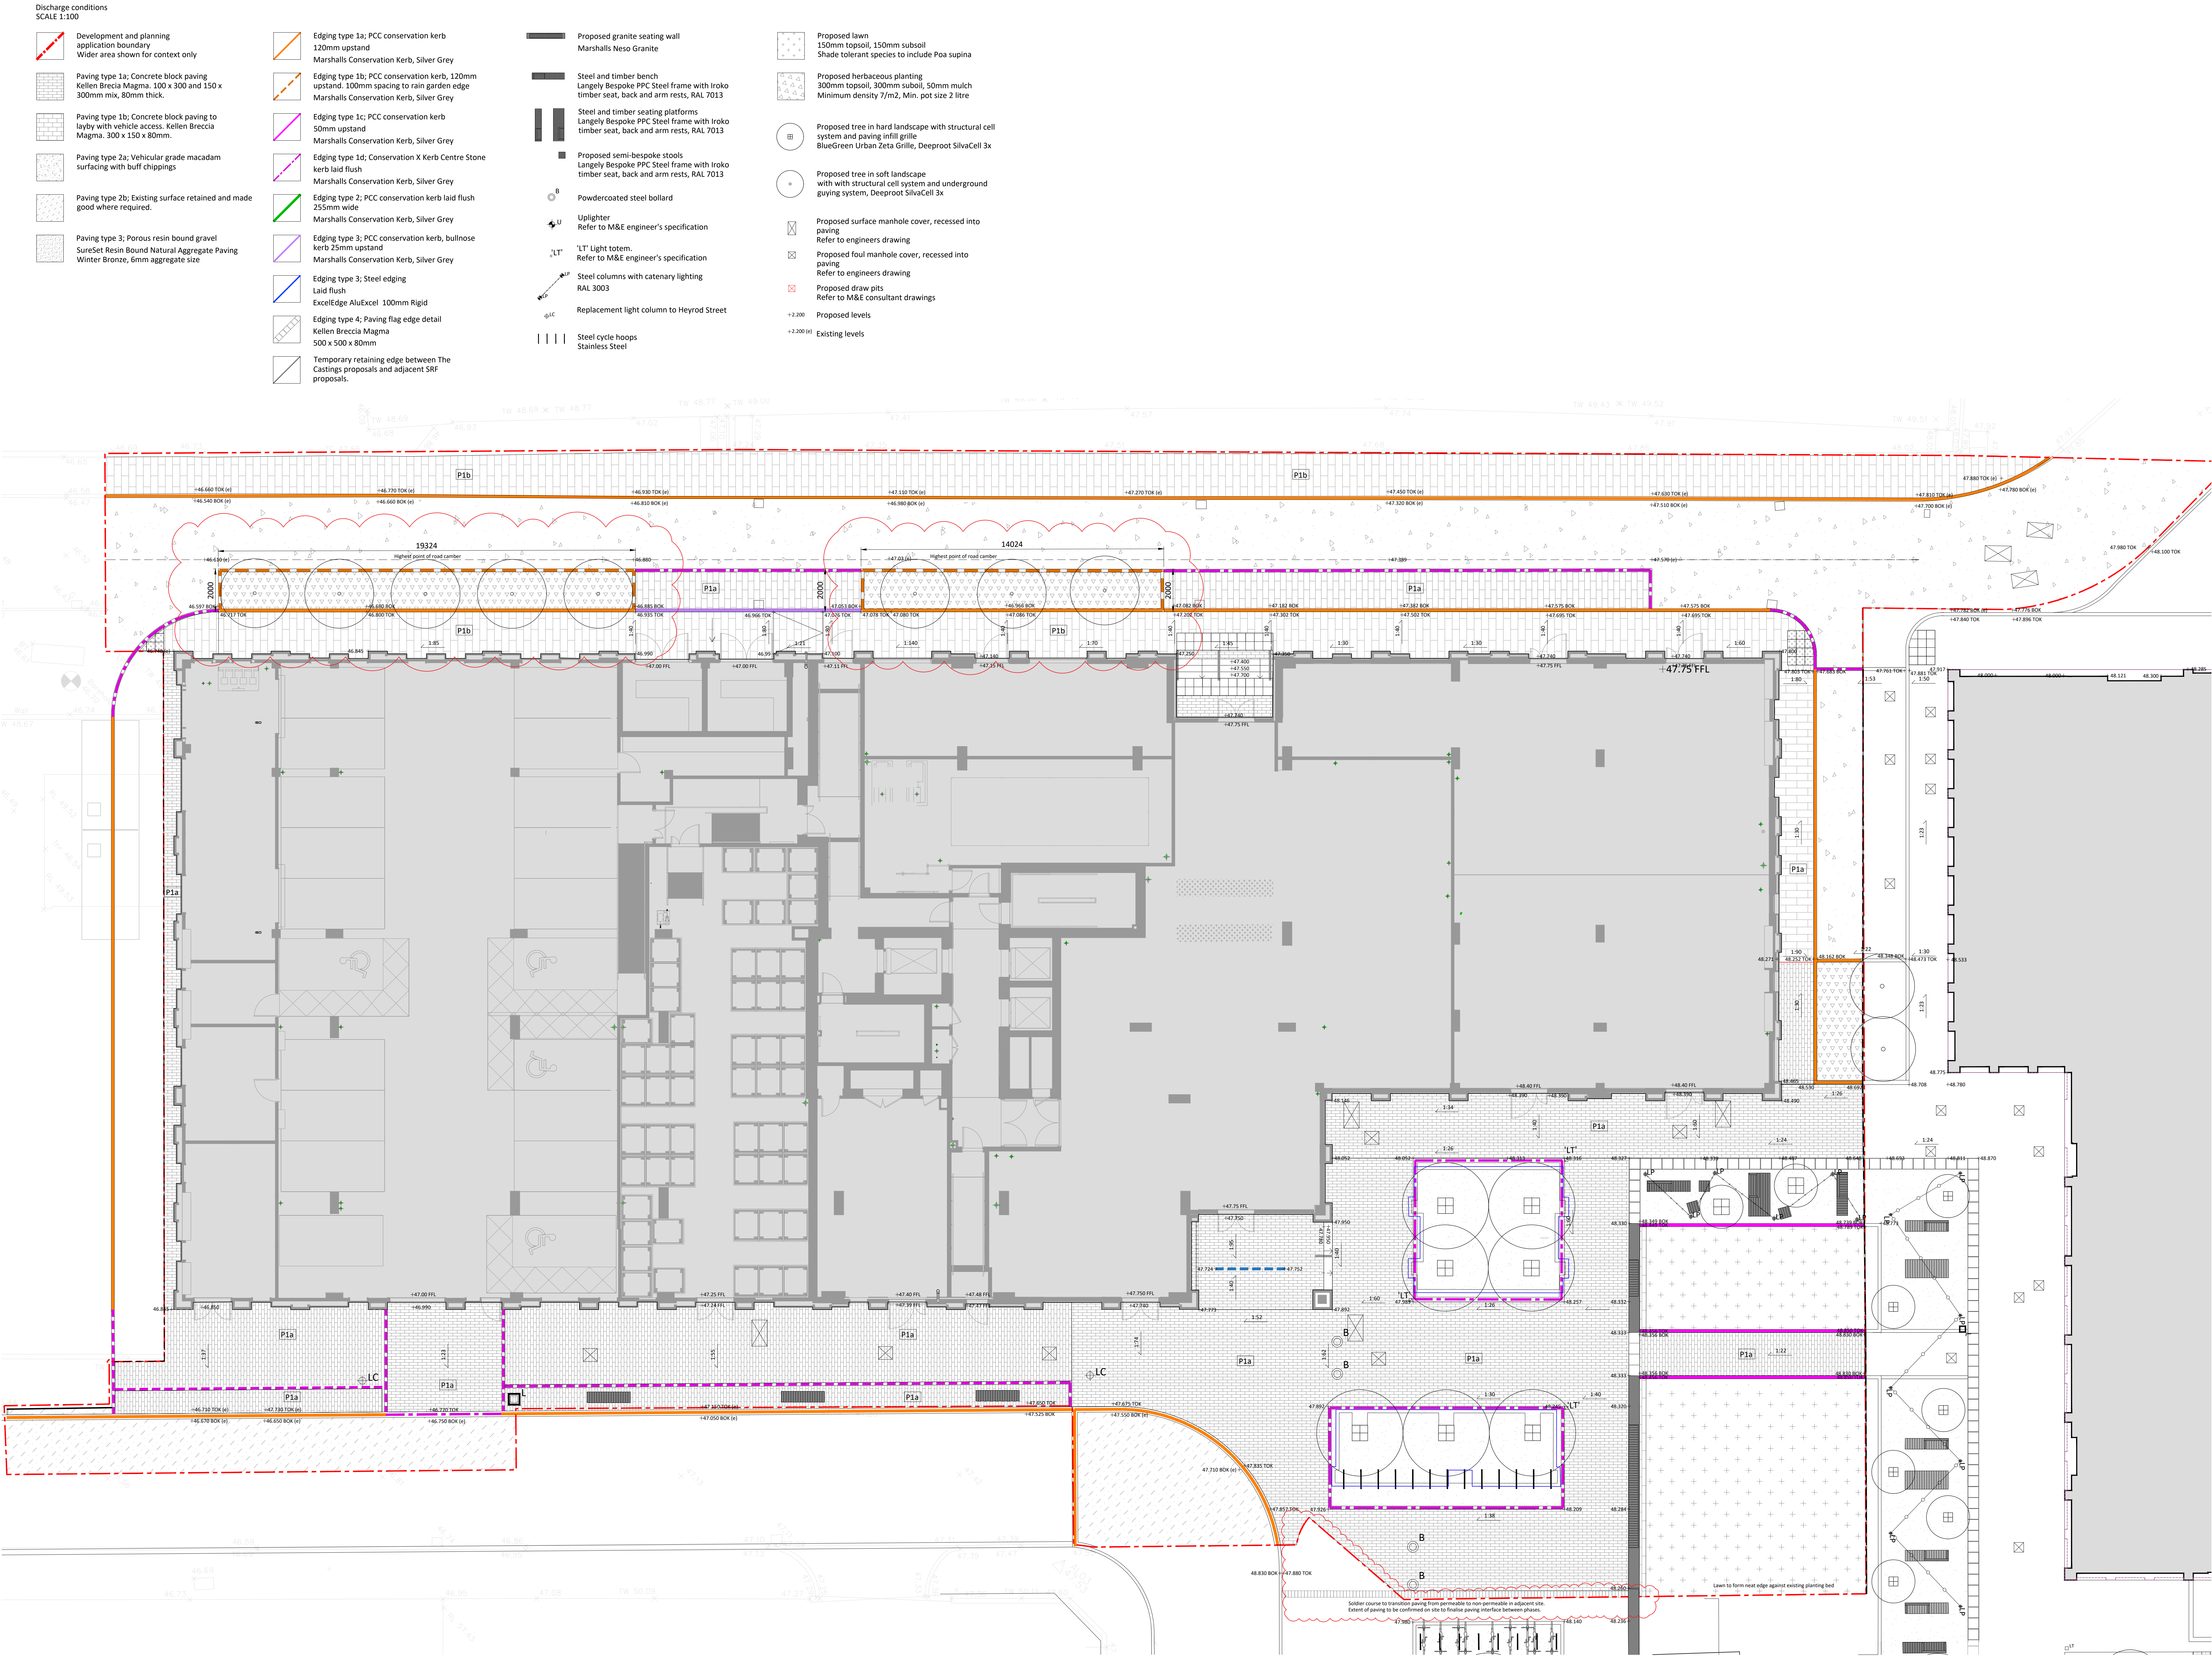

1. All information shown outside of application boundary is to be considered indicative and subject to separate detailed planning applications.
2. All dimensions in mm, unless otherwise stated.
3. Scaling from drawing if printed incorrectly may lead to errors.
4. All information outside red line boundary shown for contextual purpose only.
5. All hatch patterns are indicative only unless stated otherwise.
6. This drawing is to be read in conjunction with the following re-form landscape architecture documentation:
 - CAS-RFM-XX-L01-DR-L-19-0023 Planning Condition Landscape General Arrangement Level 01
 - CAS-RFM-XX-L21-DR-L-19-0024 Planning Condition Landscape General Arrangement Level 21AND all relevant documentation from the design team
6. Levels information on this drawing illustrates the design intent. The contractor is to check and verify all levels and dimensions against site survey information.
7. Any discrepancies in the design information are to be brought to the attention of re-form landscape architecture, in writing, prior to commencement of construction works.
8. All proprietary products shall be installed in strict accordance with manufacturers written instructions. Refer to other consultants' drawings and specifications for the following design information:
 - Foundation details
 - Base course and/or sub bases design & specification
 - Waterproofing of any element
 - Levels & Drainage design and infrastructure
 - Lighting and ducting
 - Existing & proposed utilities
10. Plant quantities are to suit site areas in accordance with scheduled plant densities.
11. Any proposed plant substitution shall be agreed with the landscape architect prior to ordering.

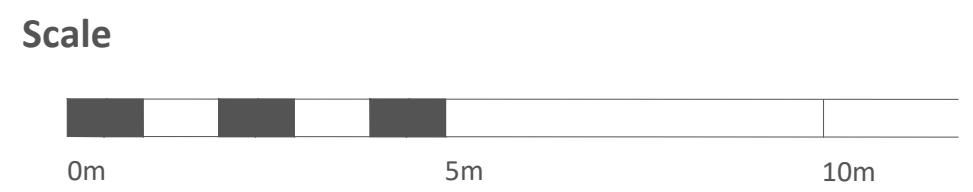

04.04.23 Rain gardens widened to 2000mm	EB	EB	DL	P02
13.07.22 Planning condition 11 discharge	EB	EB	DL	P01
Date	Description of revision	Drawn	Checked	Approved

re-form
landscape architecture

Beehive Mill, Jersey Street,
Manchester M4 6JG
T: +44 (0)161 397 4953
E: info@re-formlandscape.com
W: re-formlandscape.com

Project
THE CASTINGS, 2 HEYROD STREET
RF20-799

Client
PACKAGED LIVING

Document title
DISCHARGE PLANNING CONDITION
LANDSCAPE GENERAL ARRANGEMENT - LEVEL 00

Paper size
A0

Scale
1:100

Status
FOR INFORMATION

Drawing number
CAS-RFM-XX-L0-DR-L-19-0022

Revision
S2
P02

© re-form landscape architecture